


one eighth inch = one foot  
0 4 8 12 16  

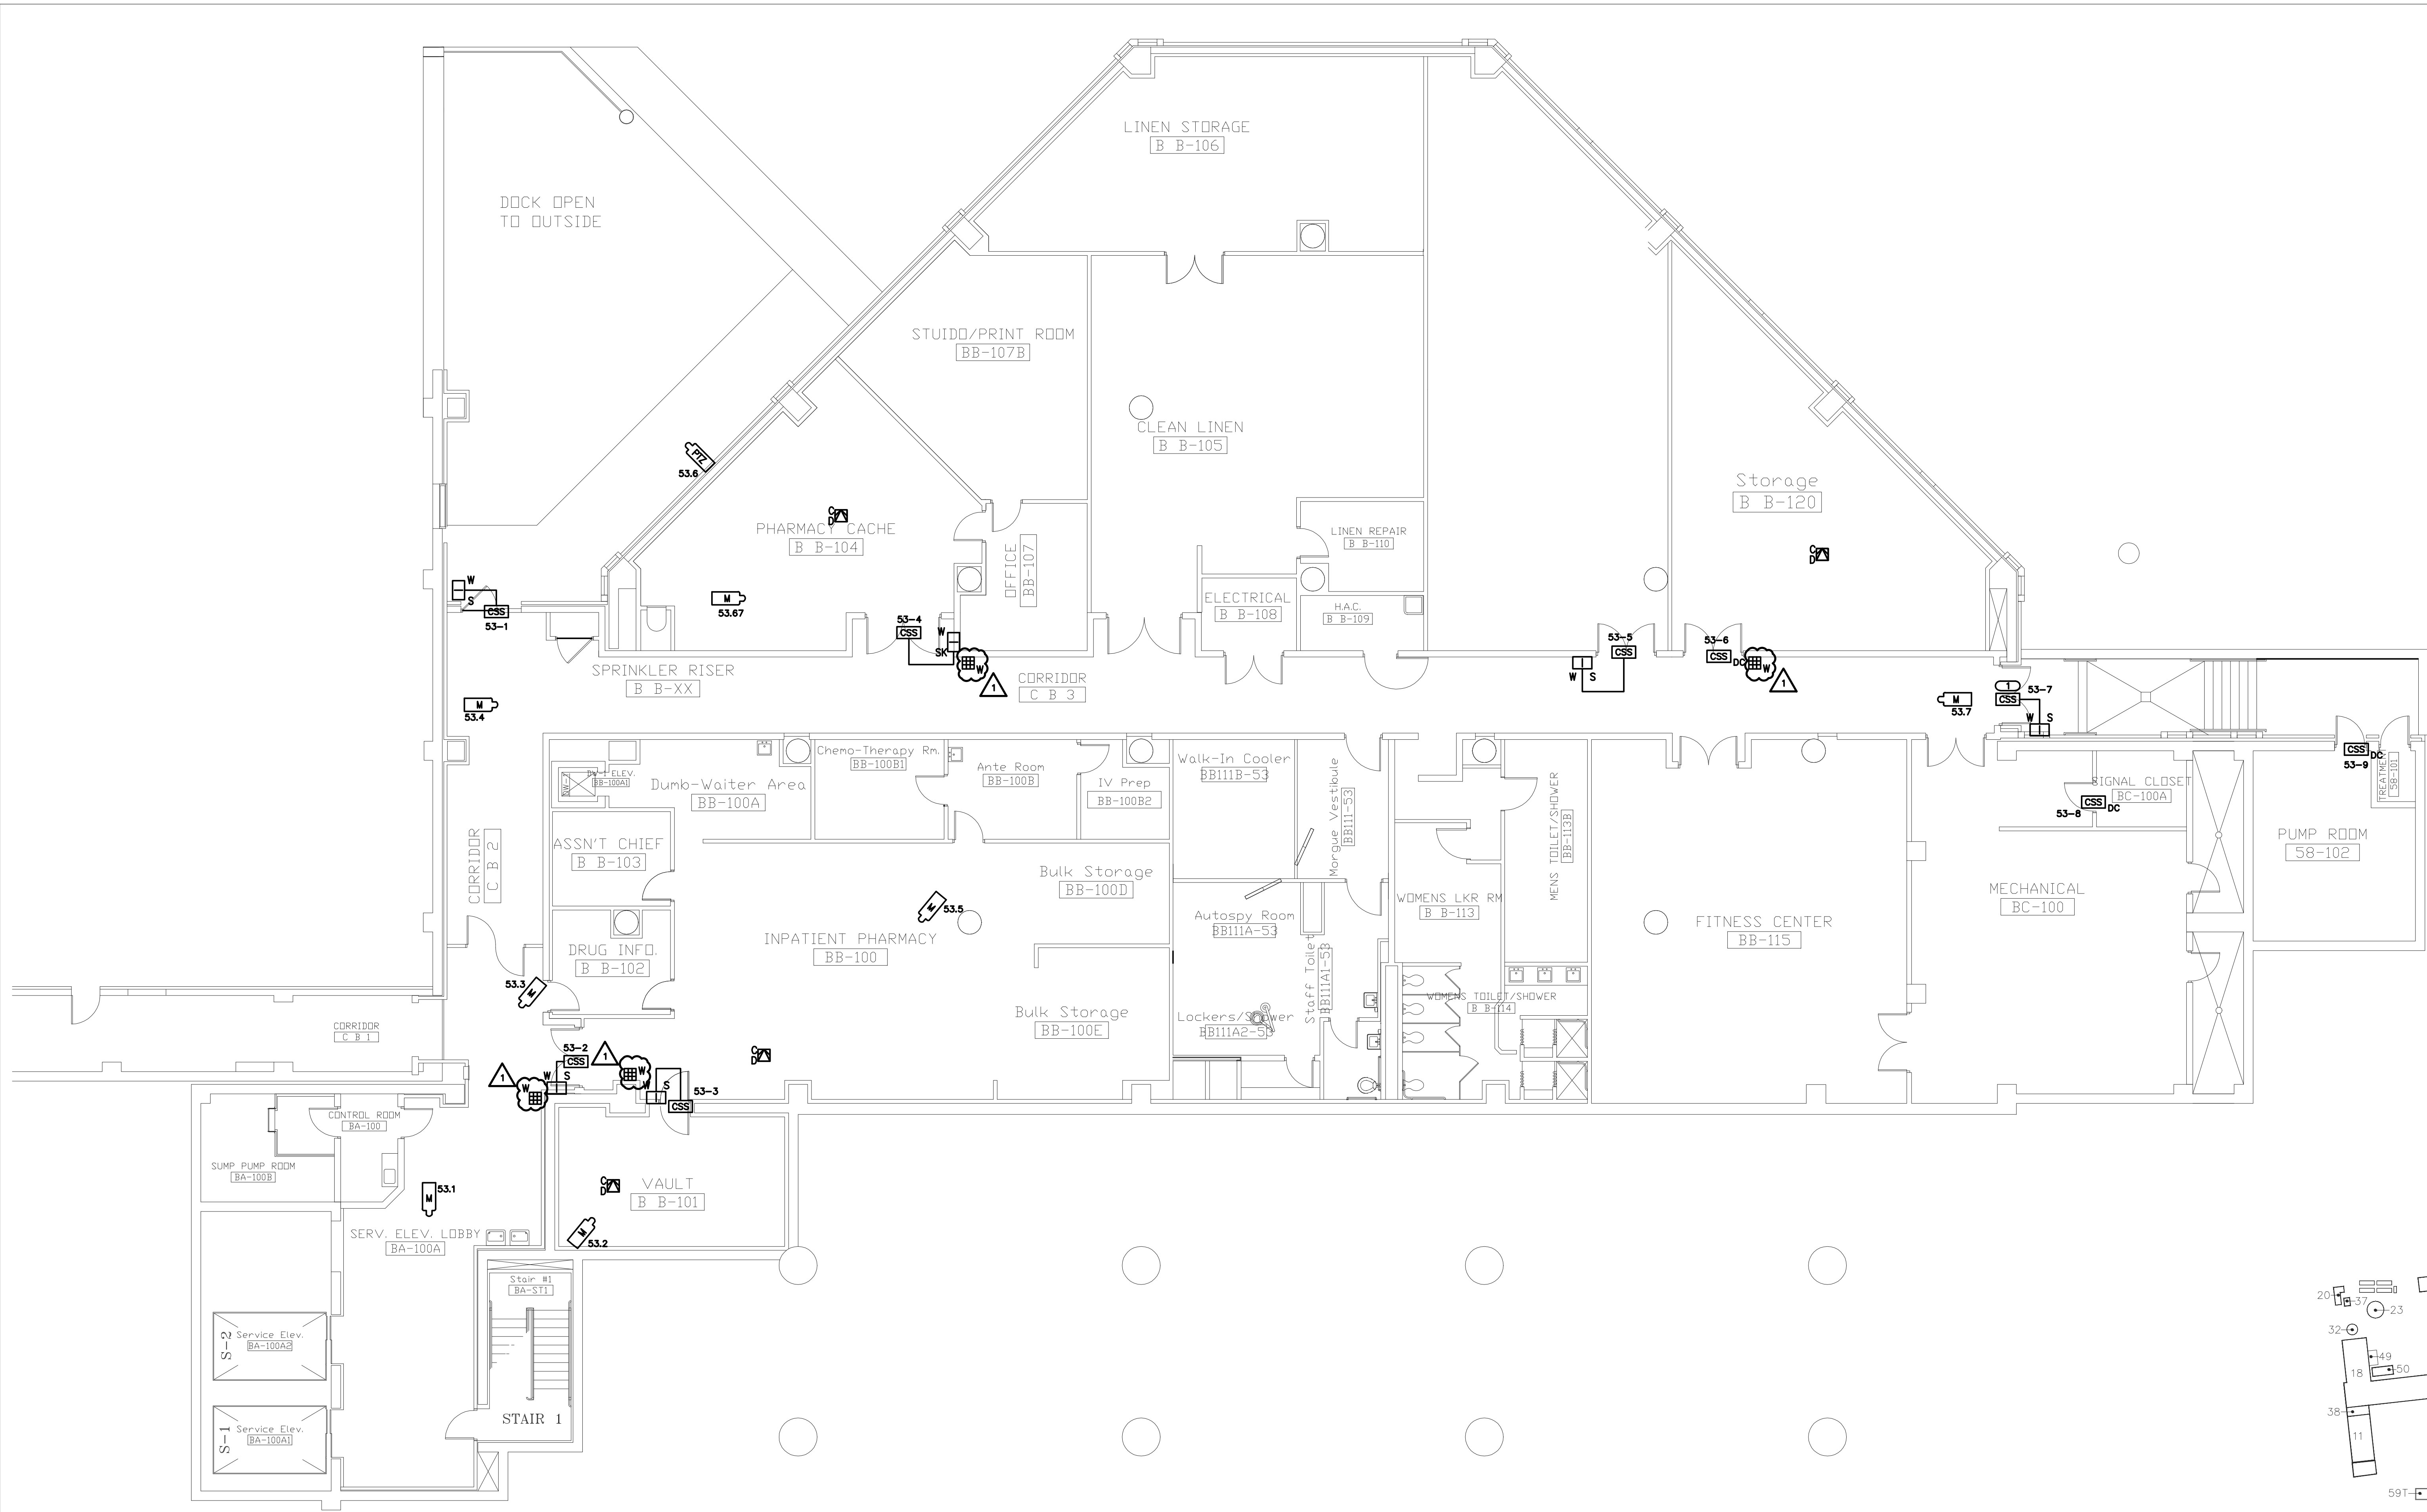

**BASEMENT**  
SCALE: 1/8" = 1'-0"  
N

