

LEGEND	
98 EK	SIGN LOCATION NO. SIGN TYPE
	DEMO/REMOVE
	INSTALL AT/NEAR EXISTING LOCATION
	INSTALL AT NEW LOCATION
	CAMPUS MAP

Relocated Phase 1 Signs


Phase 2 Exterior Signs to be Purchased/Installed

Confirm Location/Graphics

REVISION DATE: 6.20.14
By: g

? Do we do this?

Test Center VA Southern Nevada Healthcare System | VA Desert Pacific Healthcare Network

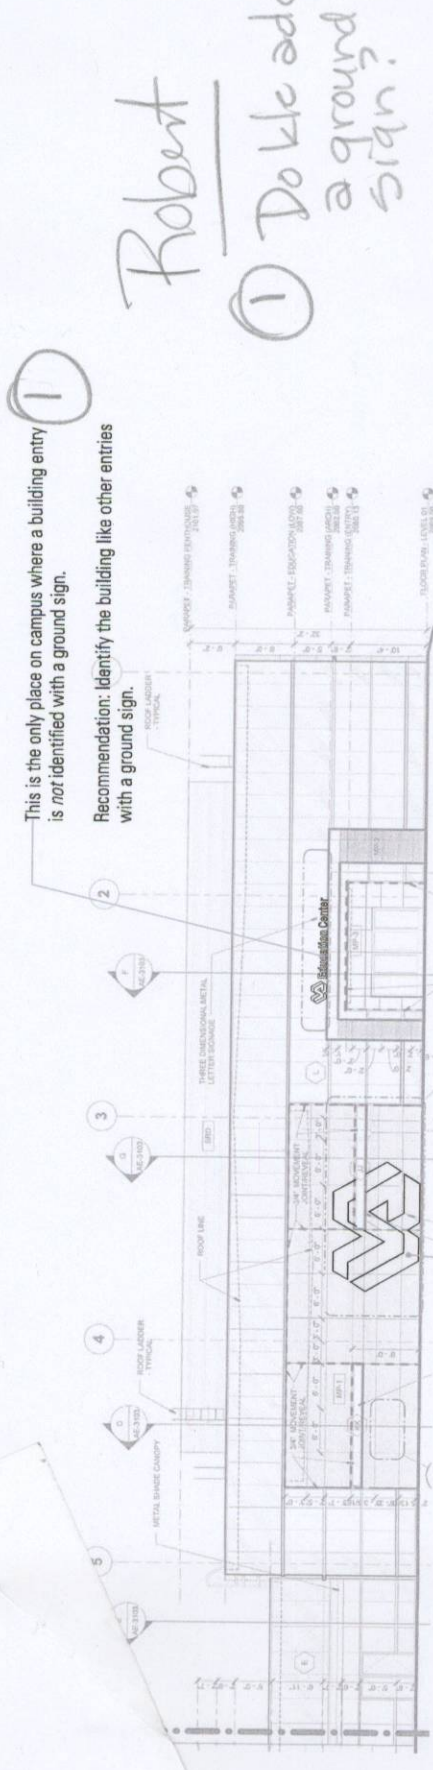

1 Do the add a ground sign

2 Is this still in the plans?



Education Center

G04.0

300? Relocated - New info - CS
400? Relocated - New info - CS
500? Relocated - New info - CS



Deer Springs Way

North Pecos Road