
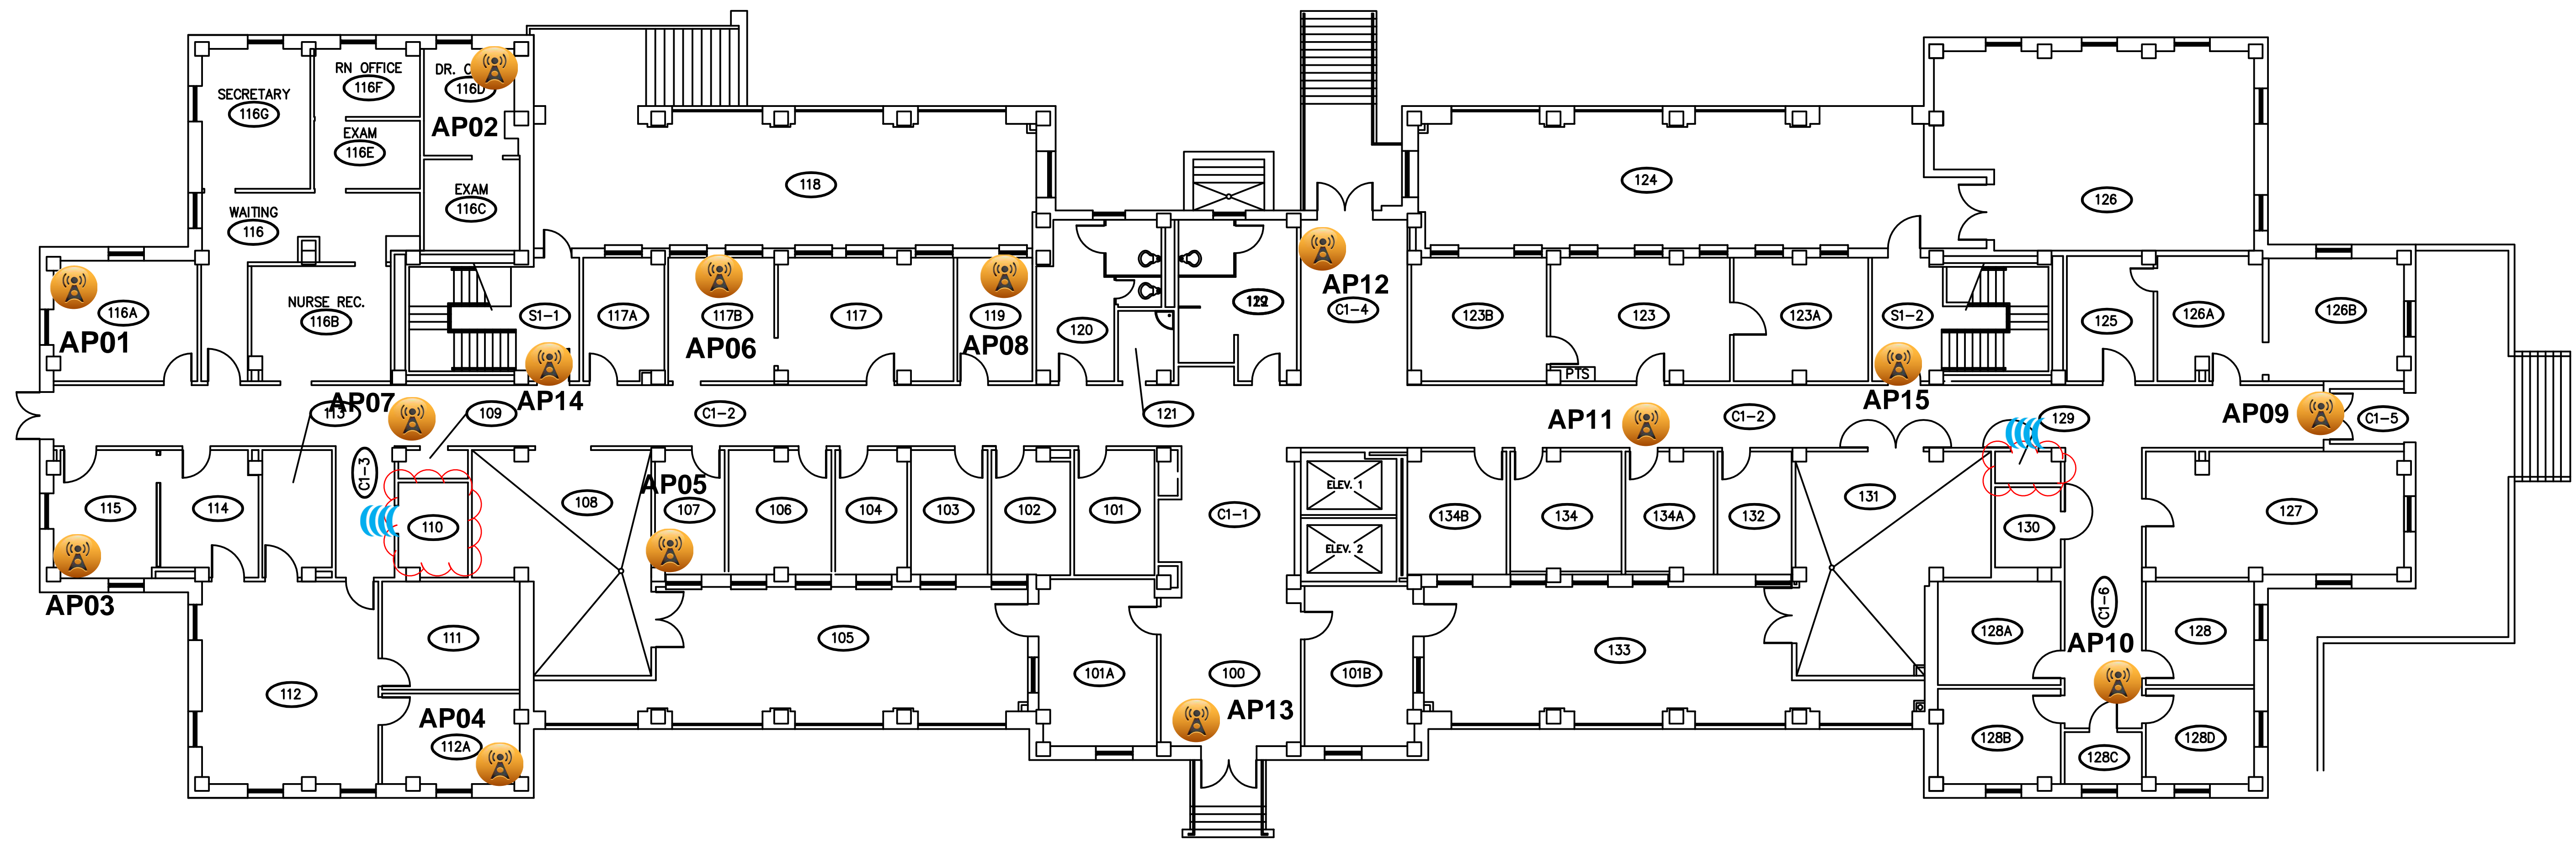


Bay Pines Building 22 - Floor 1






Default


-  3502I AP
-  3502I Elevator AP
-  3502E AP
-  Legacy AP
-  Spectrum Capture
-  Wiring Closet



Bay Pines Building 22 - Floor 2



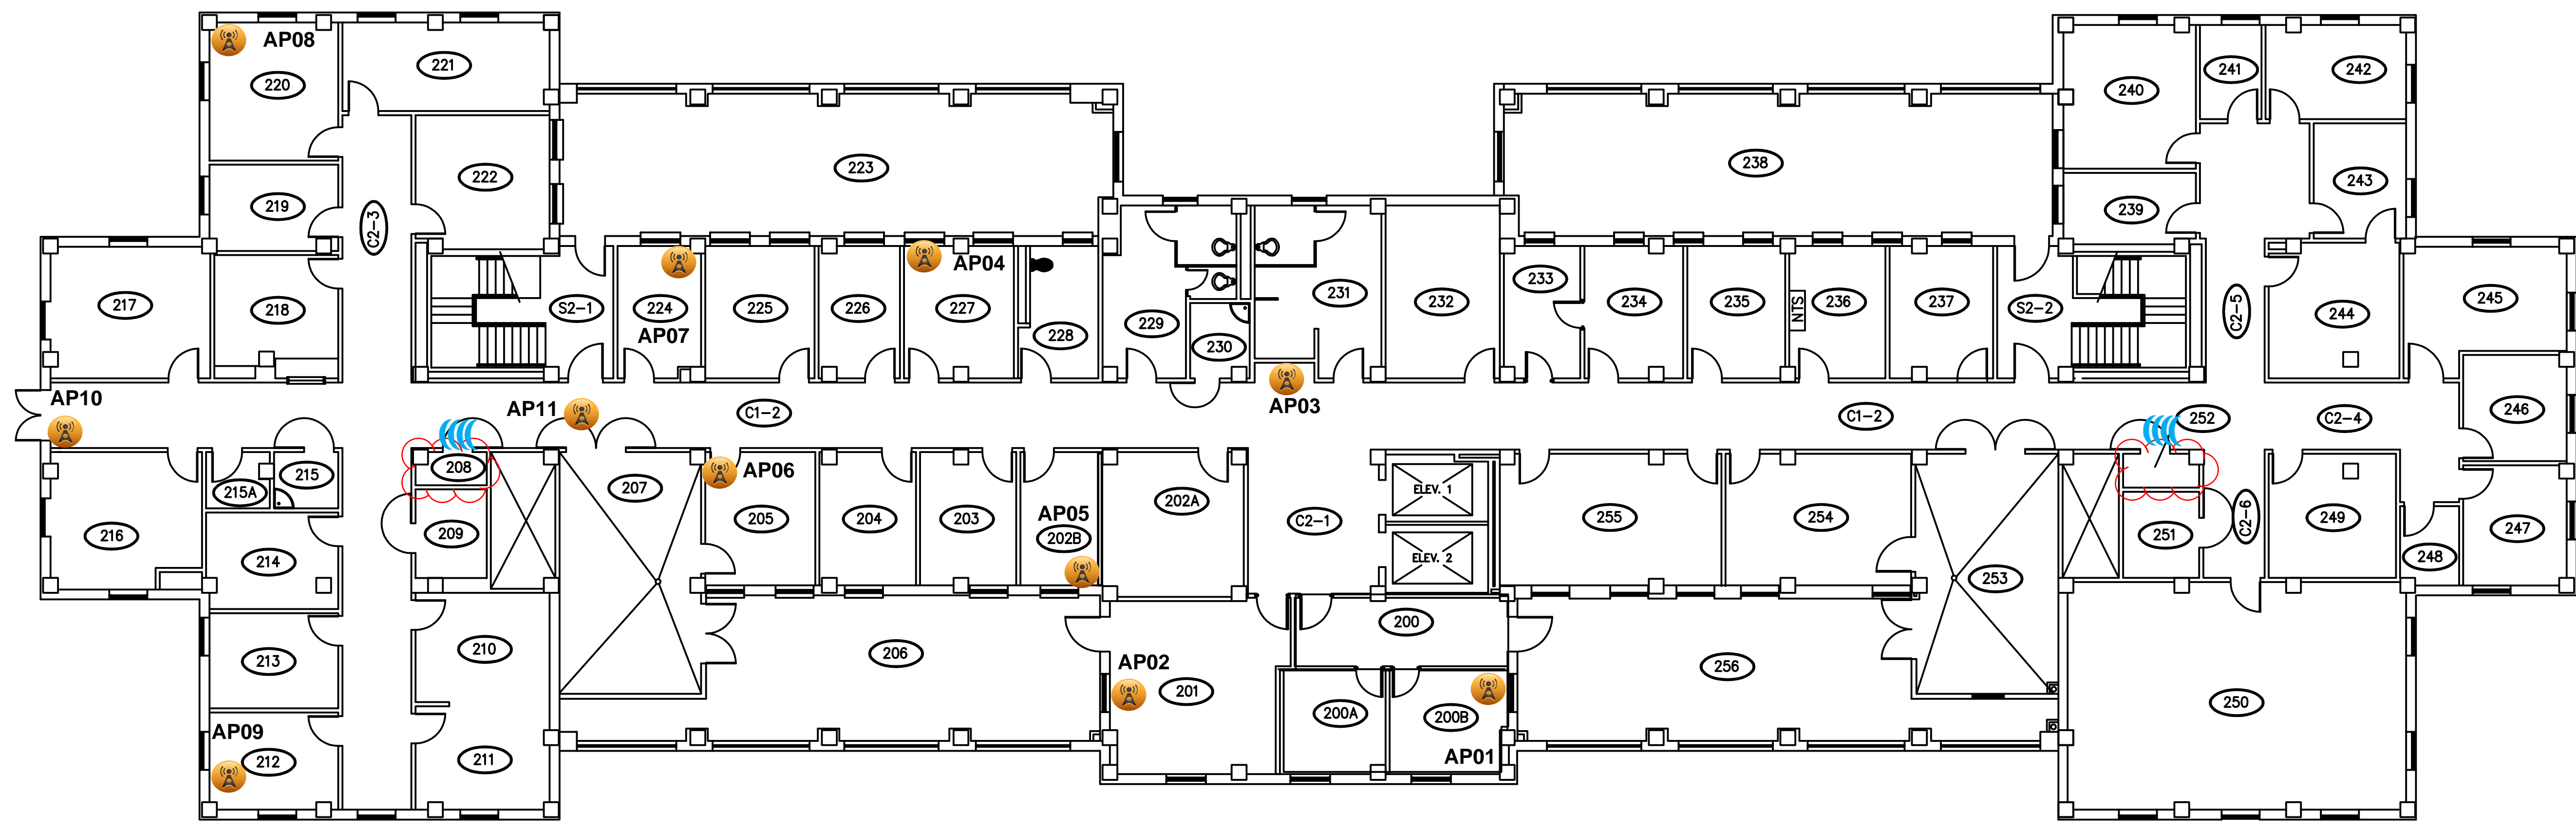

Default


-  3502I AP
-  3502I Elevator AP
-  3502E AP
-  Legacy AP
-  Spectrum Capture
-  Wiring Closet



Bay Pines Building 22 - Floor 3



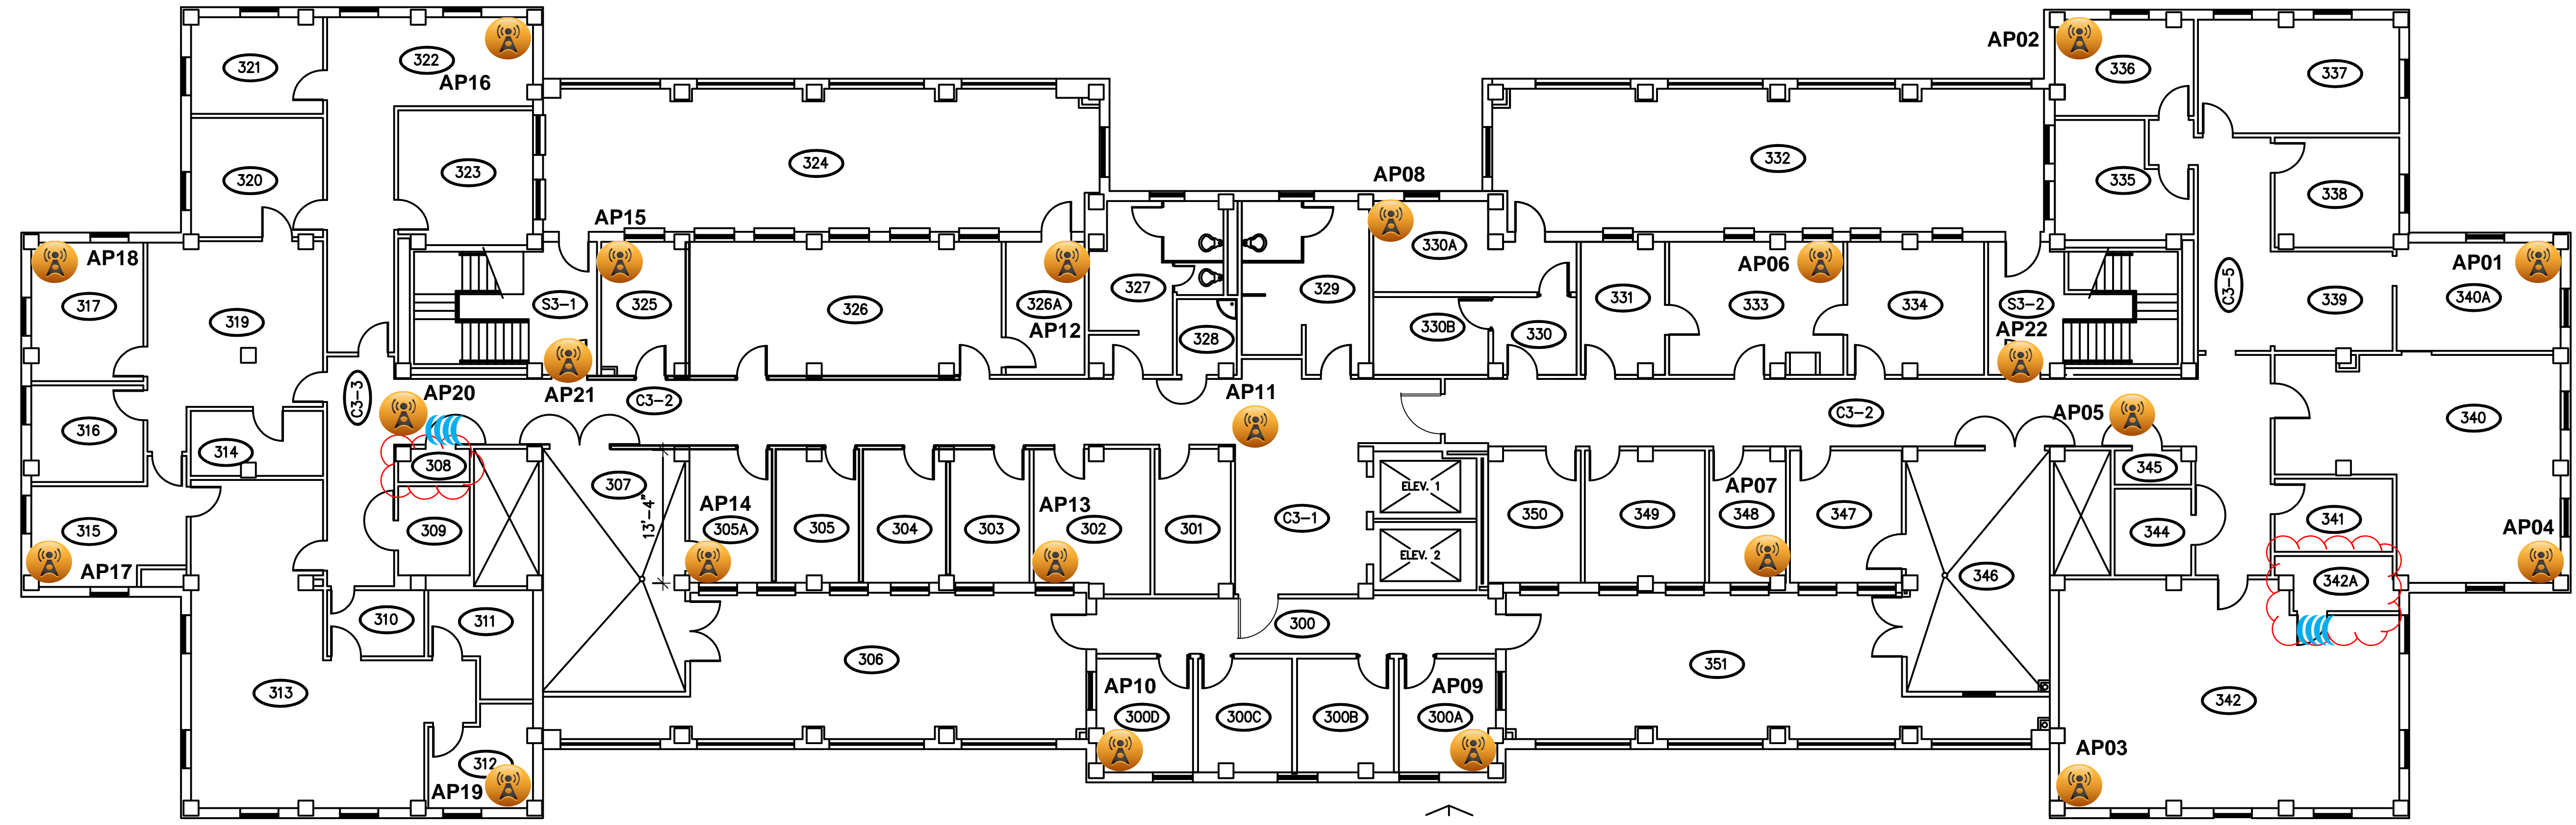


Default


-  3502I AP
-  3502I Elevator AP
-  3502E AP
-  Legacy AP
-  Spectrum Capture
-  Wiring Closet



Bay Pines Building 22 - Floor 4


Default


-  3502I AP
-  3502I Elevator AP
-  3502E AP
-  Legacy AP
-  Spectrum Capture
-  Wiring Closet

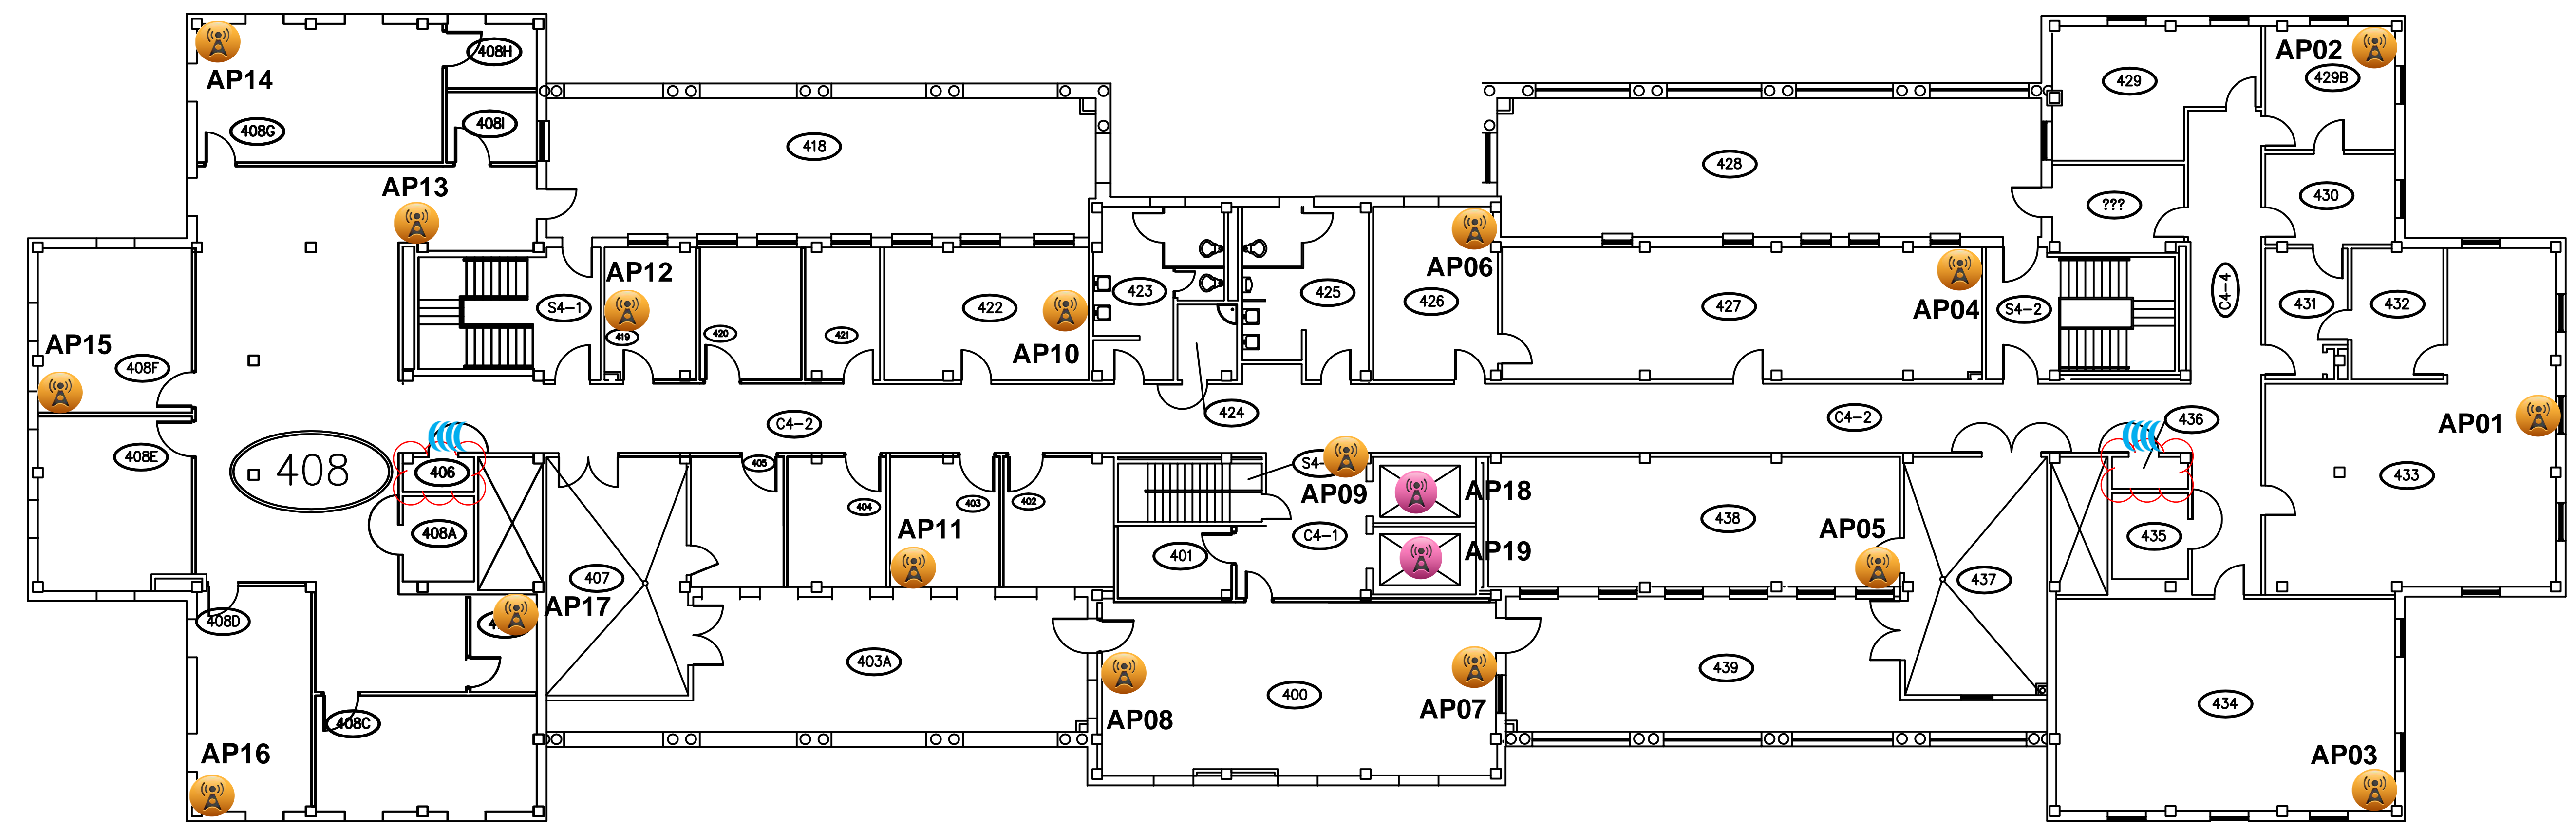

Bay Pines Building 22,23 - Corridor 1 - Floor 1

Standard-2


-  3502I AP
-  3502I Elevator AP
-  3502E AP
-  Legacy AP
-  Spectrum Capture
-  Wiring Closet

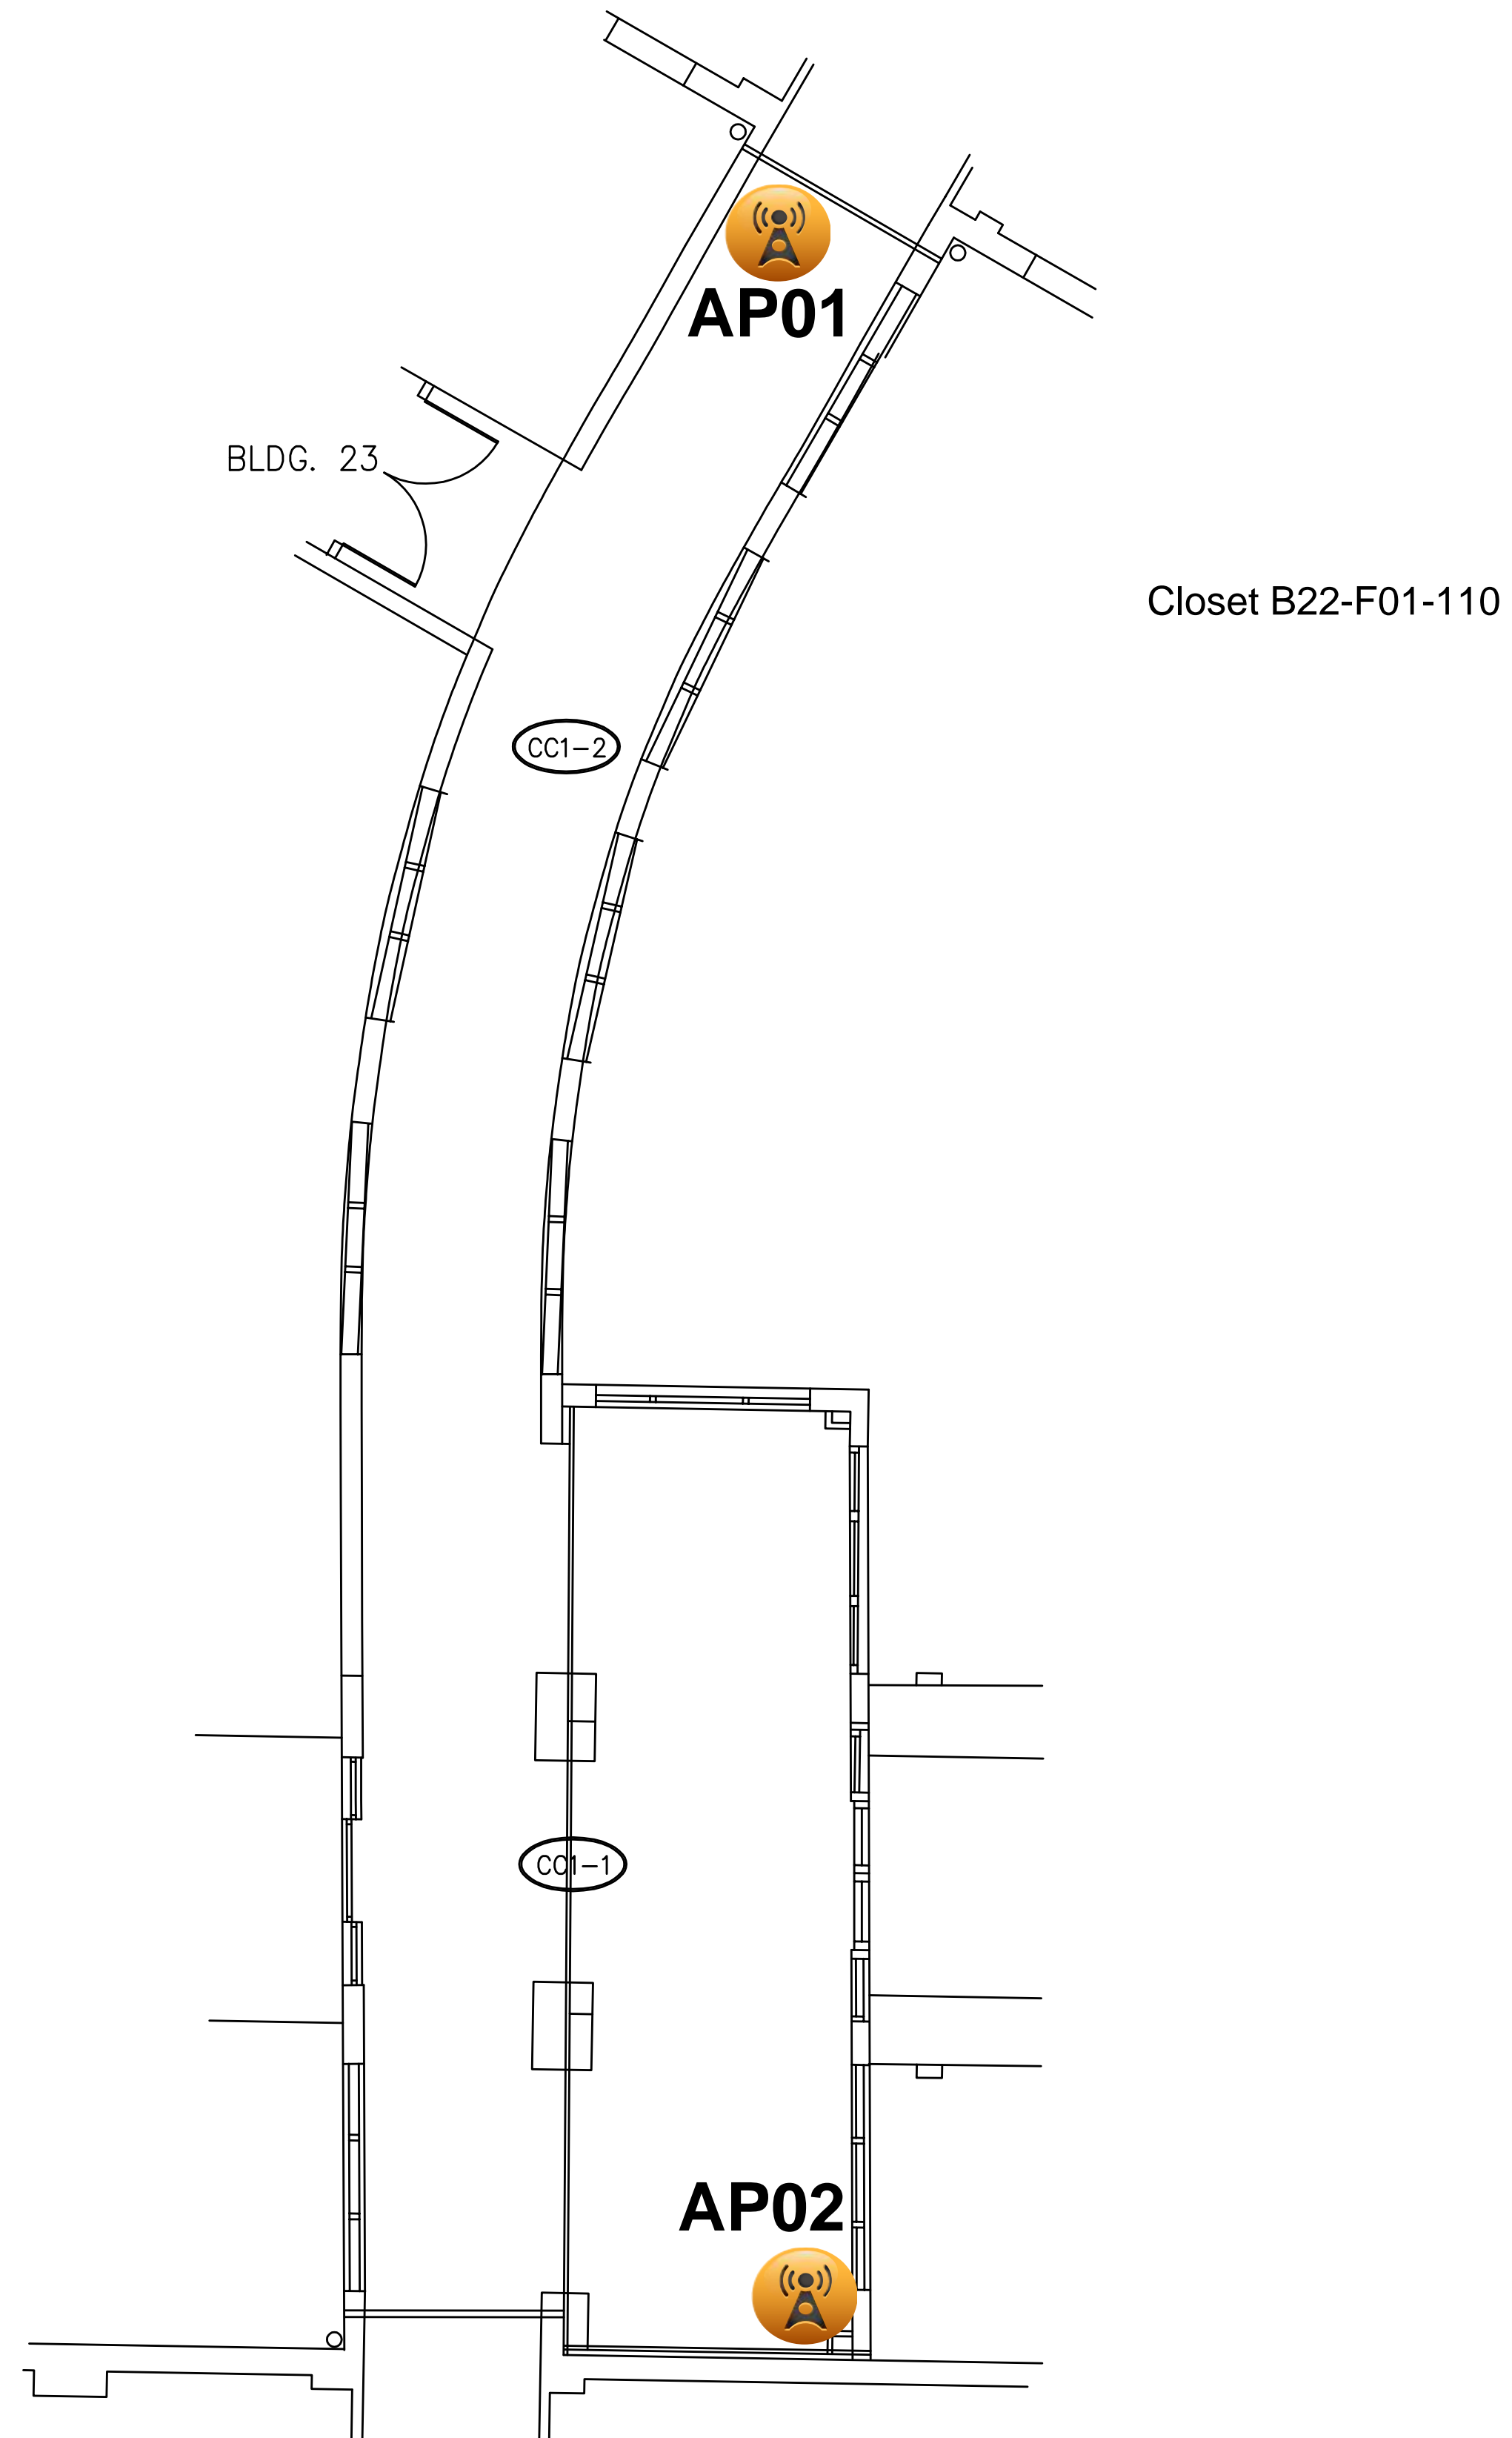

Bay Pines Building 22,23 - Corridor 1 - Floor 2

Standard-2


-  3502I AP
-  3502I Elevator AP
-  3502E AP
-  Legacy AP
-  Spectrum Capture
-  Wiring Closet

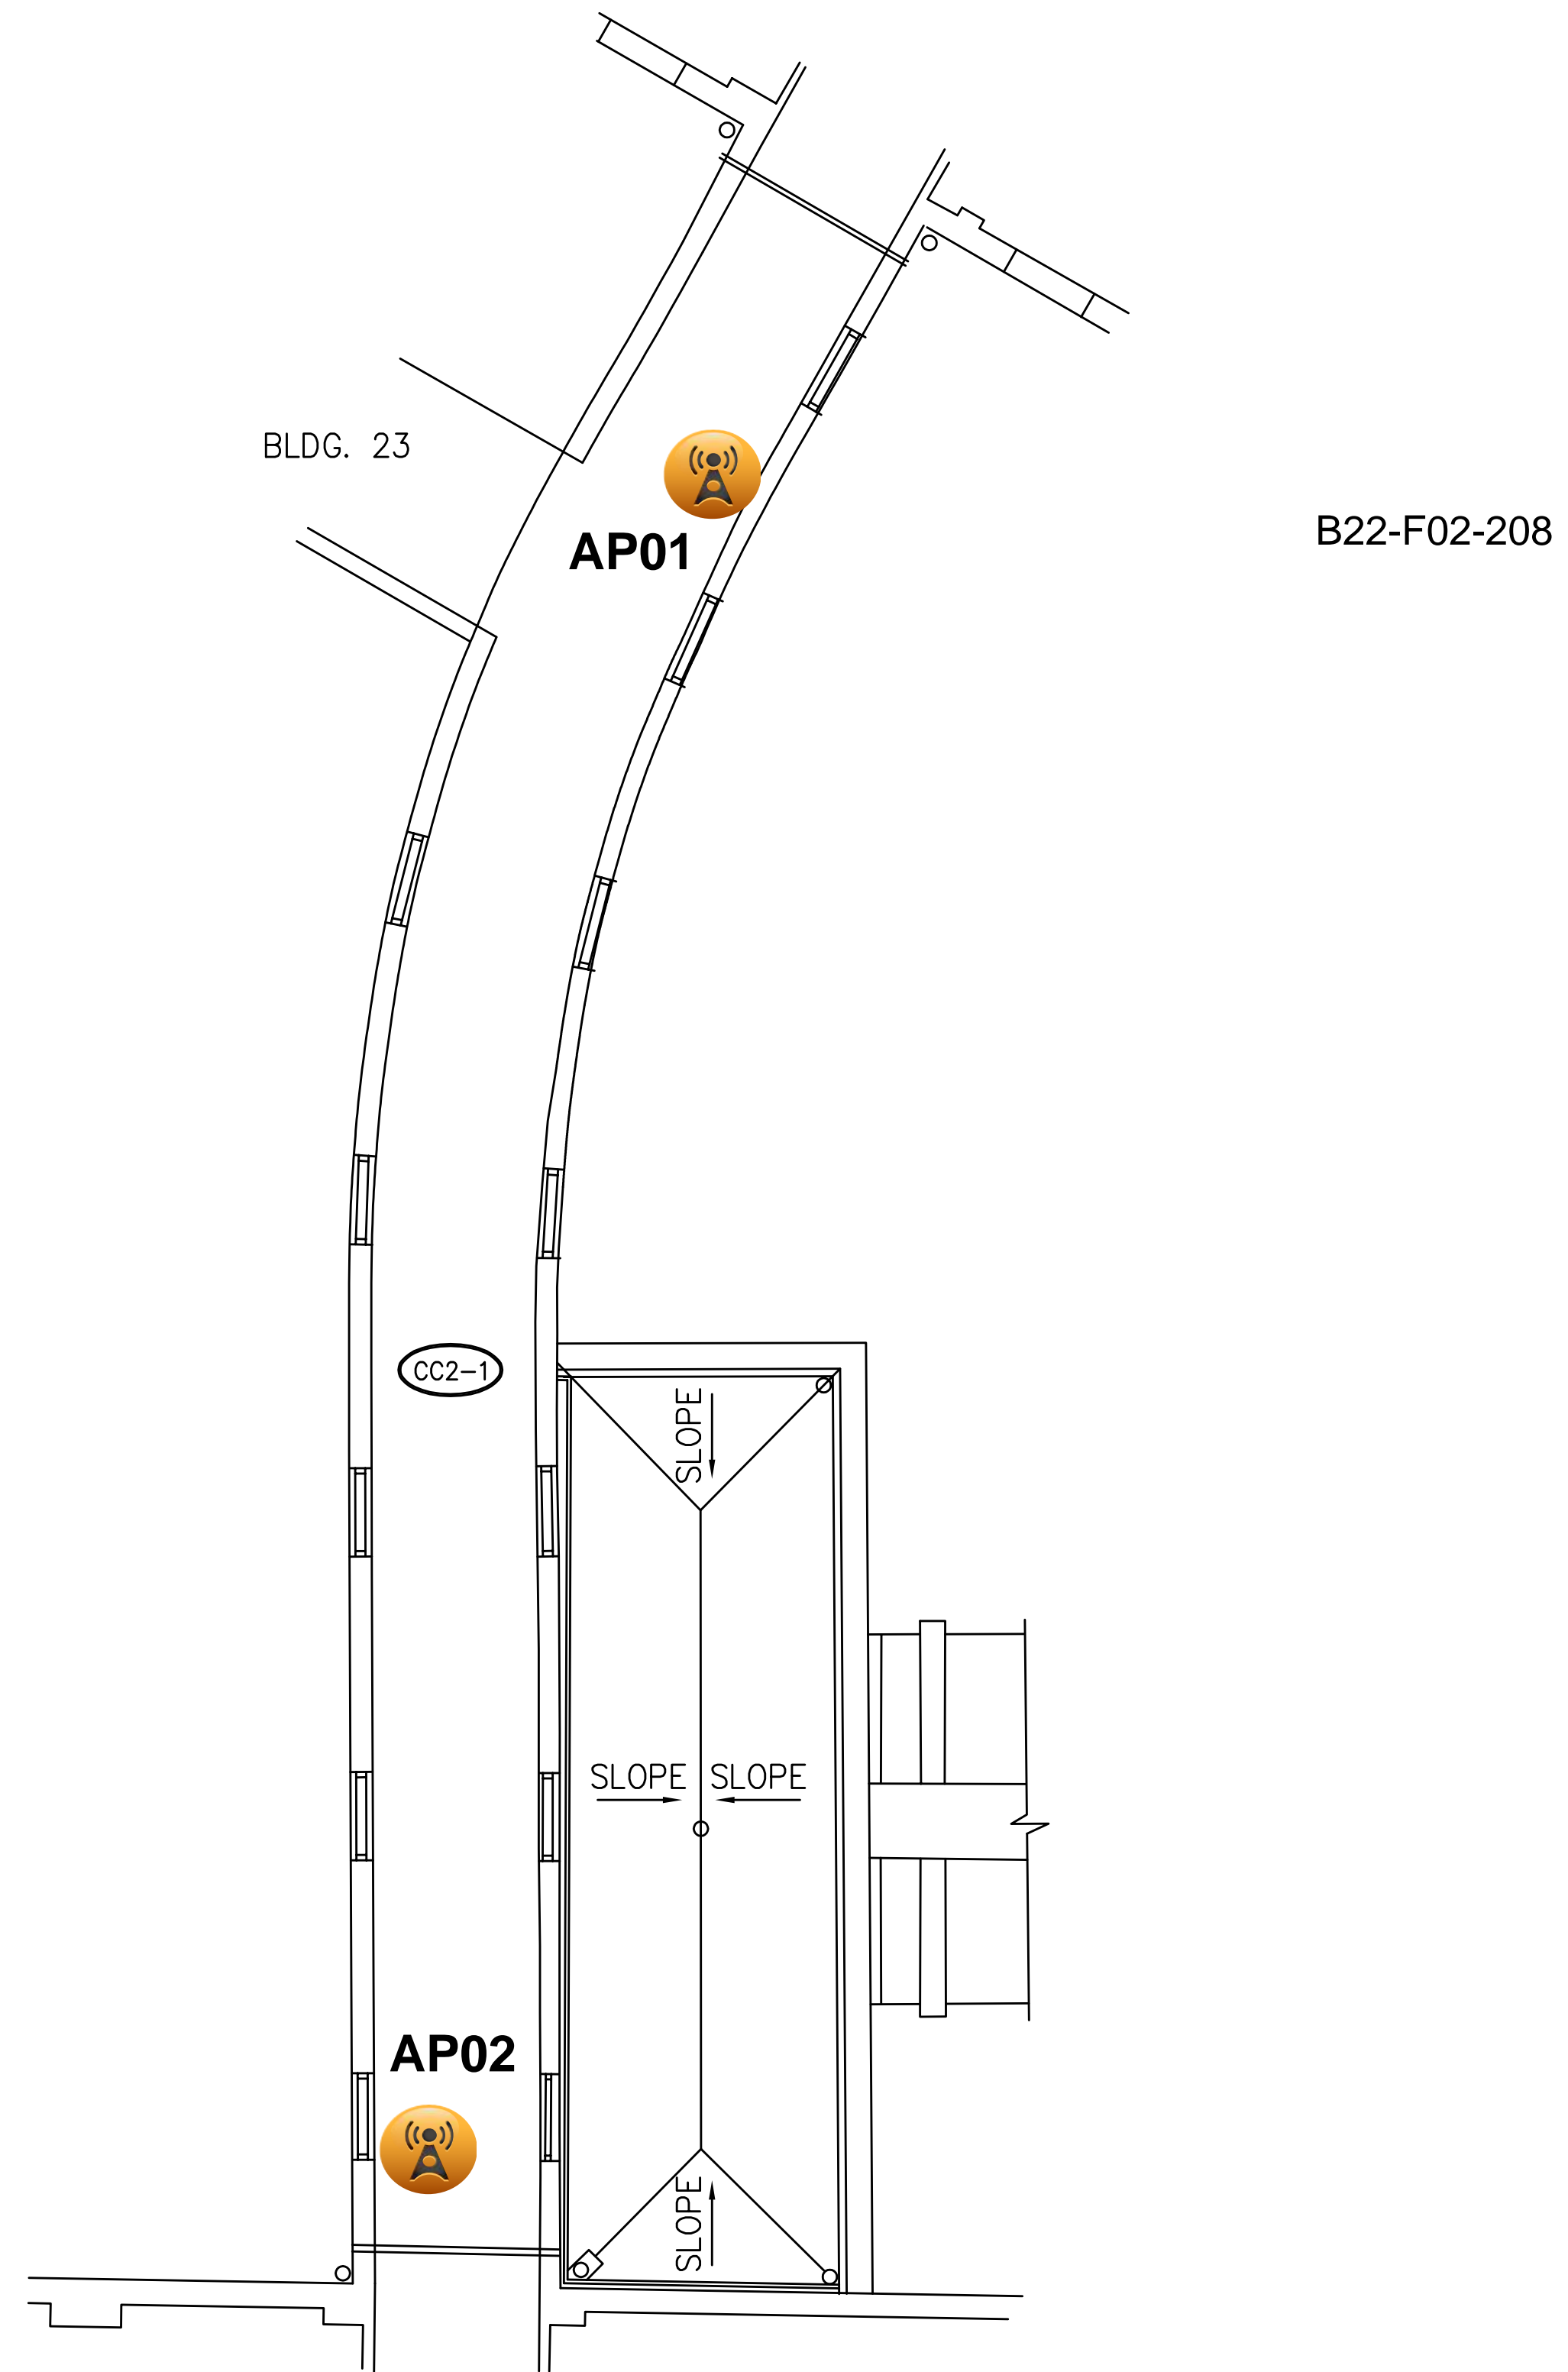

Bay Pines Building 23 - Floor 1

Default


-  3502I AP
-  3502I Elevator AP
-  3502E AP
-  Legacy AP
-  Spectrum Capture
-  Wiring Closet

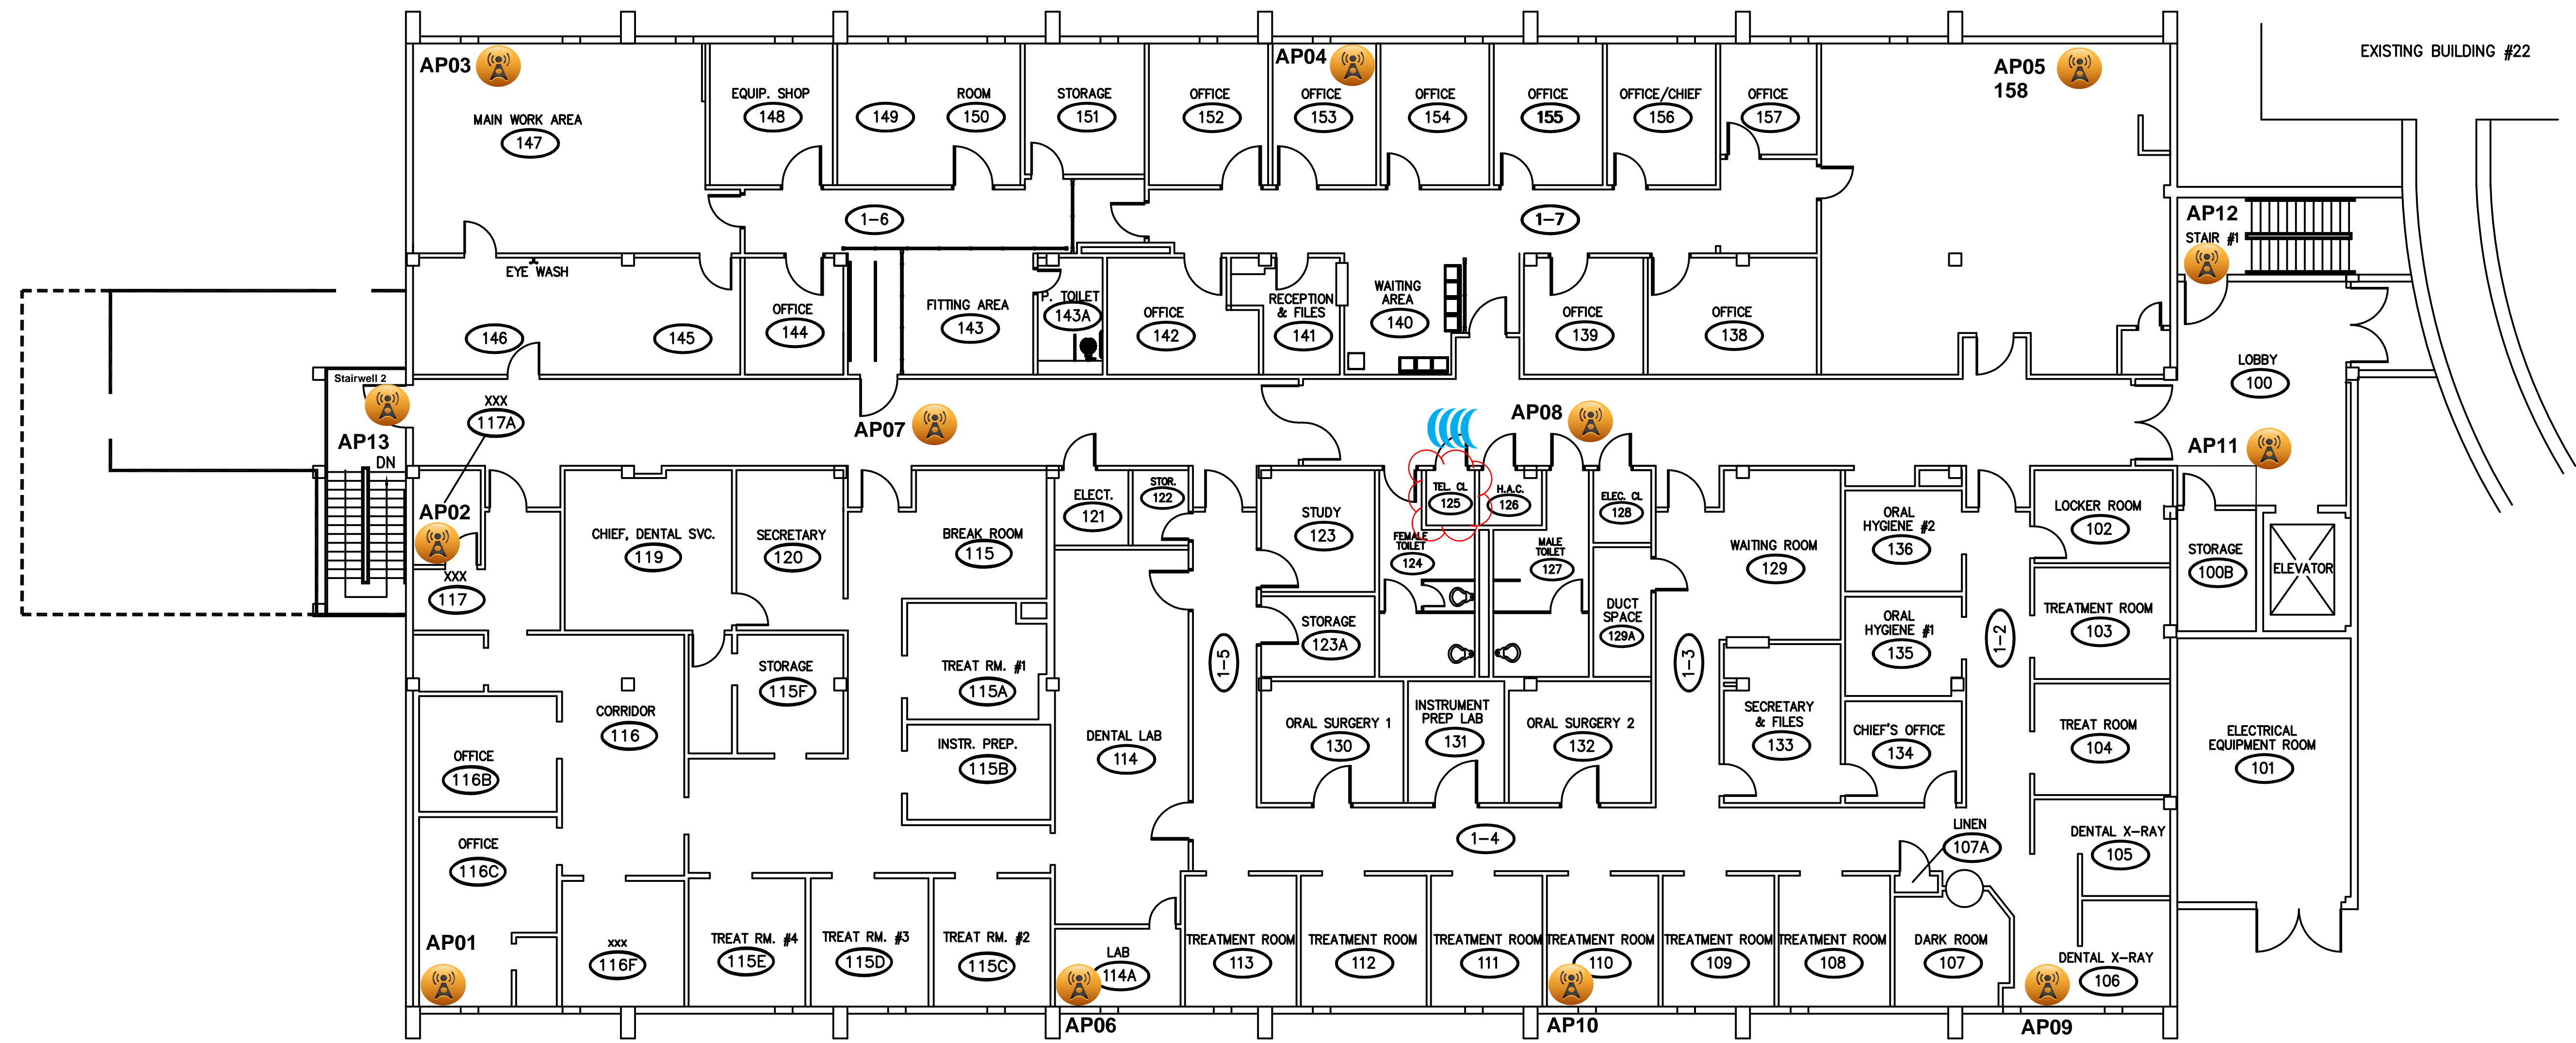

Bay Pines Building 23 - Floor 2


Default


-  3502I AP
-  3502I Elevator AP
-  3502E AP
-  Legacy AP
-  Spectrum Capture
-  Wiring Closet

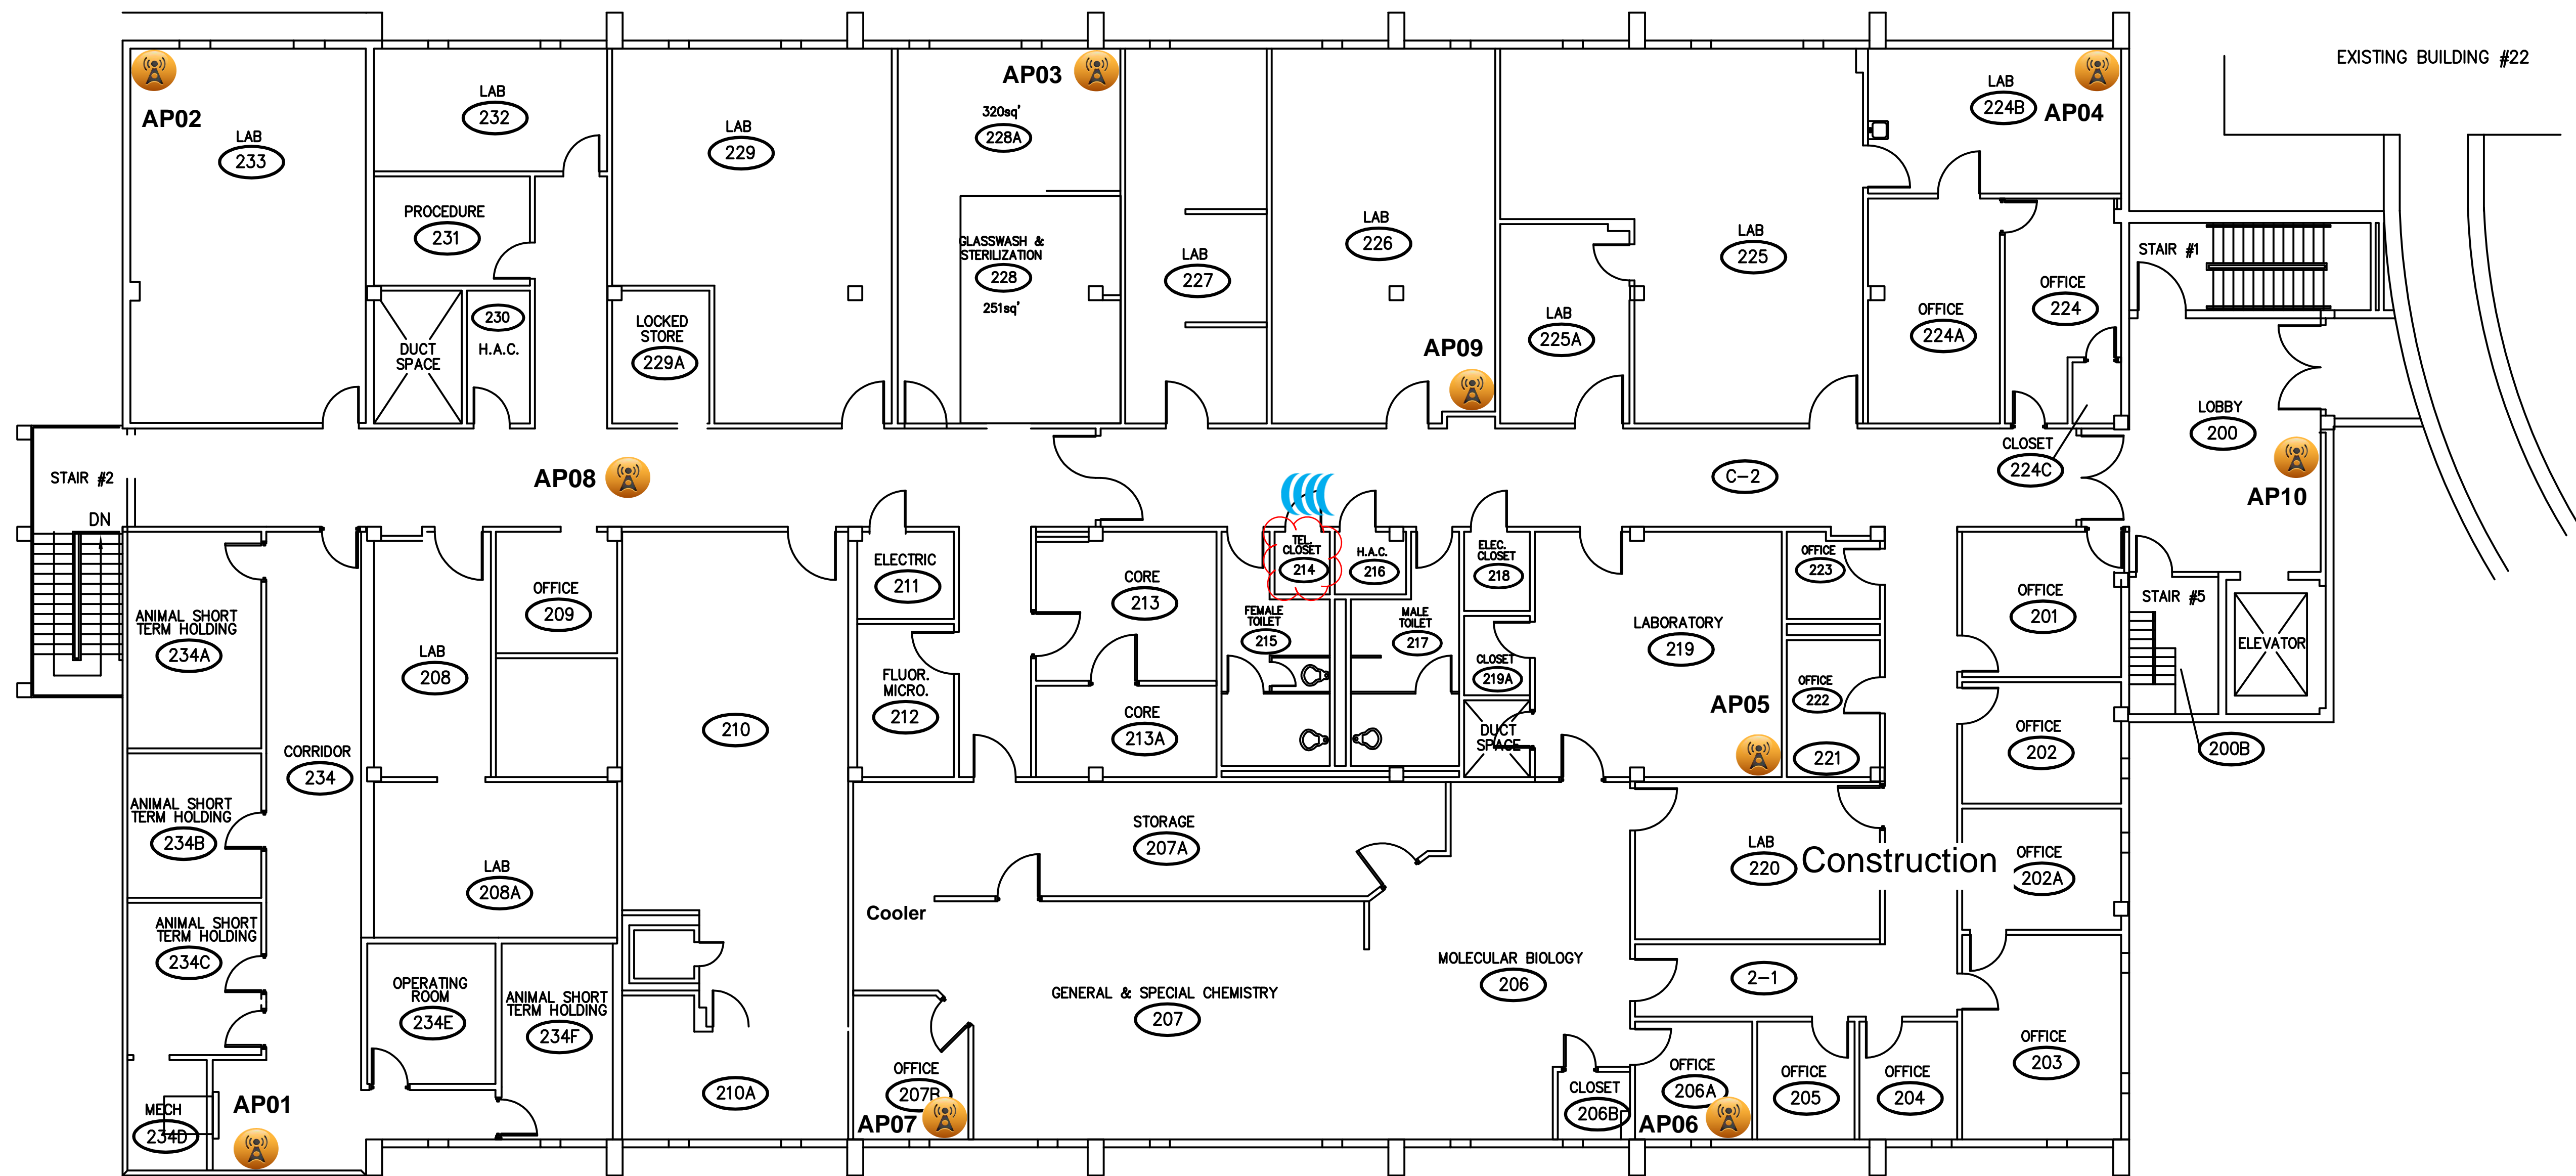

Bay Pines Building 24 - Floor 3

Default


-  3502I AP
-  3502I Elevator AP
-  3502E AP
-  Legacy AP
-  Spectrum Capture
-  Wiring Closet

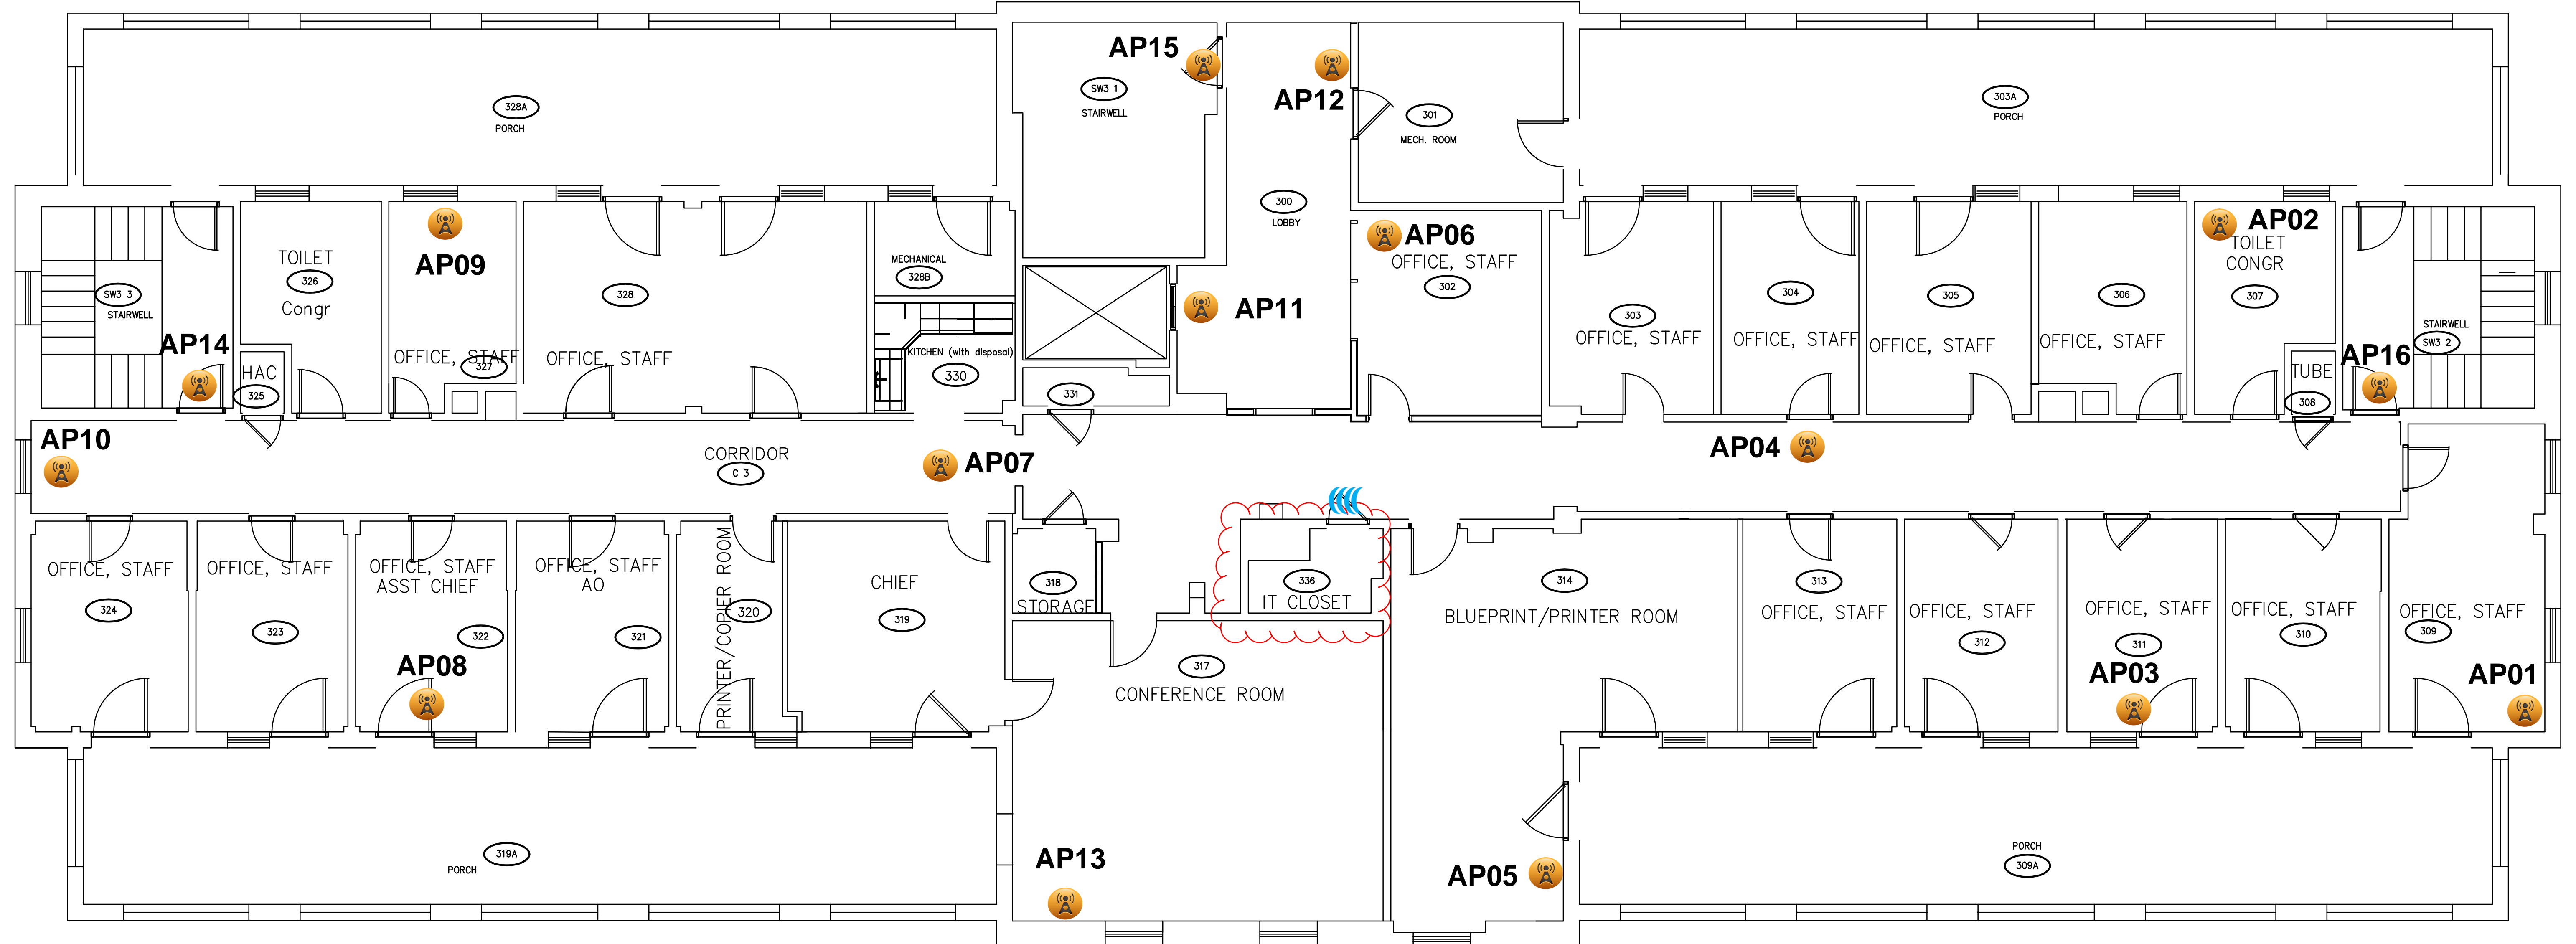

Bay Pines Building 35 - Floor 1

Standard-2


-  3502I AP
-  3502I Elevator AP
-  3502E AP
-  Legacy AP
-  Spectrum Capture
-  Wiring Closet

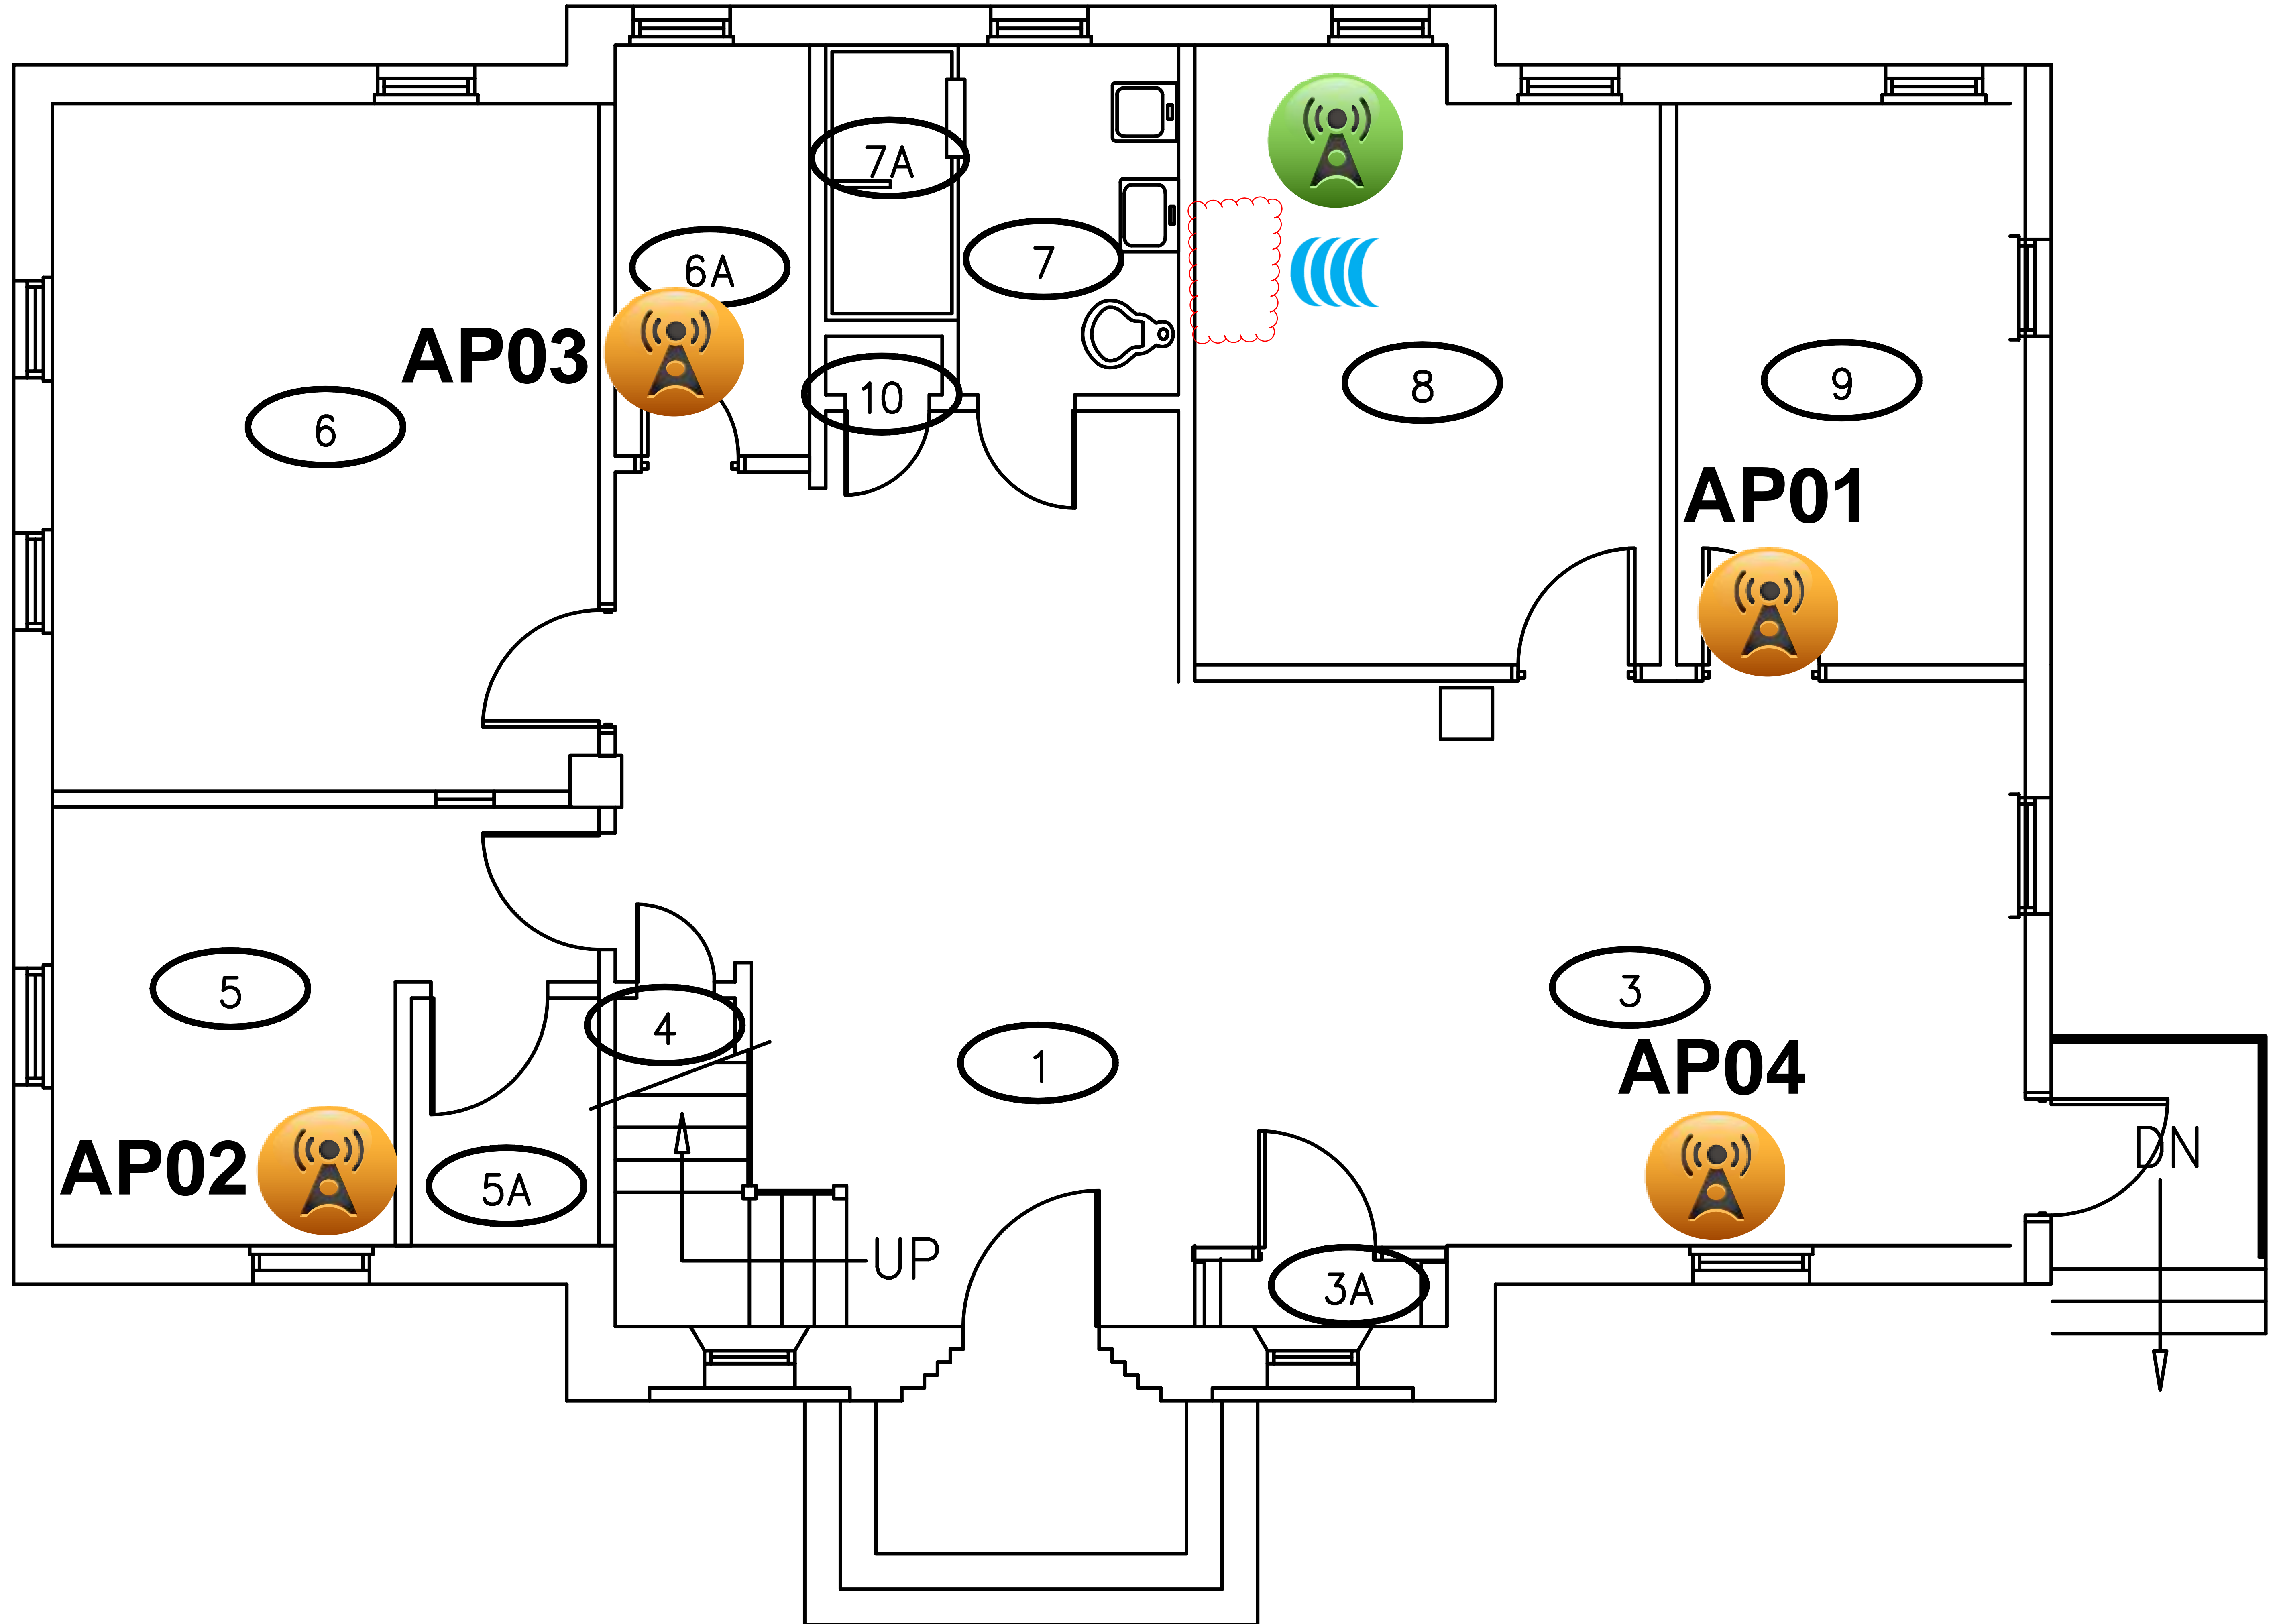





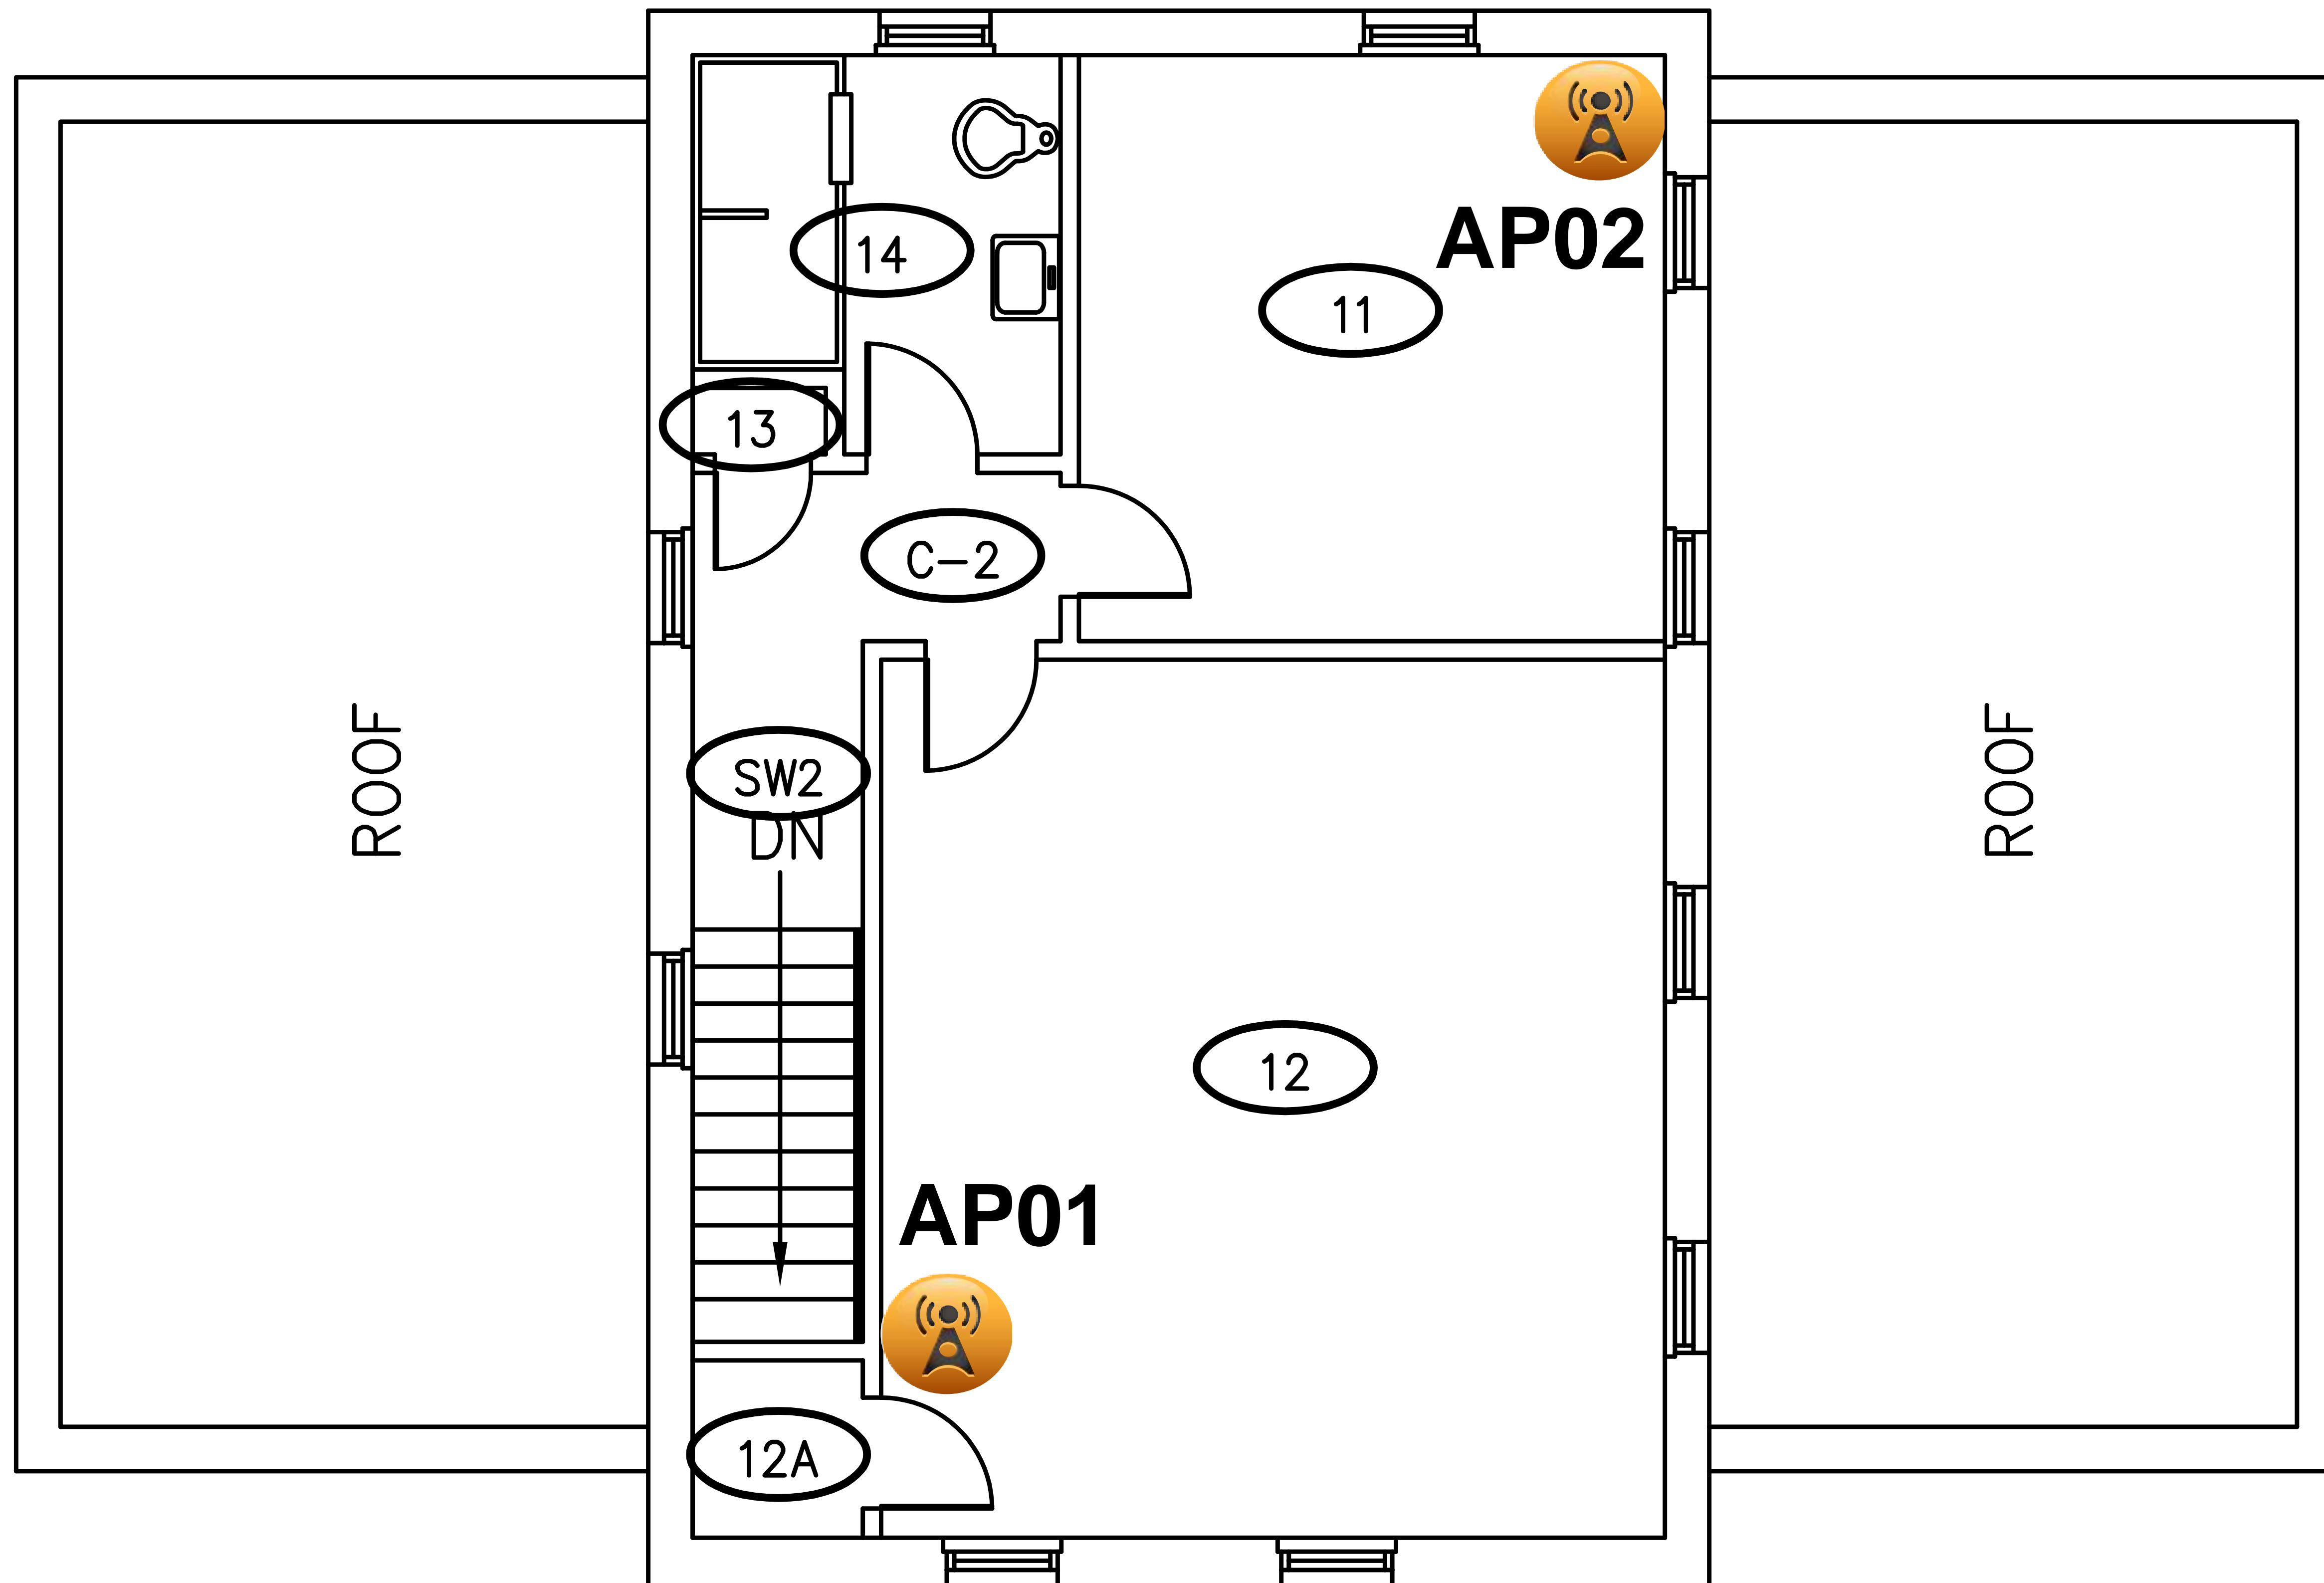

Bay Pines Building 35 - Floor 2

Standard-2

Closet B35-F01-8




-  3502I AP
-  3502I Elevator AP
-  3502E AP
-  Legacy AP
-  Spectrum Capture
-  Wiring Closet

Bay Pines Building 36 - Floor 1

Default


-  3502I AP
-  3502I Elevator AP
-  3502E AP
-  Legacy AP
-  Spectrum Capture
-  Wiring Closet

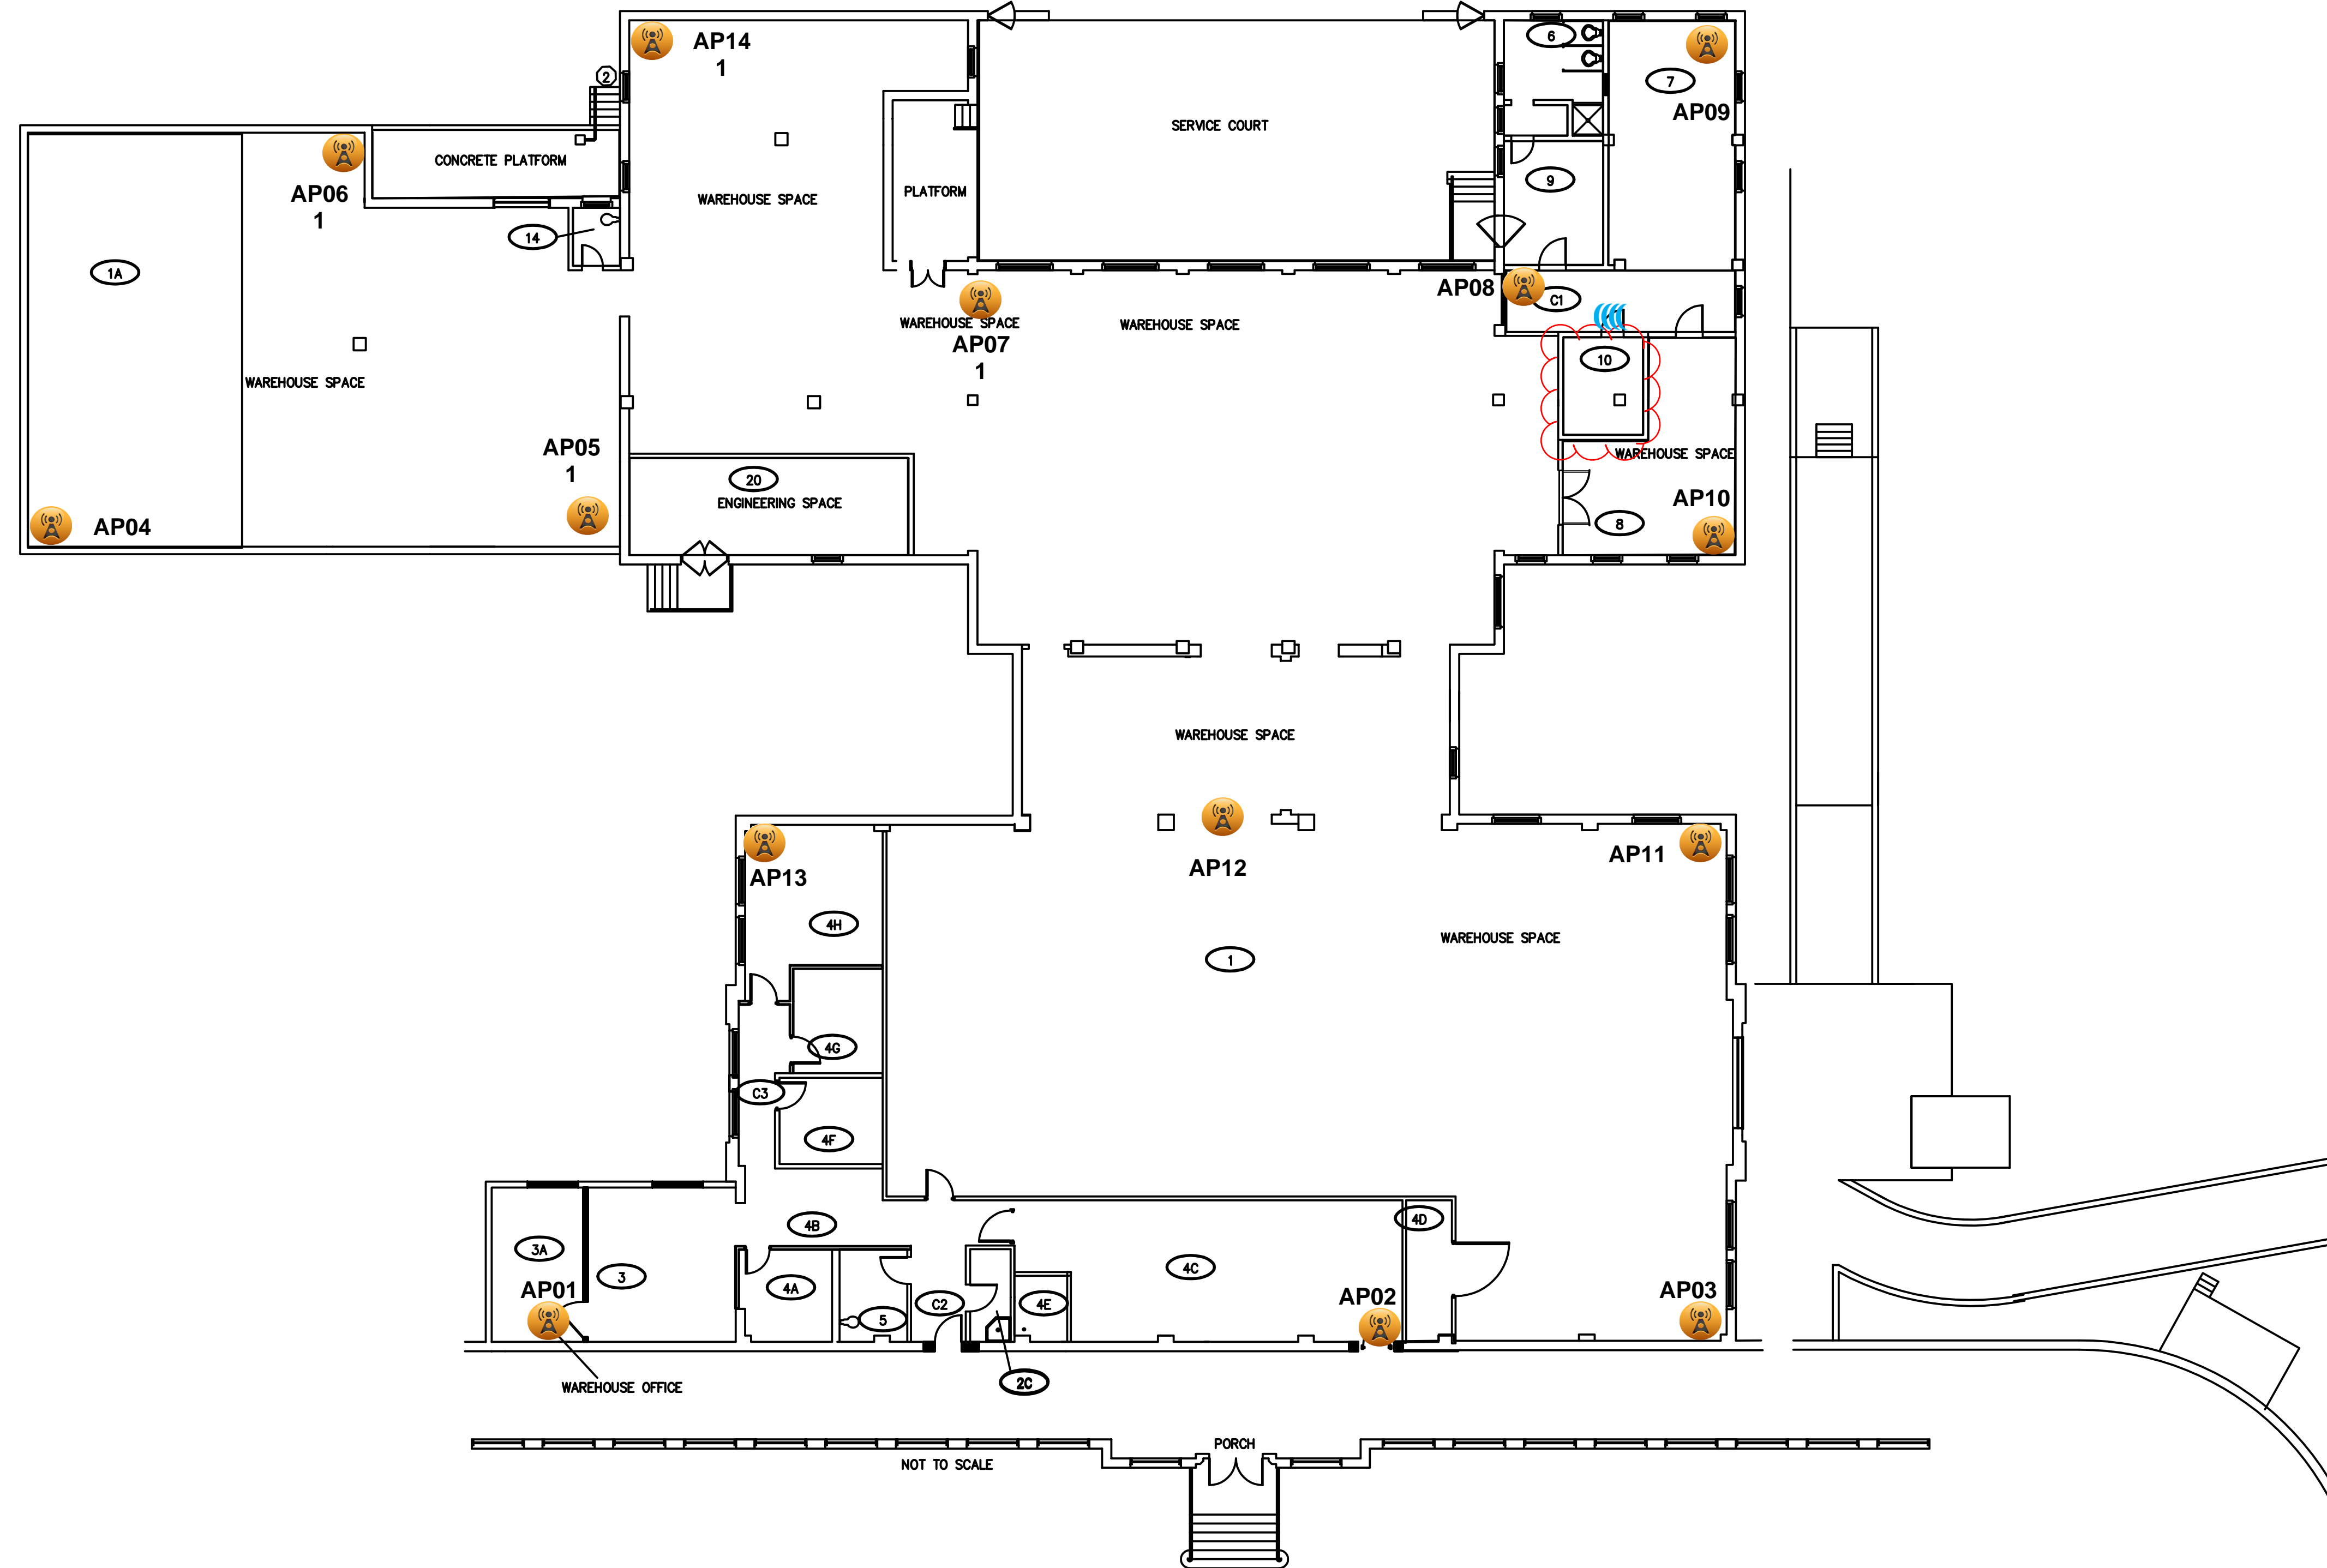

Bay Pines Building 37 - Floor 1





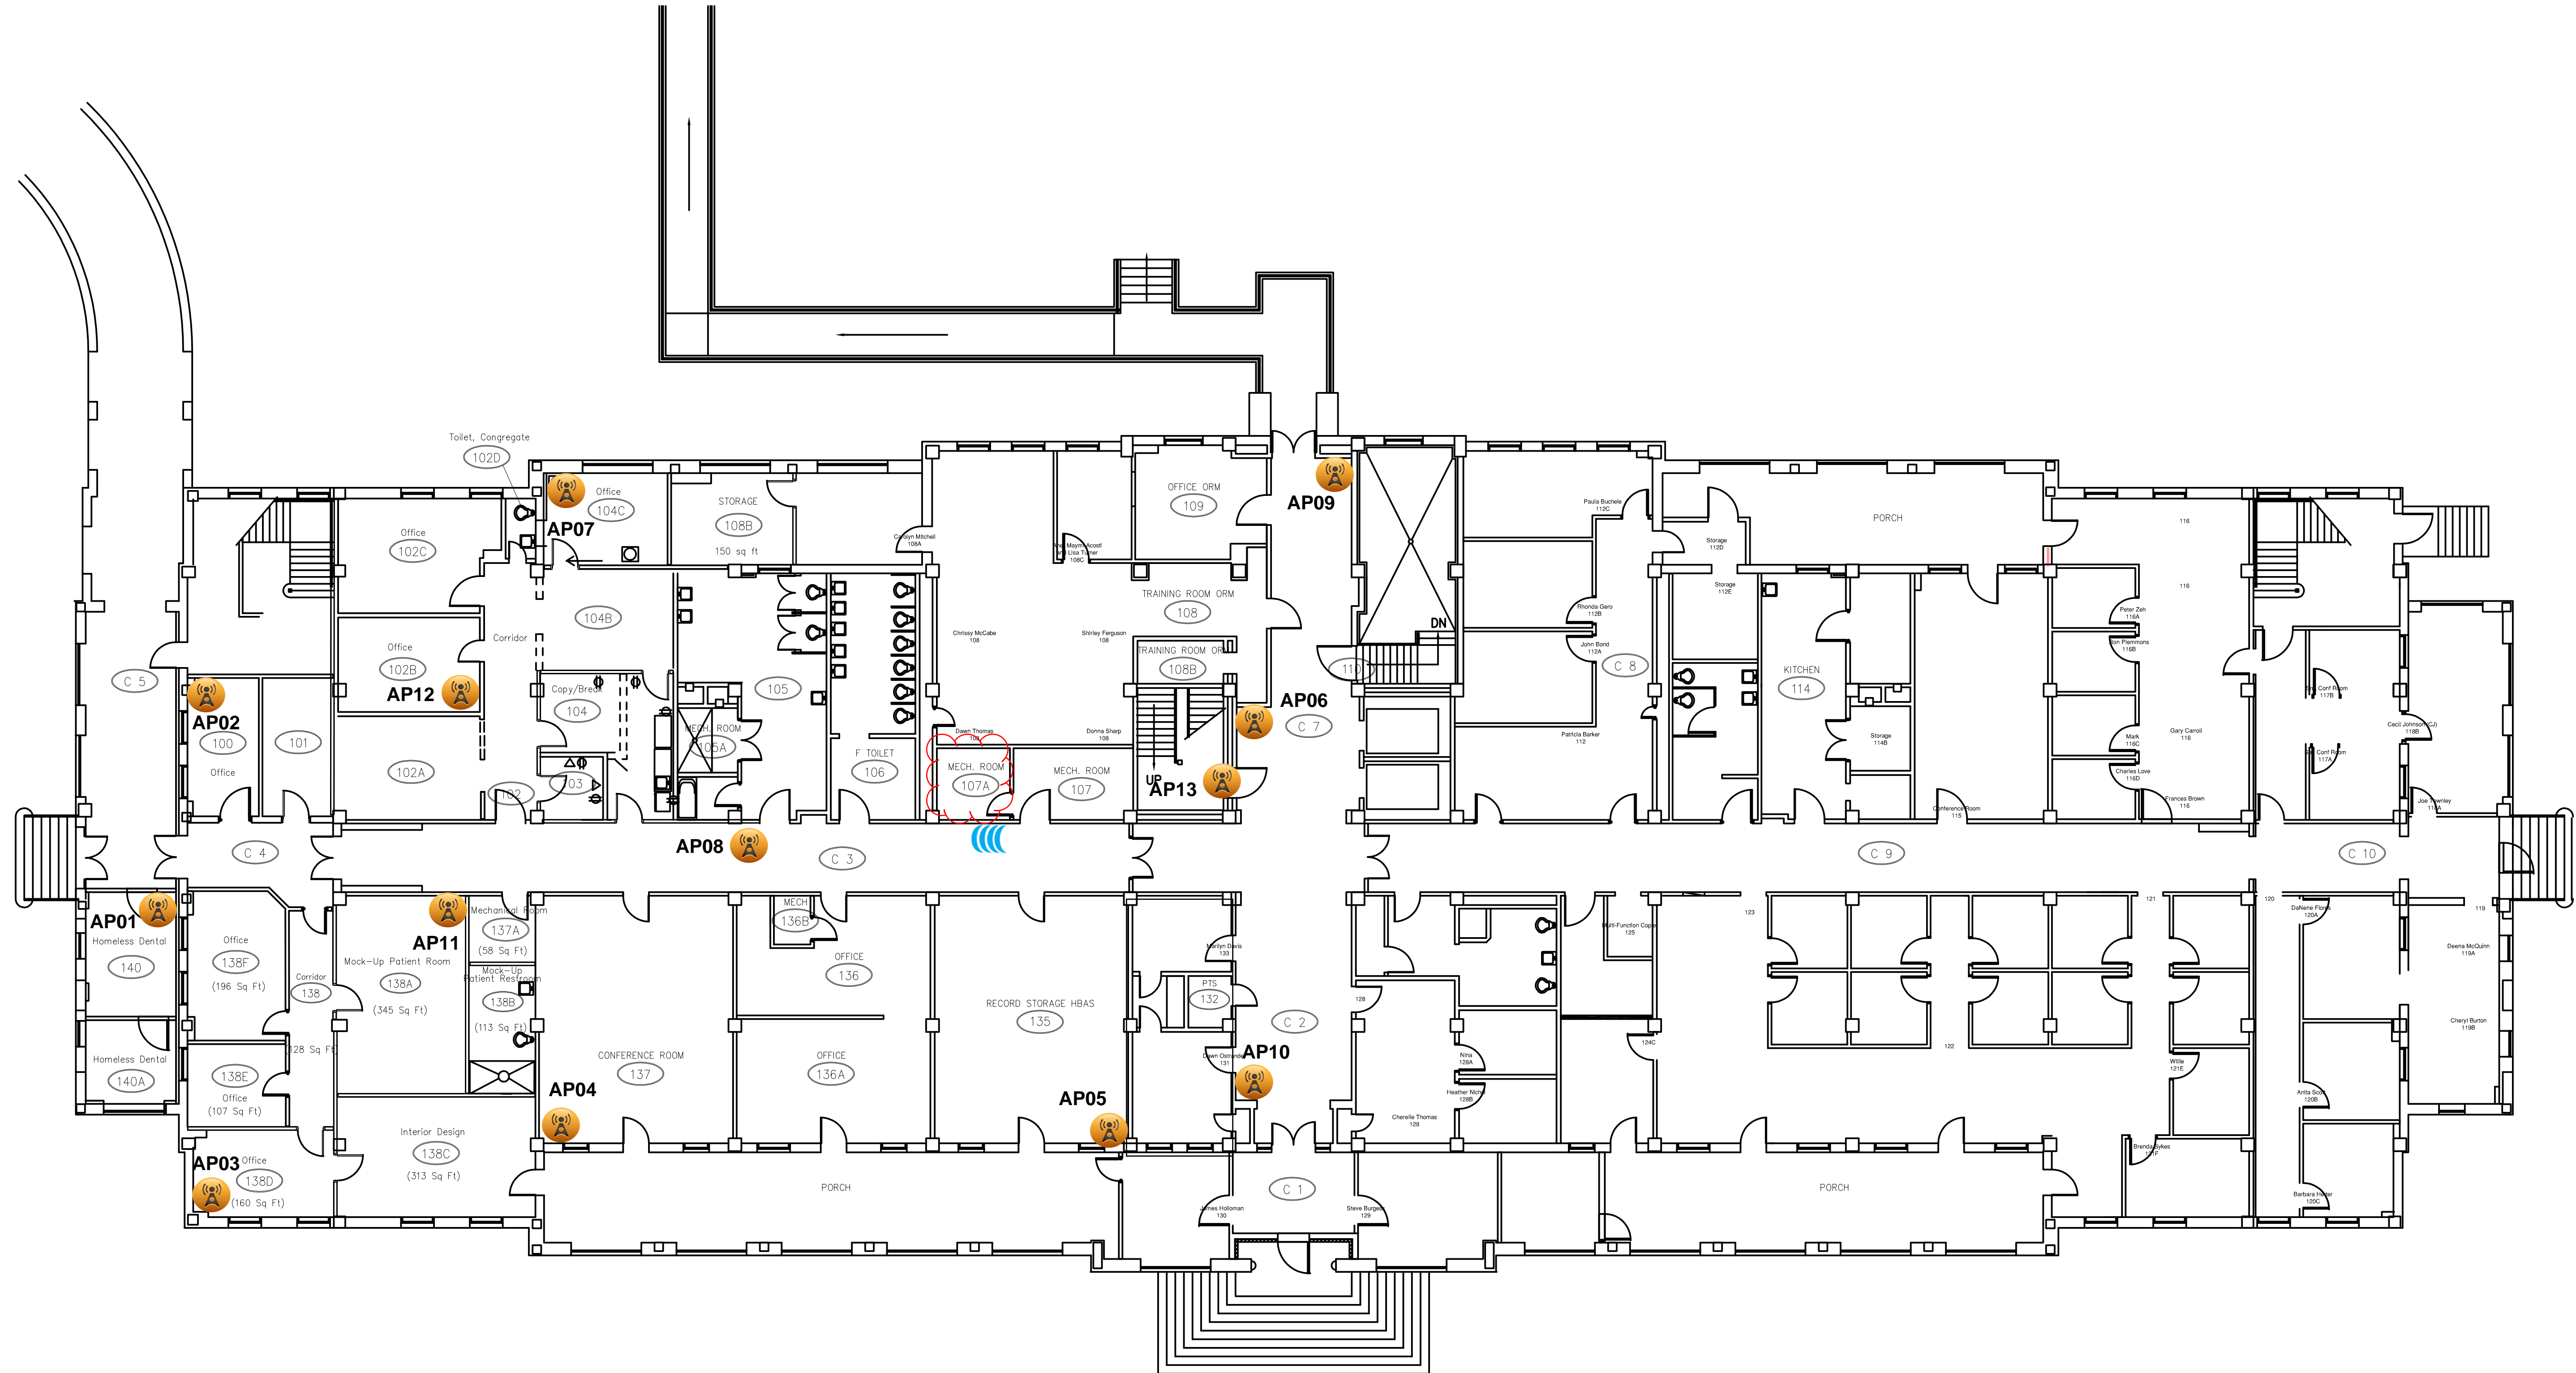

Default


-  3502I AP
-  3502I Elevator AP
-  3502E AP
-  Legacy AP
-  Spectrum Capture
-  Wiring Closet



Bay Pines Building 37 - Floor 3


Default


-  3502I AP
-  3502I Elevator AP
-  3502E AP
-  Legacy AP
-  Spectrum Capture
-  Wiring Closet

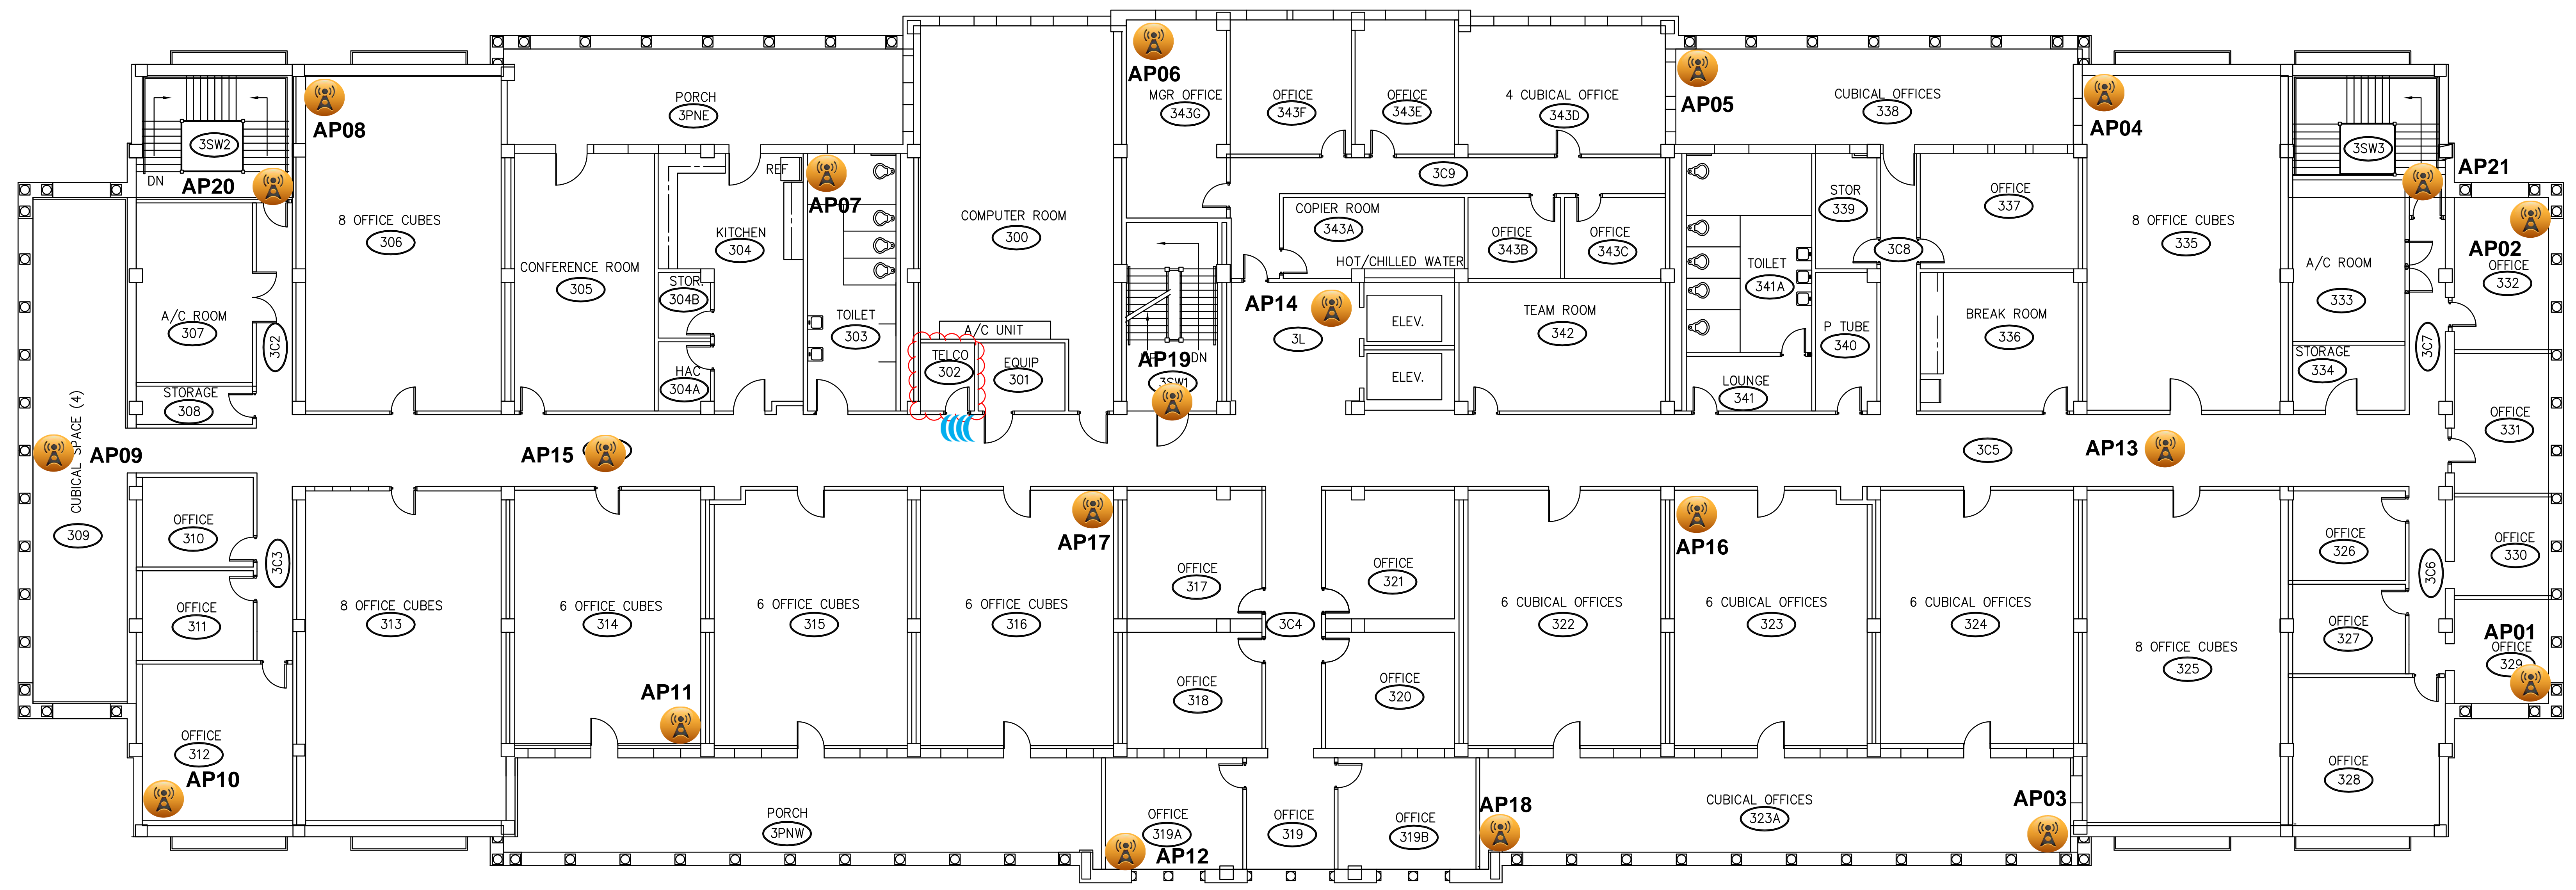

Bay Pines Building 102 - Floor 1 - Section AB



Default

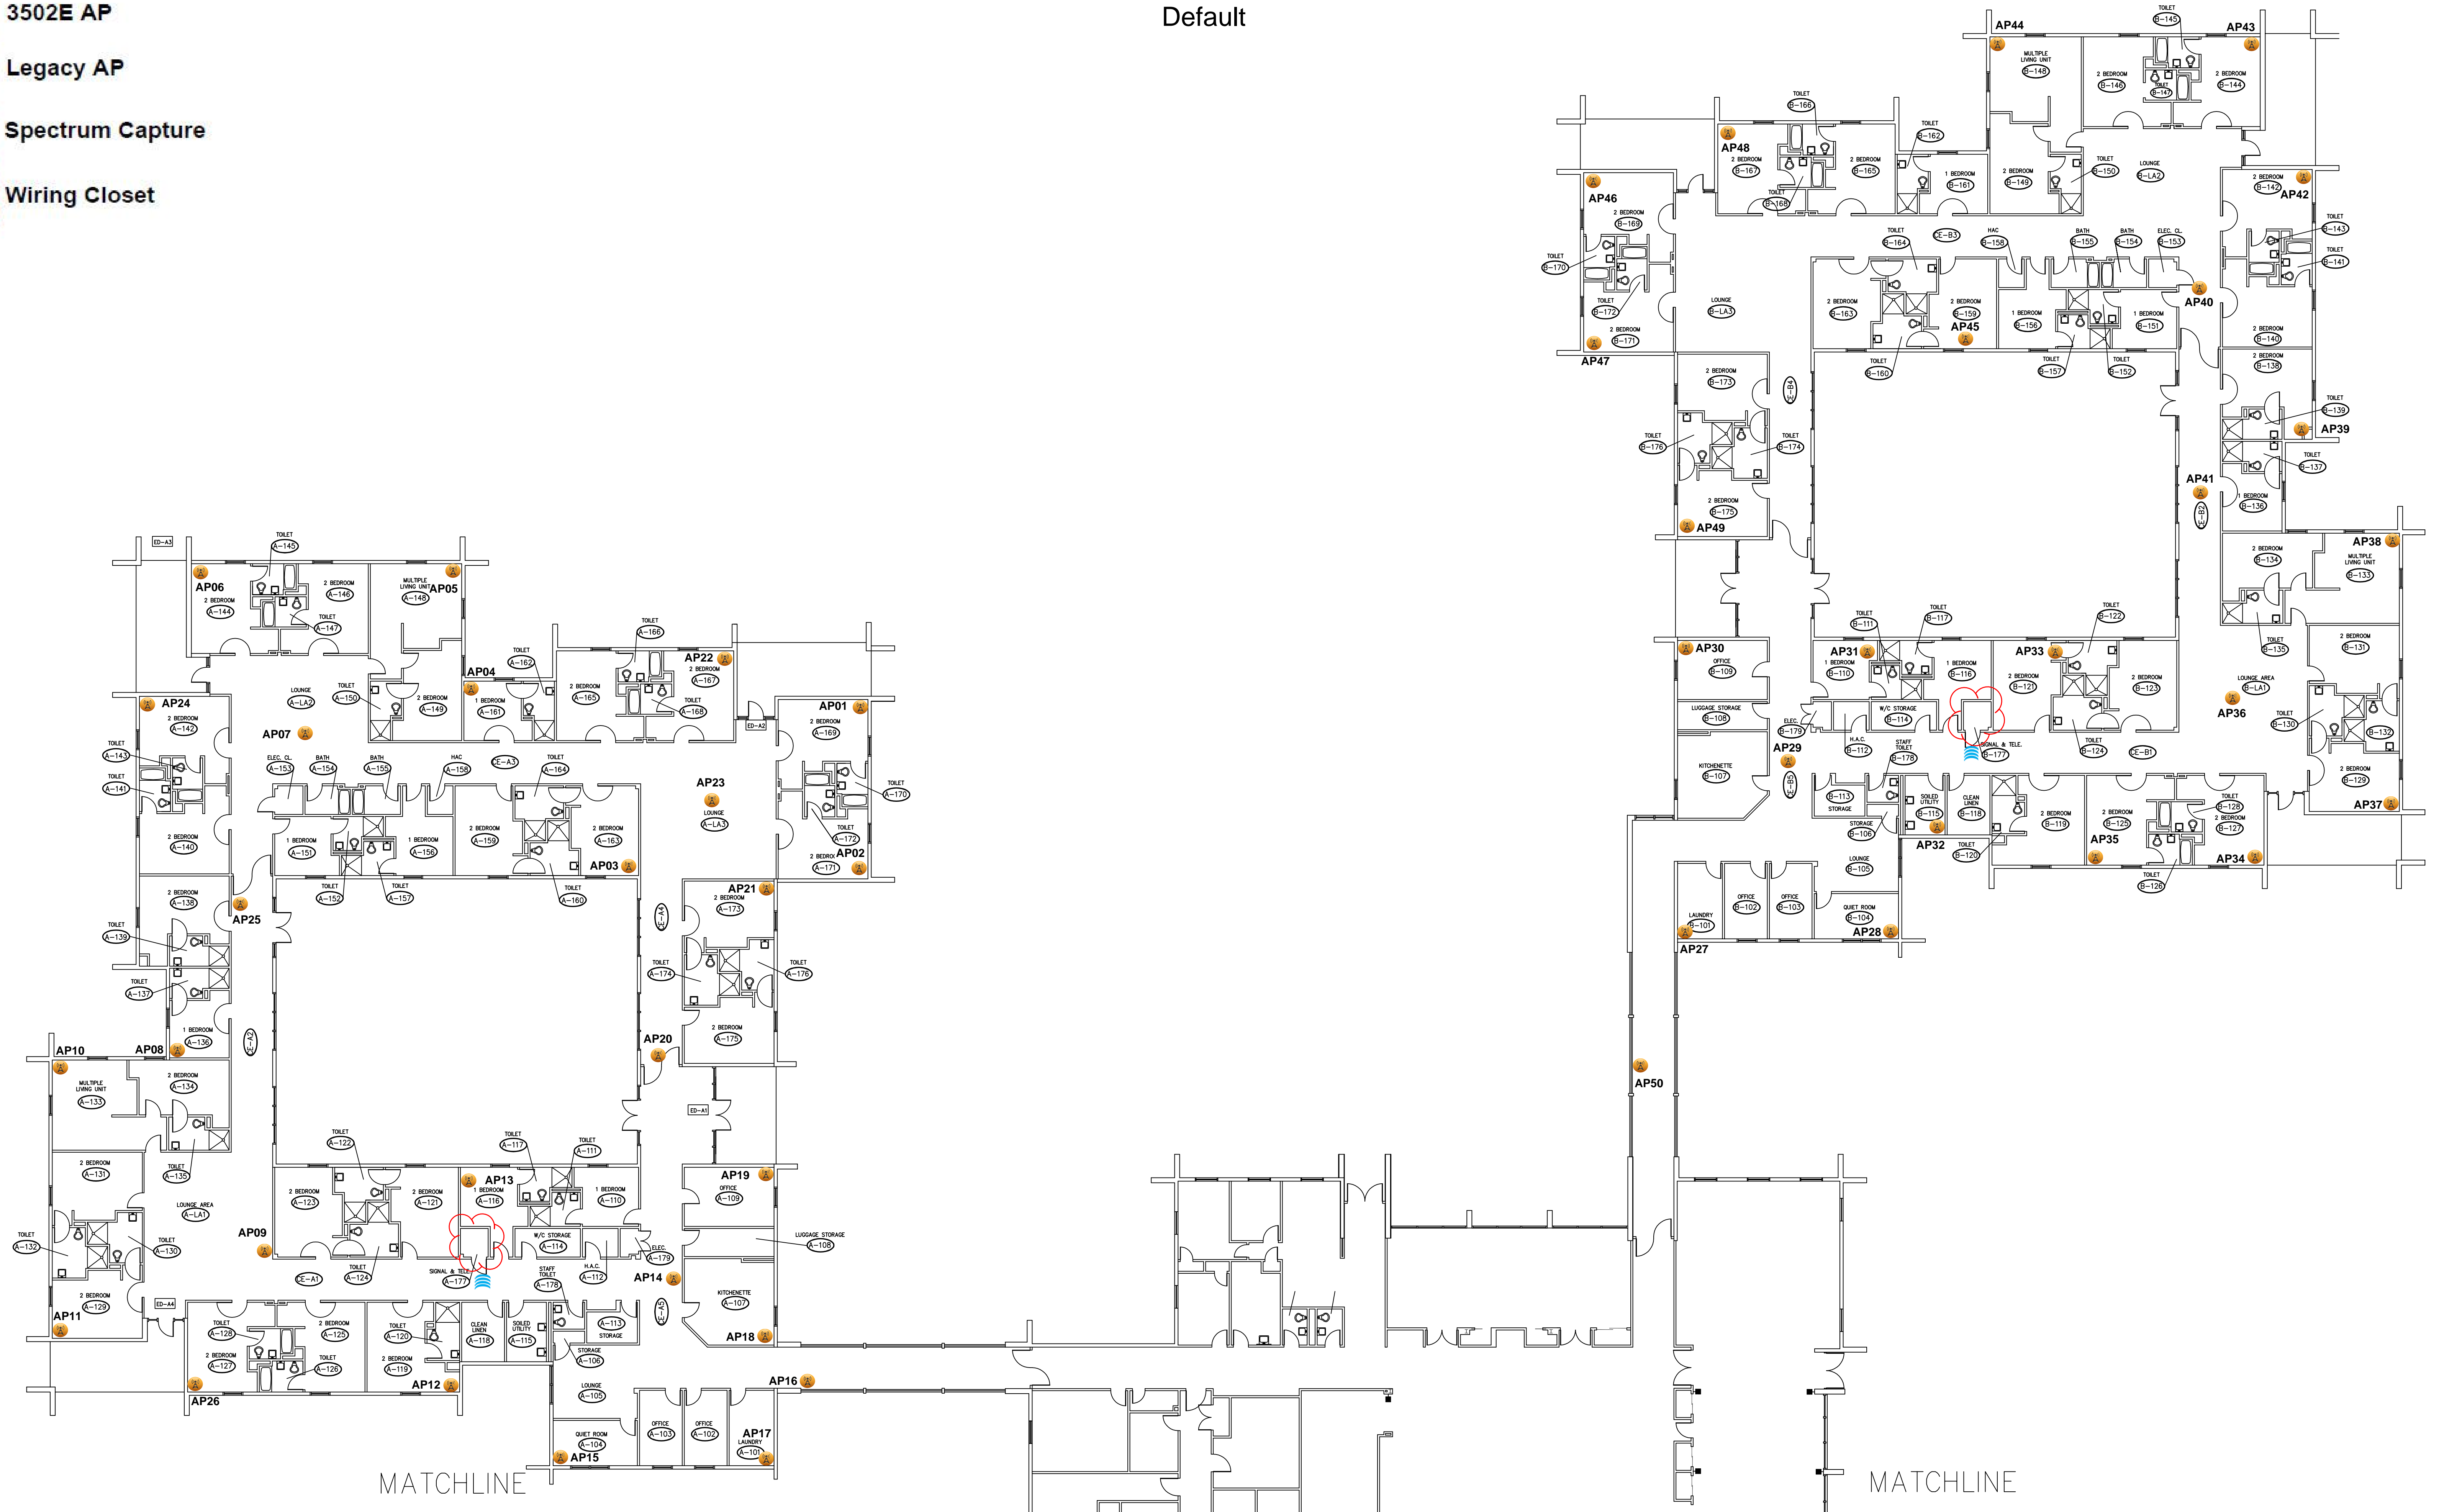
-  3502I AP
-  3502I Elevator AP
-  3502E AP
-  Legacy AP
-  Spectrum Capture
-  Wiring Closet



Bay Pines Building 106 - Floor 2

Default



-  3502I AP
-  3502I Elevator AP
-  3502E AP
-  Legacy AP
-  Spectrum Capture
-  Wiring Closet

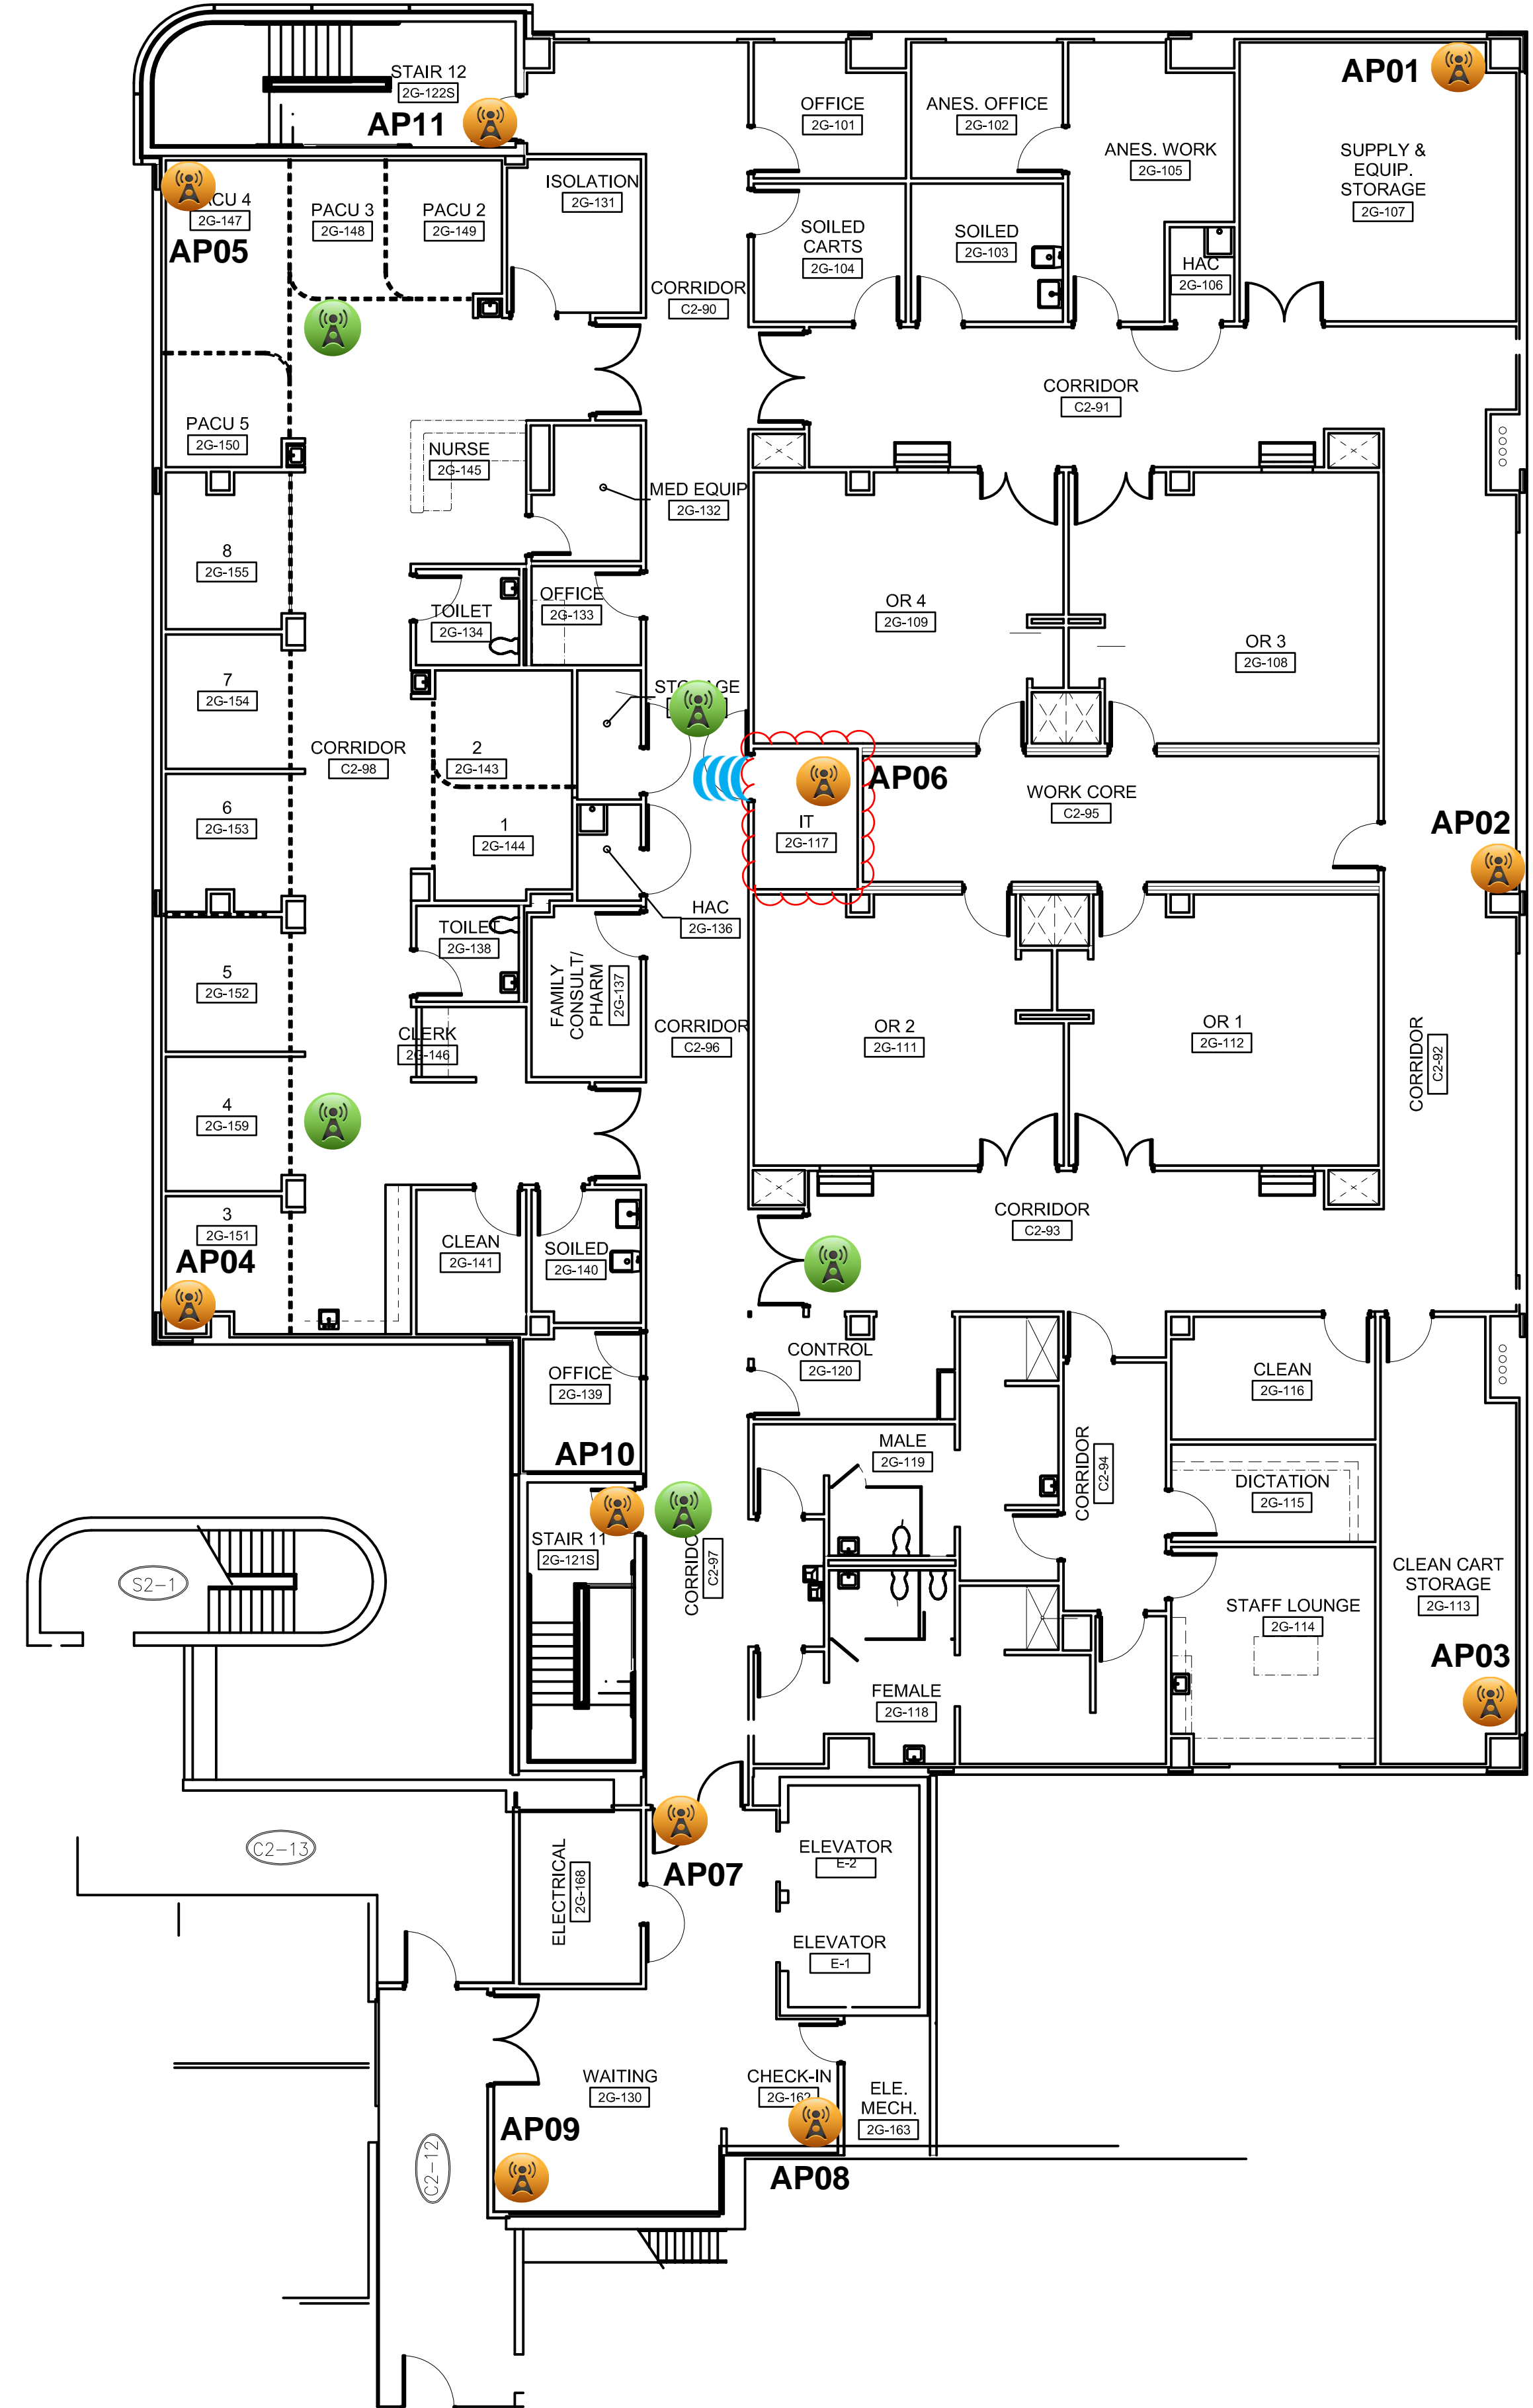

Bay Pines Building 107 - Floor 1


Default

-  3502I AP
-  3502I Elevator AP
-  3502E AP
-  Legacy AP
-  Spectrum Capture
-  Wiring Closet

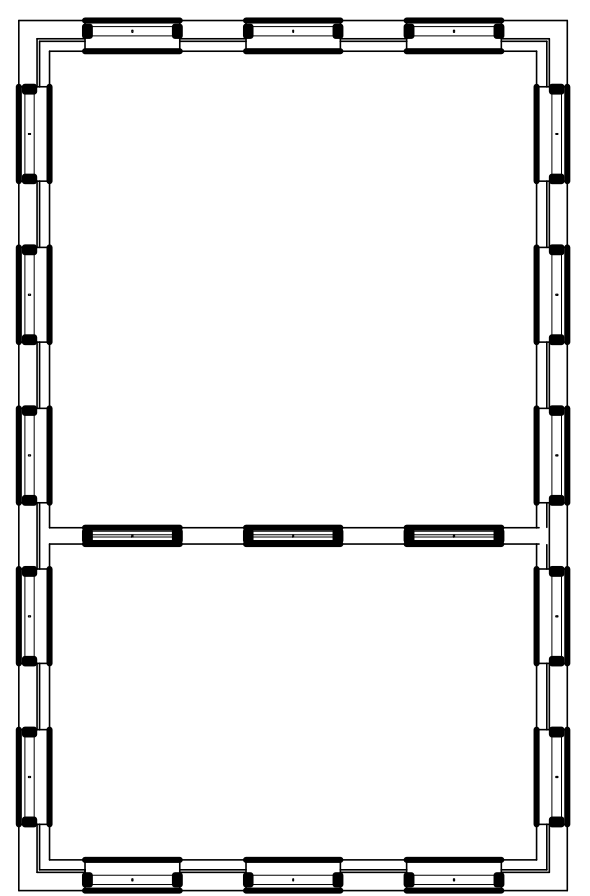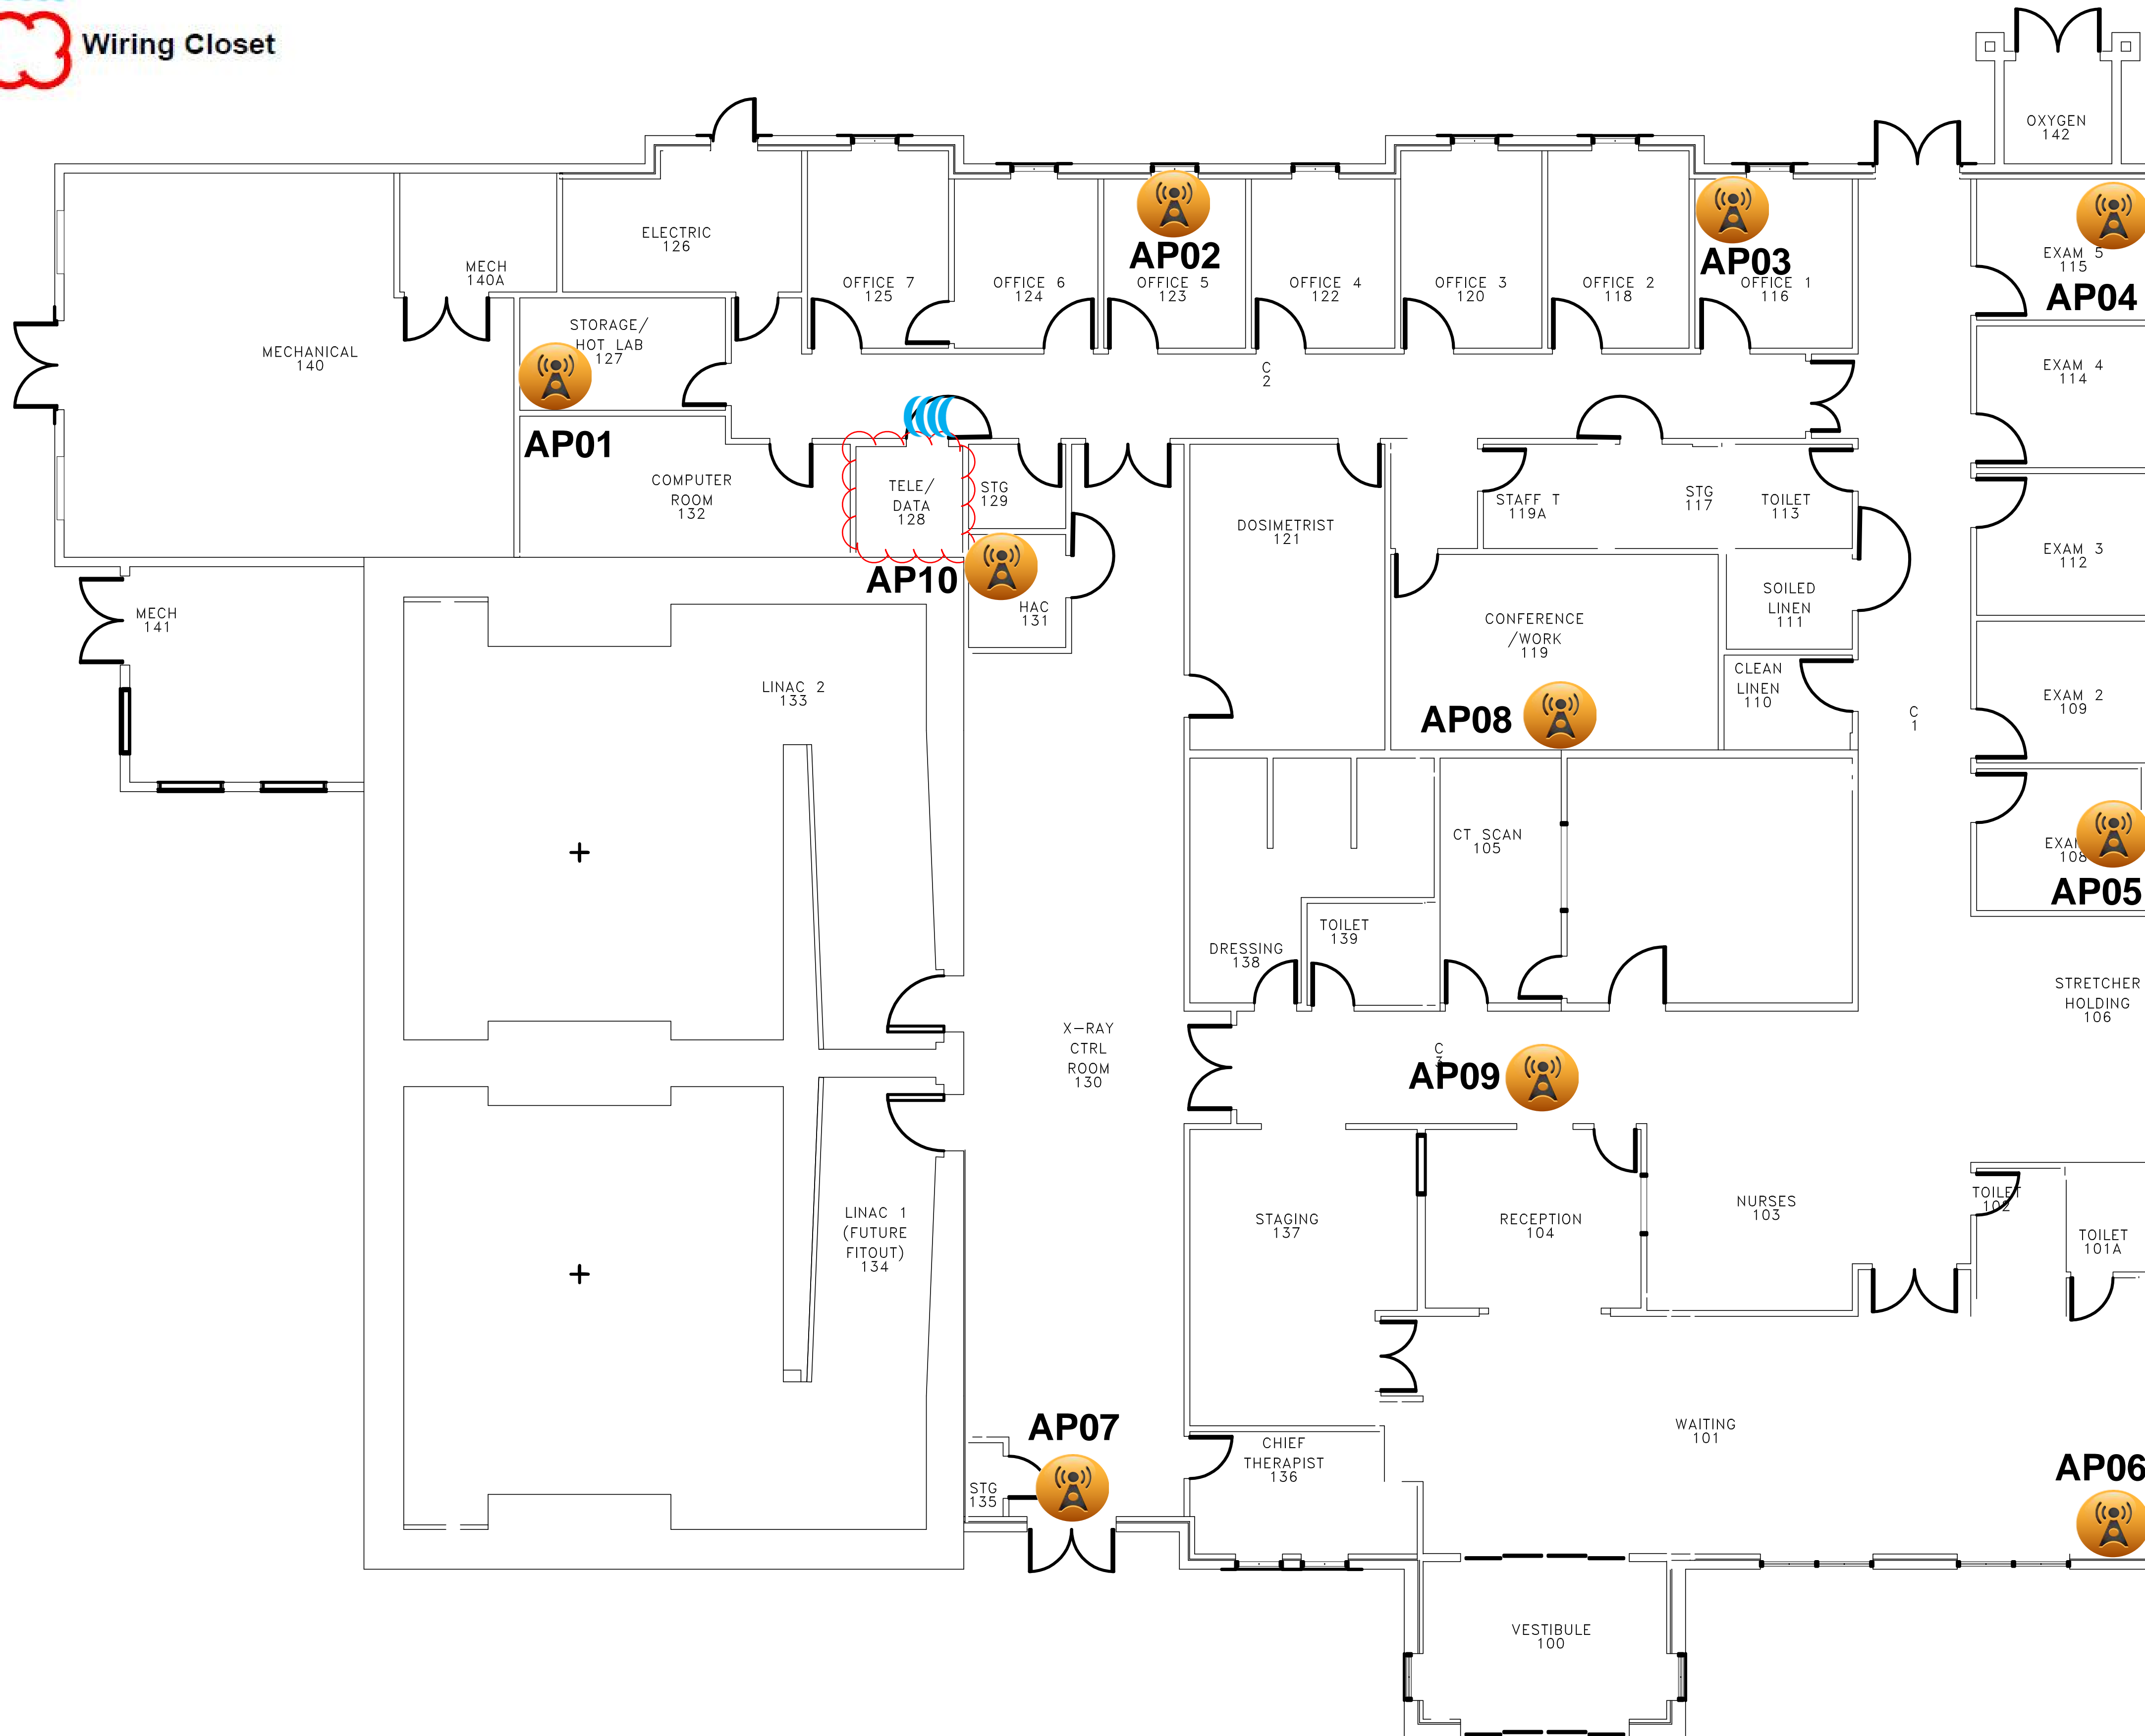

Bay Pines Building 300 - Floor 1

Standard-2

-  3502I AP
-  3502I Elevator AP
-  3502E AP
-  Legacy AP
-  Spectrum Capture
-  Wiring Closet

