


FLOOR PLAN GENERAL NOTES


- A DO NOT SCALE THE DRAWINGS. REFER DISCREPANCIES TO ARCHITECT FOR FINAL DECISIONS ON LAYOUT.
- B ALL DIMENSIONS SHOWN ARE TO FACE OF WALL FRAMING/ MASONRY UNLESS NOTED OTHERWISE. DIMENSIONS DESIGNATES AS "CLR" OR "CLEAR" INDICATE A CLEAR DIMENSION FROM FACE OF FINISH TO FACE OF FINISH.
- C PROVIDE BRACING AND FIRE-TREATED BLOCKING AS REQUIRED IN WALLS SUPPORTING CASEWORK, TACKBOARDS, MARKERBOARDS, RESTROOM ACCESSORIES, ETC.
- D PROVIDE SEALJOINTS BETWEEN DISSIMILAR MATERIALS.
- E VERIFY EXISTING FIELD CONDITIONS PRIOR TO BEGINNING WORK, AND REPORT DISCREPANCIES IMMEDIATELY TO ARCHITECT FOR CLARIFICATION.
- F MOUNT TOP OF WALL CABINETS @ 7'-0" A.F.F., UNLESS NOTED OTHERWISE. REFER QUESTIONABLE MOUNTING HEIGHT CHOICES TO ARCHITECT FOR FINAL DECISIONS.
- G ALL GYPSUM WALLBOARD IS 5/8" TYPE "X" UNLESS NOTED OTHERWISE.
- H CONFLICTS BETWEEN SPECIFICATIONS AND DRAWINGS SHALL BE COMMUNICATED TO THE ARCHITECT FOR RESOLUTION PRIOR TO COMMENCEMENT OF THE WORK.
- I SUPPLY, COORDINATE AND INSTALL ACCESS DOORS, PANELS AND HATCHES IN CEILINGS, WALLS AND FLOORS; AND NOTIFY ARCHITECT OF ANY CONFLICTS WITH FEATURES SHOWN ON DRAWINGS.
- J PROVIDE WATER ROUGH-IN AND ELECTRICAL CONNECTIONS FOR OWNER-PROVIDED EQUIPMENT IN COMPLIANCE WITH MEP DRAWINGS.
- K PROVIDE SLIP CHANNELS AT ALL LOCATIONS WHERE WALLS EXTEND TO A STRUCTURAL MEMBER ABOVE.
- L DOORS TO BE INSTALLED 6" FROM CORNER TO INSIDE OF DOOR FRAME UNLESS NOTED OTHERWISE- TYPICAL
- M PROVIDE CONTROL JOINT IN ALL GYPSUM BOARD WALLS GREATER THAN 30' LONG. PLACE CONTROL JOINTS AT CORNERS OF DOORS OR WINDOWS.
- N PATCH EXISTING WALLS WHERE NEW WALLS MEET ACCORDING TO DRAWING SPECIFICATIONS
- O PATCH, REPAIR AND CLEAN EXISTING WALLS. REF. FINISH SCHEDULE FOR NEW WALL FINISH, BASE AND FLOOR FINISH

FLOOR PLAN NOTES


- A.1 PATCH OR FILL WALL WITH CMU OR METAL STUD TO MATCH EXISTING ADJACENT THICKNESS AND FINISH
- A.2 FURR-OUT WALLS WITH METAL STUDS AND SPRAY FOAM INSULATION, FINISH WITH 5/8" TYPE "X" GYP.
- A.3 FURR-OUT ROOF WITH 5 1/2" METAL STUDS, SPRAY FOAM INSULATION, FINISH WITH 5/8" TYPE "X" GYP.
- A.4 INSTALL SALVAGED METAL LOCKERS, SINGLE DOOR, 60" TALL, 12" X 12" BASE
- A.5 REPAIR AND PROVIDE SUBFLOOR TO ALIGN NEW FINISH FLOOR WITH ADJACENT FLOOR
- A.6 REPLACE WINDOWS RE: SHEET AS 800. ALTERNATE #3 EXISTING TO REMAIN, APPLY LOW-E WINDOW FILM
- A.7 PROVIDE LIGHT PROOF SHADES RE: SPECIFICATIONS

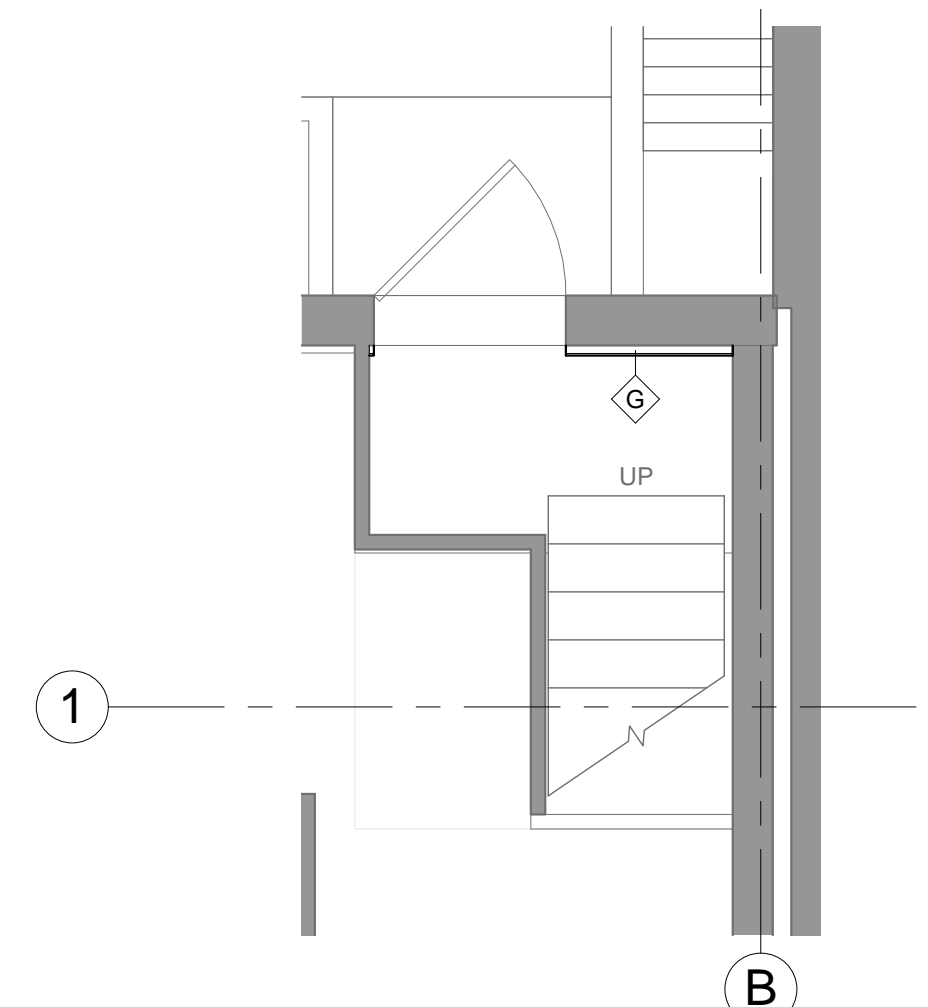


7 EXIT STAIR LANDING PLAN
AS101 1/4" = 1'-0"

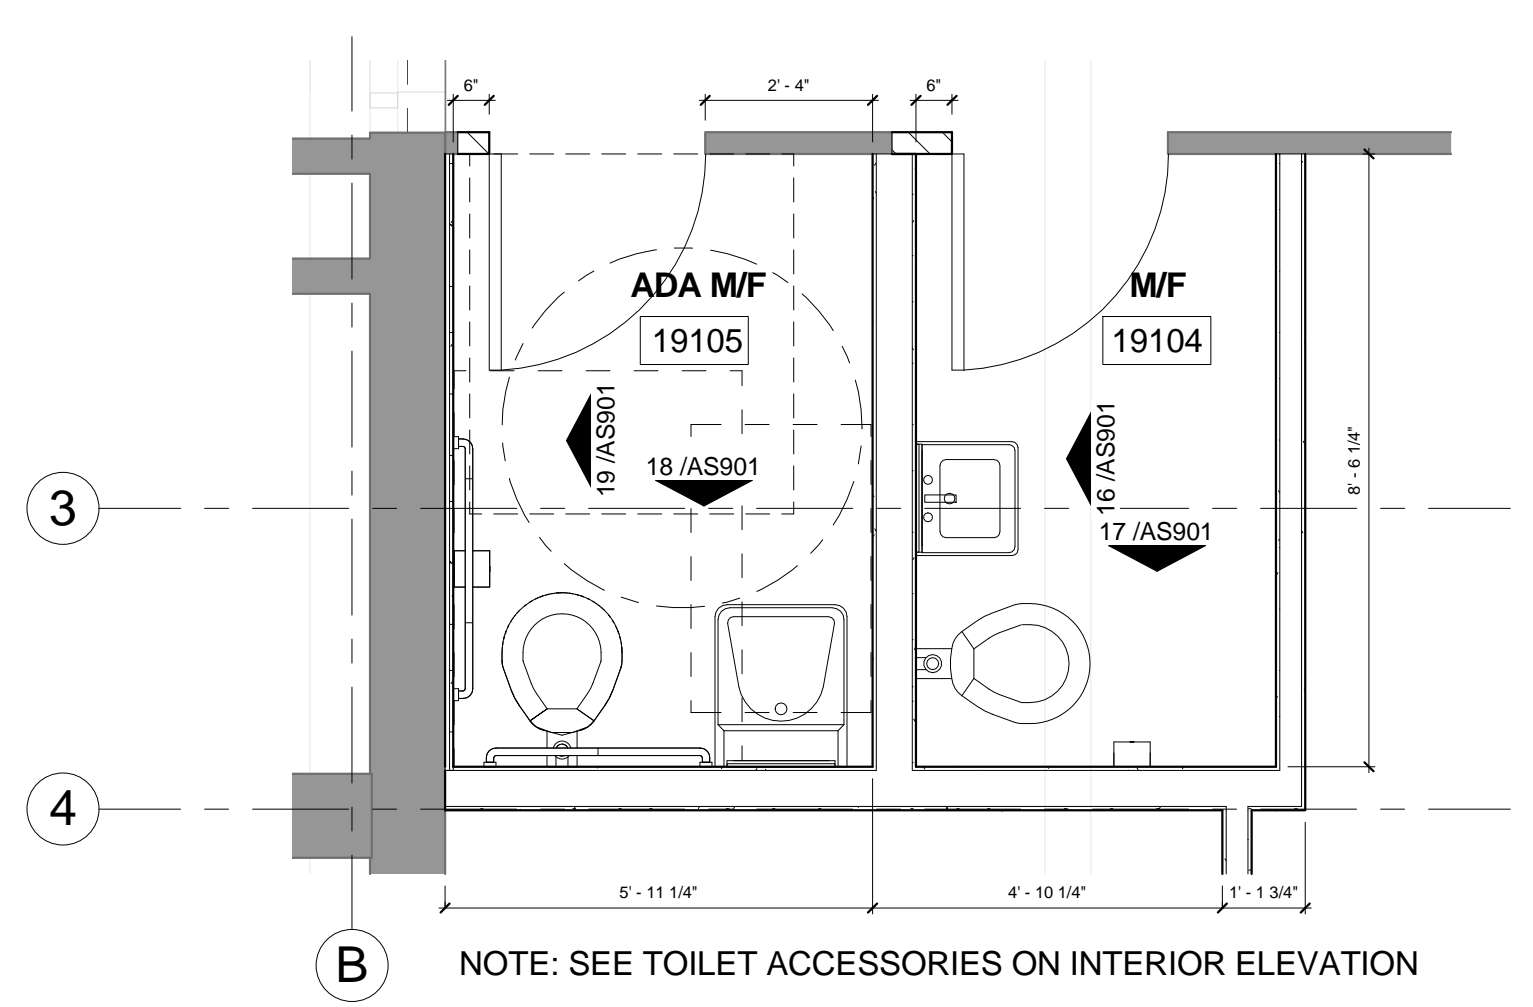


6 FIRST FLOOR RESTROOM PLAN
AS101 3/8" = 1'-0"

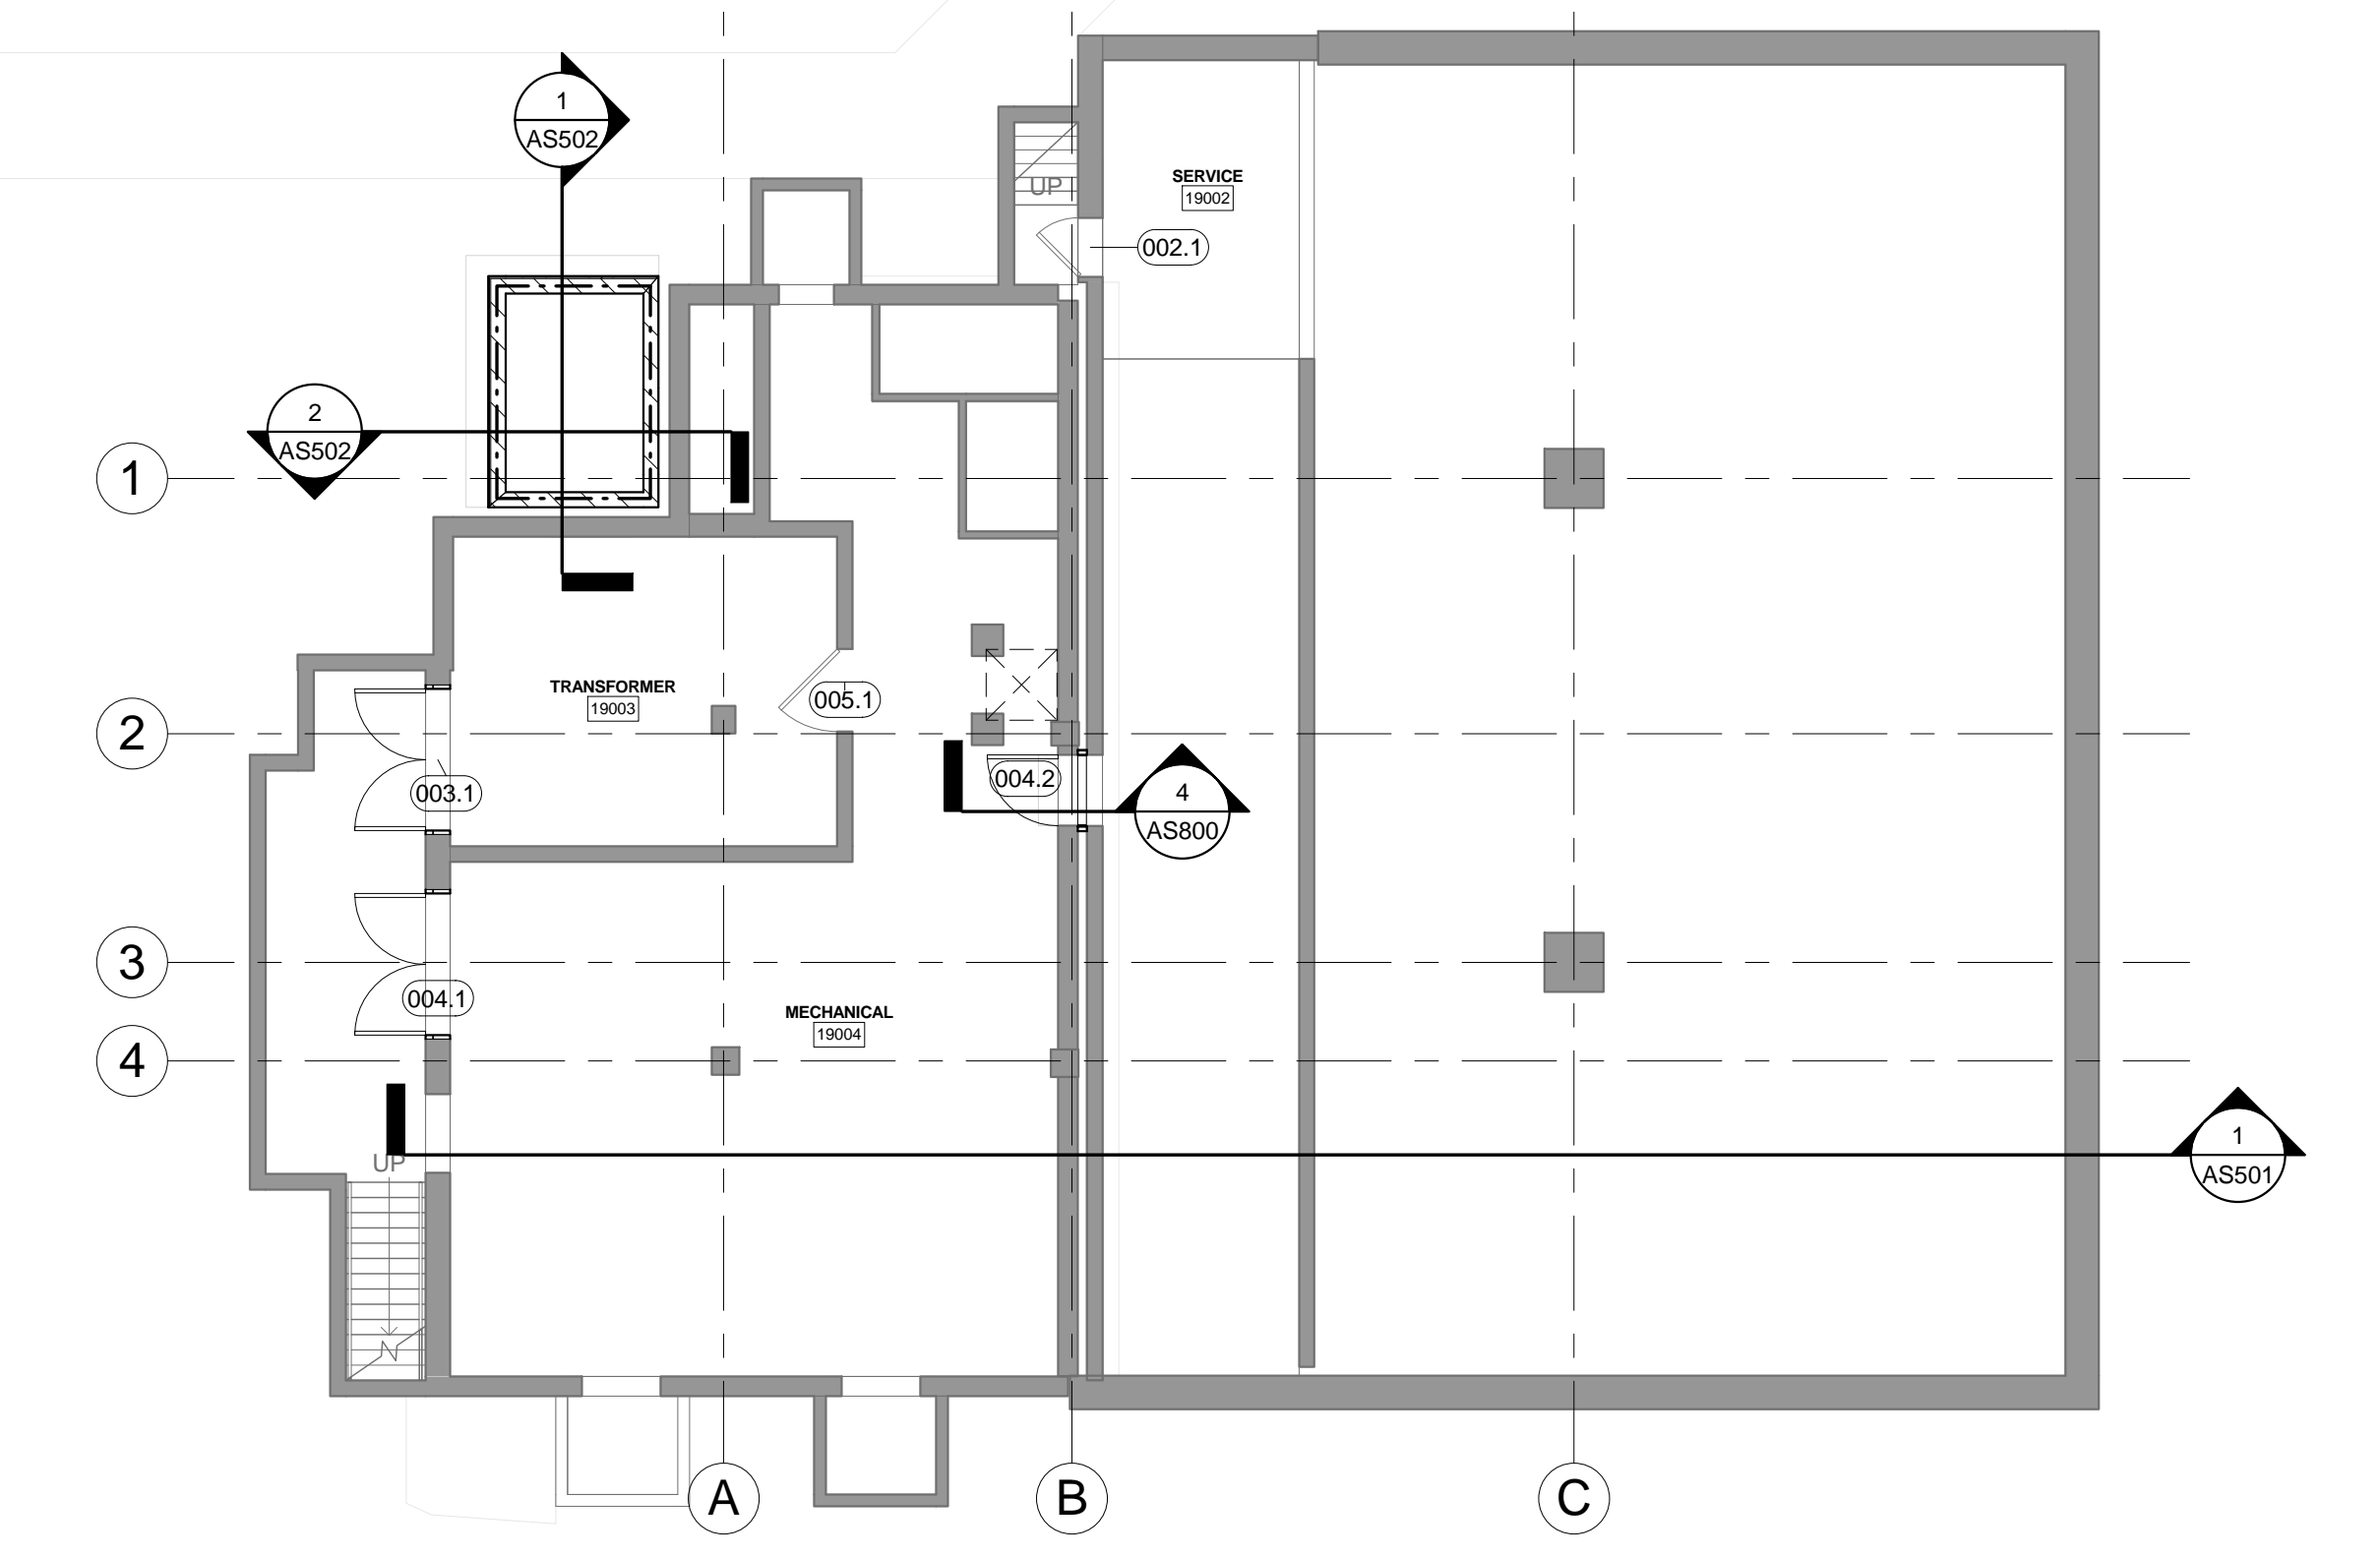


1 BASEMENT FLOOR PLAN
AS101 1/8" = 1'-0"

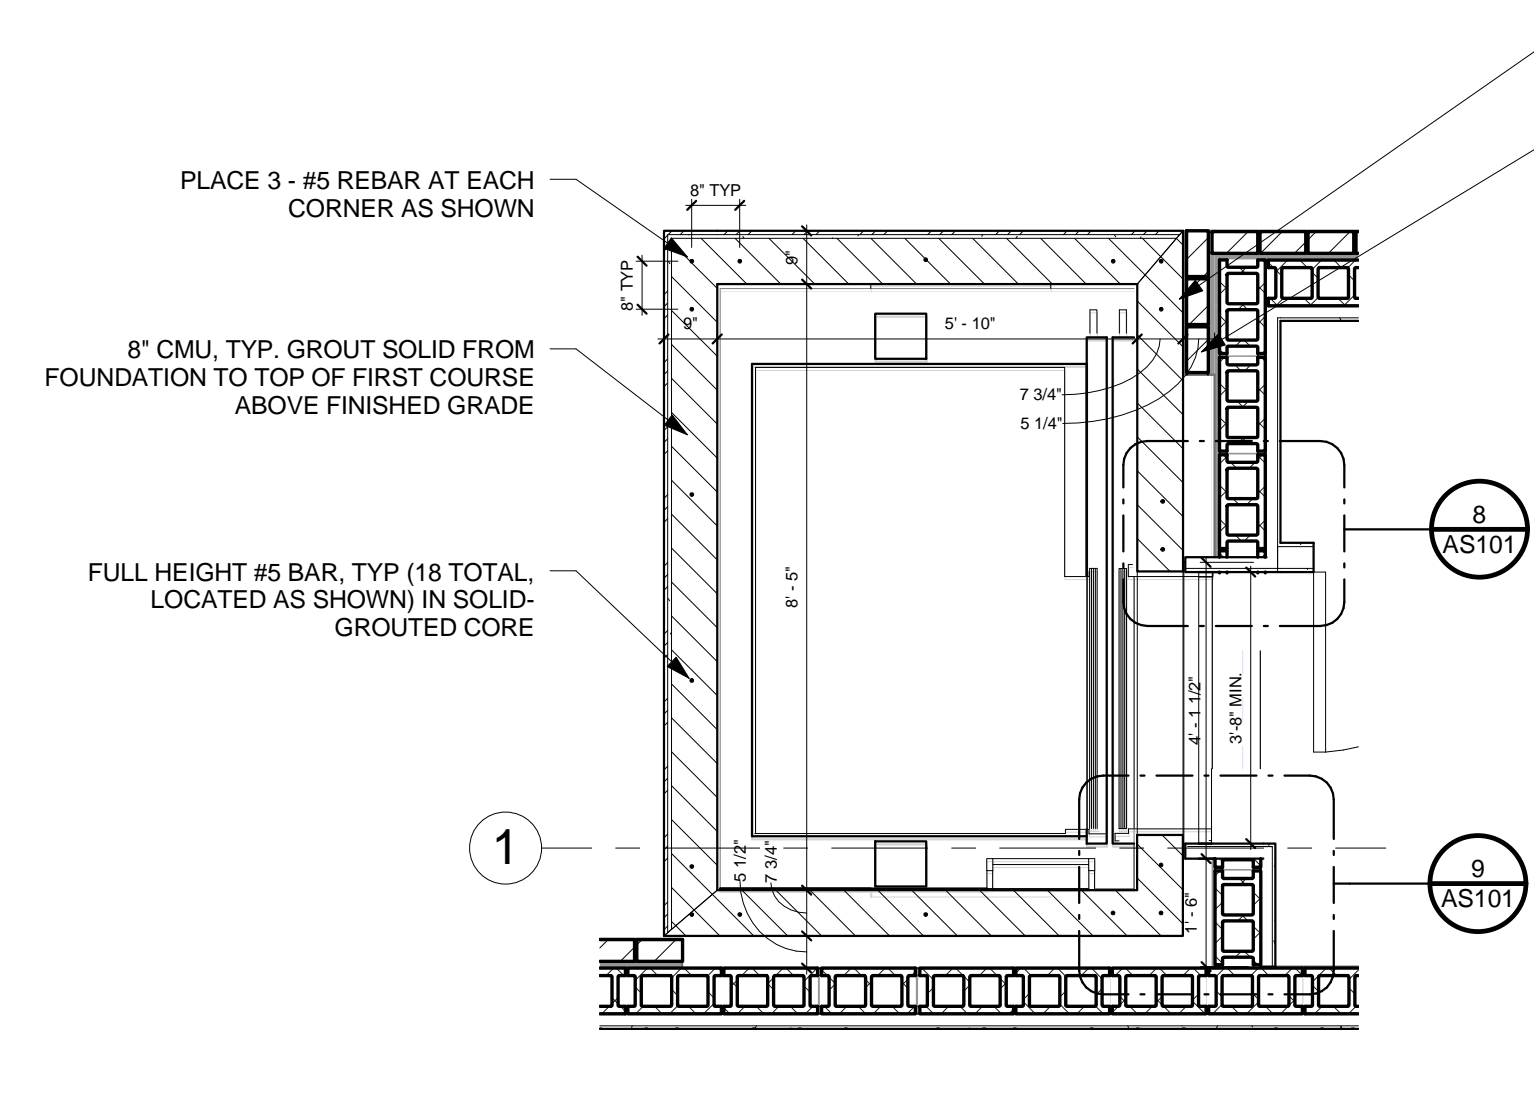


5 SECOND FLOOR ELEVATOR PLAN
AS101 3/8" = 1'-0"

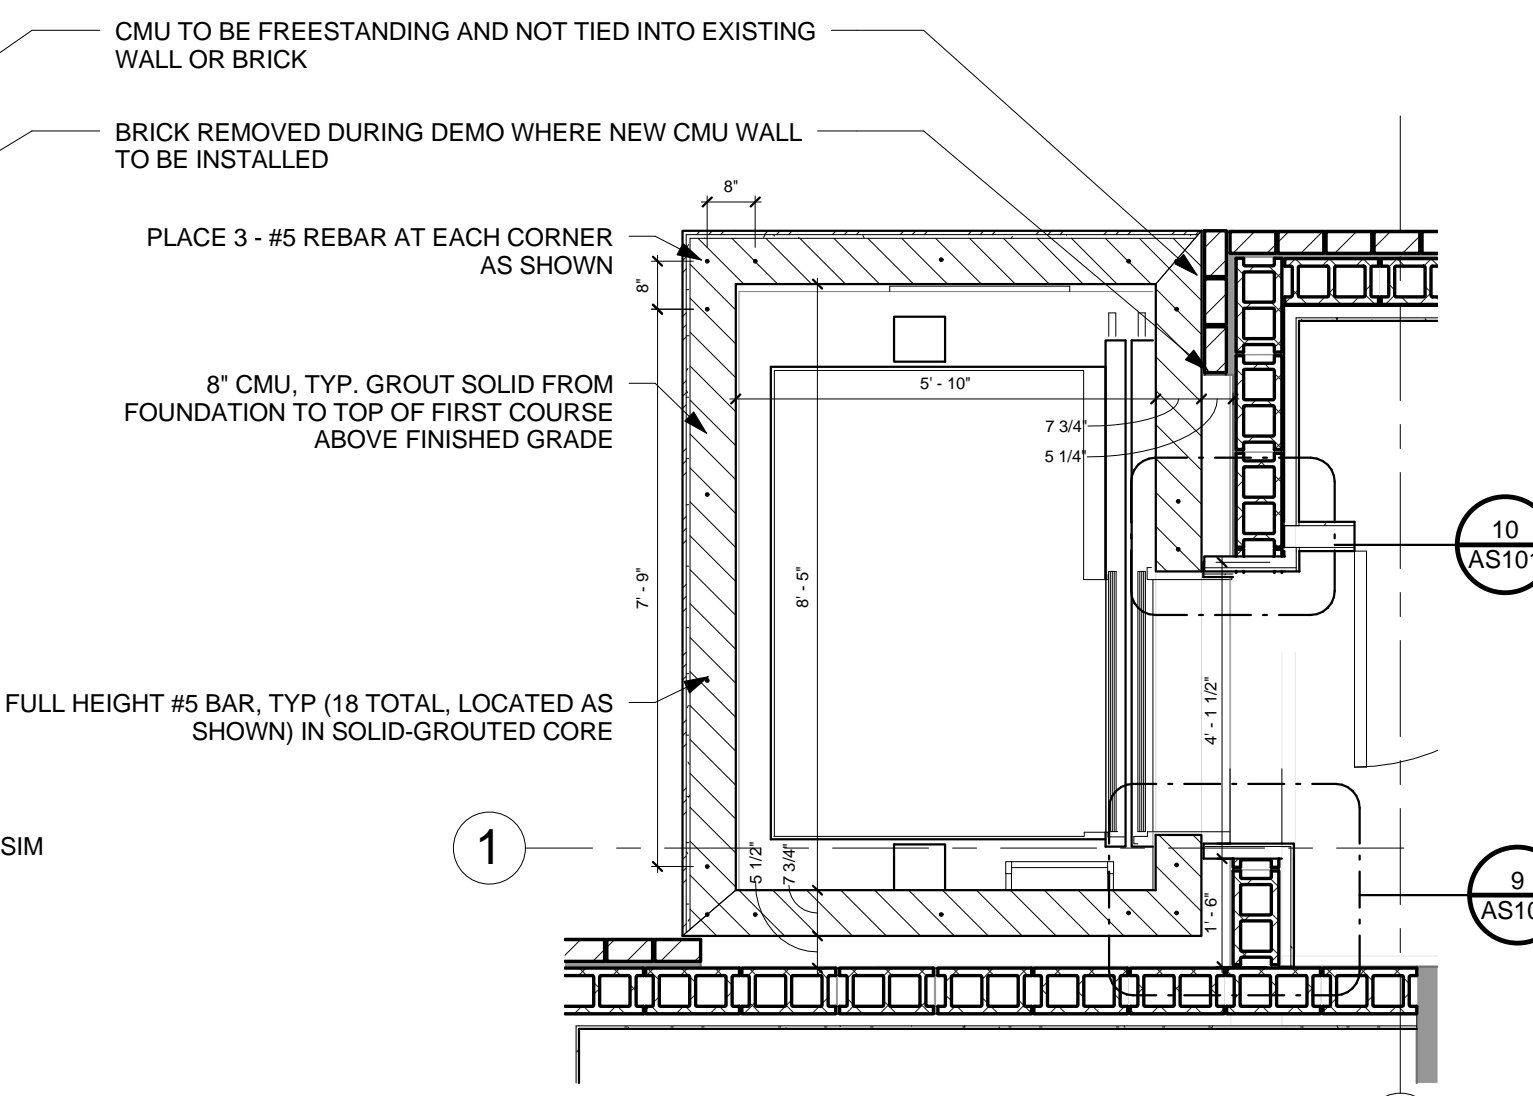


4 FIRST FLOOR ELEVATOR PLAN
AS101 3/8" = 1'-0"

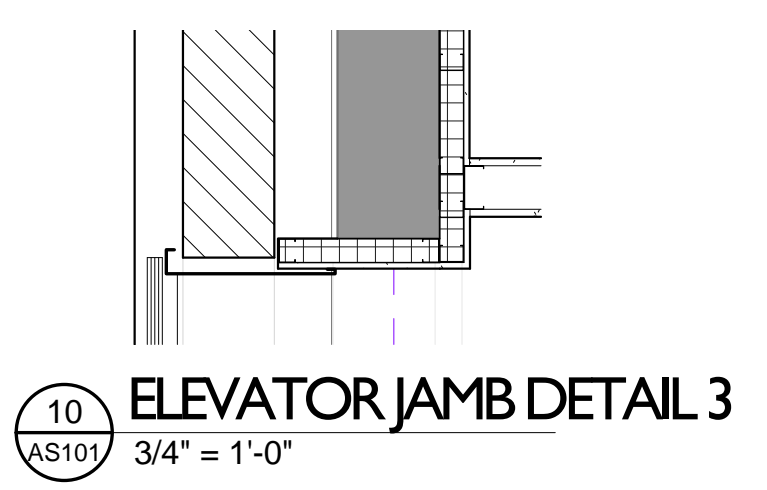


10 ELEVATOR JAMB DETAIL 3
AS101 3/4" = 1'-0"

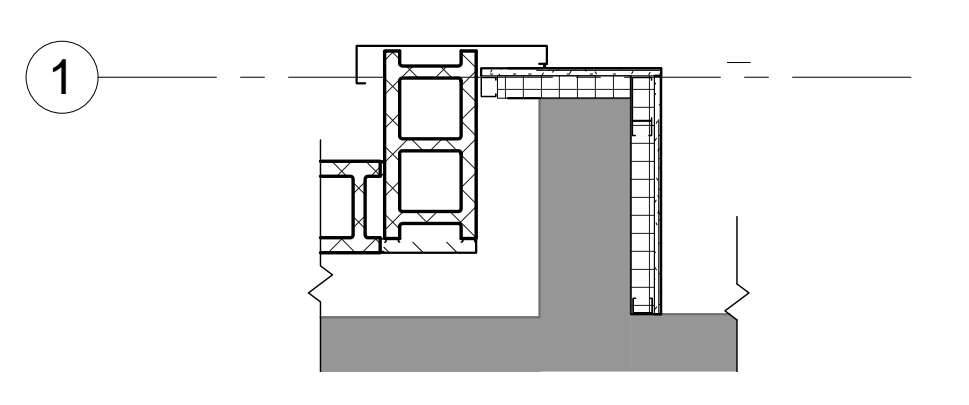


9 ELEVATOR JAMB DETAIL 2
AS101 3/4" = 1'-0"

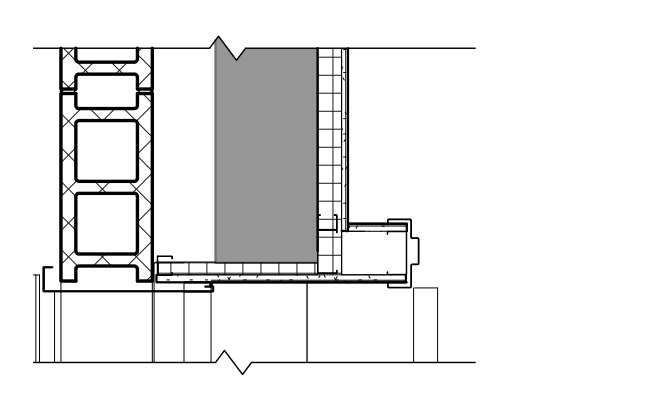

8 ELEVATOR JAMB DETAIL 1
AS101 3/4" = 1'-0"

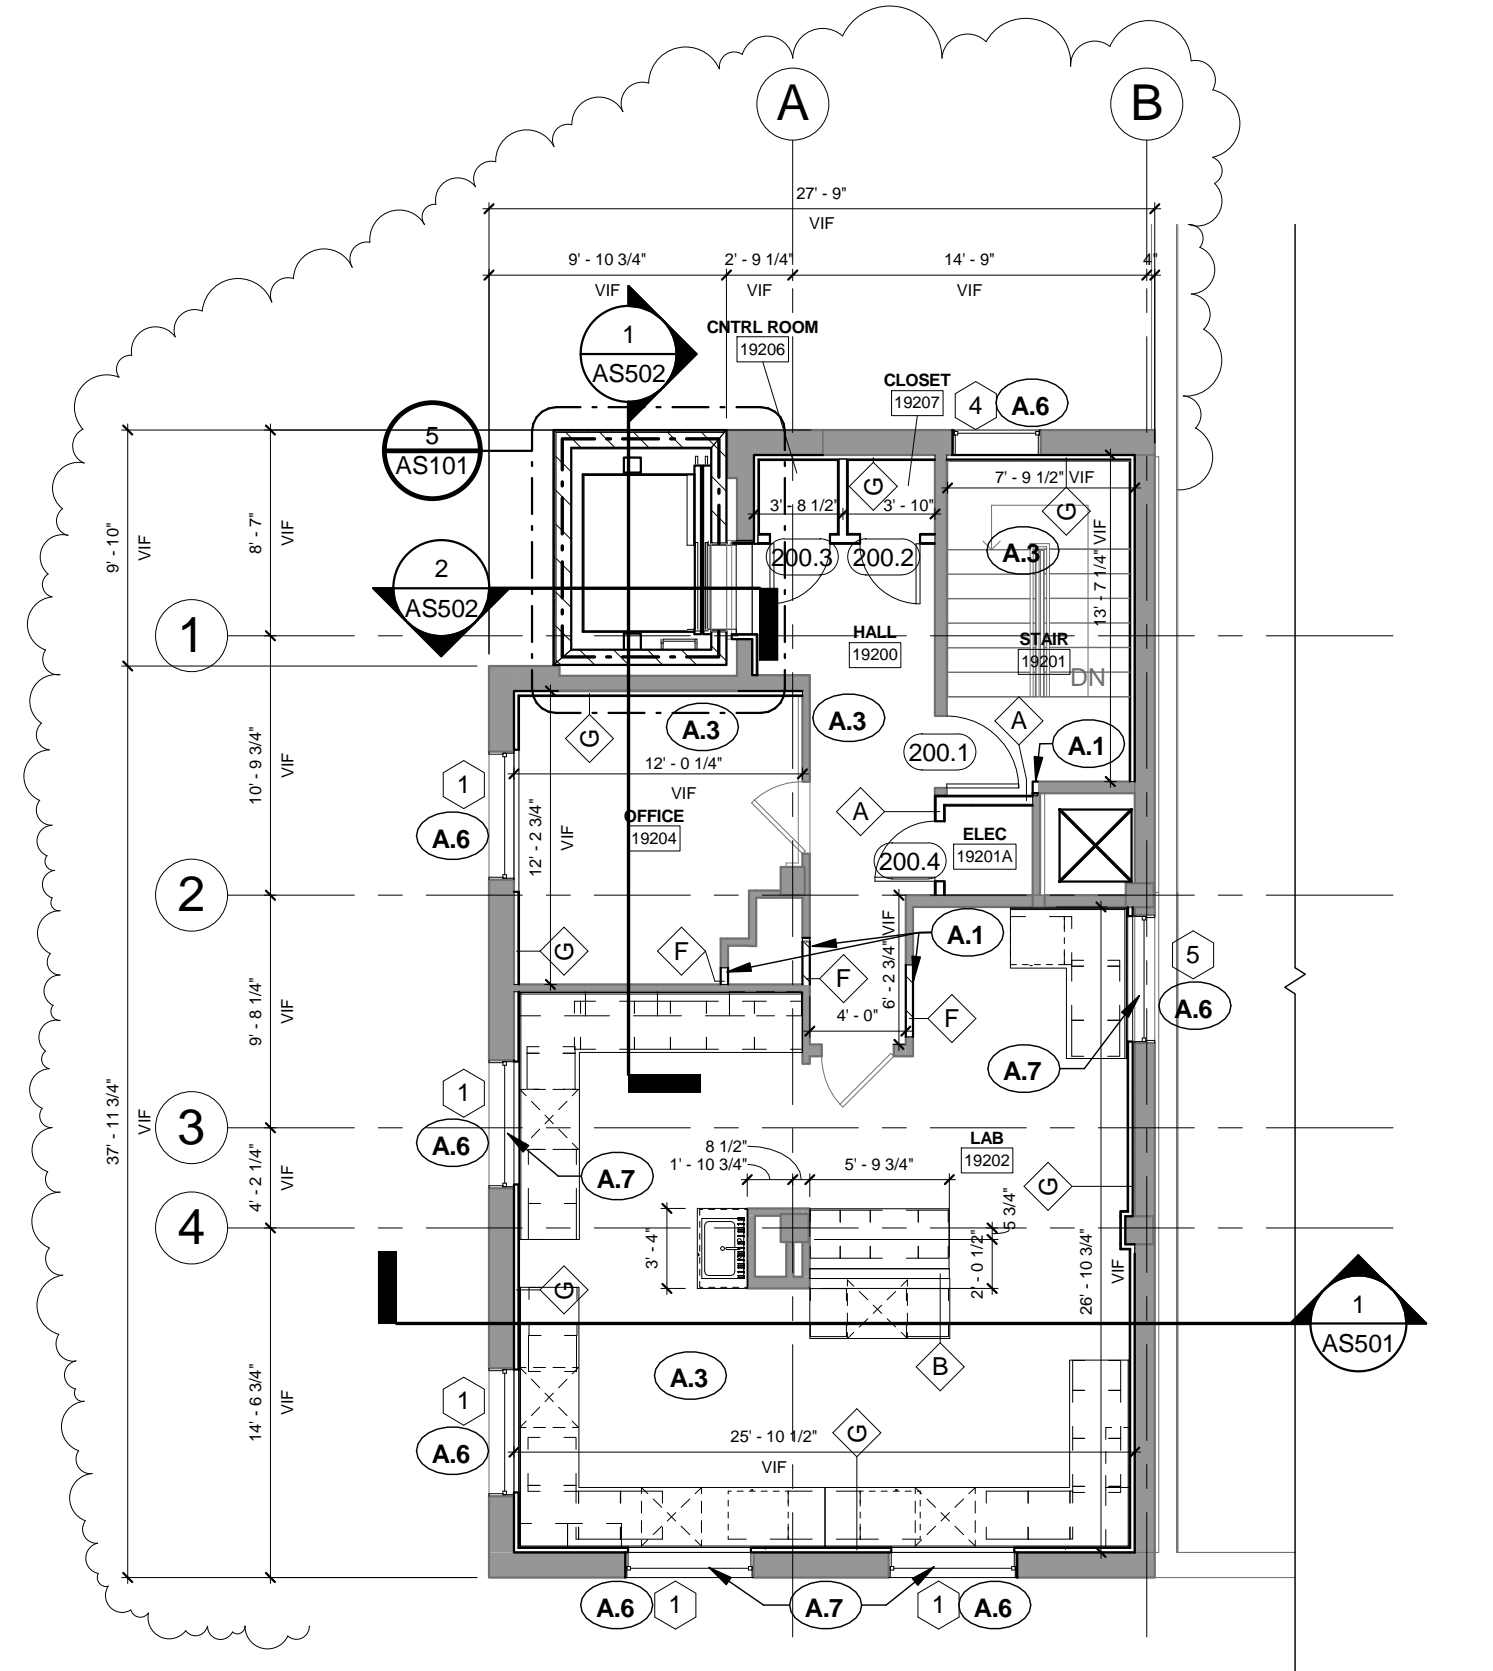

3 SECOND FLOOR PLAN
AS101 1/8" = 1'-0"

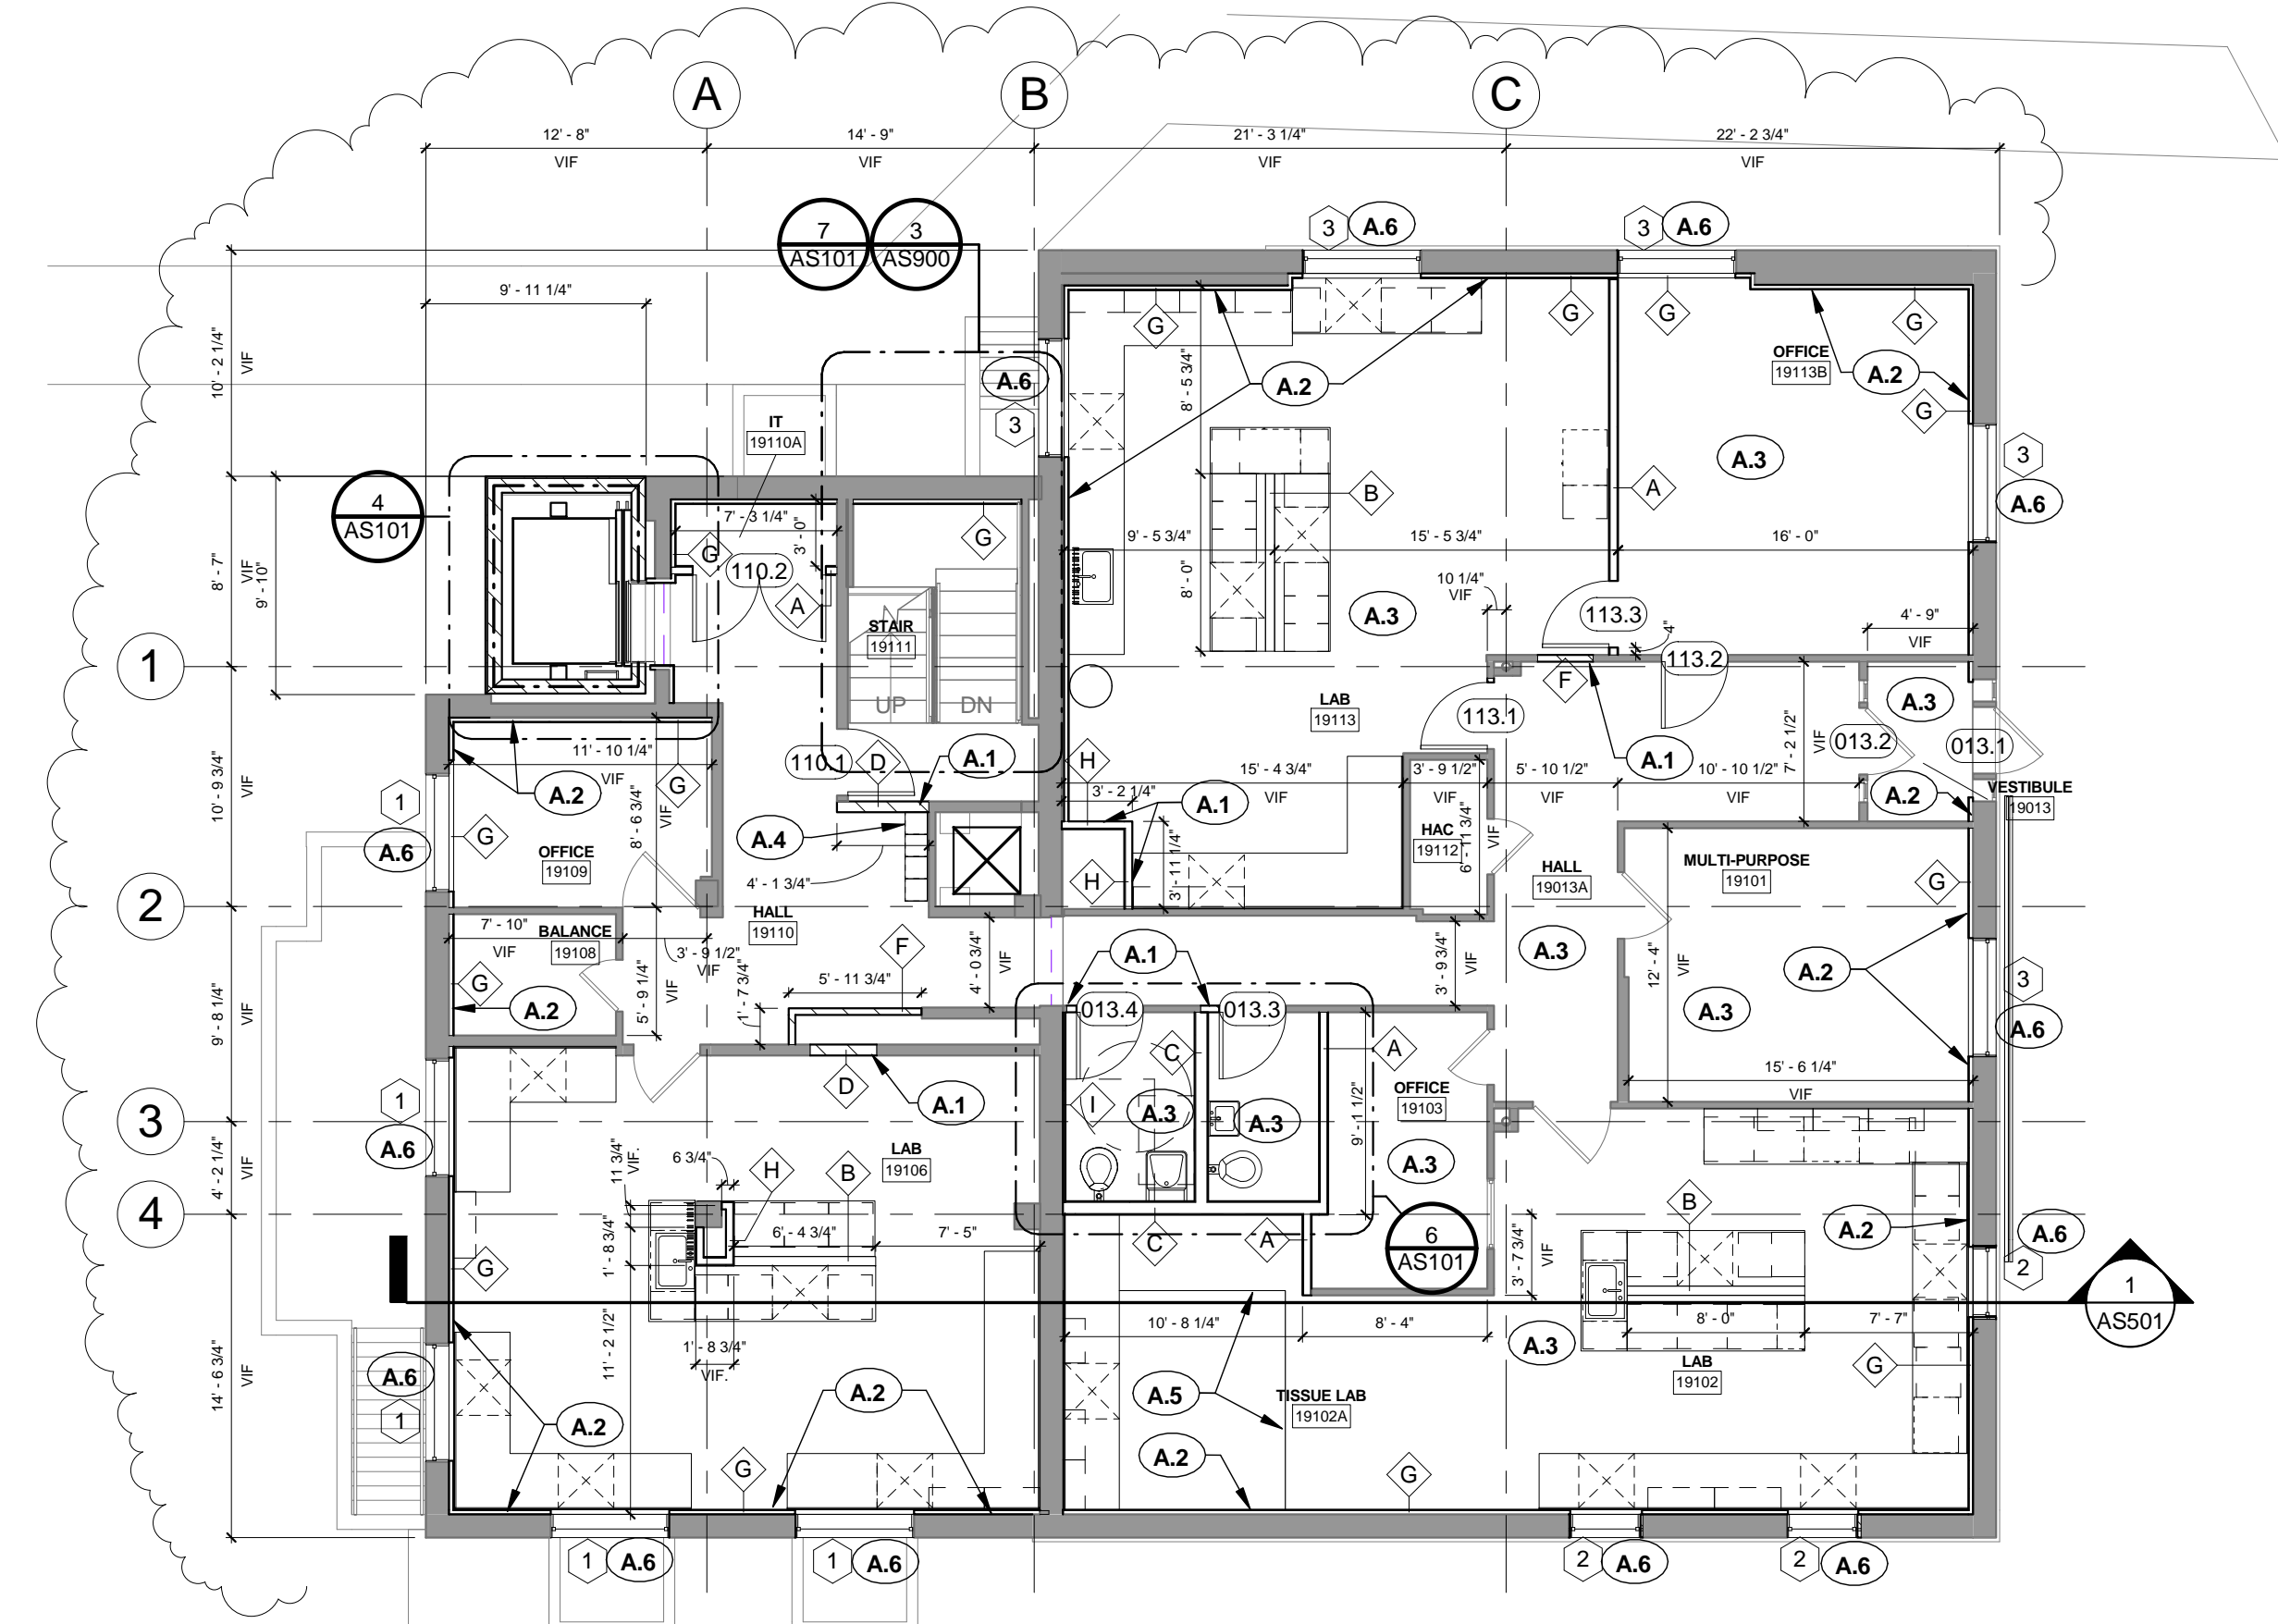

2 FIRST FLOOR PLAN
AS101 1/8" = 1'-0"

FULLY SPRINKLERED

FOR BID

<p>2 Revision: CASEWORK DEMO/SALVAGE. 11-10-2014</p> <p>Revisions: Date</p>	<p>ROBLEY REX VAMC System 800 Zorn Ave. Louisville, KY 40206</p>	<p>MEP / HVAC DESIGN</p> <p>BCCLT, Inc. www.BCCLT.com</p> <p>Site Civil, MEP Engineers 9100 Markfield Road Suite 200 Louisville, KY 40222 T: 502-708-1860</p> <p>BCCLT Brigi, Chance, Cummins, London, Titzer</p>	<p>PROJECT LEADER/ARCHITECT:</p> <p>GUIDON DESIGN</p> <p>2453 N. DELAWARE ST. INDIANAPOLIS, IN. 46205 317.800.6388 WWW.GUIDONDESIGN.COM SUSTAINABLE ARCHITECTURE + ENGINEERING</p>	<p>Drawing Title FLOOR PLANS</p> <p>Approved: Project Director Anthony C. Costanzo anthony.costanzo@va.gov 502-287-4222</p>	<p>Project Title RENOVATE RESEARCH BUILDING 19 - T661</p> <p>Location ROBLEY REX VAMC</p> <p>Date 8/17/2012</p> <p>Checked By: LJL</p> <p>Drawn By: STW</p>	<p>Project Number 12.1004</p> <p>Building Number Bldg-19</p> <p>Drawing Number AS101</p> <p>VA Project Number 603-12-601 - T661</p> <p>Department of Veterans Affairs</p>
---	---	--	---	---	---	---