



Steris Equipment No. 2 as referenced on Basis of Design Drawings.

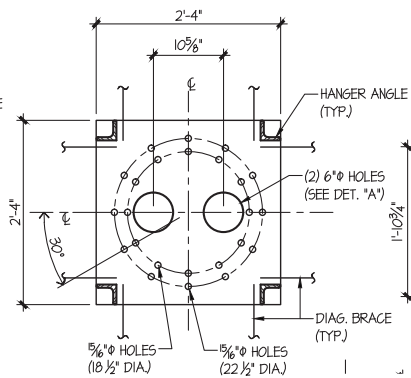

Steris Equipment No. 1, 3 & 5 as referenced on Basis of Design Drawings.

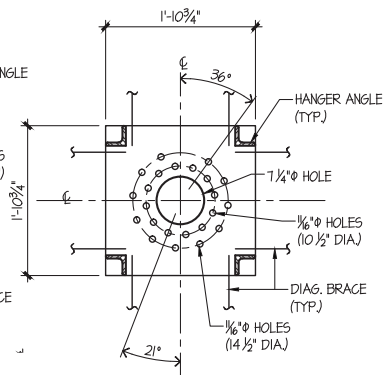

Steris Equipment No. 4 as referenced on Basis of Design Drawings.

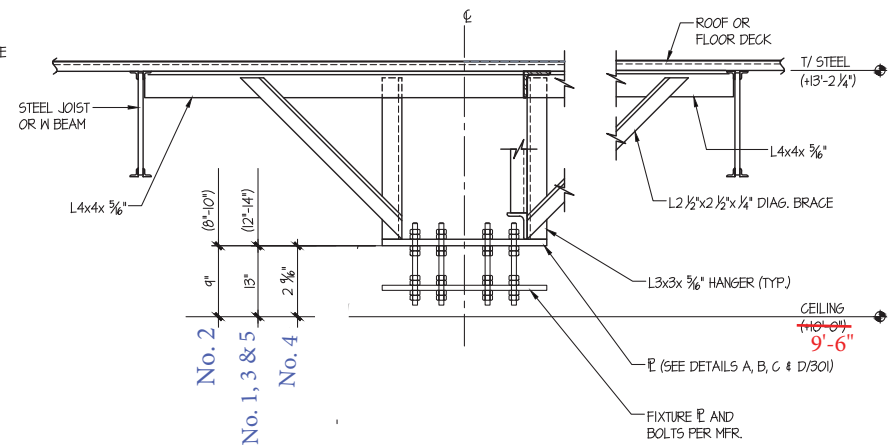


PLATE DETAILS

No Scale

DETAIL-CEILING HUNG EQUIPMENT SUPPORT

No Scale