


AREAS SAMPLED JANUARY 2003:
NON-ASBESTOS-CONTAINING MATERIALS

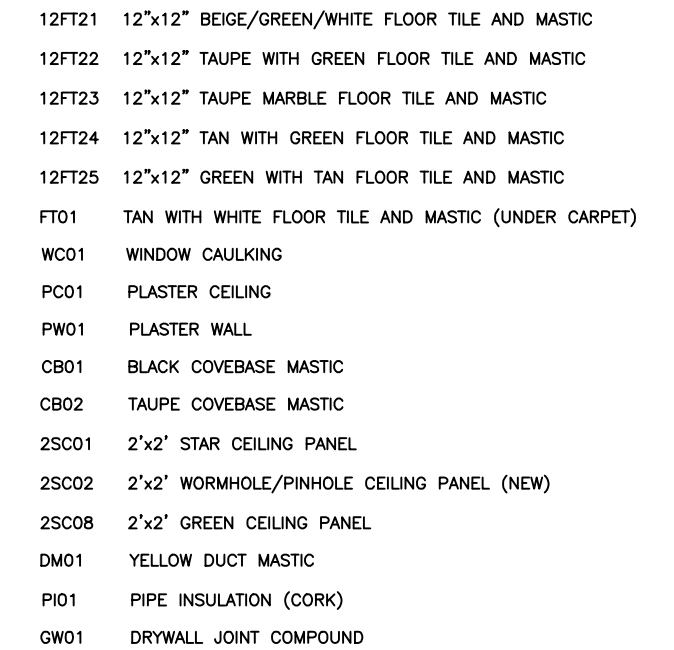


SAMPLE IDENTIFICATION

9-WC01-EXTERIOR-01 NON-ASBESTOS-CONTAINING MATERIAL

DESCRIPTION	LOCATION
FT01-12"x12" TAN W/ BROWN FLECK FT/BLACK MASTIC	1122 UNDER CARPET IN ROOMS/HALLS: 1121,1125,1120A, 1124,1123,1119,1108,1105,1104A,1104B,1103,1102,1099, 1099A,1099B,1095,1094,1089,1082,1053A,1053,1068,1063A 1083,1048,1002,1006A,1006,1003,1008,1010,1018,1021,1022, 1028,1030,1031,1035,1036,1056,1029A,1029,1034,1037,1040

Homogenous Area	Sample Number	Sample Description	Locations	Results
FT01	20-3-1-01	Tan with Brown Fleck FT / Black Mastic	RM 1122, Behind Door	2% CH-tile, 2% CH-mastic
	20-3-1-02		RM 1122, West End	2% CH-tile, 2% CH-mastic
	20-3-1-03		RM 1121, Doorway	3% CH-tile
	20-3-1-04		RM1099, Doorway	2% CH-tile, 5% CH-mastic
	20-3-1-05		RM 1083A, Northeast Wall	3% CH-tile, 5% CH-mastic
	20-3-1-06		RM 1037, Doorway	3% CH-tile, 5% CH-mastic
	20-3-1-07		RM 1003, Doorway	3% CH-tile, 5% CH-mastic
	20-3-1-08	Black Mastic	RM 1070, Doorway	ND

**BULK SAMPLE LOCATIONS
BUILDING 3 - 1ST FLOOR
VA MEDICAL CENTER
SALISBURY, NORTH CAROLINA**

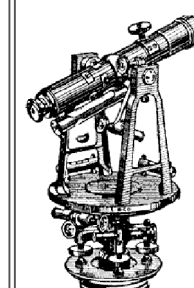

HGS ENGINEERING, INC.

1121 NOBLE STREET
ANNISTON, ALABAMA 36201