KEYED NOTES:

1. PROVIDE (1) DATA DROP AND (1) DUPLEX RECEPTACLE MOUNTED AT +84" AFF (EXCACT LOCATION TO BE DETERMINED BY COR) FOR ELECTRONIC BULLETIN BOARD. CIRCUIT FROM PANEL CB1.

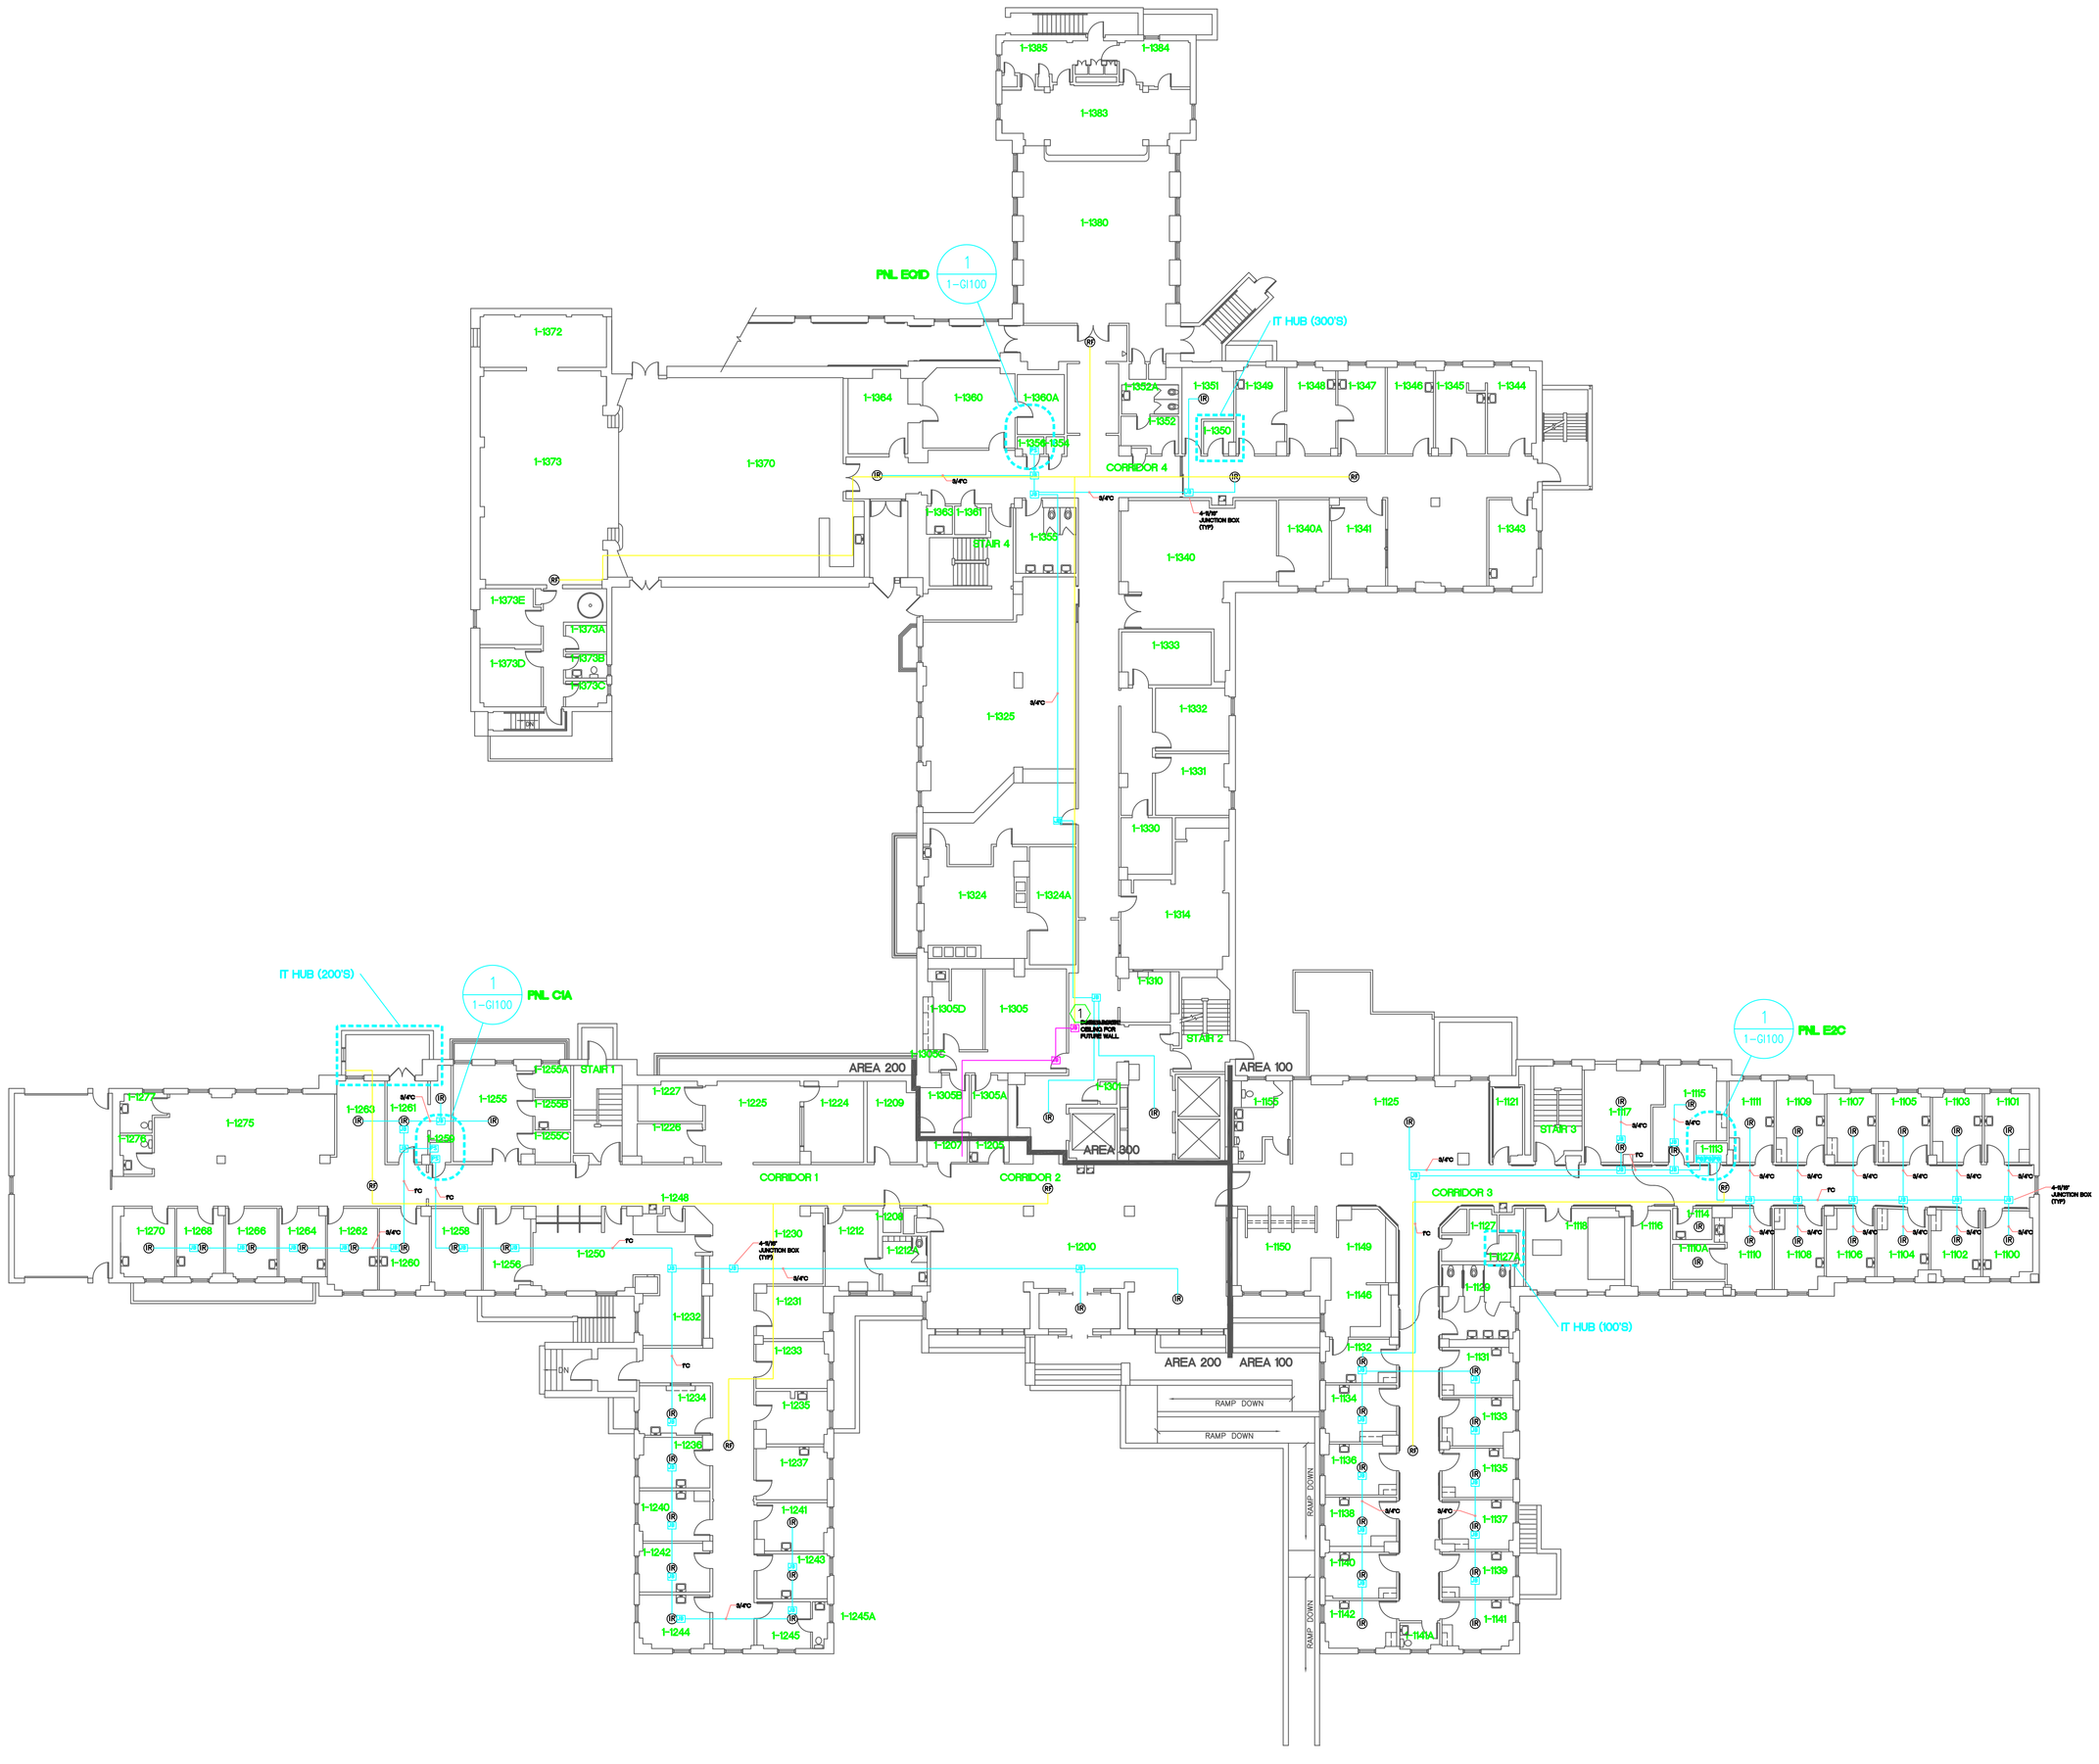

NORTH

AS-BUILT	01/31/14
AS-BUILT	10/25/13
Revision 1:	3-8-13

CONSULTANTS:

WAK Engineers·Architects·Co
William A. Kibbe & Associates
1475 S. Washington Avenue Saginaw MI
(989) 752-5000

Department of Veterans Affairs
Aleda E Lutz Medical Center
1500 Weiss Street
Saginaw, MI 48602

Property of the United States Government
For Official Use Only
Do not remove this notice
Properly Destroy documents when no longer needed

File Name

File Location

Drawing Title: BUILDING 1 FLOOR 1 RTLS LAYOUT

Approved: Director Facilities Management Service

Project Title: RTLS SITE PREP

Project No.: 655-13-106

Date: 3-8-13

Checked

Drawn

Scale: 1/16" = 1'-0"

Building Number: BUILDING 1

Drawing Number: 1-EP-110

Dwg. 14 of 95

Office of Facilities Management

Department of Veterans Affairs

VA FORM 08-6231, OCT 1978