



REVISIONS	DATE	SEE COMPOSITE	LEGEND: XXXX(+) = Sample Number (ACM) XXX(-) = Sample Number (non ACM)	DRAWING TITLE		PROJECT TITLE		DATE	
				SIXTH FLOOR POD-C & PARTIAL POD-A		ASBESTOS CONTAINING MATERIALS		05/19/2014	
				BUILDING NUMBER		PROJECT NUMBER		DRAWING NO.	
				1 SO/LLM		JC		TA	
				LOCATION		VAMC, LR DIVISION		32 OF 40	

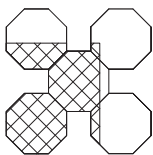


KEY PLAN

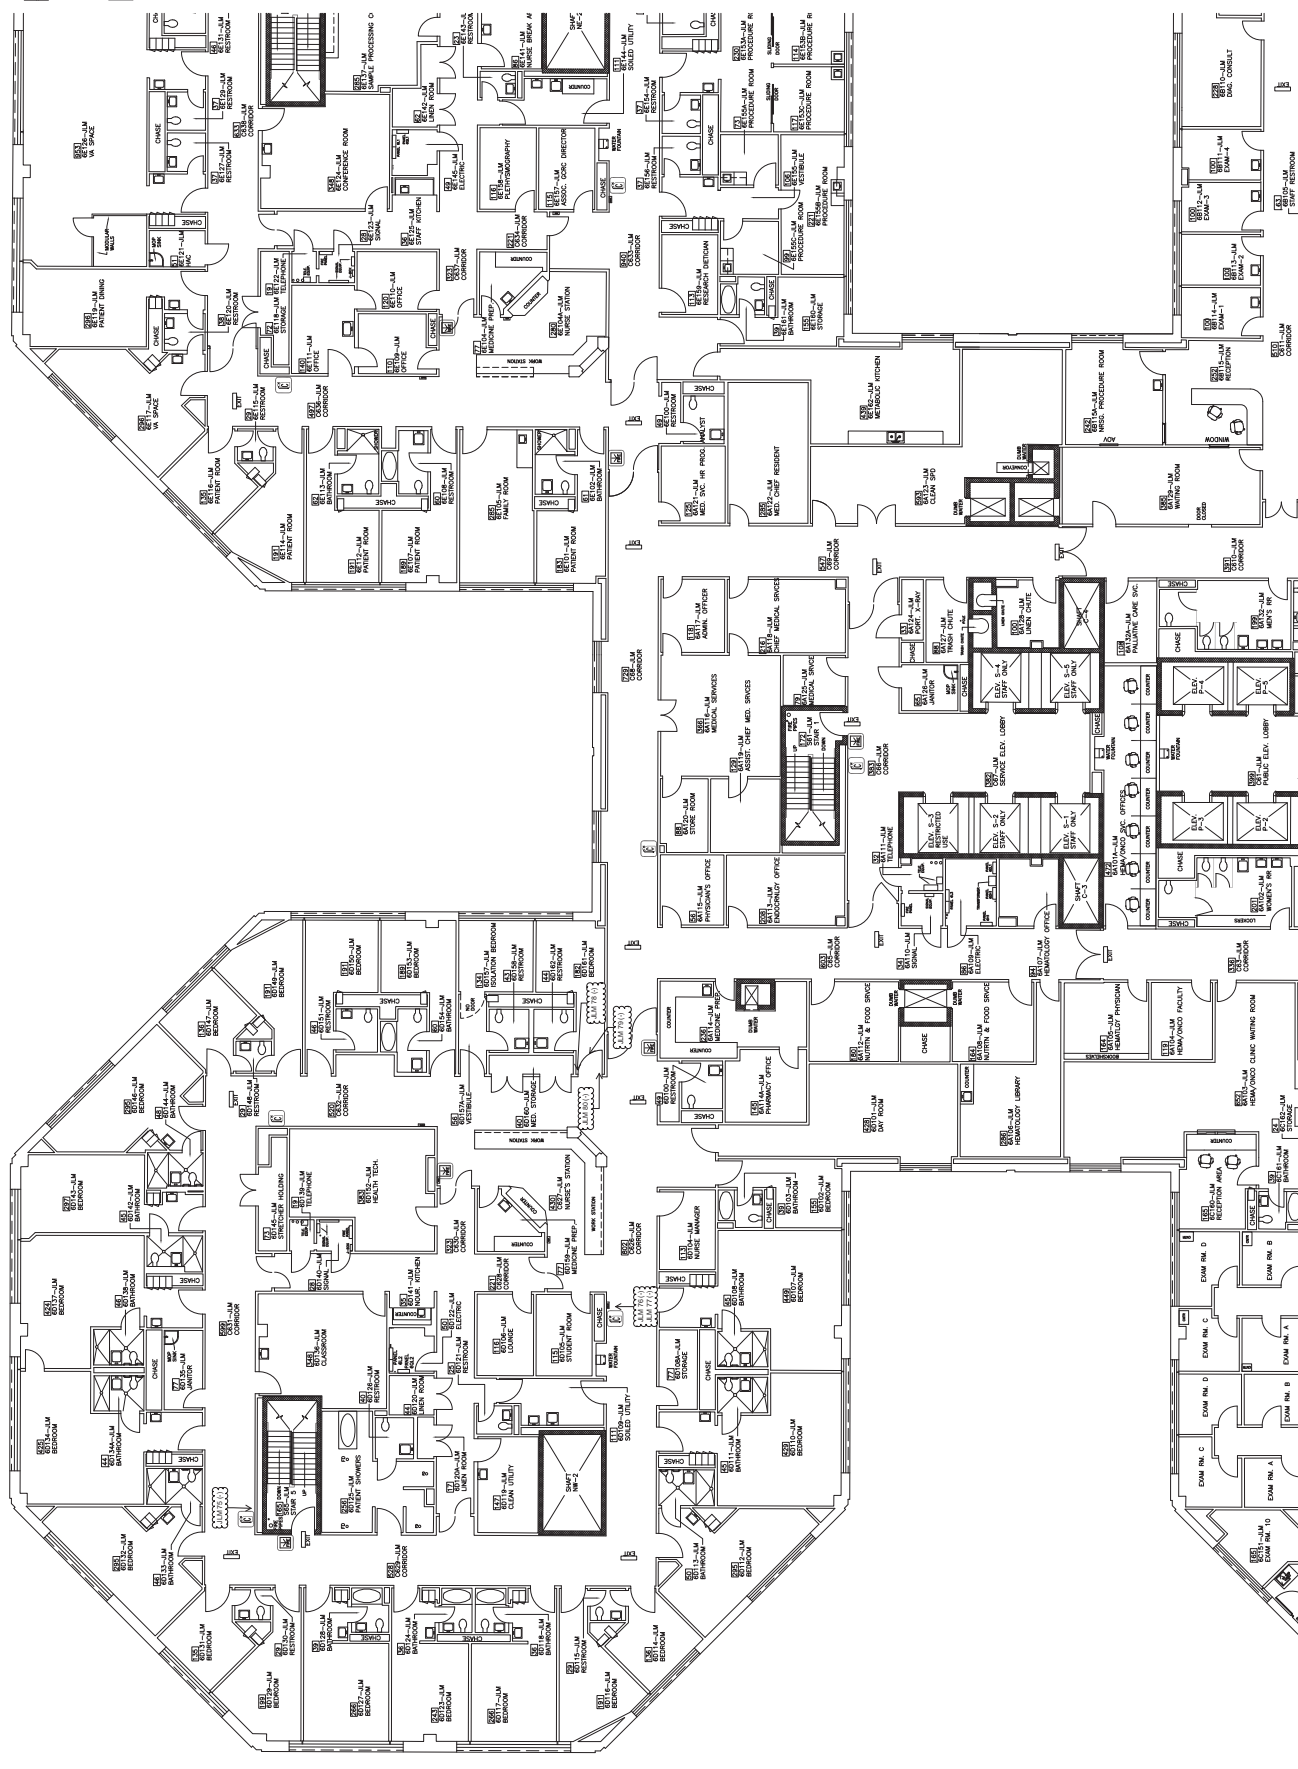

NOT TO SCALE

DEPARTMENT OF VETERANS AFFAIRS	Office of Facilities	DATE	05/19/2014
		PROJECT NUMBER	
DRAWING NO.		33 OF 40	
PROJECT TITLE		ASBESTOS CONTAINING MATERIALS	
BUILDING NUMBER		1 SOULM	
LOCATION		VAMC, LR DIVISION	
DRAWING TITLE		SIXTH FLOOR POD-D & PARTIAL POD-A	
LEGEND		XXX(+) = Sample Number (ACM) XXX(-) = Sample Number (non ACM)	
REVISIONS		DATE	

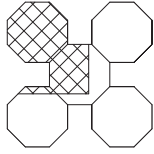

KEY PLAN

NOT TO SCALE



Legend:
XXX(+) = Sample Number (ACM)
XXX(-) = Sample Number (non ACM)

SEE COMPOSITE




DATE: 05/19/2014
PROJECT NUMBER:
DRAWING NO.: 34 OF 40

PROJECT TITLE: ASBESTOS CONTAINING MATERIALS
BUILDING NUMBER: 1 SOJLM
LOCATION: VAMC LR DIVISION

DRAWING TITLE: SIXTH FLOOR
POD-E & PARTIAL POD-A

REVISIONS

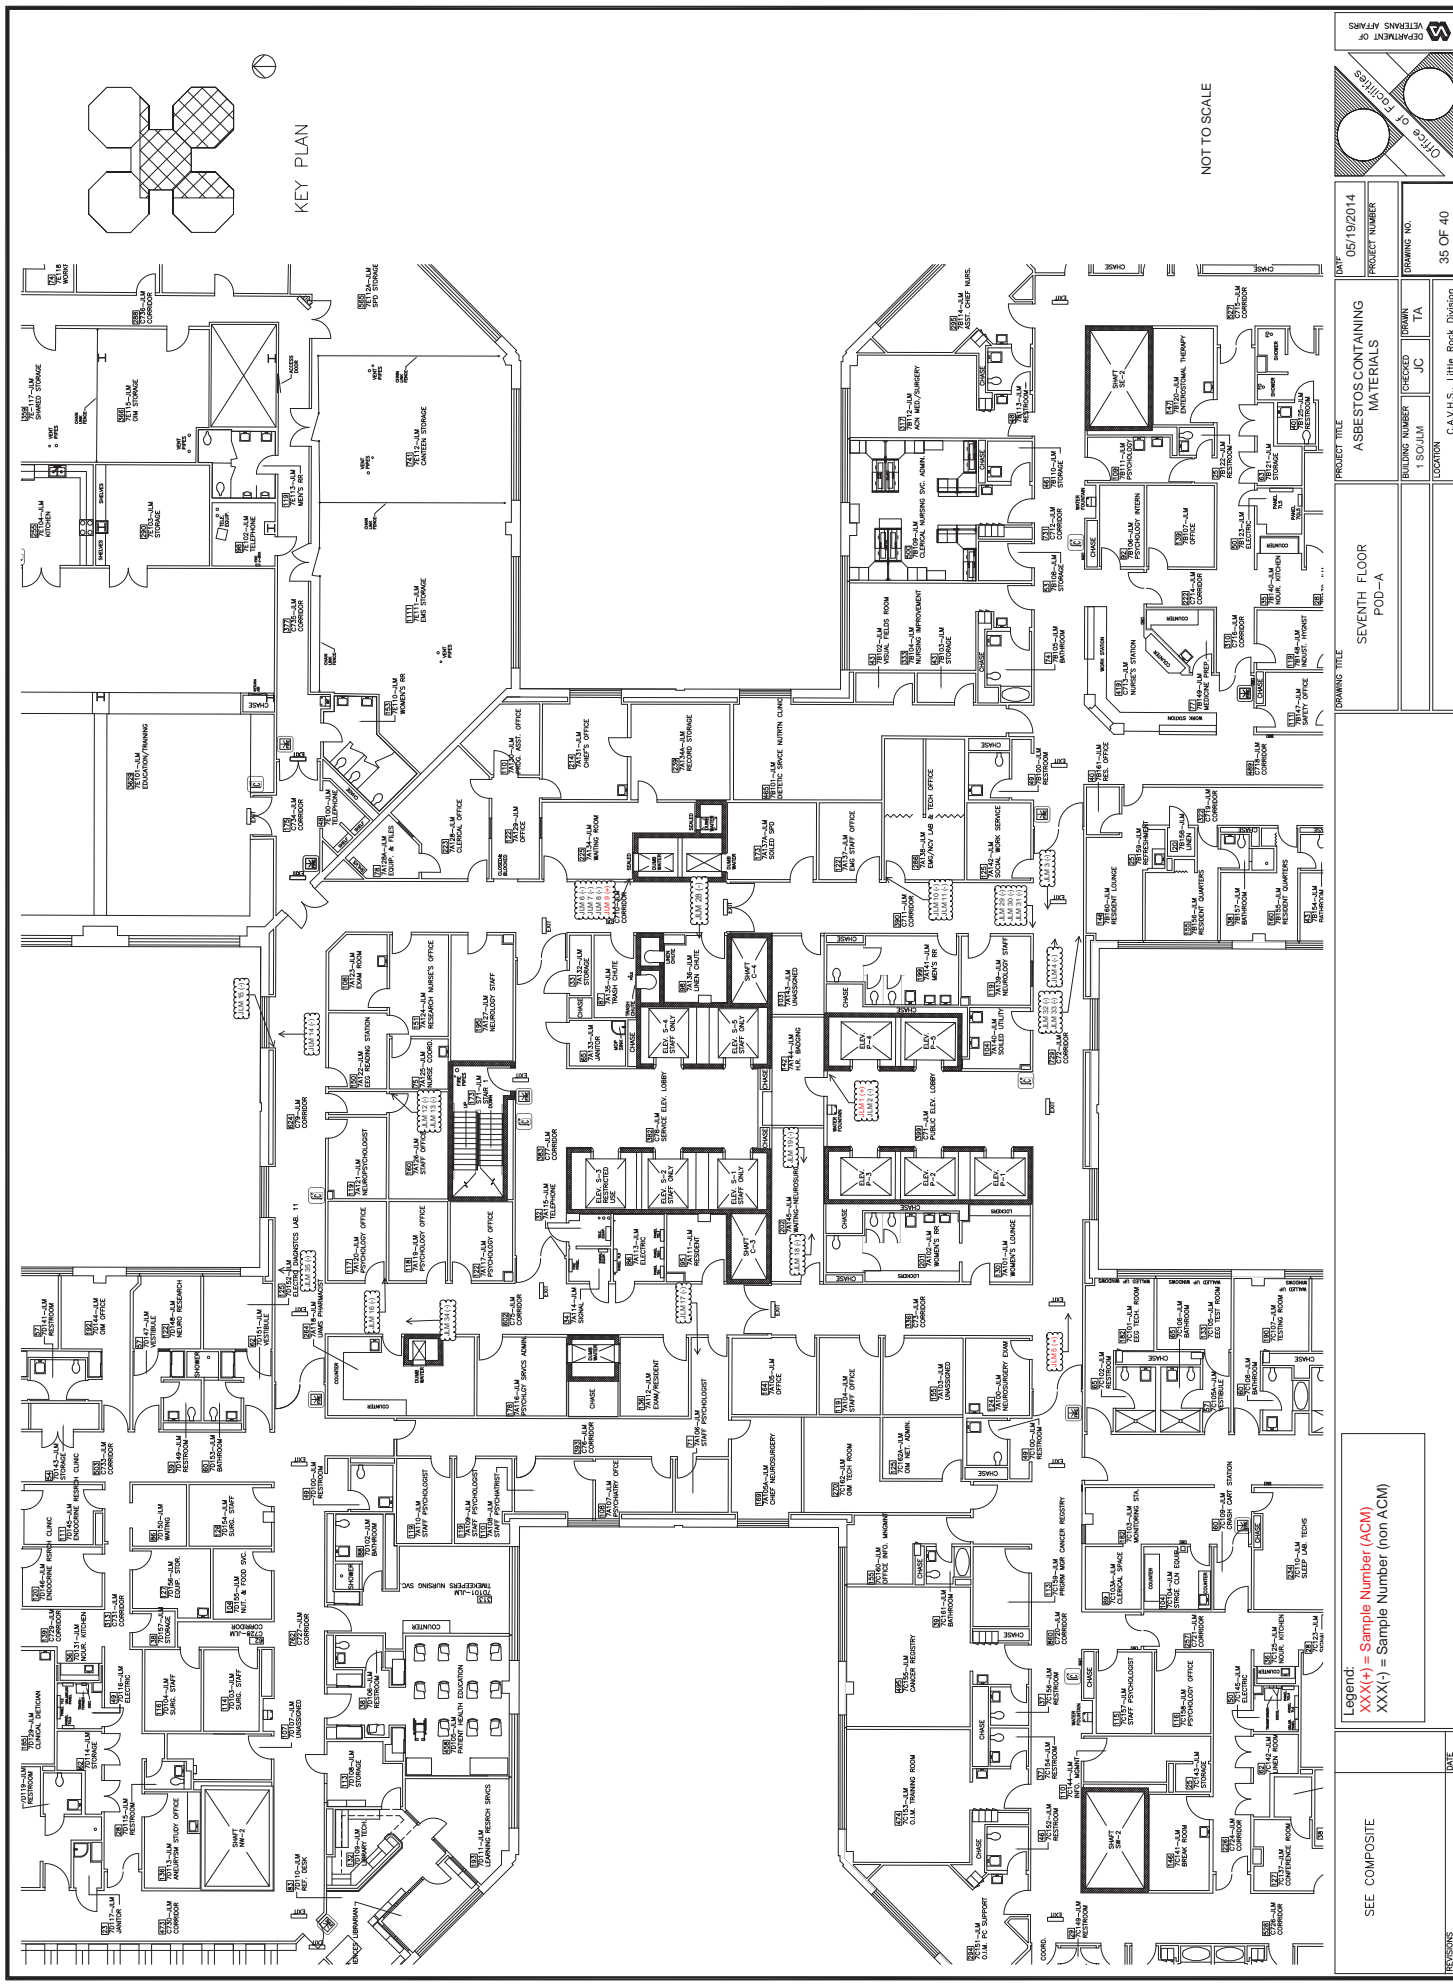


KEY PLAN

NOT TO SCALE

DEPARTMENT OF VETERANS AFFAIRS	Office of Facilities	DATE	05/19/2014
		PROJECT NUMBER	
DRAWING NO.	35 OF 40	PROJECT TITLE	SEVENTH FLOOR POD-A
		ASBESTOS CONTAINING MATERIALS	
BUILDING NUMBER	1301-AM	CREATED	JC
		TA	
LOCATION	CAVHLS, Little Rock Division	REVISIONS	
		DATE	


Legend:
XXX(+) = Sample Number (ACM)
XXX(-) = Sample Number (non ACM)

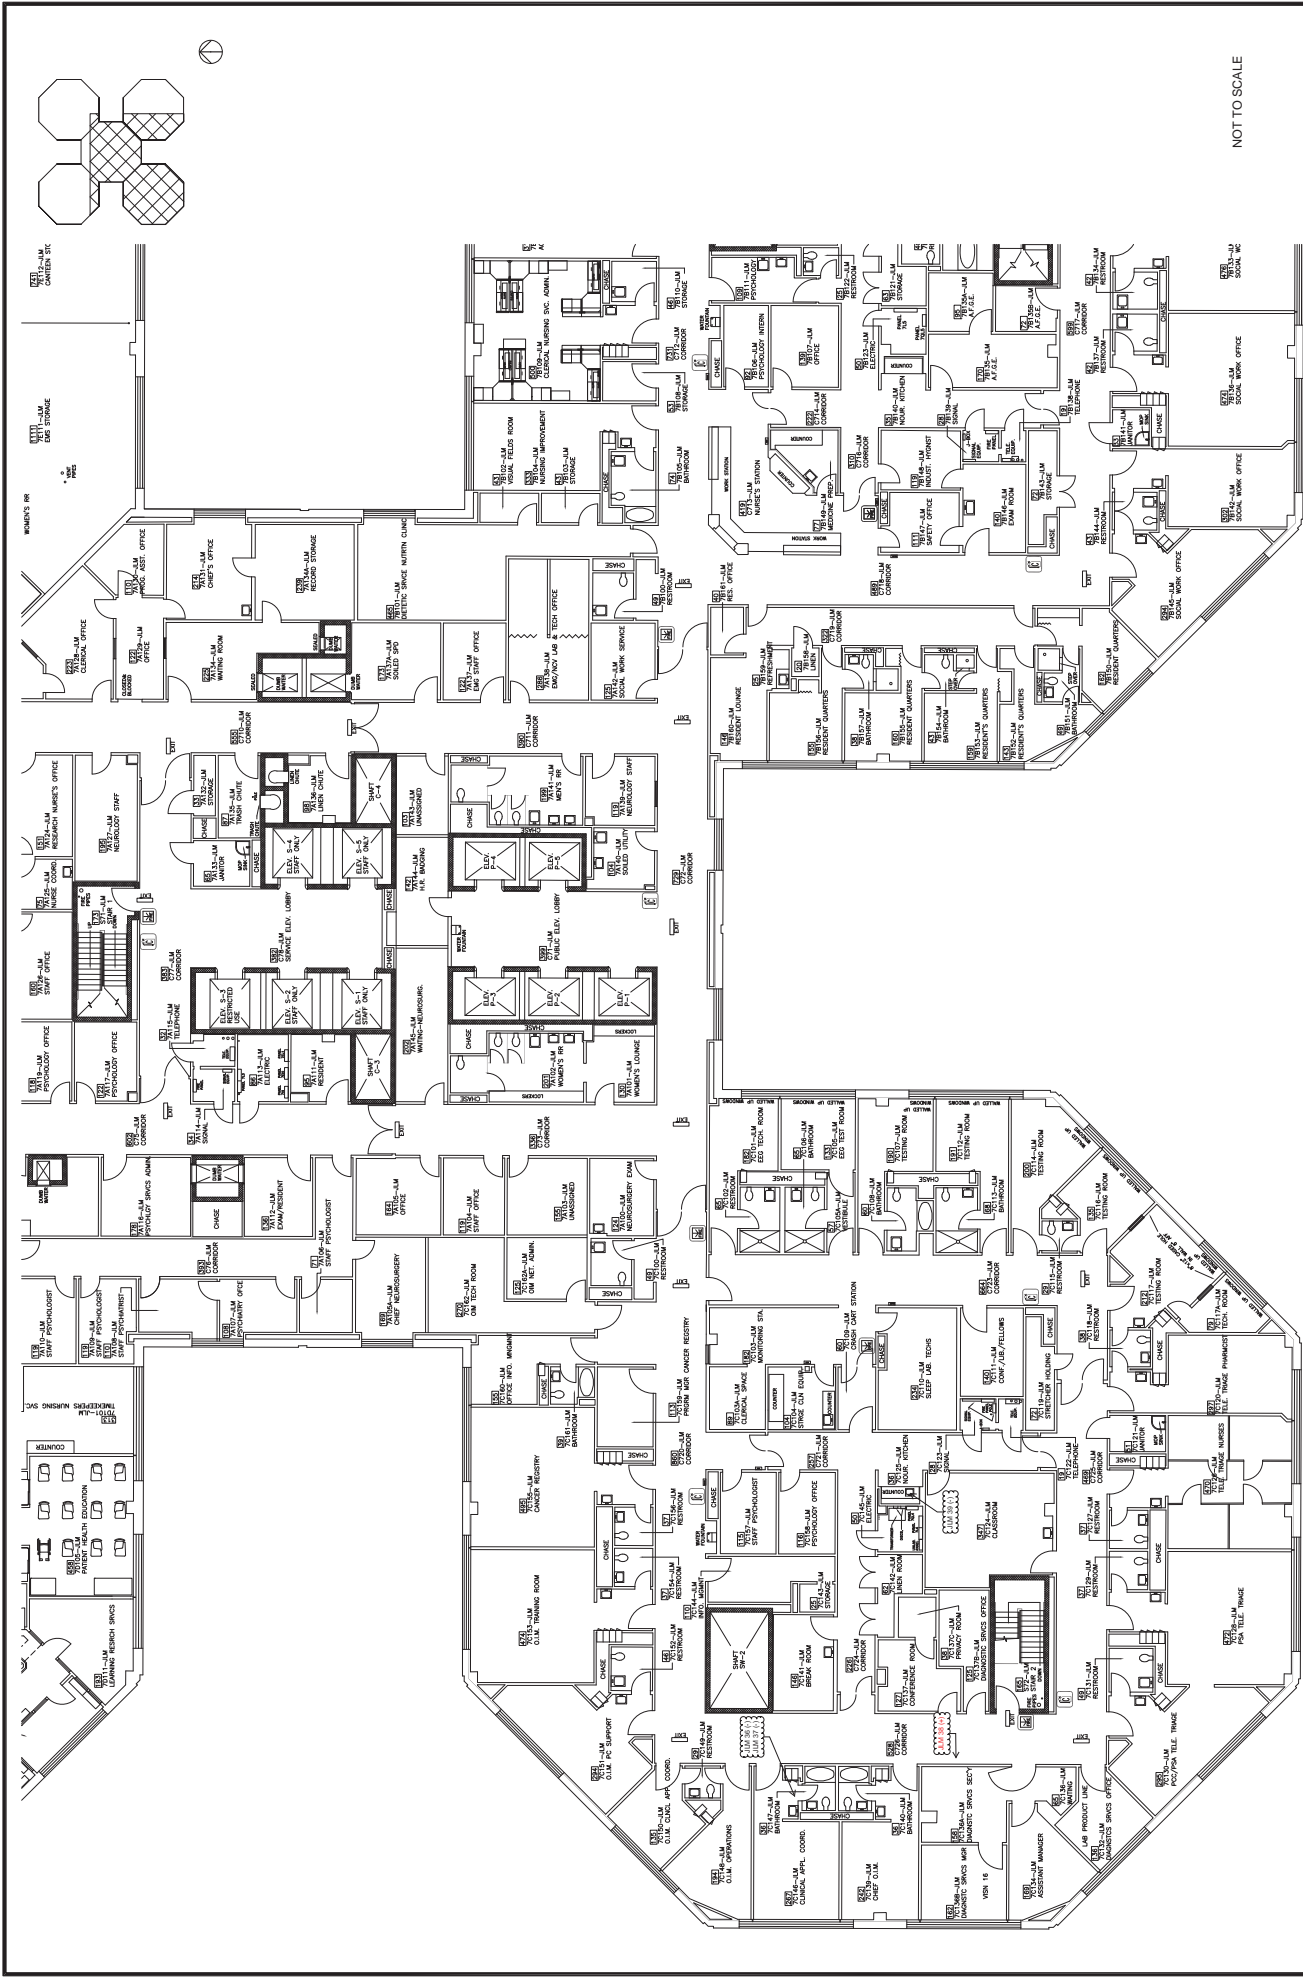


NOT TO SCALE

Legend:
XXX(+) = Sample Number (ACM)
XXX(-) = Sample Number (non ACM)

REVISIONS	DATE	DRAWING TITLE SEVENTH FLOOR POD-C & PARTIAL POD-A		PROJECT TITLE ASBESTOS CONTAINING MATERIALS	DATE 05/19/2014
		BUILDING NUMBER 1301-AM		PROJECT NUMBER	
		LOCATION VAMC, LR DIVISION		DRAWING NO. 37 OF 40	
		CHECKED JC		DRAWN TA	
		Office of Facilities		DEPARTMENT OF VETERANS AFFAIRS	

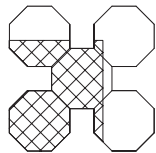

KEY PLAN

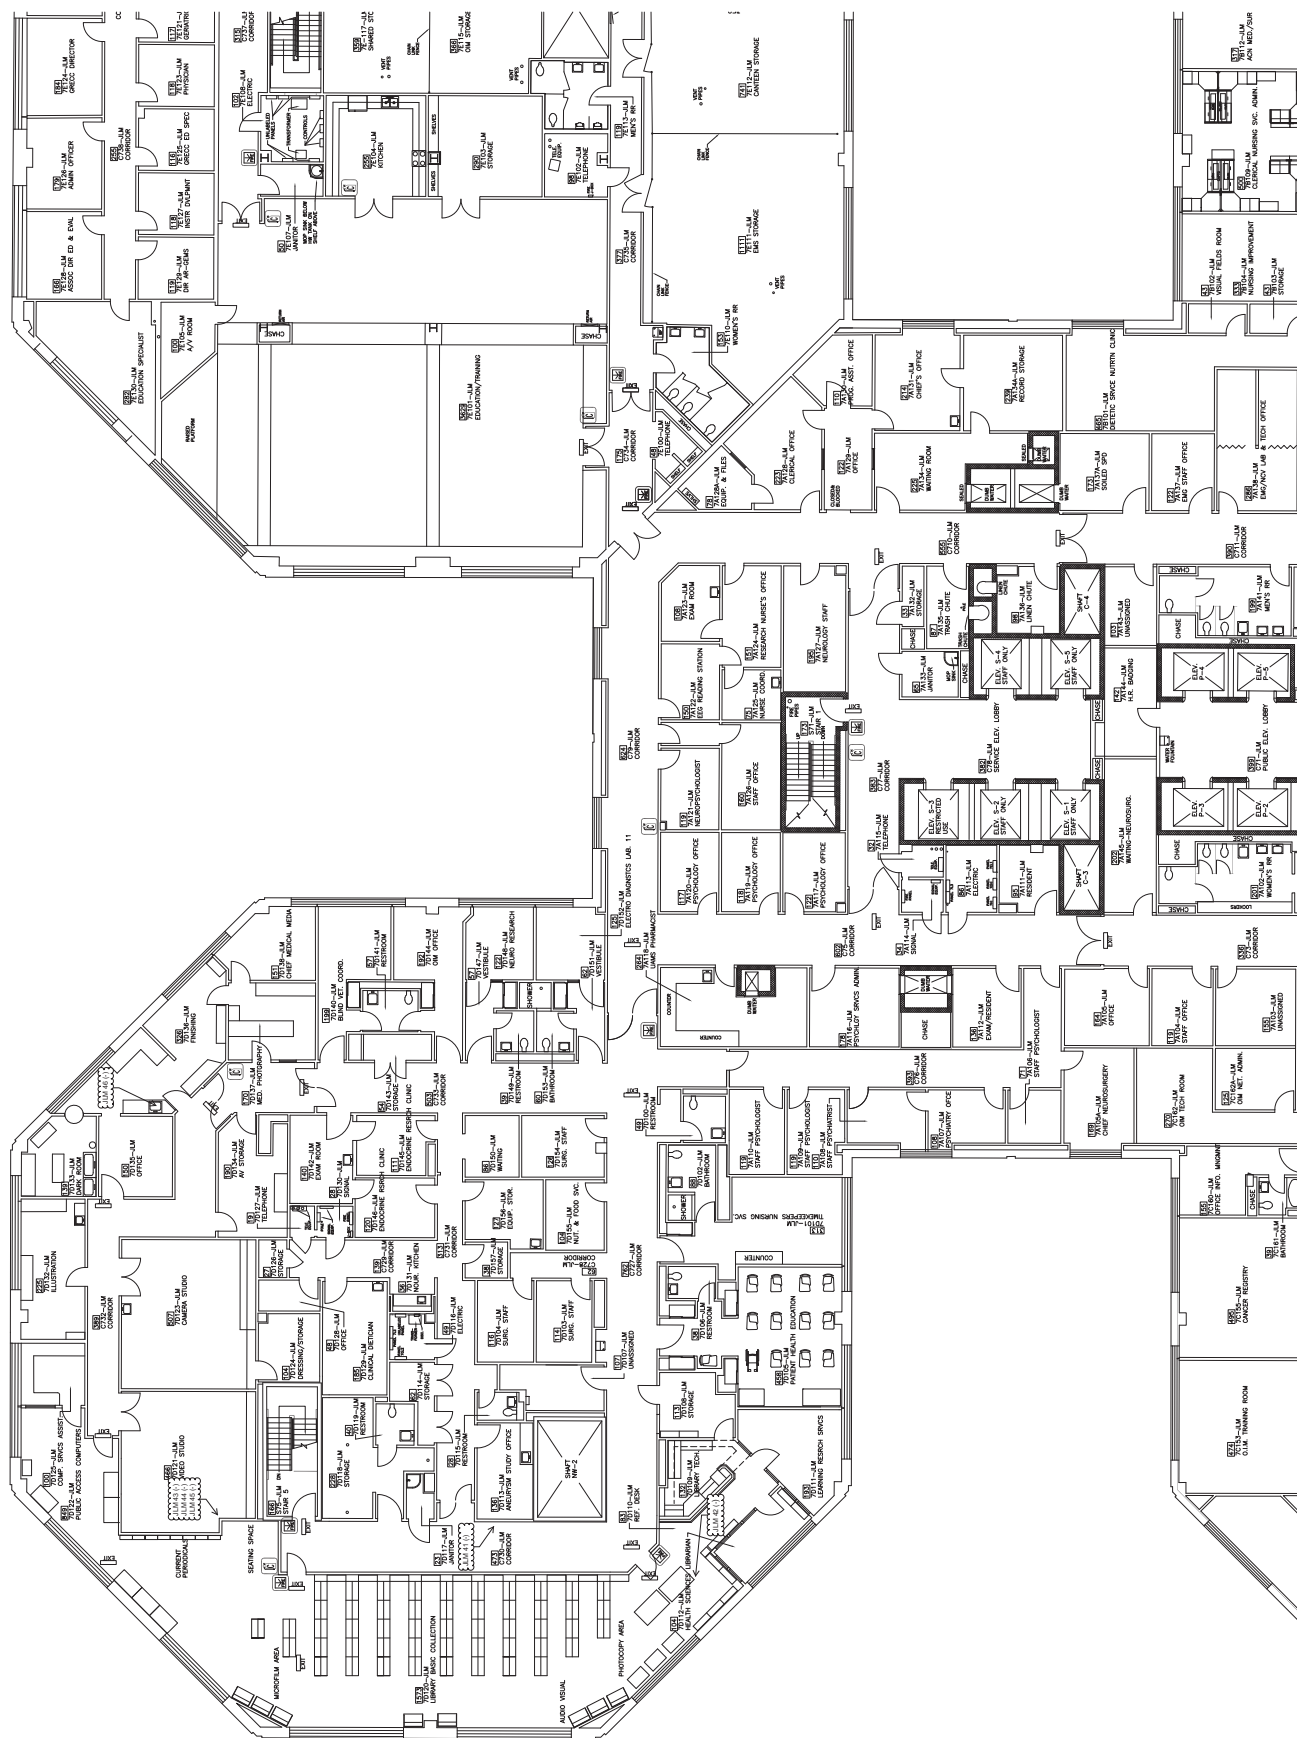

NOT TO SCALE

Legend:

Legend:
XXX(+) = Sample Number (ACM)

Legend:
 XXX(+) = Sample Number (ACM)
 XXX(-) = Sample Number (non ACM)

DRAWING TITLE

SEVENTH FLOOR
POD-D & PARTIAL POD-A

PROJECT TITLE

ASBESTOS CONTAINING MATERIALS


DATE _____

PROJECT NUMBER	05/19/2014
----------------	------------

--	--

NT OF
AFFAIRS

REVISIONS	DATE
-----------	------

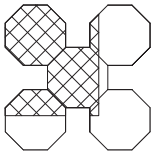


KEY PLAN

NOT TO SCALE




Legend:
XXX(+) = Sample Number (ACM)
XXX(-) = Sample Number (non ACM)

DEPARTMENT OF VETERANS AFFAIRS		Office of Facilities	
DATE	05/19/2014	PROJECT TITLE	ASBESTOS CONTAINING MATERIALS
PROJECT NUMBER		BUILDING NUMBER	1501/AM
DRAWING NO.		LOCATION	VAMC, LR DIVISION
SEVENTH FLOOR		POD-E & PARTIAL POD-A	

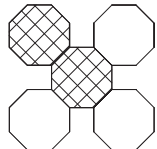

KEY PLAN

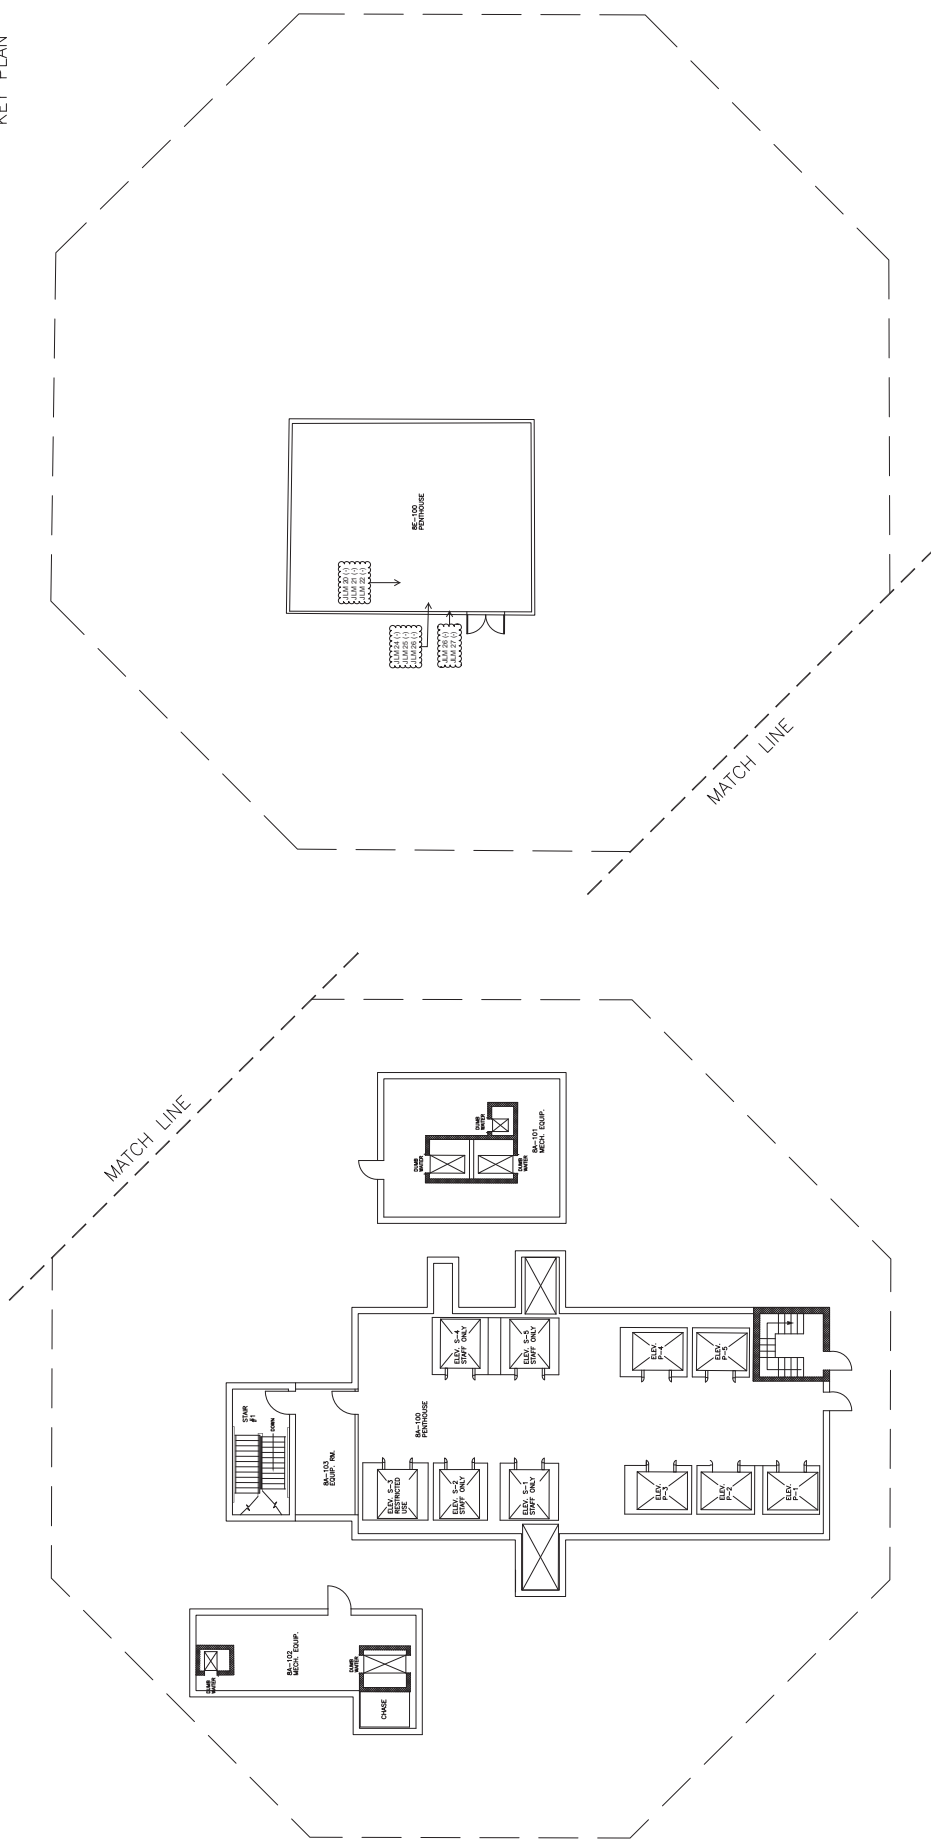

NOT TO SCALE

EIGHTH FLOOR POD E

EIGHTH FLOOR POD A

REVISIONS	DATE	11-08			
	DESCRIPTION				
	DATE	11-08			
	DESCRIPTION				
EIGHTH FLOOR POD-E & POD-A		PROJECT TITLE ASBESTOS CONTAINING MATERIALS		DATE 05/19/2014	
		BUILDING NUMBER 1 SCULLM		PROJECT NUMBER	
		LOCATION VAMC, LR DIVISION		DRAWING NO. 40 OF 40	
		CHECKED JC		DRAWN TA	
		OFFICE OF Footnotes		DEPARTMENT OF VETERANS AFFAIRS	

Legend:

XXX(+) = Sample Number (ACM)

XXX(-) = Sample Number (non ACM)