



KEY PLAN



NOT TO SCALE

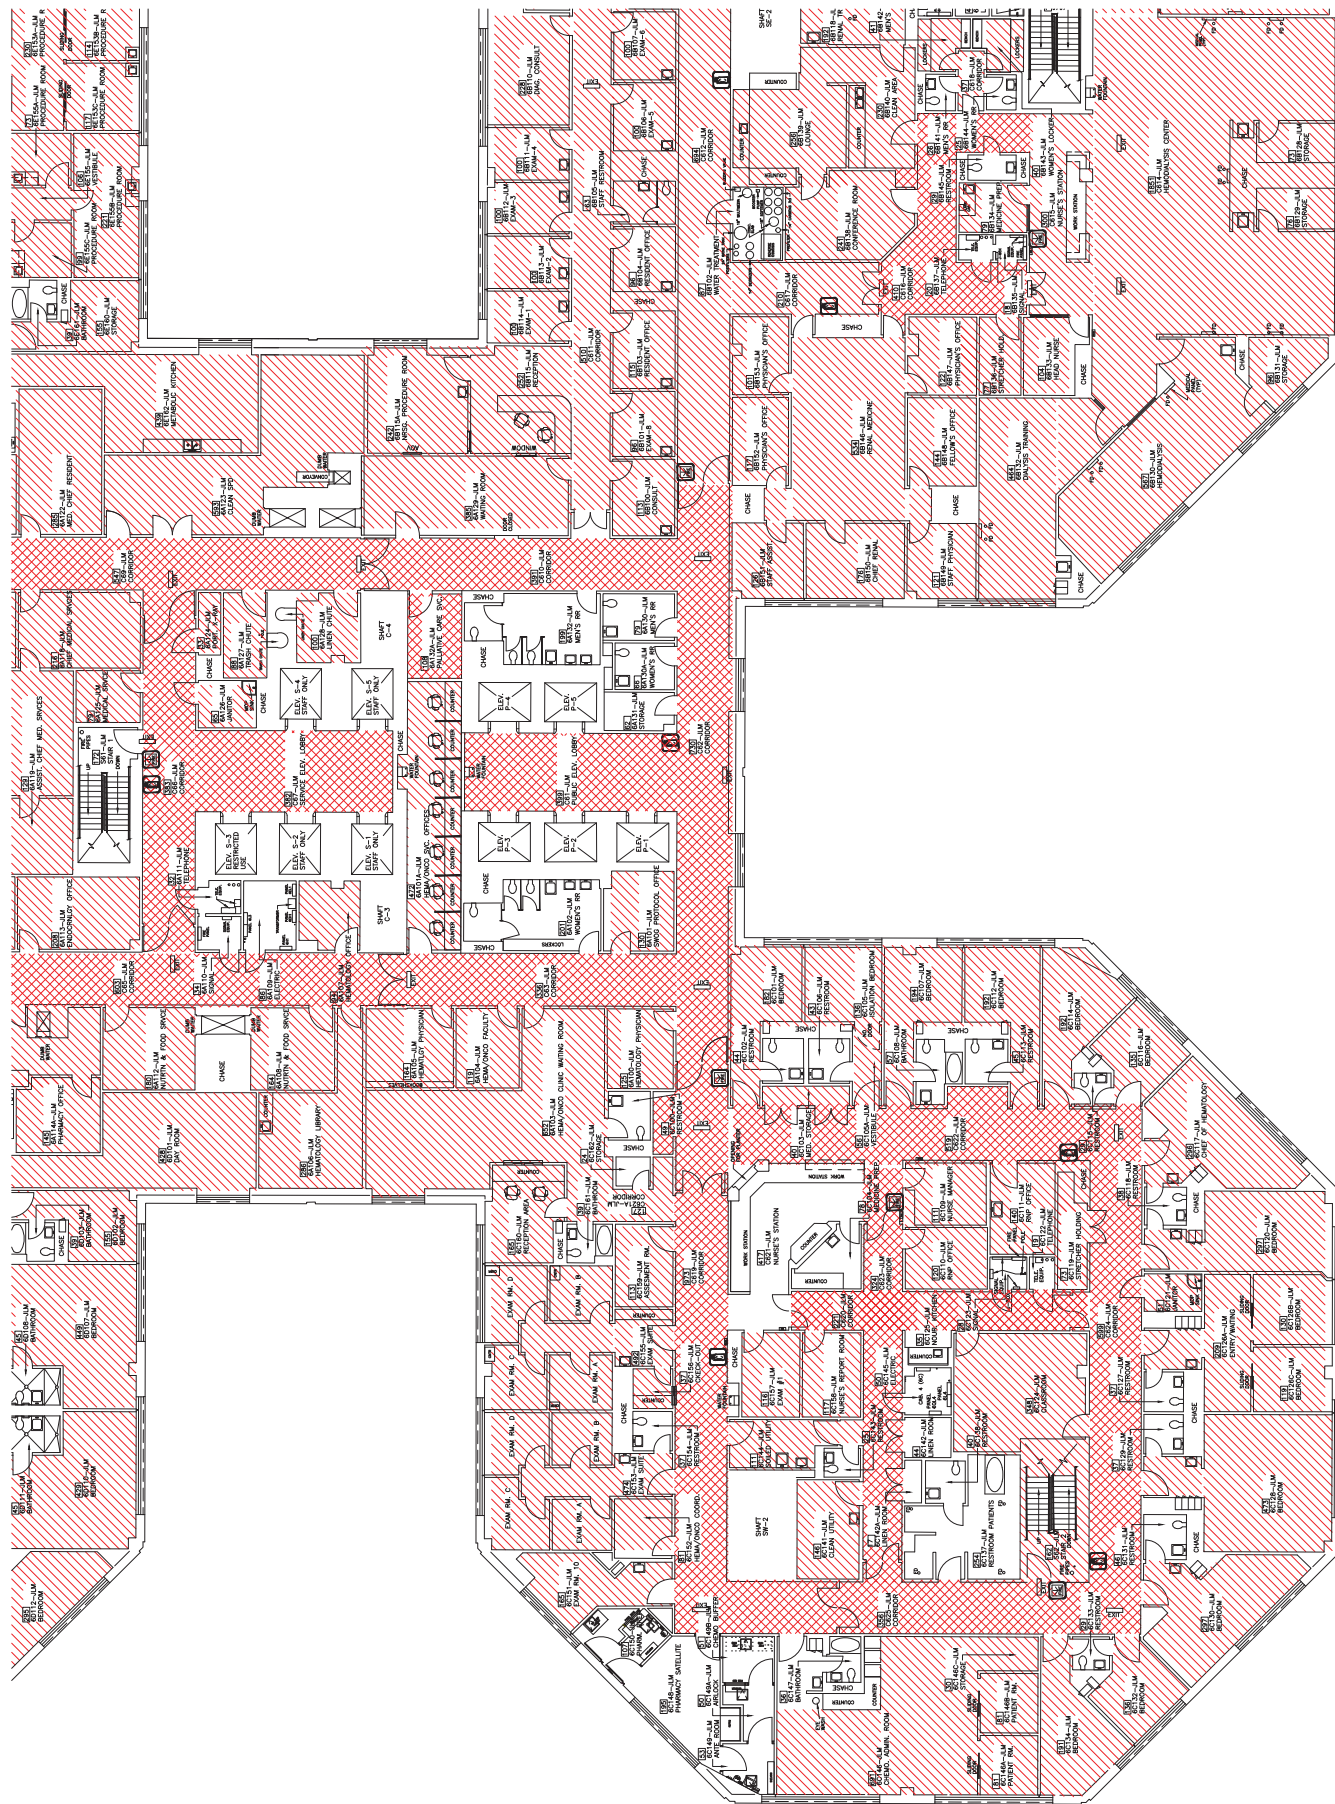


SEE COMPOSITE	DRAWING TITLE		PROJECT TITLE		DATE		05/19/2014		PROJECT NUMBER		DRAWING NO.		32 of 40	
	SIXTH FLOOR POD-C & PARTIAL POD-A		ASBESTOS CONTAINING MATERIALS		BUILDING NUMBER 1501AM		CHECKED JC		DRAWN TA		LOCATION V.A.M.C. LR DIVISION			

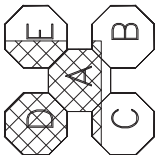


KEY PLAN




NOT TO SCALE

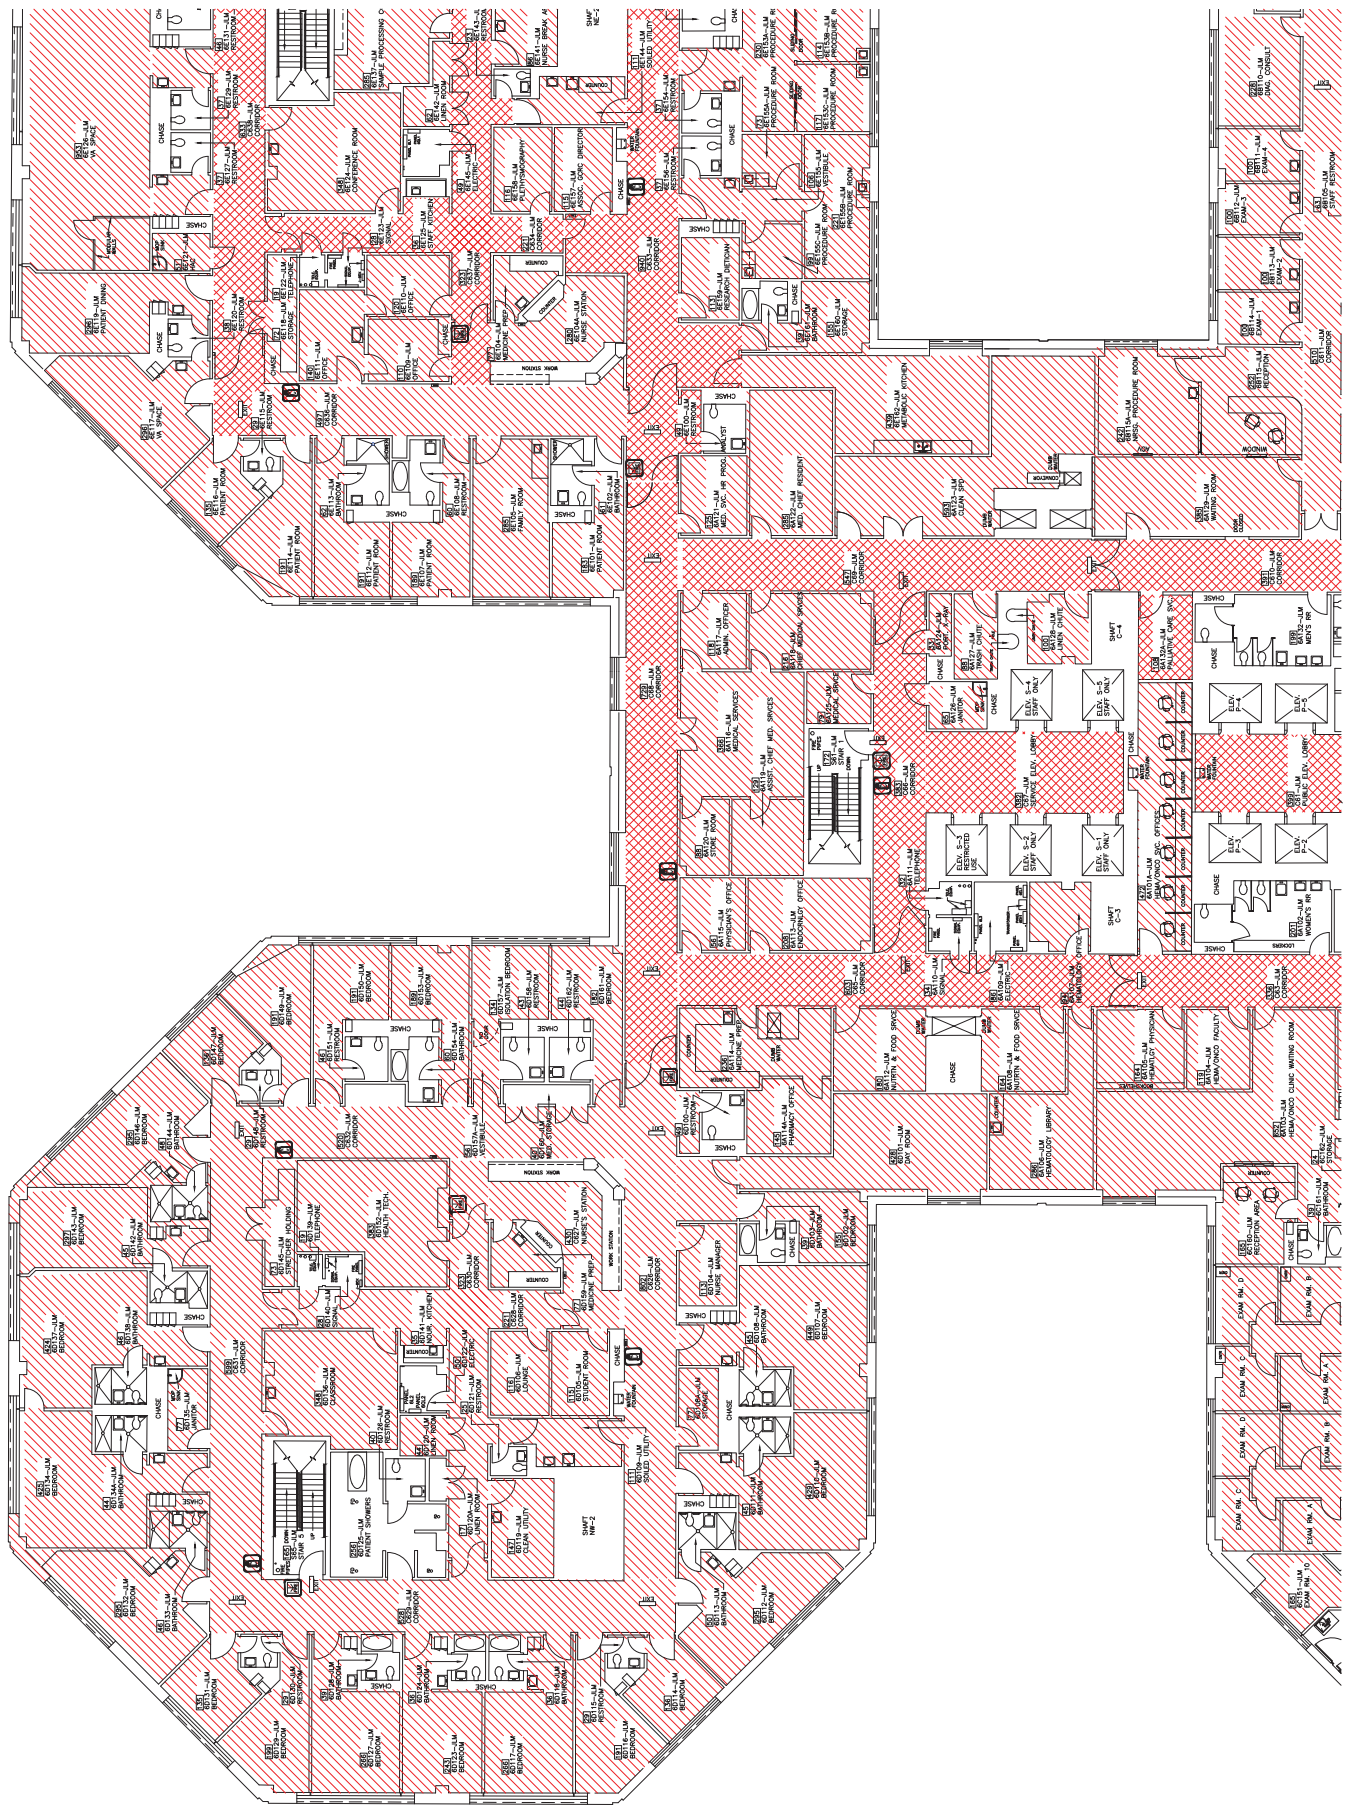

DEPARTMENT OF VETERANS AFFAIRS		Office of Facilities	
DATE	05/19/2014	PROJECT TITLE	SIXTH FLOOR POD-D & PARTIAL POD-A
PROJECT NUMBER		BUILDING NUMBER	1 SOULIM
DRAWING NO.	33 of 40	CHECKED	JC
		DRAWN	TA
		LOCATION	V.A.M.C. LR DIVISION
SEE COMPOSITE		REVISIONS	
DATE			

 

KEY PLAN

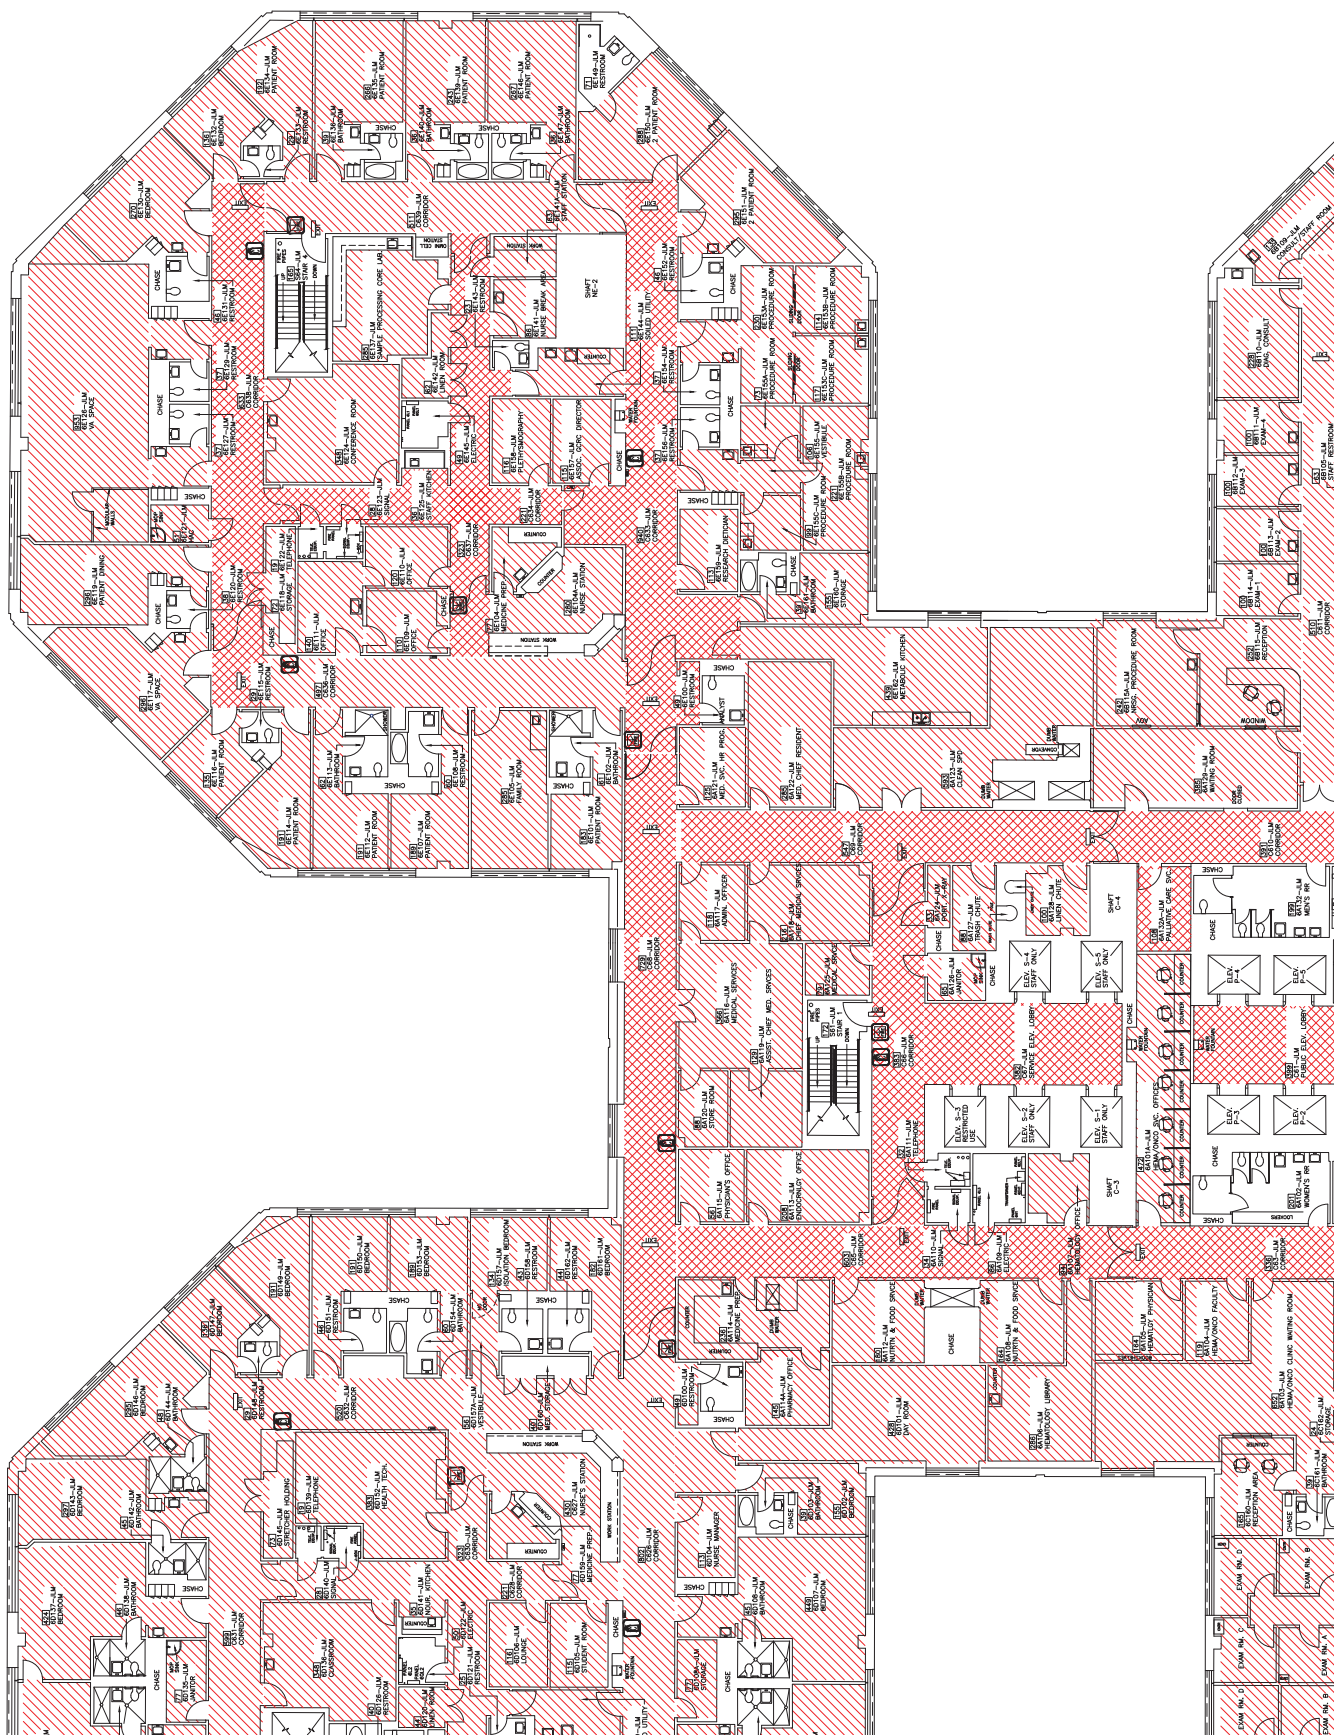

SEE COMPOSITE

SIXTH FLOOR
POD-E & PARTIAL POD-A


PROJECT TITLE	ASBESTOS CONTAINING MATERIALS

DATE
05/19/2014


PROJECT NUMBER

DRAWING NO.

Draw 34 of 40

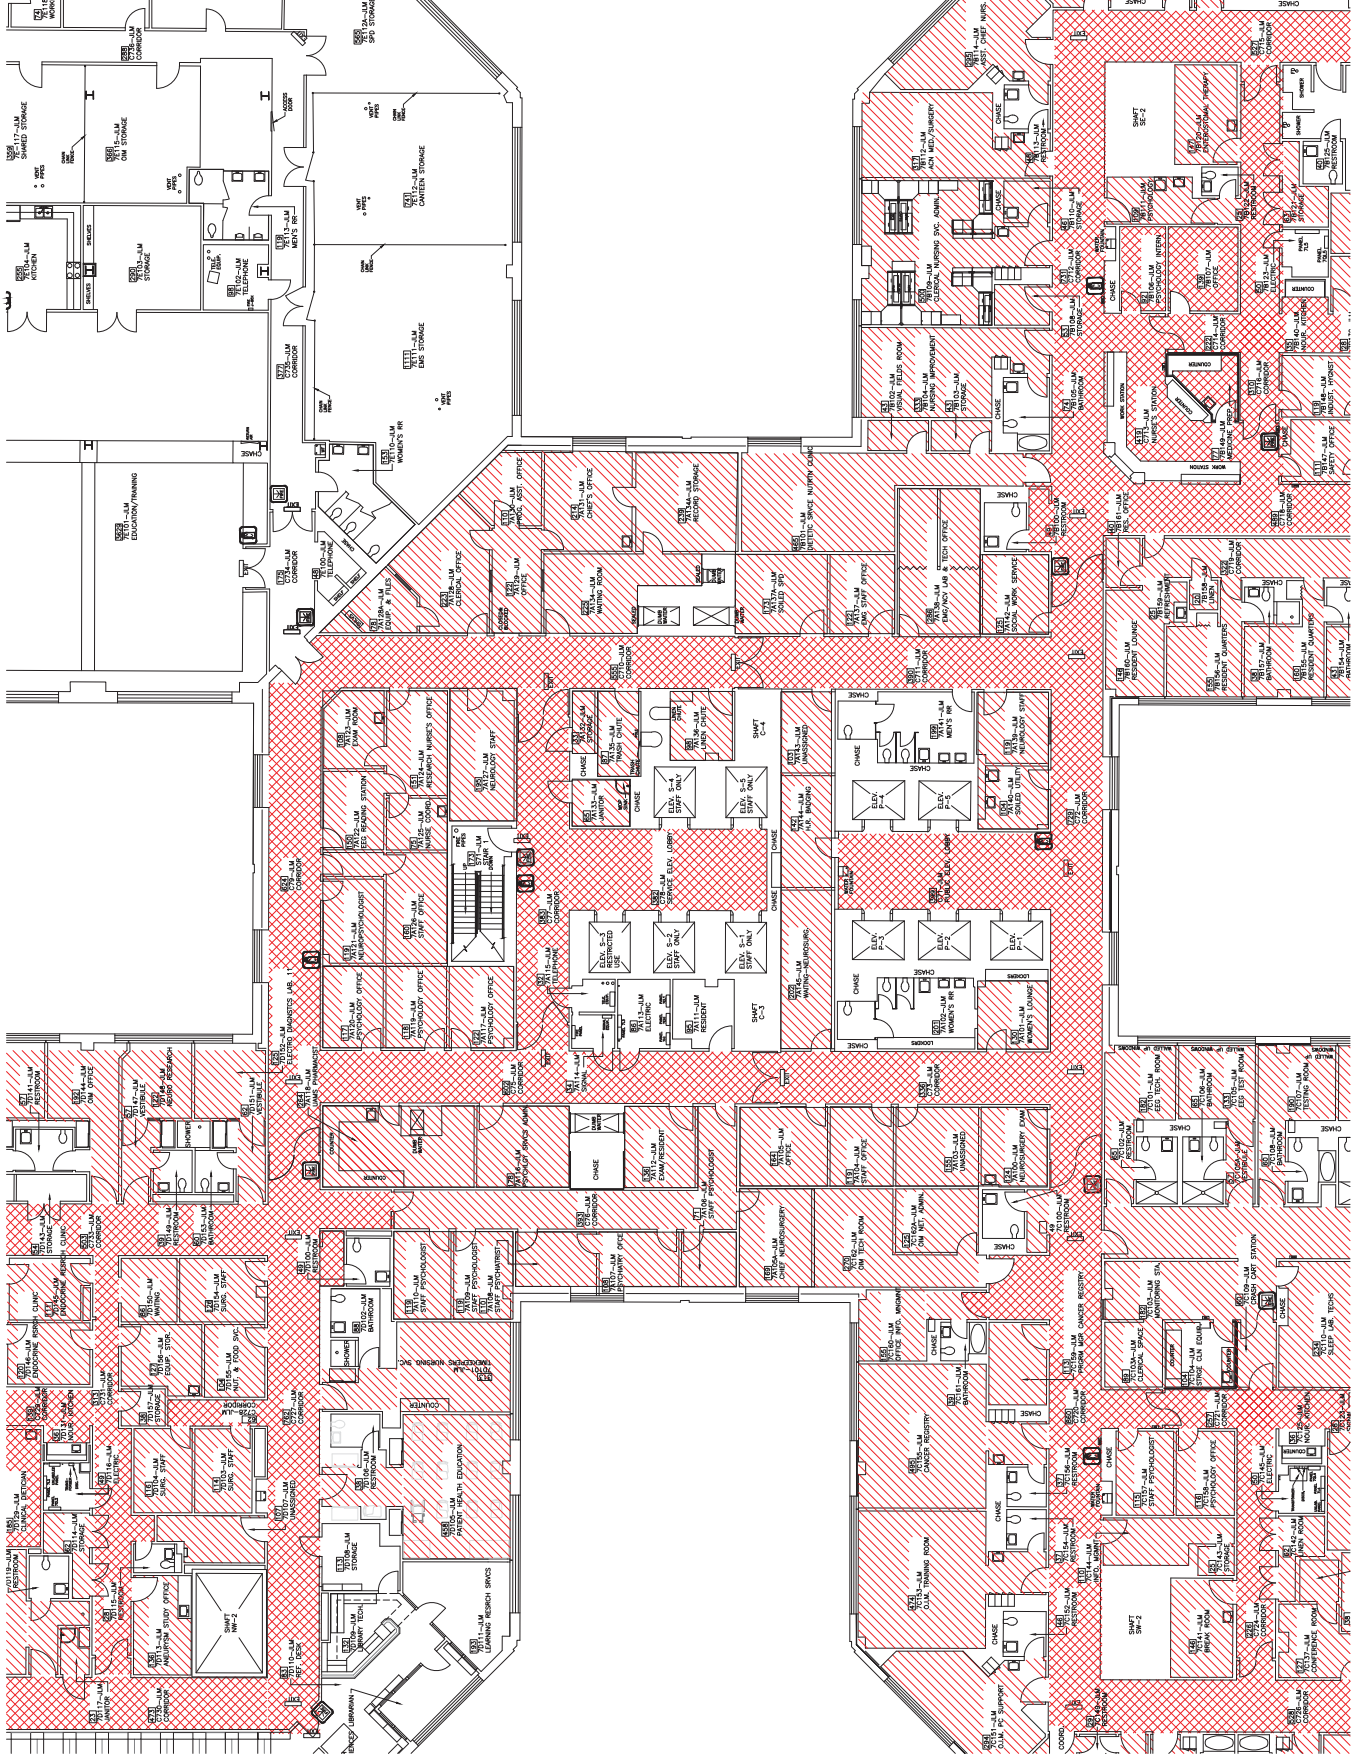


DEPARTMENT OF VETERANS AFFAIRS	Office of Facilities	DATE	05/19/2014
		PROJECT NUMBER	
DRAWING NO.	CHECKED	DRAWN	TA
PROJECT TITLE		SEVENTH FLOOR POD-A	
DRAWING TITLE		ASBESTOS CONTAINING MATERIALS	
BUILDING NUMBER		1 SOUTH	
LOCATION		JC	
DATE		35 of 40	
REVISIONS		DATE	

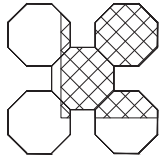


KEY PLAN




NOT TO SCALE

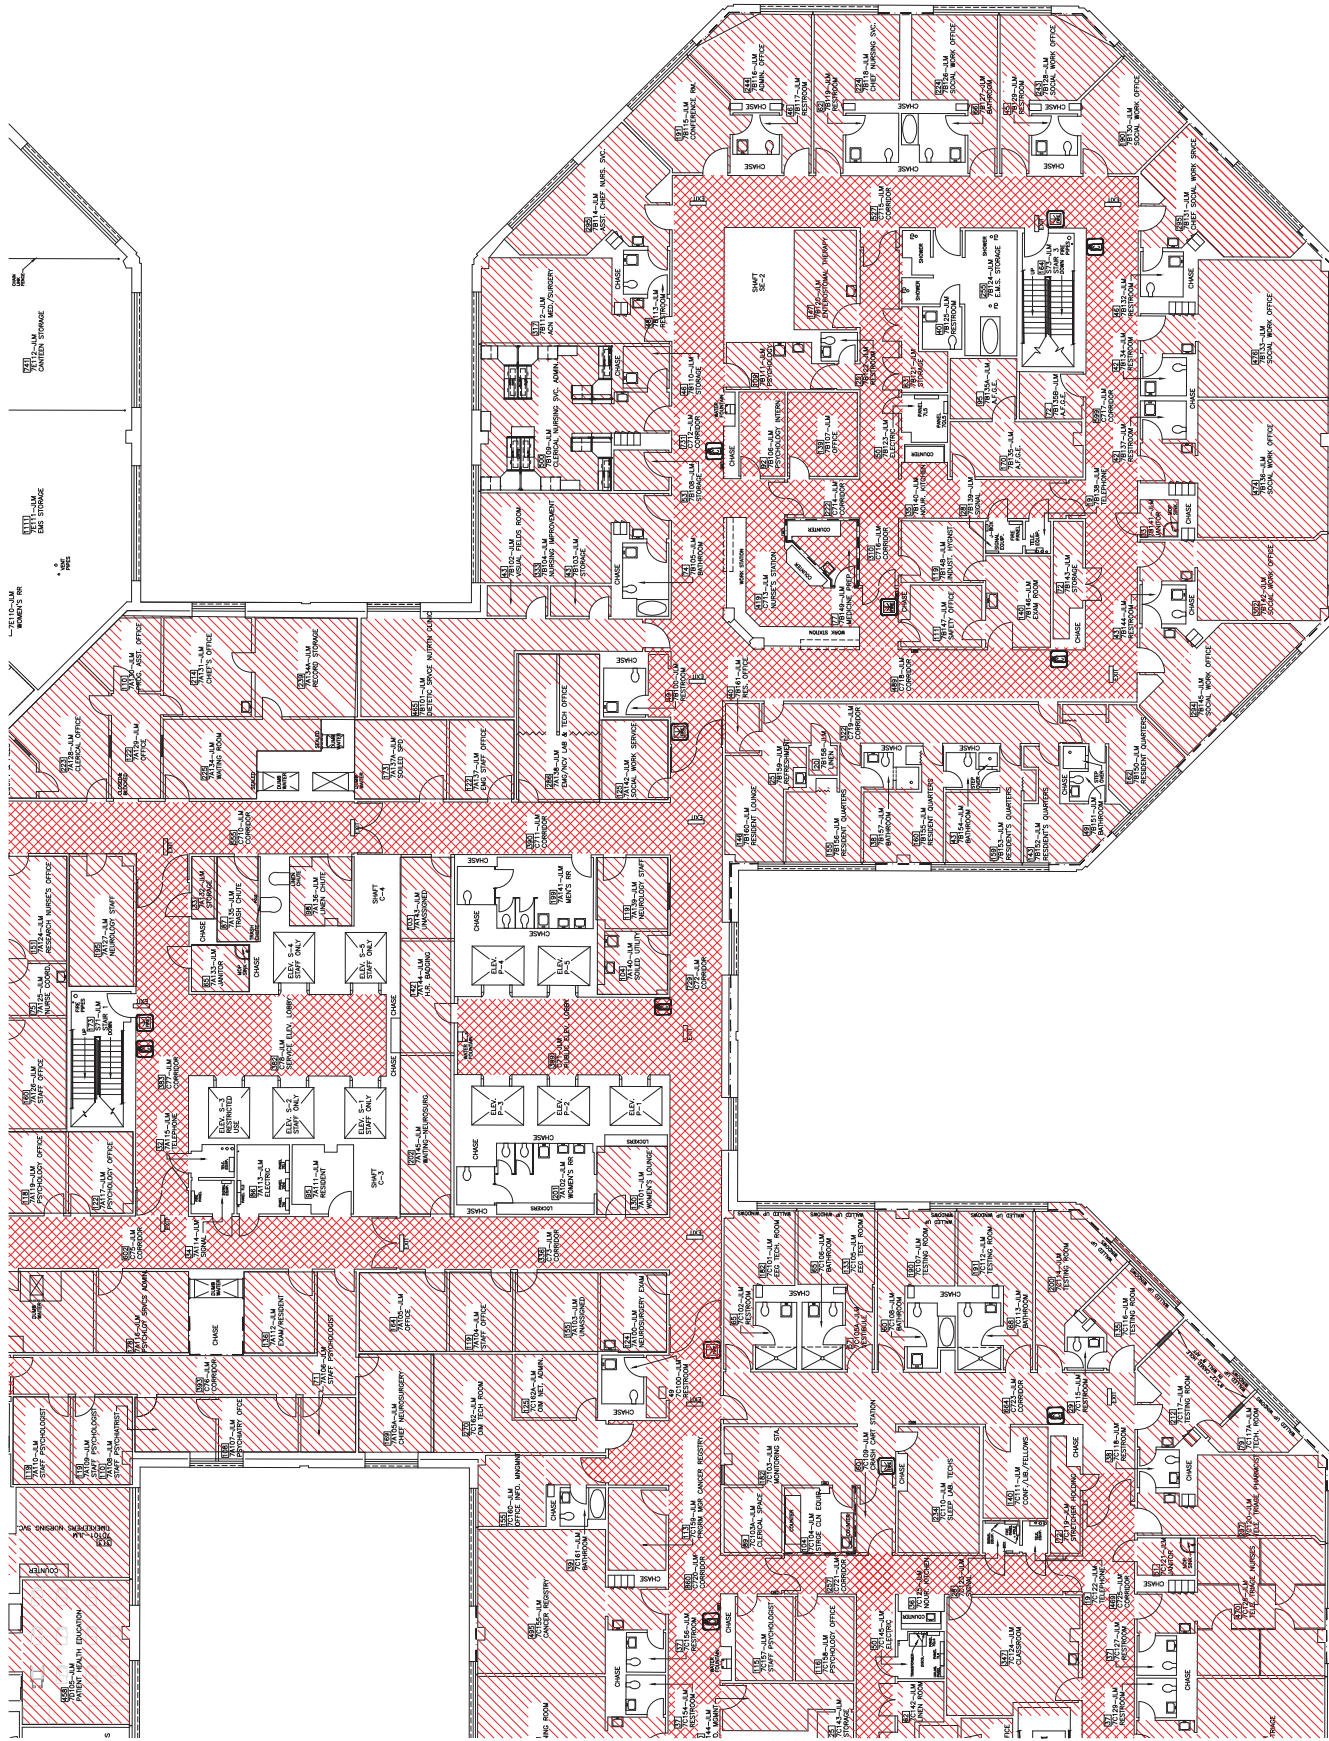


SEE COMPOSITE	REVISIONS	DRAWING TITLE										PROJECT TITLE										DATE		Office of Facilities		DEPARTMENT OF VETERANS AFFAIRS									
		SEVENTH FLOOR POD-B & PARTIAL POD-A										ASBESTOS CONTAINING MATERIALS										05/19/2014													
																						PROJECT NUMBER		DRAWING NO.											
																						BUILDING NUMBER		CHECKED		DRAWN		BY		DATE					
										LOCATION										V.A.M.C. LR DIVISION										36 of 40					

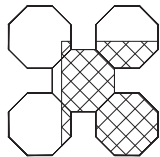

NOT TO SCALE

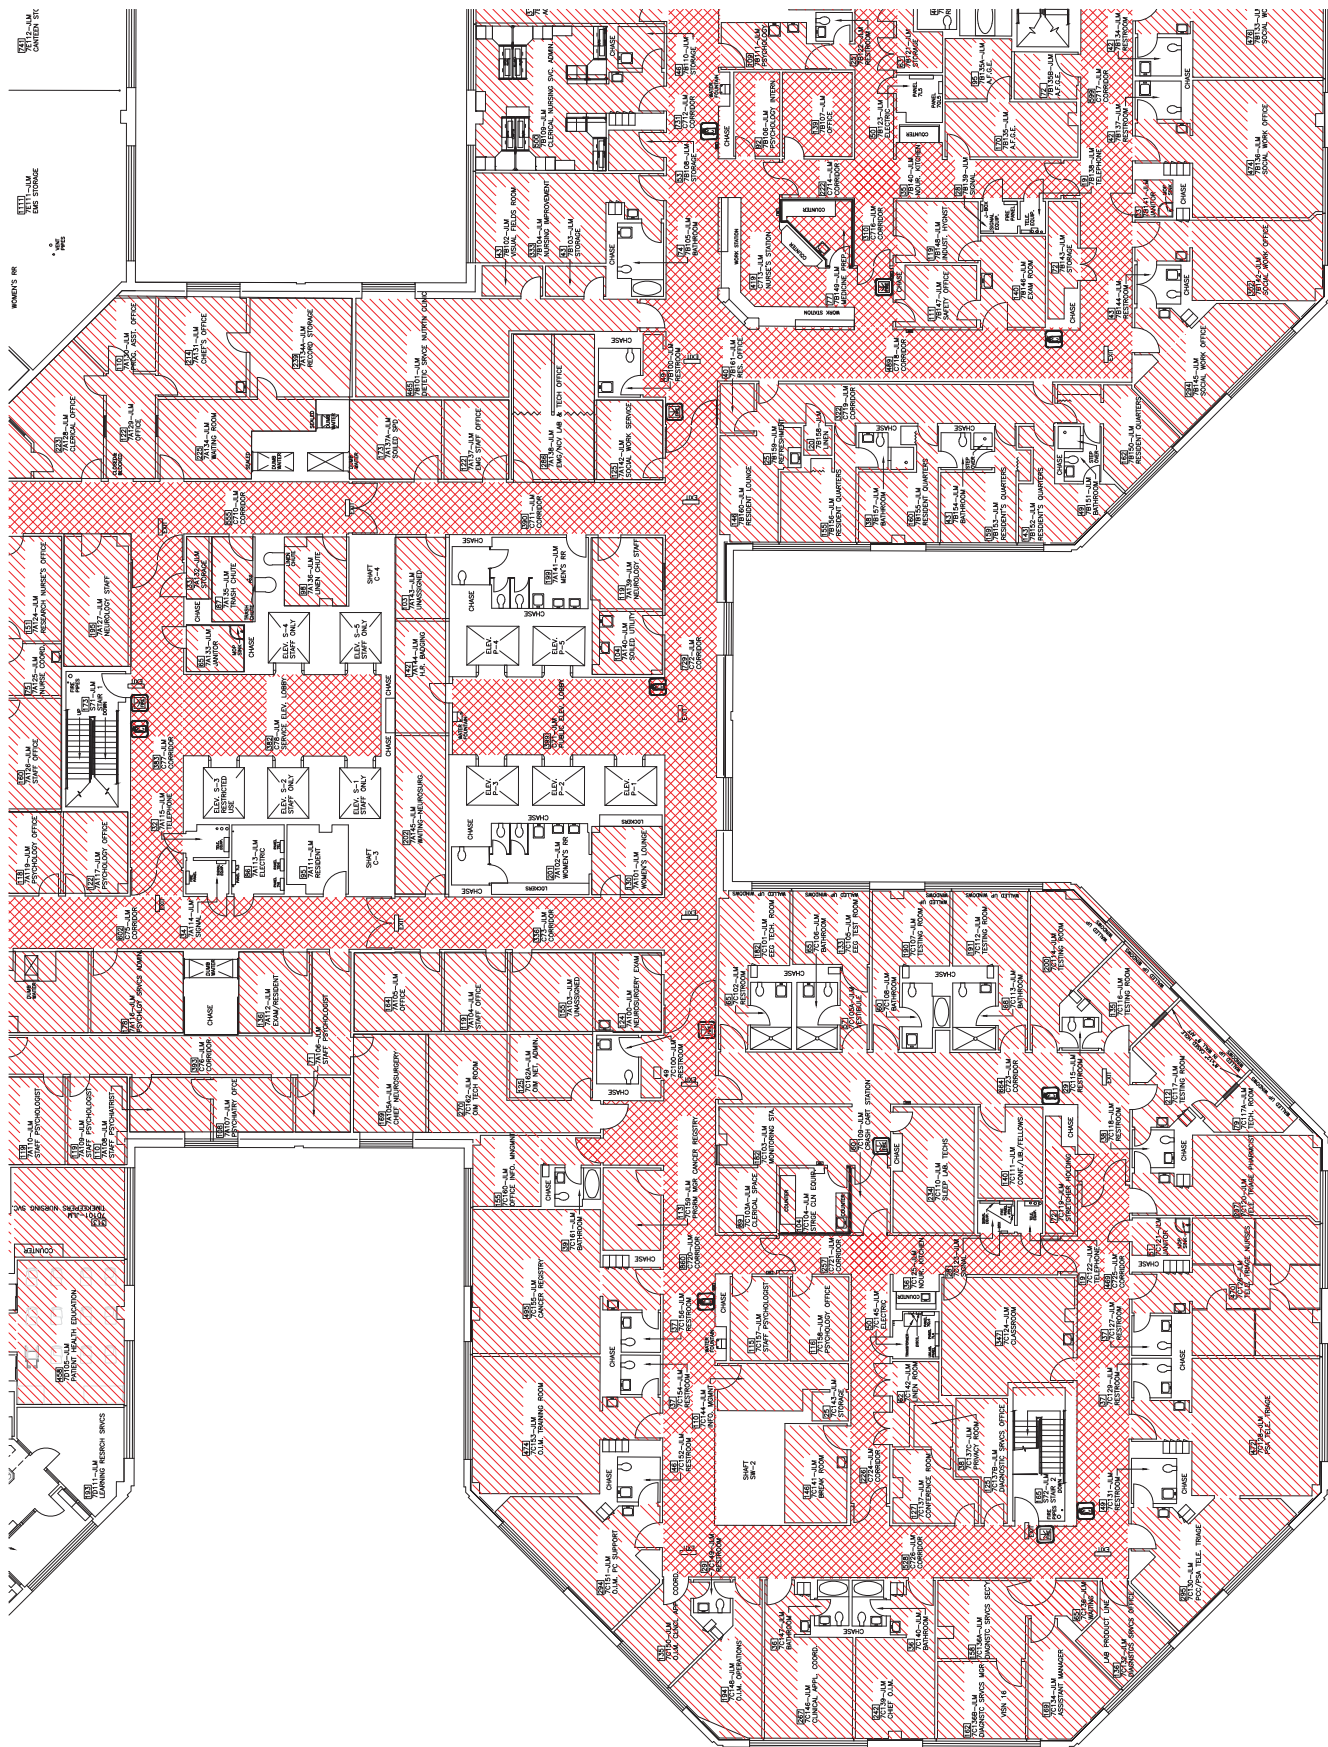


REVISIONS		DRAWING TITLE SEVENTH FLOOR POD-C & PARTIAL POD-A	PROJECT TITLE ASBESTOS CONTAINING MATERIALS		DATE 05/19/2014
	DATE				PROJECT NUMBER
			BUILDING NUMBER 1 SOUTH	CHECKED JC	DRAWN TA
			LOCATION V.A.M.C. LR DIVISION	DRAWING NO. Page 37 of 40	

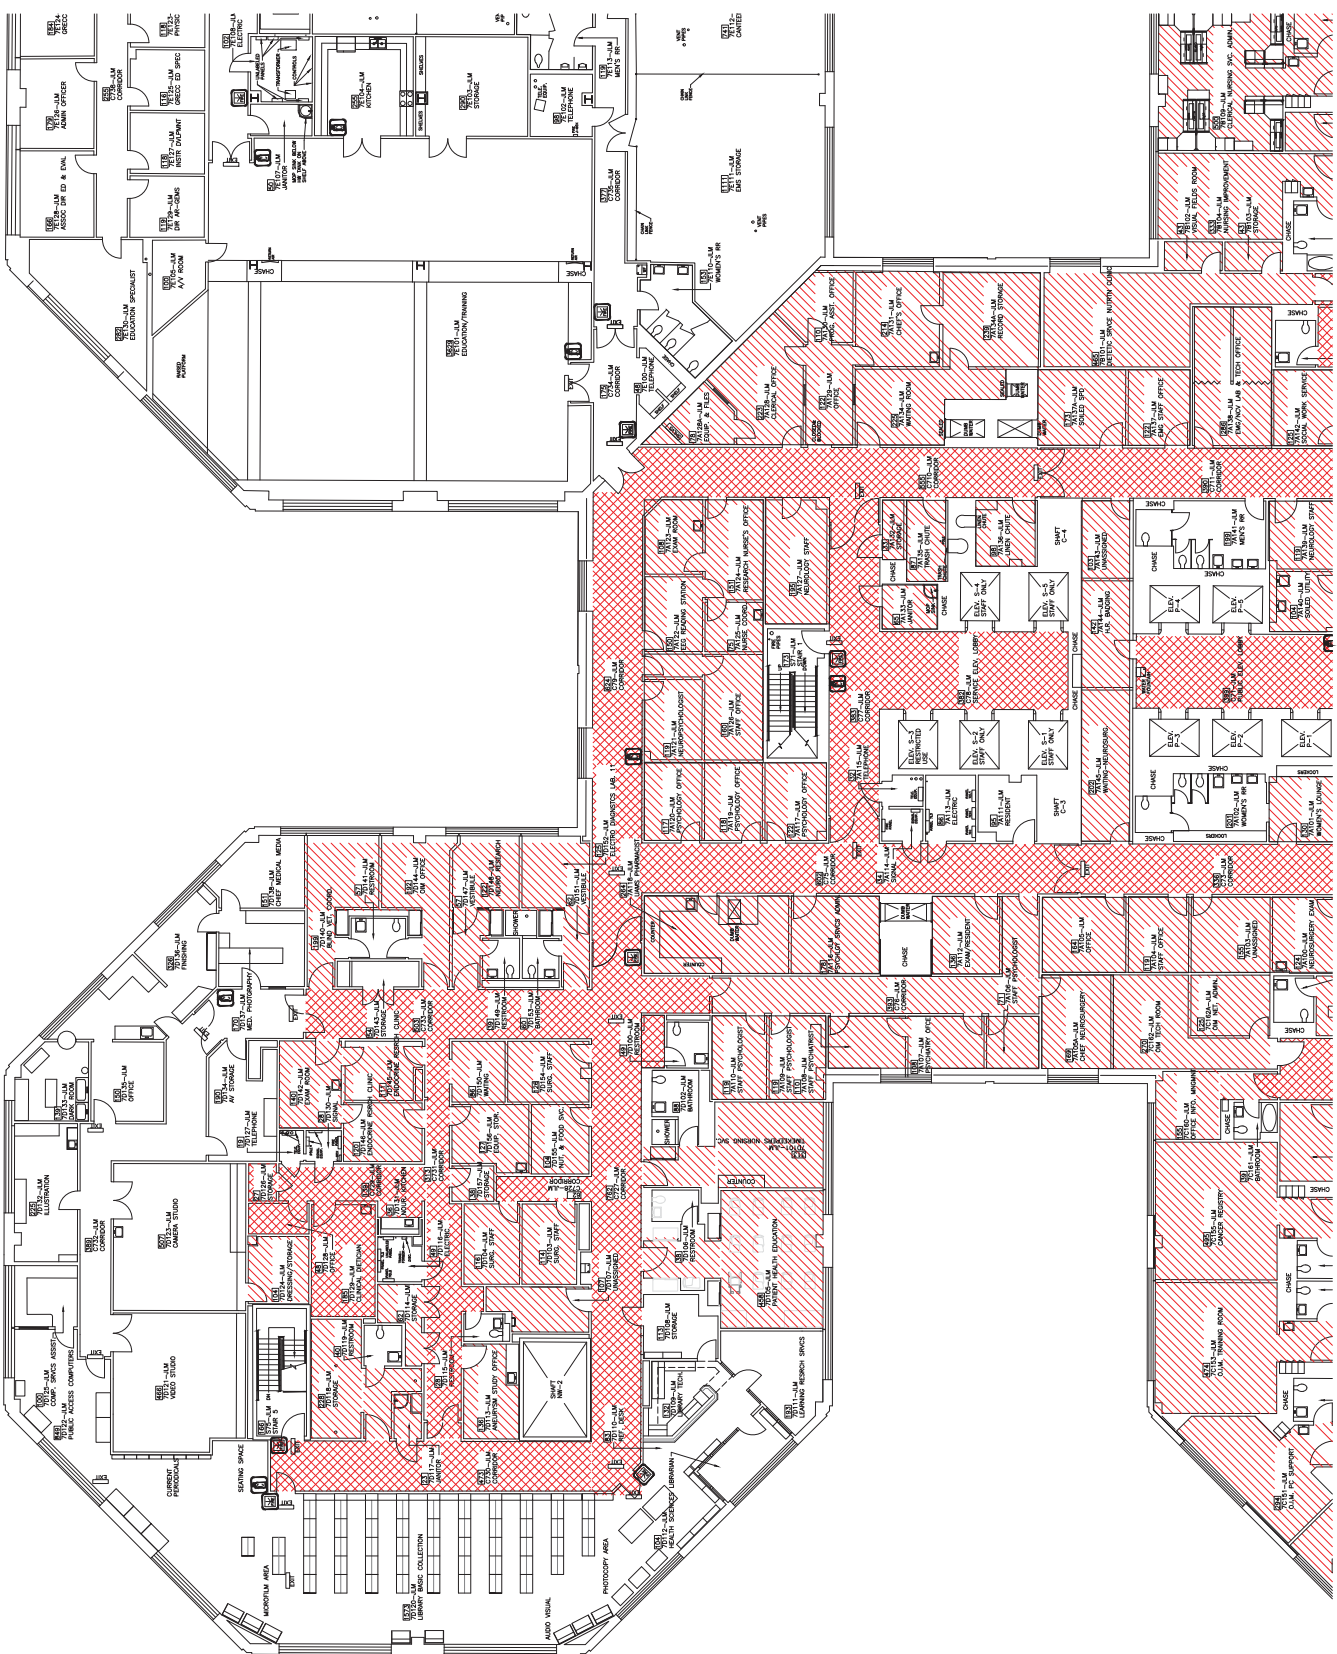


NOT TO SCALE


	DATE

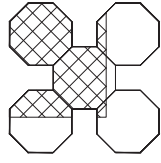


KEY PLAN

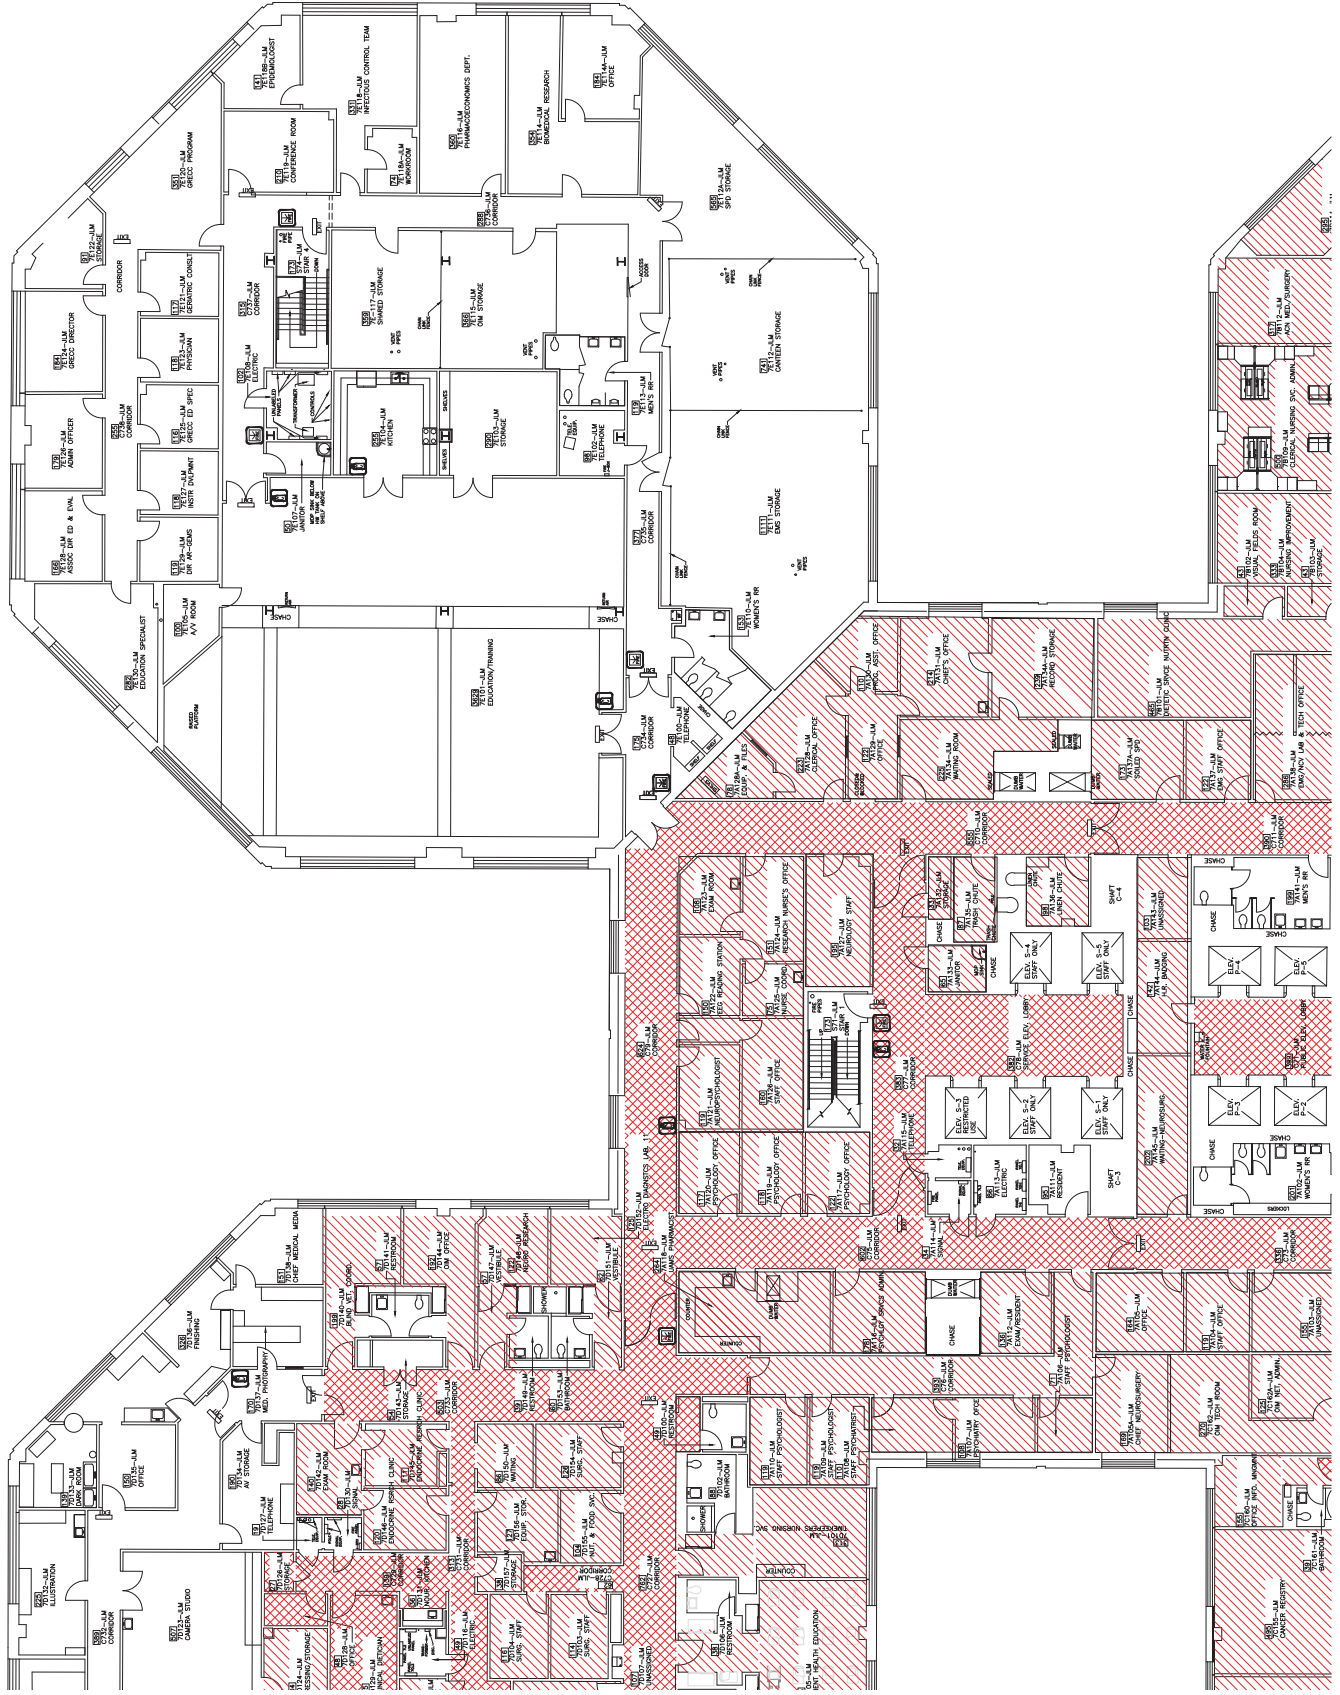

DEPARTMENT OF VETERANS AFFAIRS		Office of Facilities	
DATE	05/19/2014	PROJECT TITLE	SEVENTH FLOOR POD-E & PARTIAL POD-A
PROJECT NUMBER		ASBESTOS CONTAINING MATERIALS	
DRAWING NO.	39 of 40	BUILDING NUMBER	150JAM
		CHECKED	JA
		DRAWN	JA
		LOCATION	V.A.M.C. LR DIVISION
REVISIONS		DATE	

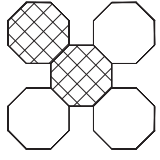

KEY PLAN

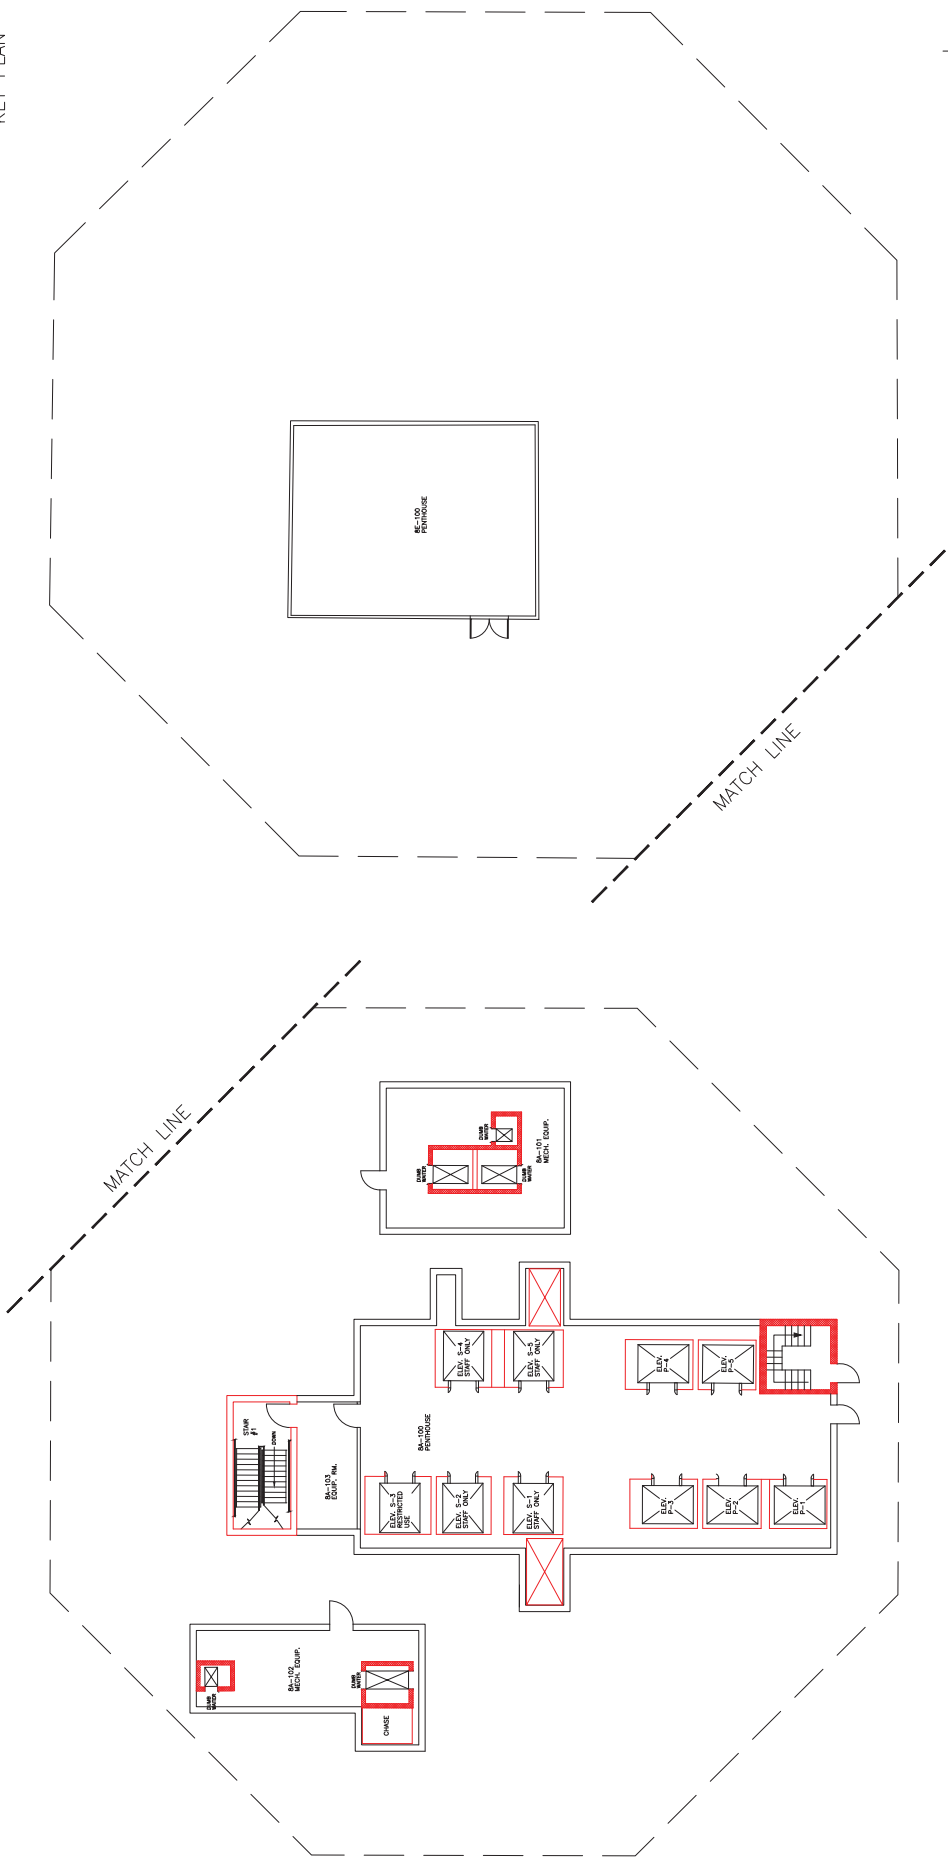

NOT TO SCALE

EIGHTH FLOOR POD E

EIGHTH FLOOR POD A

DATE 10 DEC 99		PROJECT TITLE ASBESTOS CONTAINING MATERIALS		DRAWING NO. 40 of 40	
PROJECT NUMBER		BUILDING NUMBER 1 SOJUM		DRAWN JC	
CHECKED TA		LOCATION		V.A.M.C. LR DIVISION	
DRAWING TITLE EIGHTH FLOOR POD-E & POD-A		APPROVED: CHIEF OF STAFF		APPROVED: SERVICE CHIEF	
APPROVED: MEDICAL CENTER DIRECTOR		APPROVED: FACILITY PLANNER		APPROVED: SERVICE CHIEF	
APPROVED: ASSOCIATE DIRECTOR		APPROVED: CHIEF ENGINEER		APPROVED: SERVICE CHIEF	
APPROVED: ASSISTANT DIRECTOR					
11-98		DATE		REVISIONS	