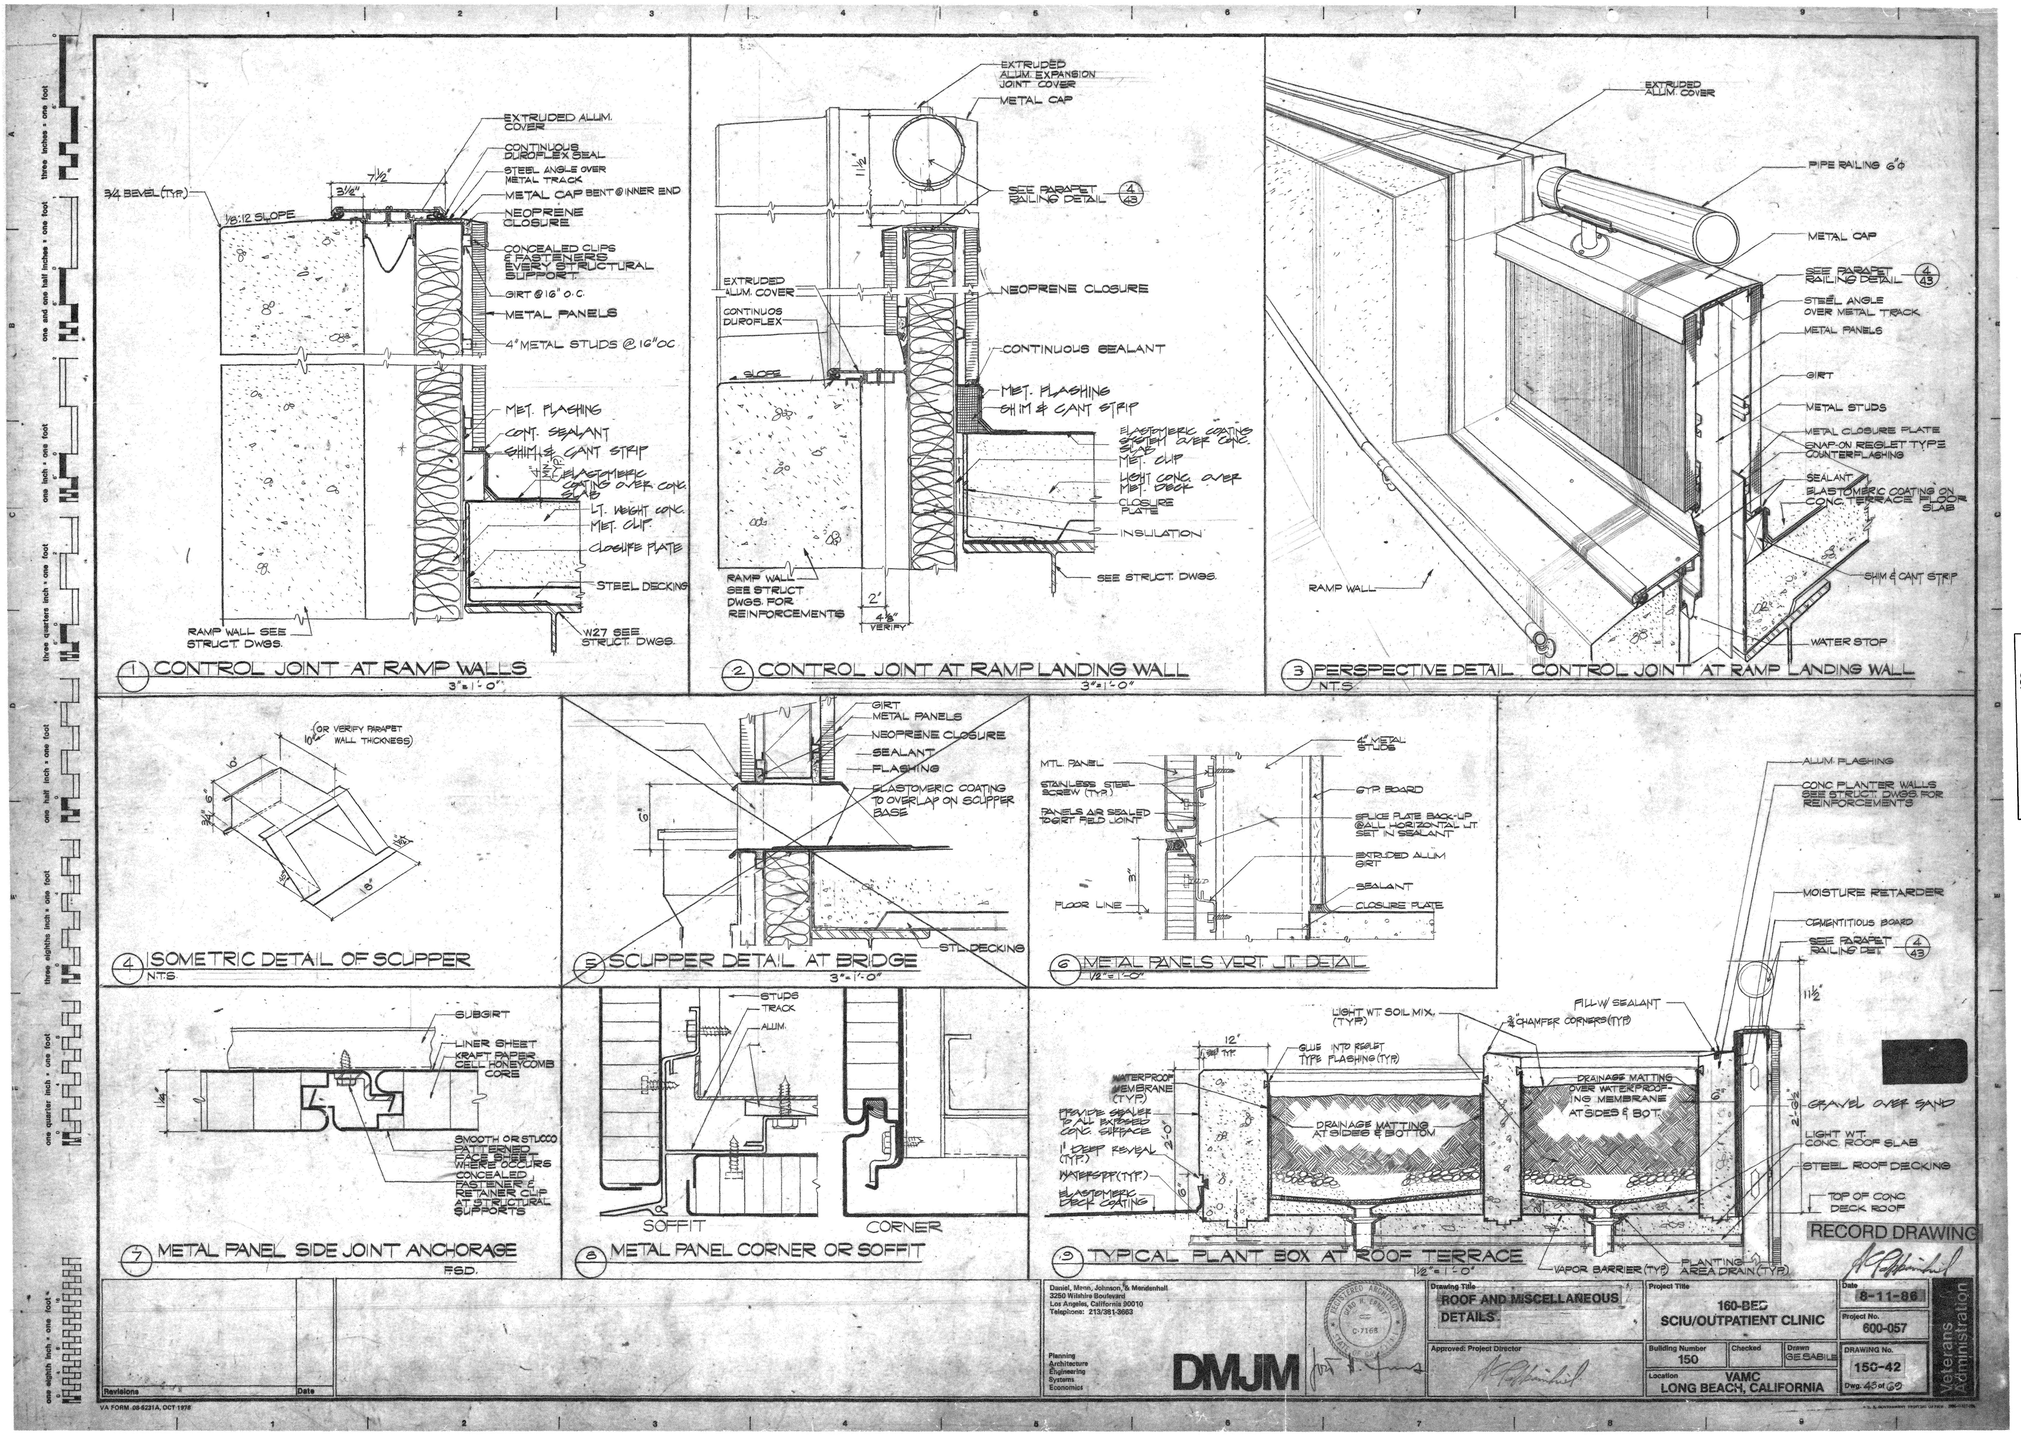

NOTE: RECORD DRAWINGS PROVIDED BY VA FOR REFERENCE ONLY. CONTRACTOR TO FIELD VERIFY EXISTING CONDITIONS.

FINAL CONSTRUCTION DOCUMENTS

Revisions	Date
FINAL CONSTRUCTION DOCUMENTS	03/17/14

CONSULTANTS:

ARCHITECT/ENGINEERS:

SRD ARCHITECTS INC
ARCHITECTURE INTERIORS PROJECT MANAGEMENT

3920 E. CORONADO STREET, SUITE 201
ANAHEIM CALIFORNIA 92807

1000 S FREMONT AVE, UNIT 53,
BLDG. A1, SUITE 1218
ALHAMBRA CALIFORNIA 91803
www.SRDarchitectsInc.com
O: 714 688 0212 • 626 202 0546 • FAX: 714 688 0244

Drawing Title: RECORD DRAWING - BUILDING 150

Approved: CHIEF CONSTRUCTION MANAGEMENT/DESIGN SECTION

PROJECT ENGINEER

Project Title: REPLACE ROOFING AT VARIOUS BUILDINGS

Location: 5901 EAST SEVENTH STREET LONG BEACH, CA 90822

Date: 03/17/14 | Checked: S.D. | Drawn: M.K.

Project Number: 600-13-107

Building Number: 150

Drawing Number: 150RA-003

Dwg. 40 of 46

Office of Construction and Facilities Management

Department of Veterans Affairs

VA FORM 08-6231

FINAL CONSTRUCTION DOCUMENTS