


three inches = one foot  
one inch = one foot  
one half inch = one foot  
three quarters inch = one foot  
one half inch = one foot  
three eighths inch = one foot  
one quarter inch = one foot  
one eighth inch = one foot

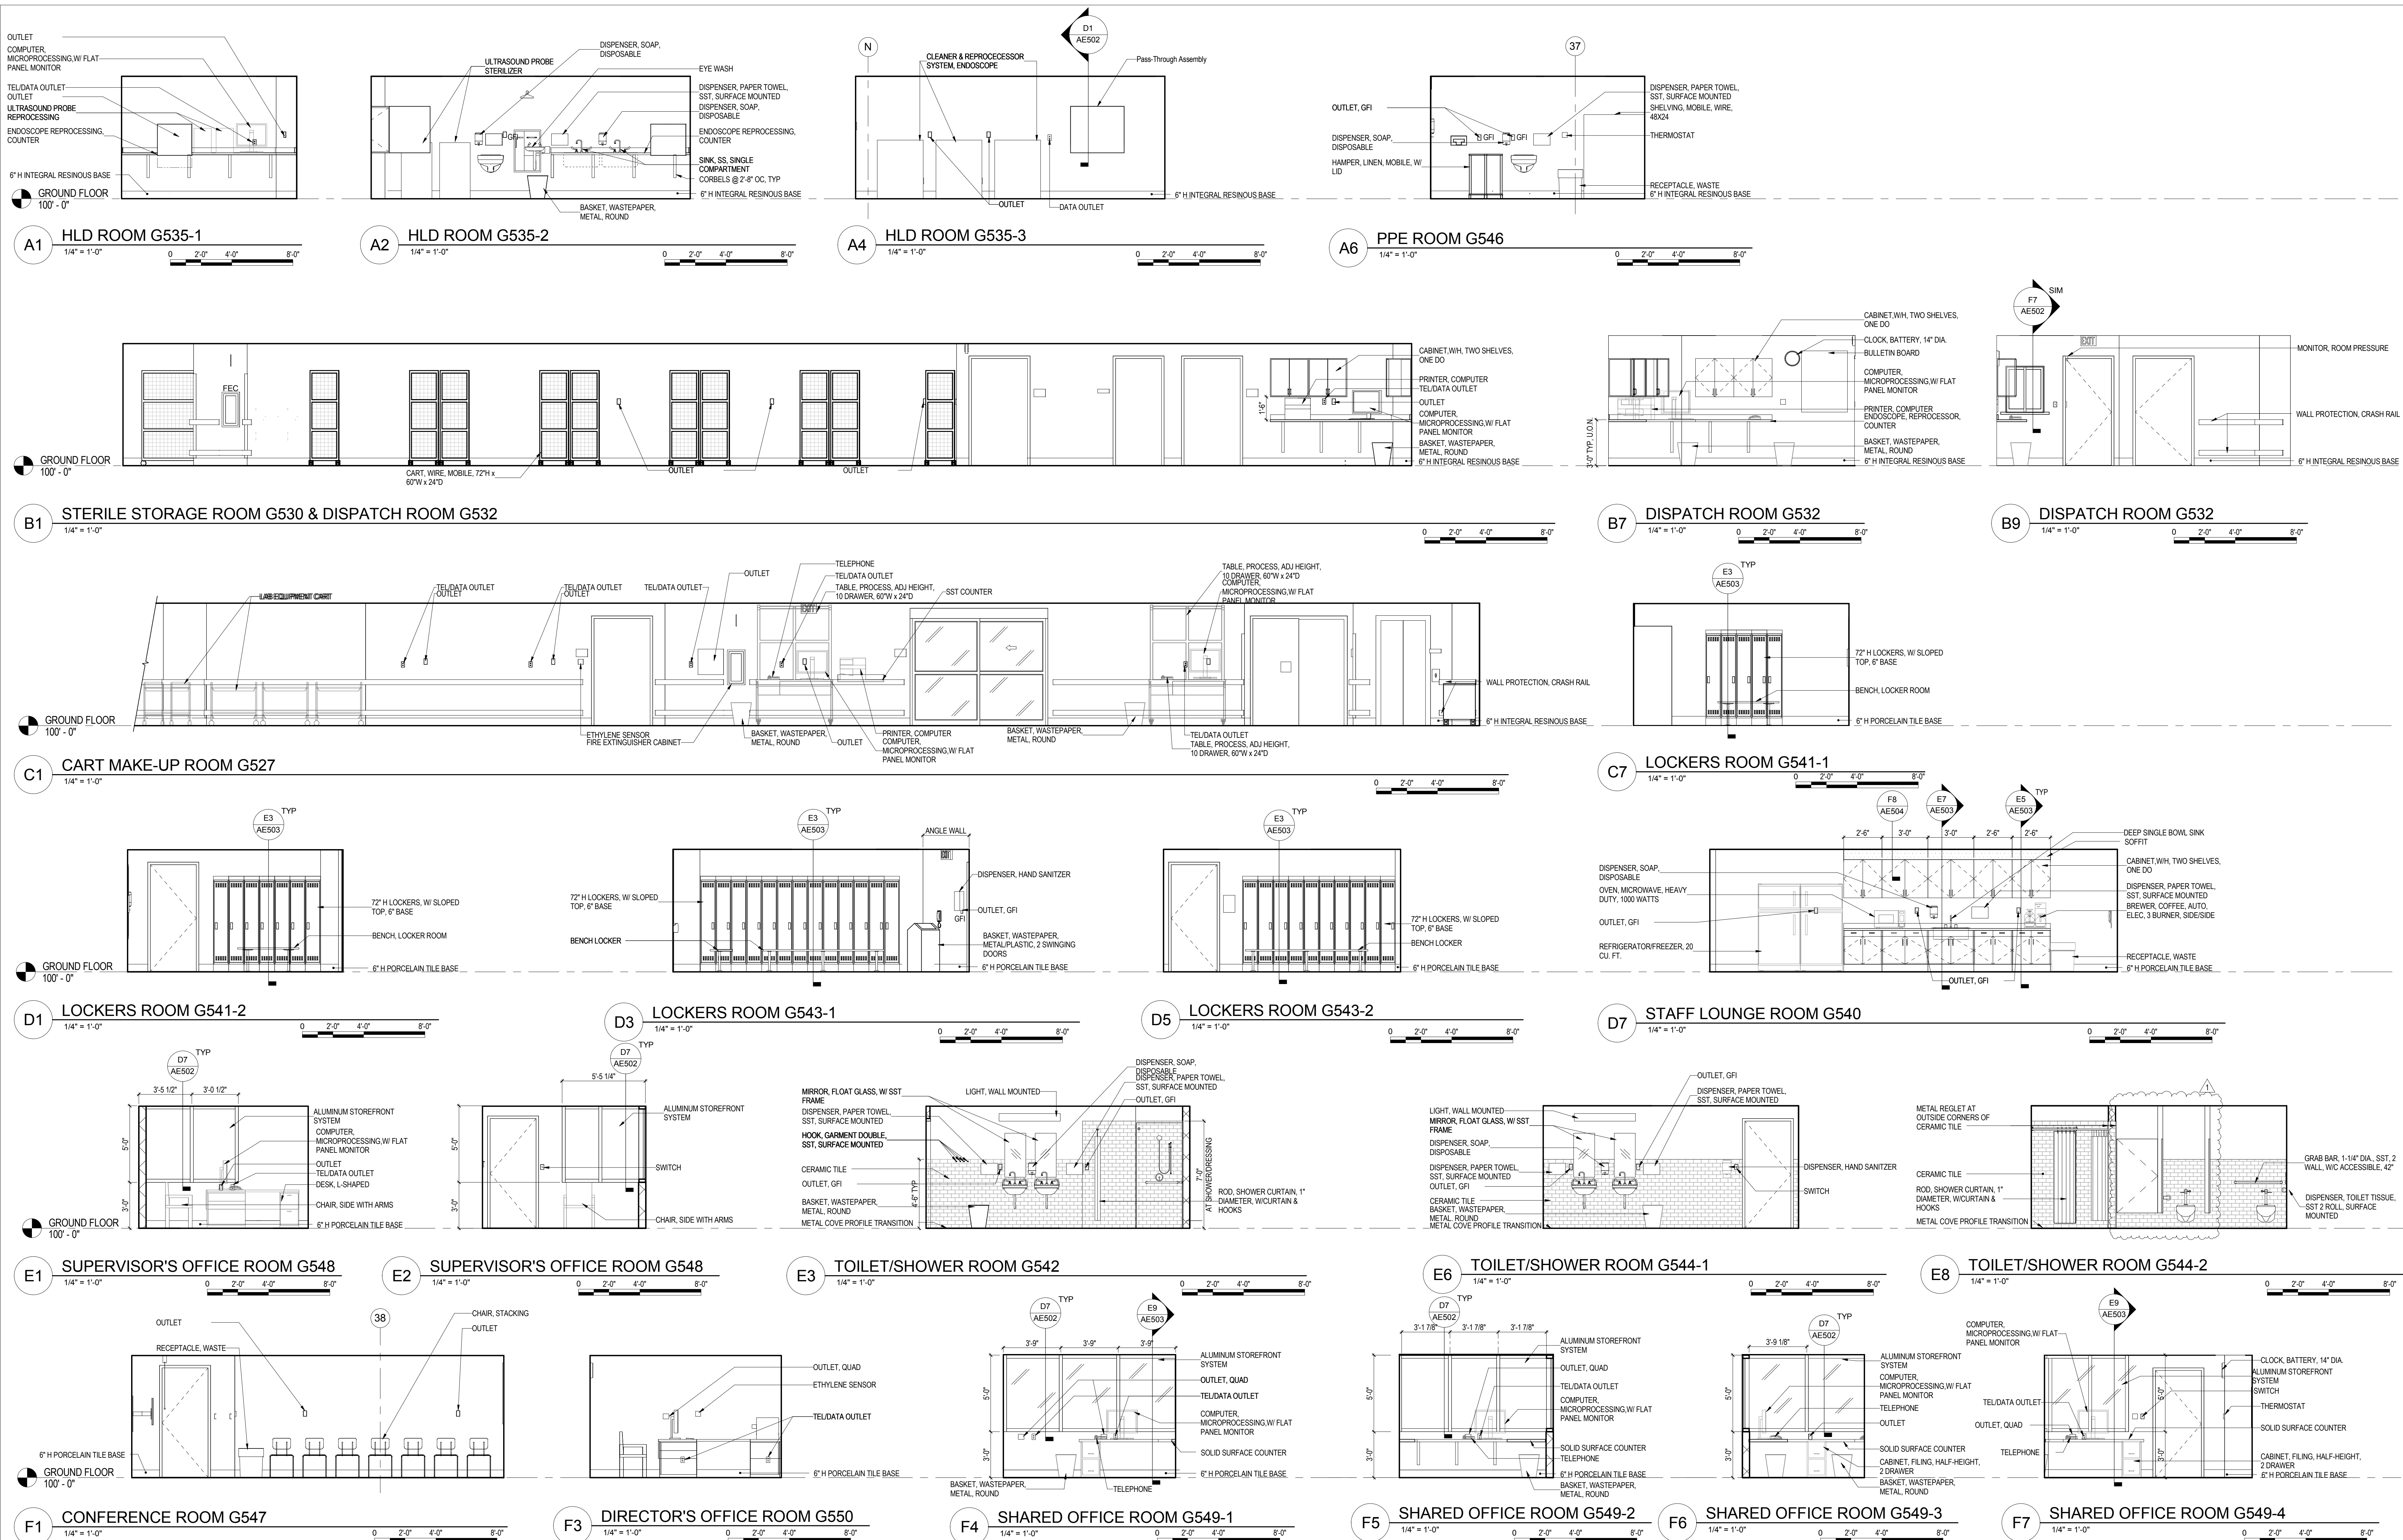

CONSULTANTS:

WARNING: This warning is required to be included on this document under New York State Education Law, Article 145, Section 7209, Sub-Paragraph 2. It is a violation of the aforementioned law for any person, unless acting under the direction of a licensed professional engineer or land surveyor, to alter any portion of the design set forth on this document. If any item of the design set forth in this document is altered, the altering engineer or land surveyor shall affix to the item his/her seal and the notation "altered by" followed by her/his signature and the date of such alteration and a specific description of the alteration.

ARCHITECT/ENGINEERS:

**HDR**  
Henningson, Durham & Richardson, Architecture and Engineering, P.C.  
500 Seventh Ave, 11th Floor, New York, NY 10018 · 212-904-1212

Interior Elevations

Approved: Project Director

Project Title  
VA NY Harbor Healthcare System  
Manhattan Campus Ground Floor Phase 1B  
Sterile Processing Suite  
Location  
423 E 23RD STREET, NEW YORK, NY 10010  
Date  
02/18/2014  
Checked  
BC  
Drawn  
PT

Project Number  
219359  
Building Number  
6  
Drawing Number  
A1701

Office of  
Construction  
and Facilities  
Management

VA U.S. Department of Veterans Affairs