




three inches = one foot
one and one half inches = one foot
one inch = one foot
three quarters inch = one foot
one half inch = one foot
three eighths inch = one foot
one quarter inch = one foot
one eighth inch = one foot

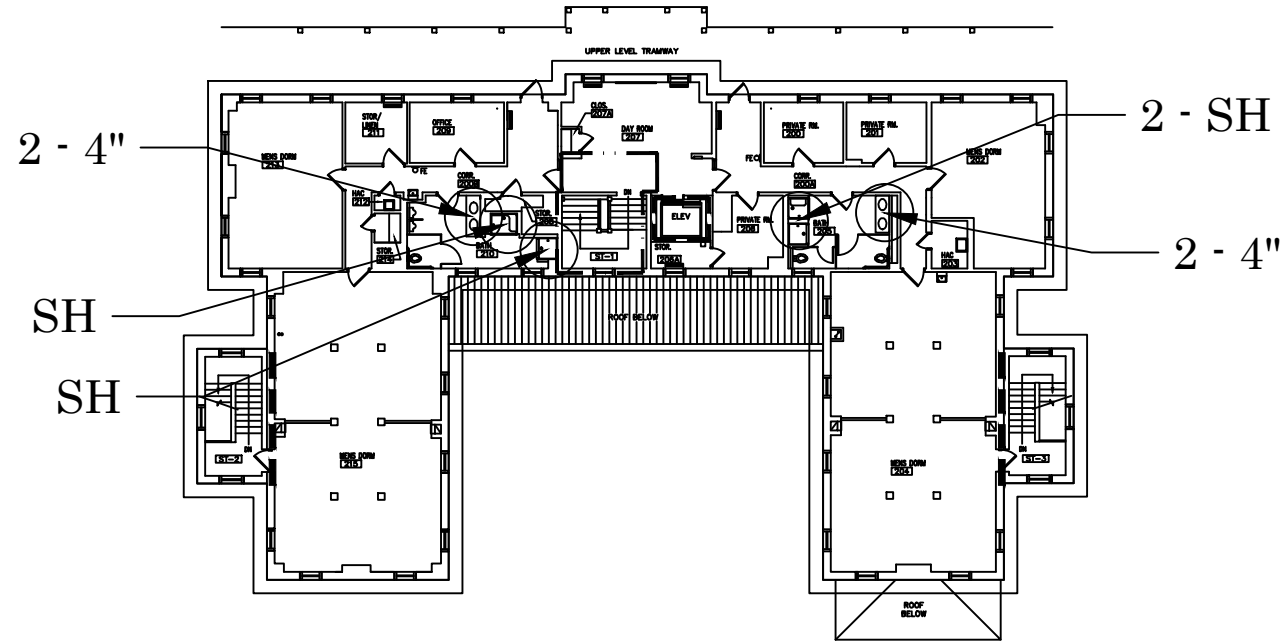

SECOND FLOOR PLAN – BUILDING #6

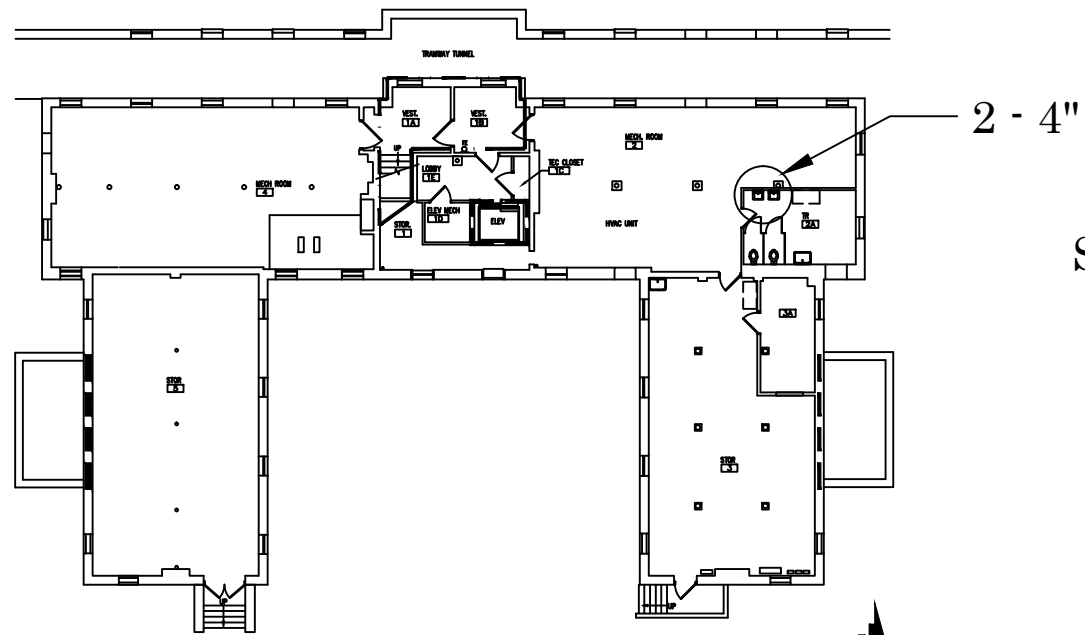


BASEMENT FLOOR PLAN – BUILDING #6

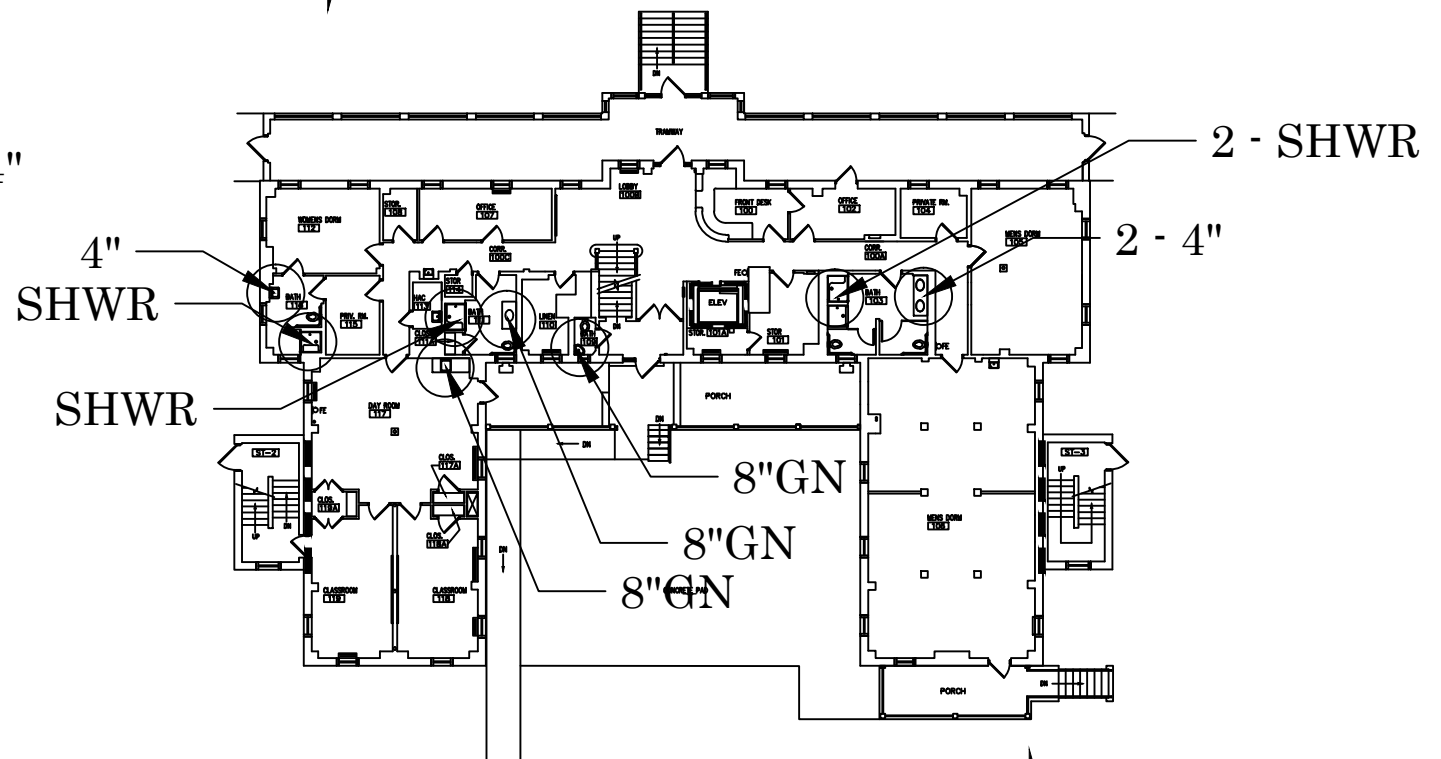


FIRST FLOOR PLAN – BUILDING #6


8-SHWR
9-4" LAVS
3-8" GN

--	--	

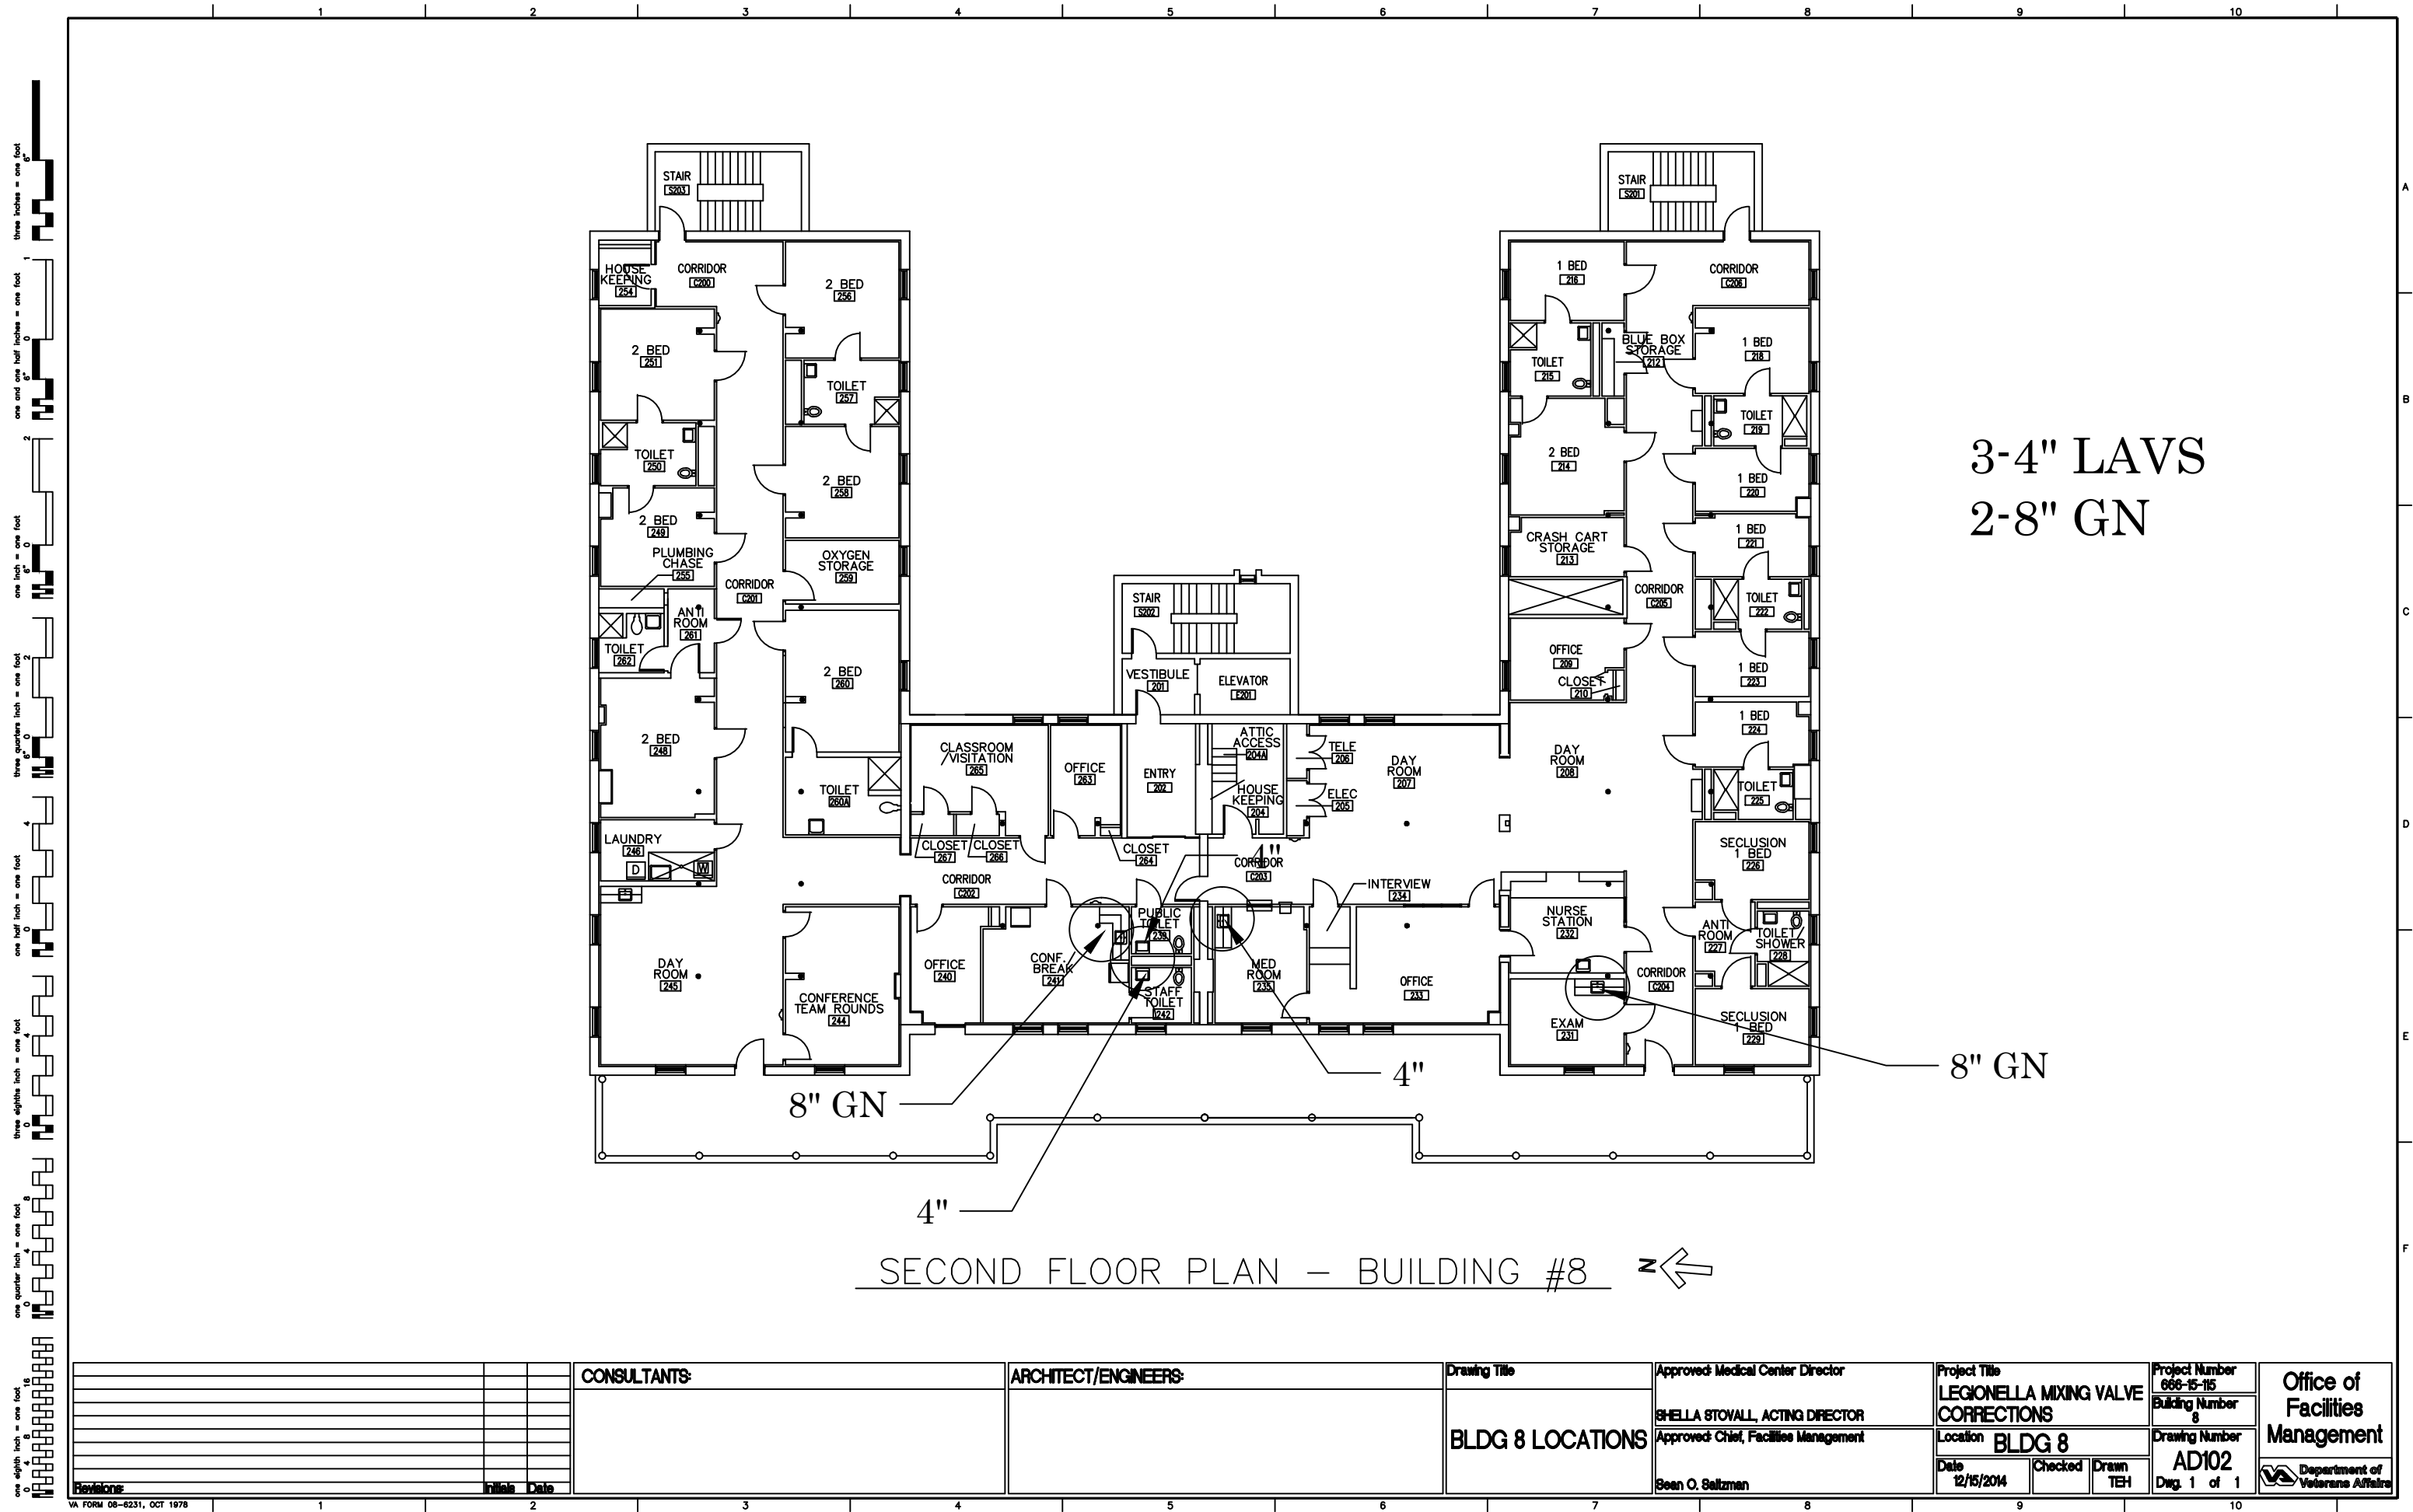

SECOND FLOOR PLAN – BUILDING #8

					CONSULTANTS:		ARCHITECT/ENGINEERS:		Drawing Title	Approved: Medical Center Director		Project Title		Project Number		Office of Facilities Management					
							BLDG 8 LOCATIONS			SHELLA STOVALL, ACTING DIRECTOR		LEGIONELLA MIXING VALVE CORRECTIONS		Building Number				666-15-115			
										Approved: Chief, Facilities Management		Location		BLDG 8				Drawing Number		8	
												Date		Checked				Drawn		AD102	
Revisions:			Initials Date							Sean O. Saltzman		12/15/2014			TEH	Dwg. 1 of 1		 Department of Veterans Affairs			

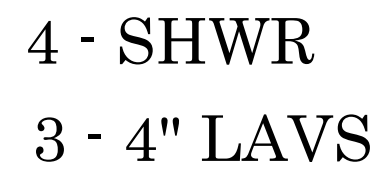

4"


TOILET


GALLERY ABOVE

up

down

FIRST FLOOR PLAN - R-24

			CONSULTANTS:		ARCHITECT/ENGINEERS:		Drawing Title		Approved Medical Center Director		Project Title		Project Number		<div style="text-align: center;"> Office of Facilities Management  Department of Veterans Affairs </div>			
							BLDG 24 LOCATIONS		SHELLA STOWALL, ACTING DIRECTOR		LEGIONELLA MIXING VALVE CORRECTIONS		666-15-115					
									Approved: Chief, Facilities Management		Location		BLDG 24				Drawing Number	
											Date		Checked				Drawn	
											12/15/2014		TEH					
Revisions:			Initials		Date				Sean O. Saltzman				AD103					
													Dwg. 1 of 1					

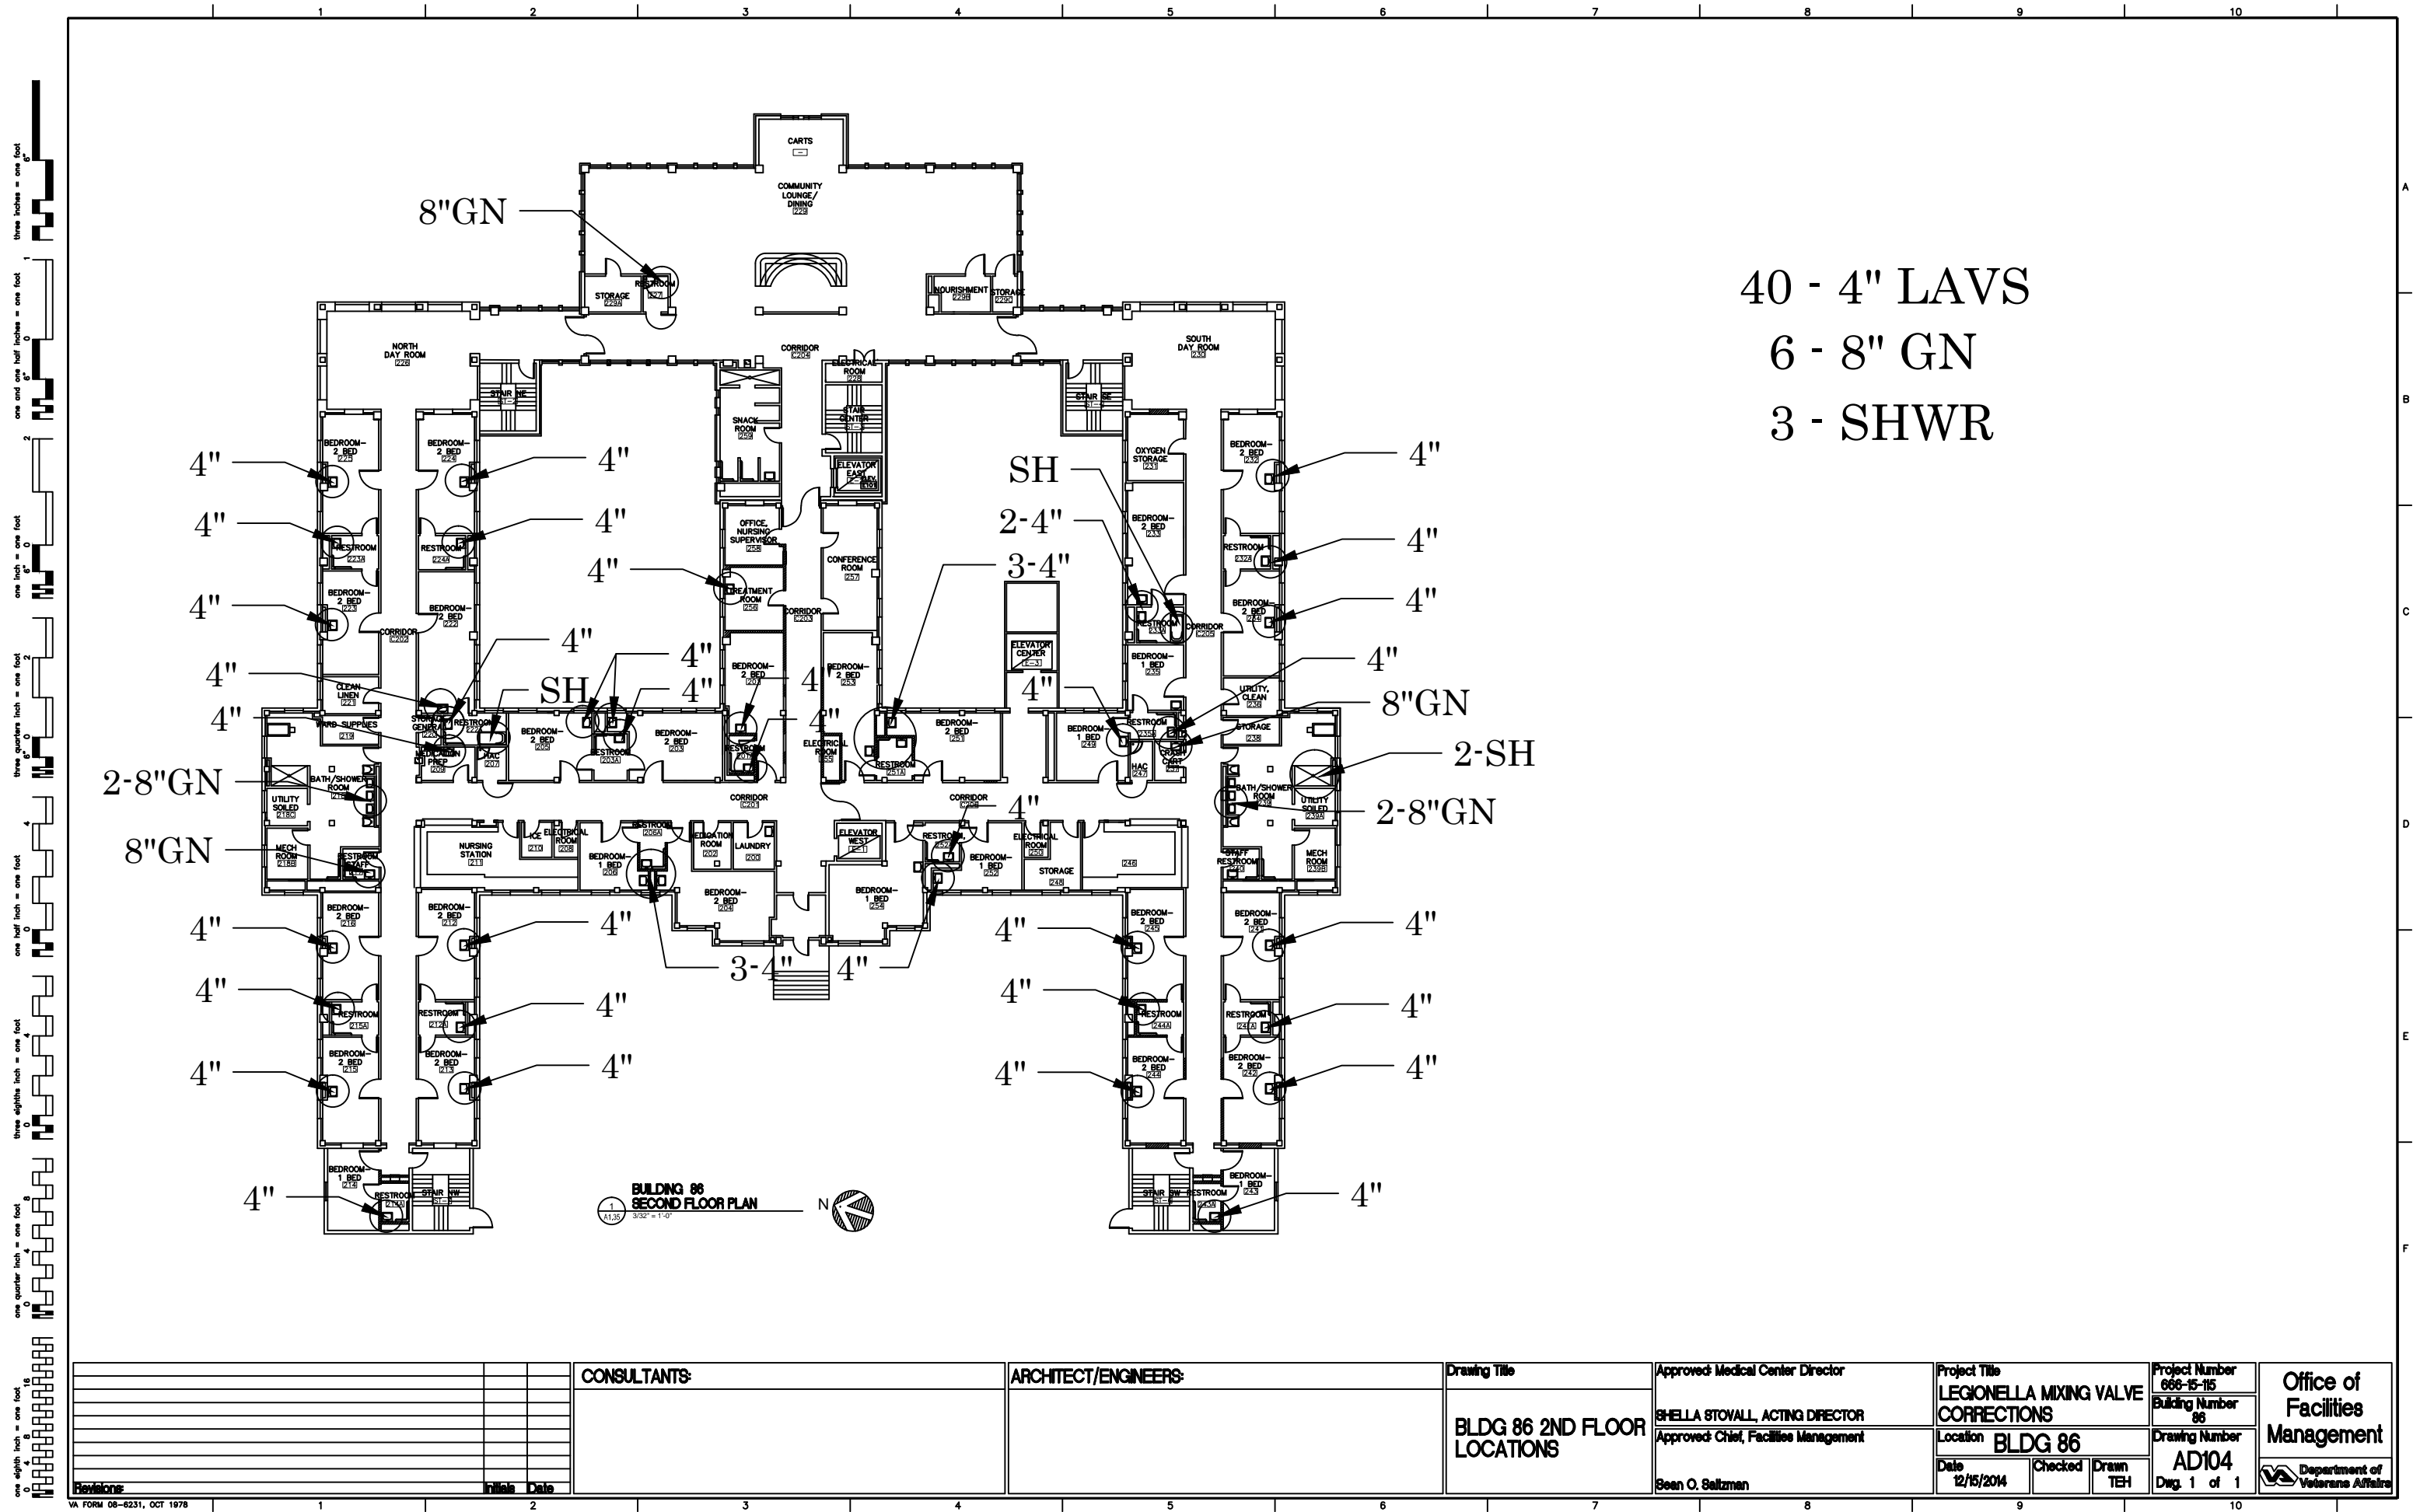

one eighth inch = one foot
one quarter inch = one foot
three eighths inch = one foot
one half inch = one foot
three quarters inch = one foot
one inch = one foot
one and one half inches = one foot
two inches = one foot
three inches = one foot

SHERIDAN VA MEDICAL CENTER


1898 FORT RD, SHERIDAN WY.

LEGIONELLA MIXING VALVE CORRECTIONS

BUILDINGS 6, 8, 24, 86

DECEMBER 2014

PROJECT NO. 666-15-115

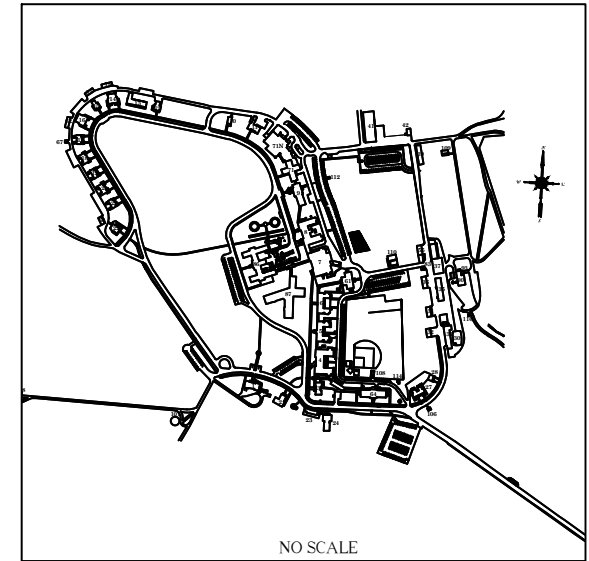


SHEET INDEX

GI001	COVER SHEET
AD101	BLDG 6
AD102	BLDG 8
AD103	BLDG 24
AD104	BLDG 86 SECOND FLOOR

GENERAL NOTES:

1. TYPICAL LAYOUTS ARE FOR GENERAL USE ONLY.
CONTRACTOR TO FIELD VERIFY QUANTITIES OF
ALL ITEMS TO BE REMOVED AND INSTALLED.

			CONSULTANTS:		ARCHITECT/ENGINEERS:		Drawing Title		Approved: Medical Center Director		Project Title		Project Number		Office of Facilities Management 	
							COVER SHEET		Sheila Stovall, Acting Director		Legionella Mixing Valve Corrections		666-15-115			
Approved: Chief, Facilities Management		Location							Building Number							
Date		Checked							Drawing Number							
Revisions:									Sean O. Saltzman		Bldgs 6,8,24,86		GI001			
Initials			Date								12/15/2014		TEH		Dwg. 1 of 5	