
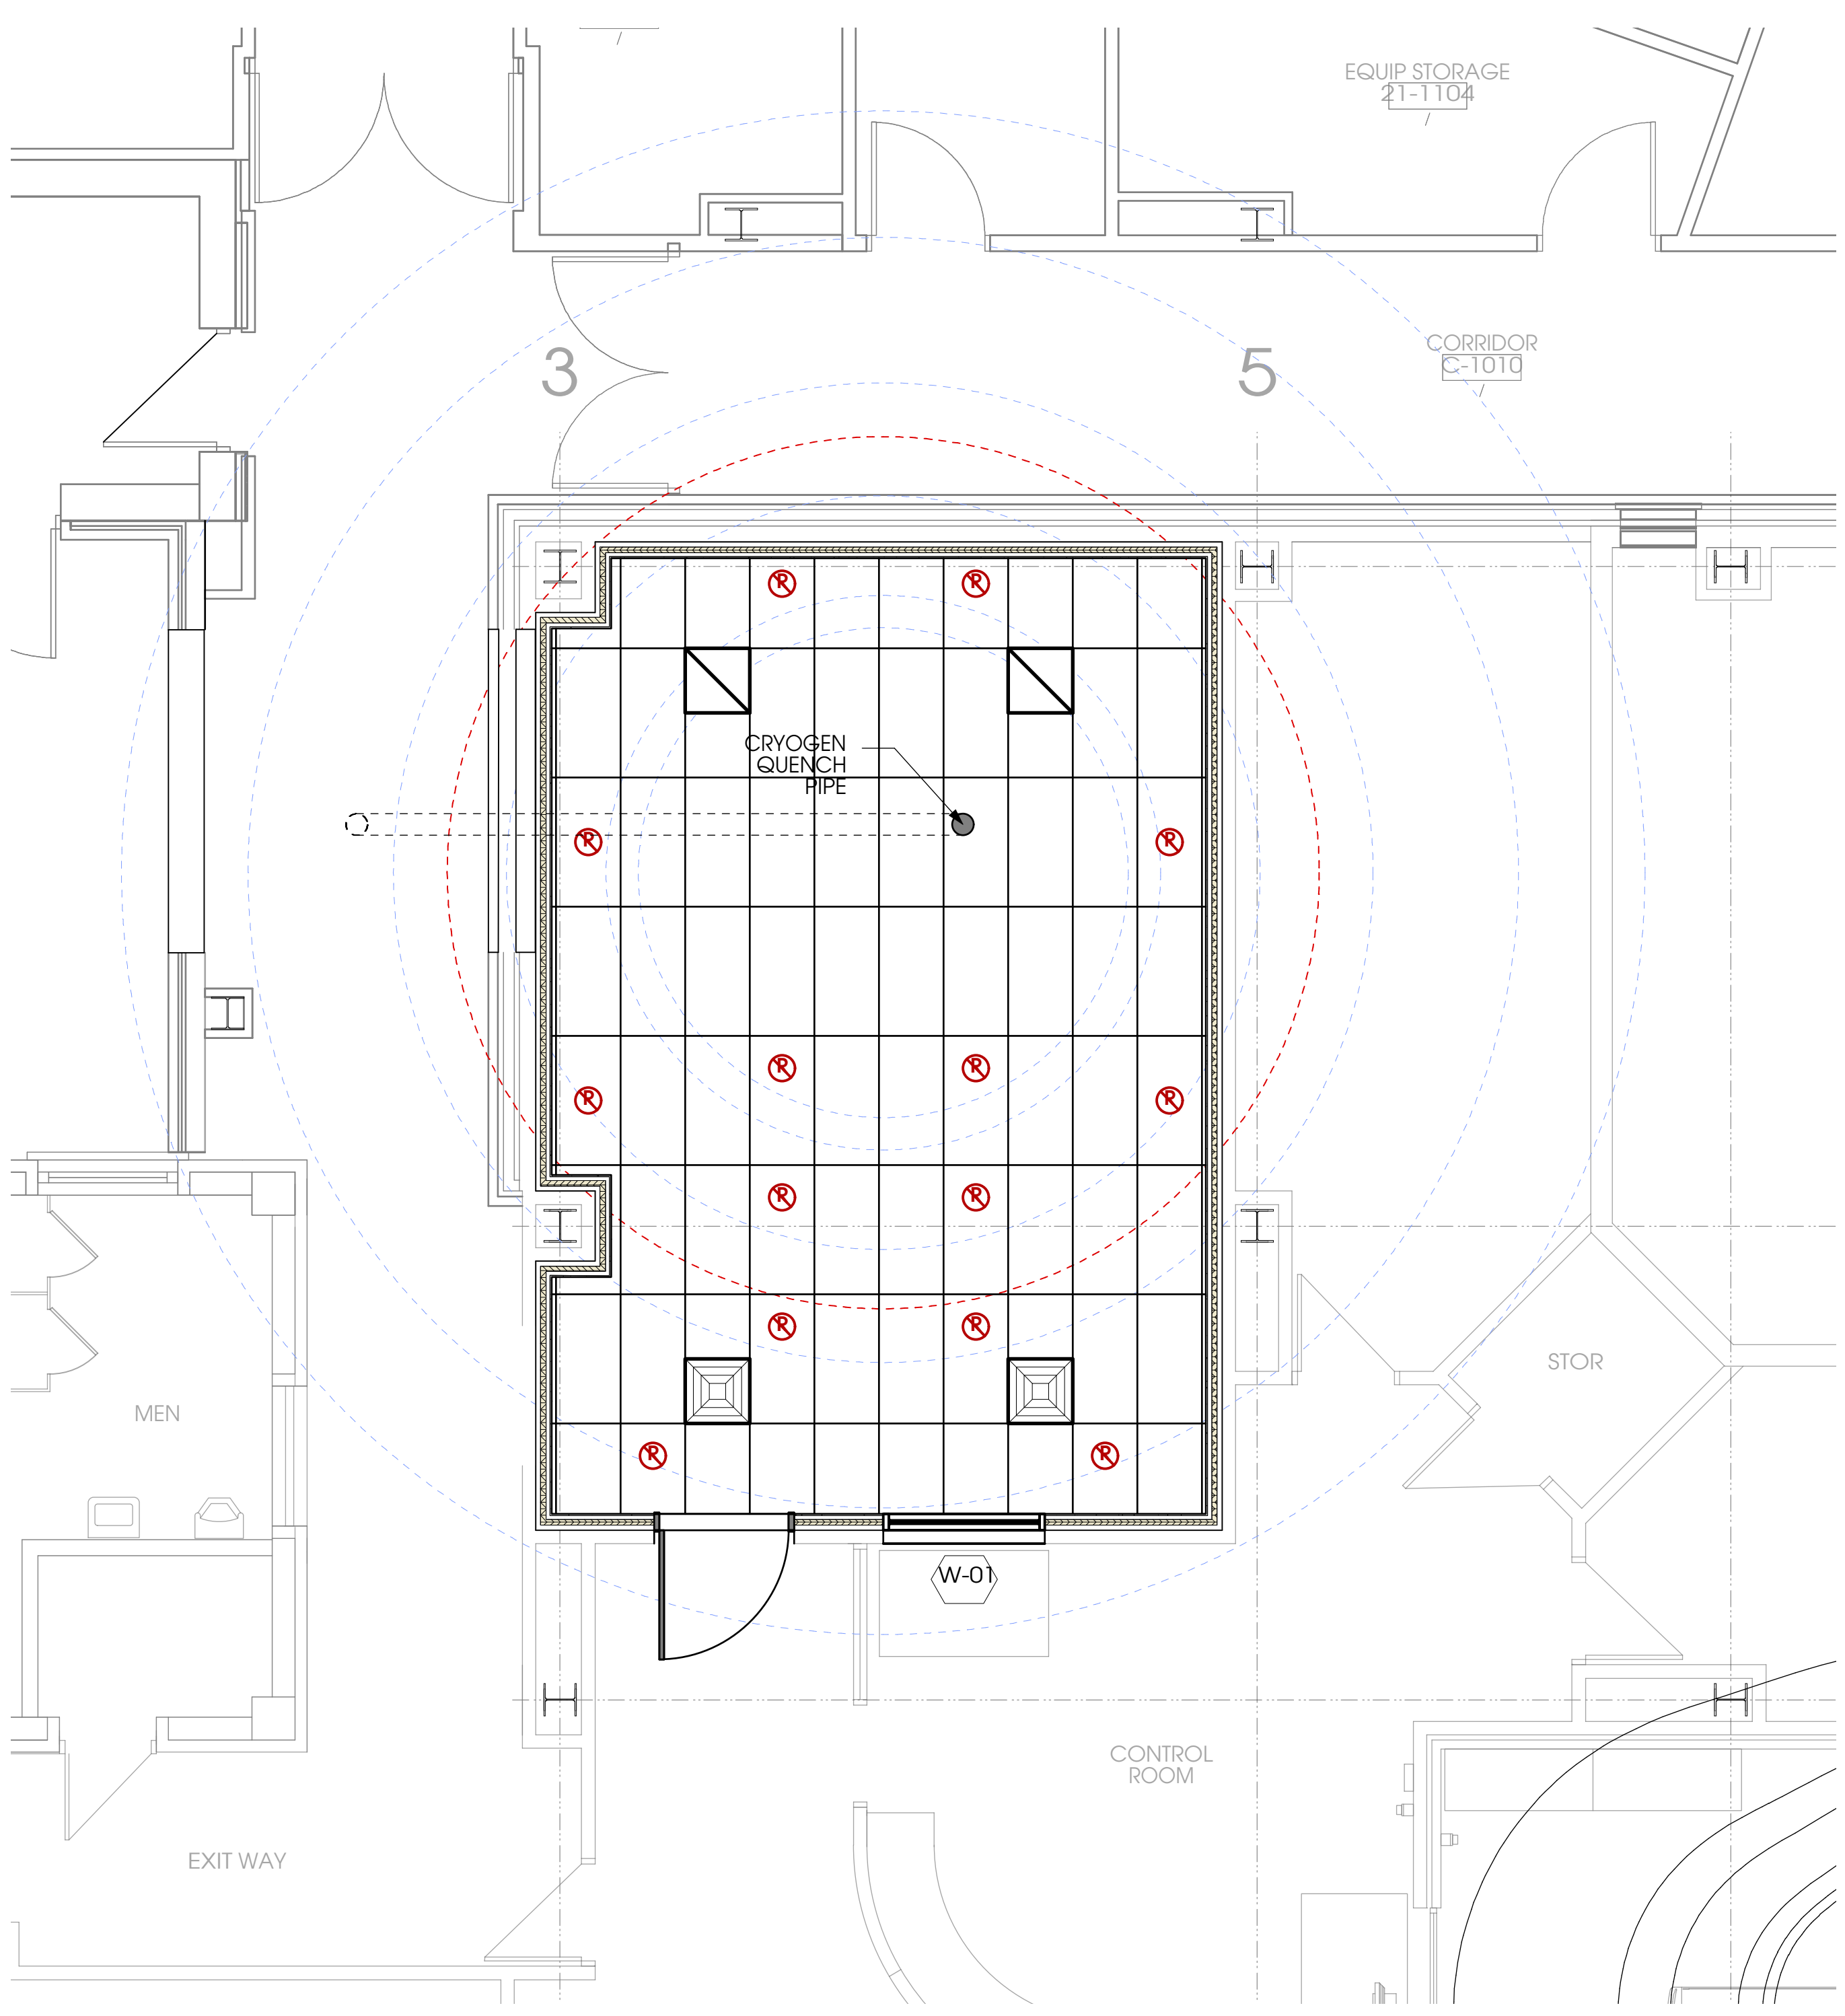
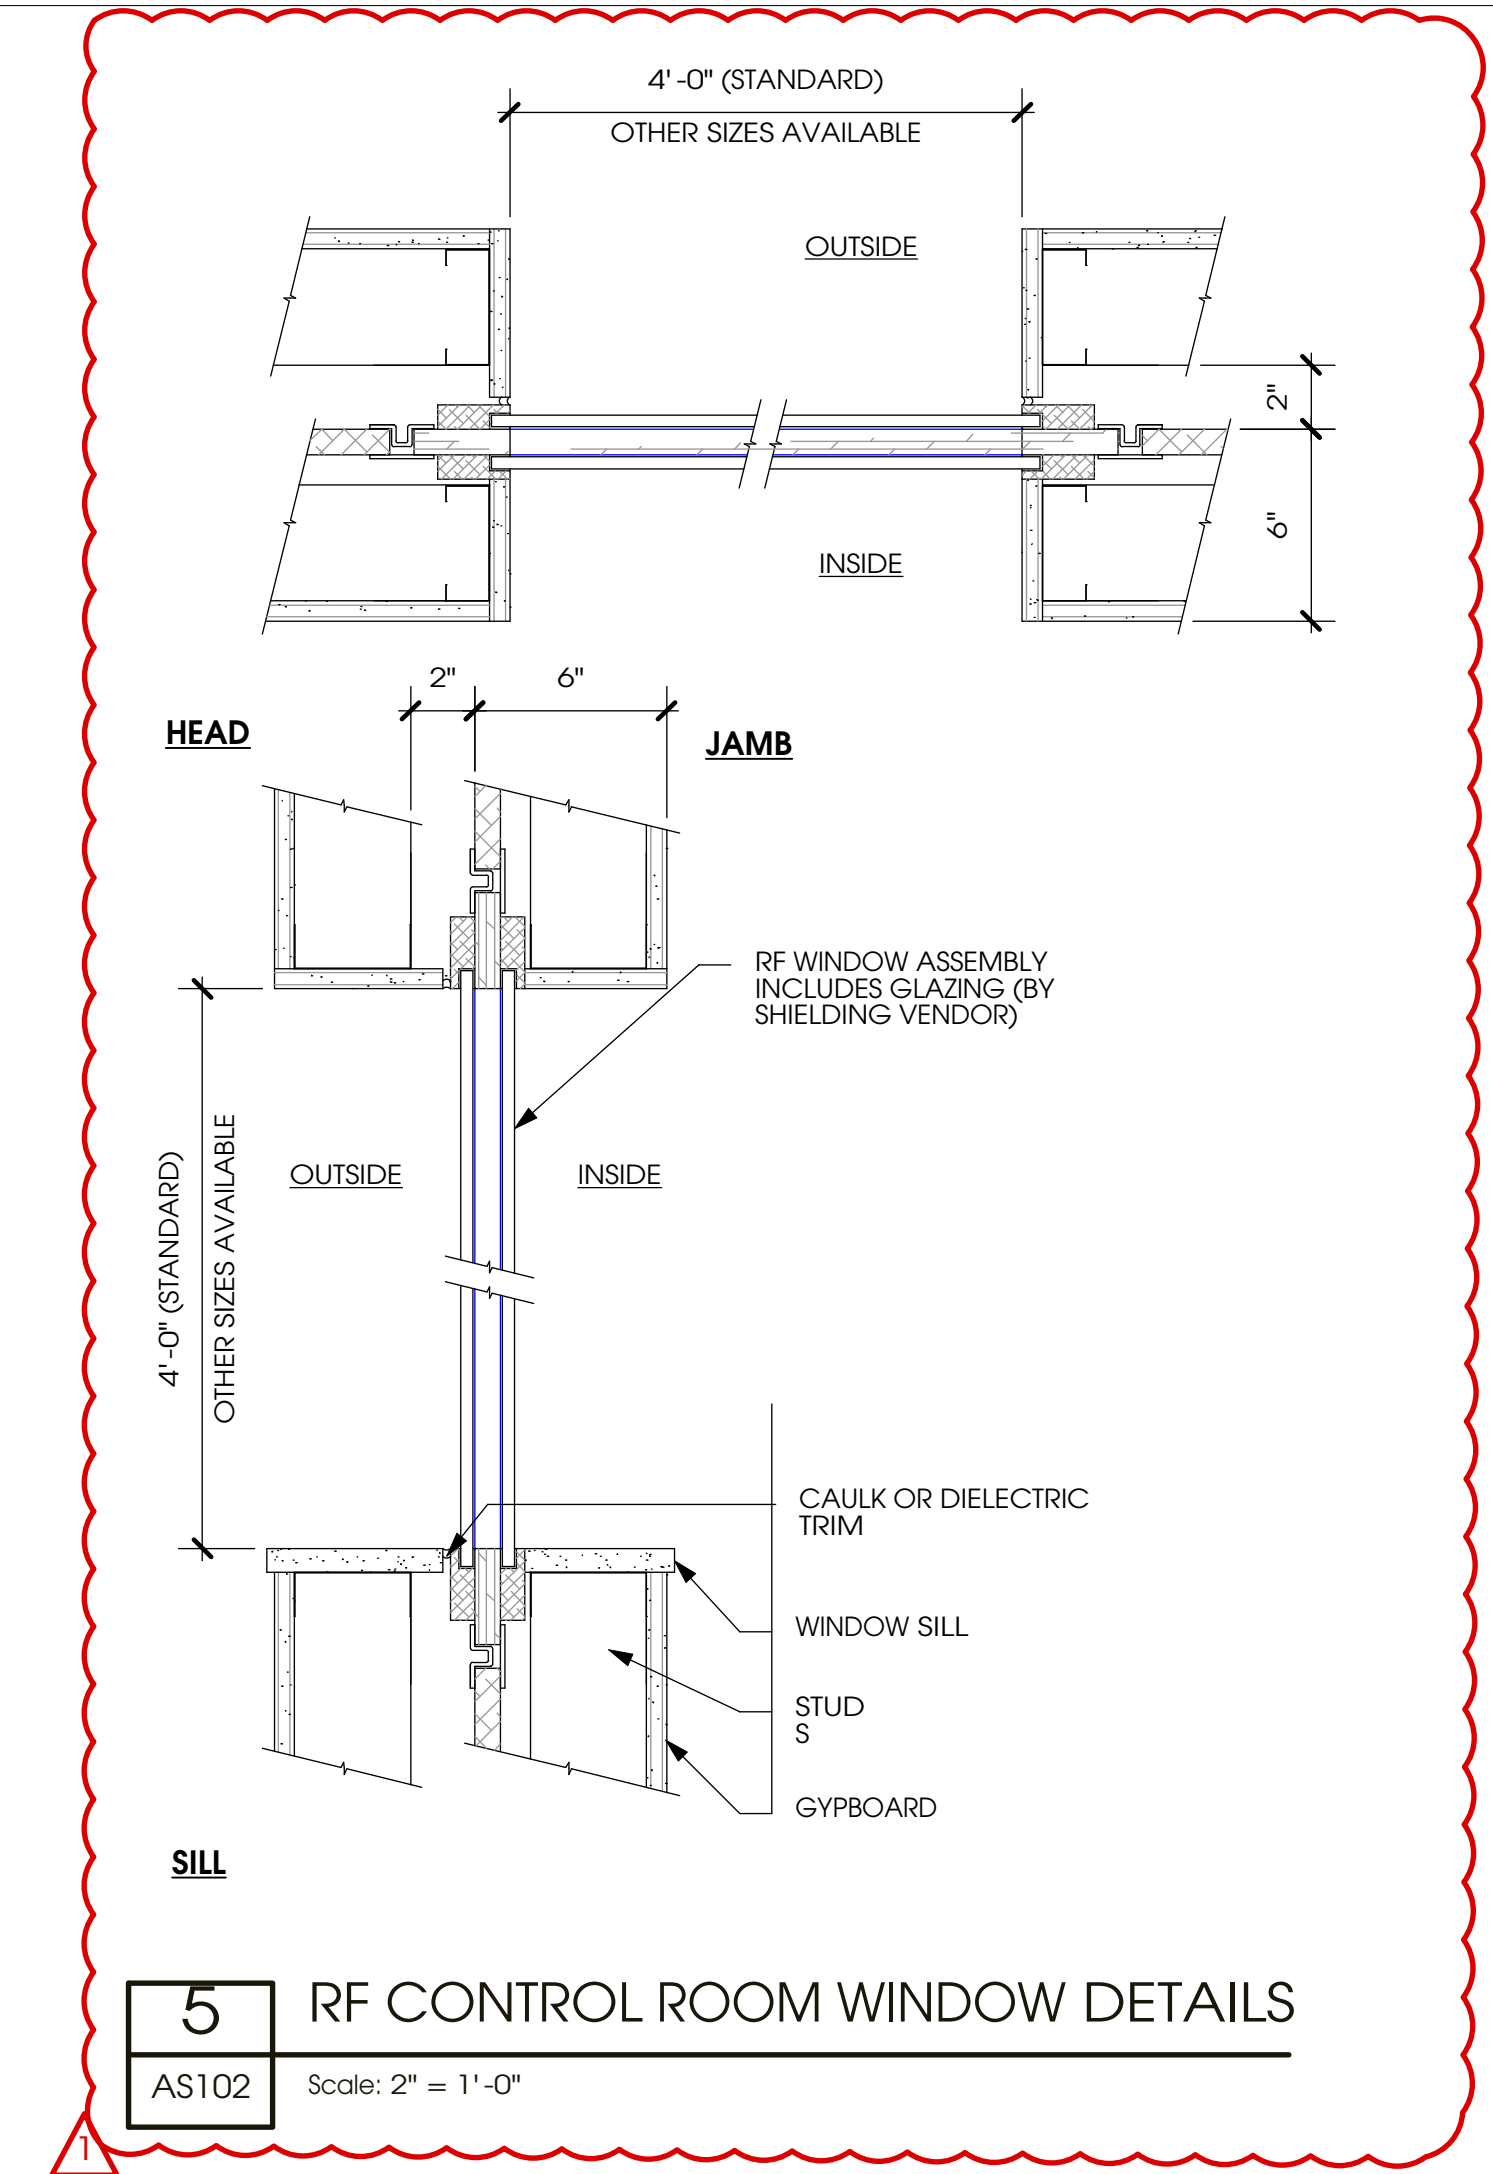


three eighths inch = one foot
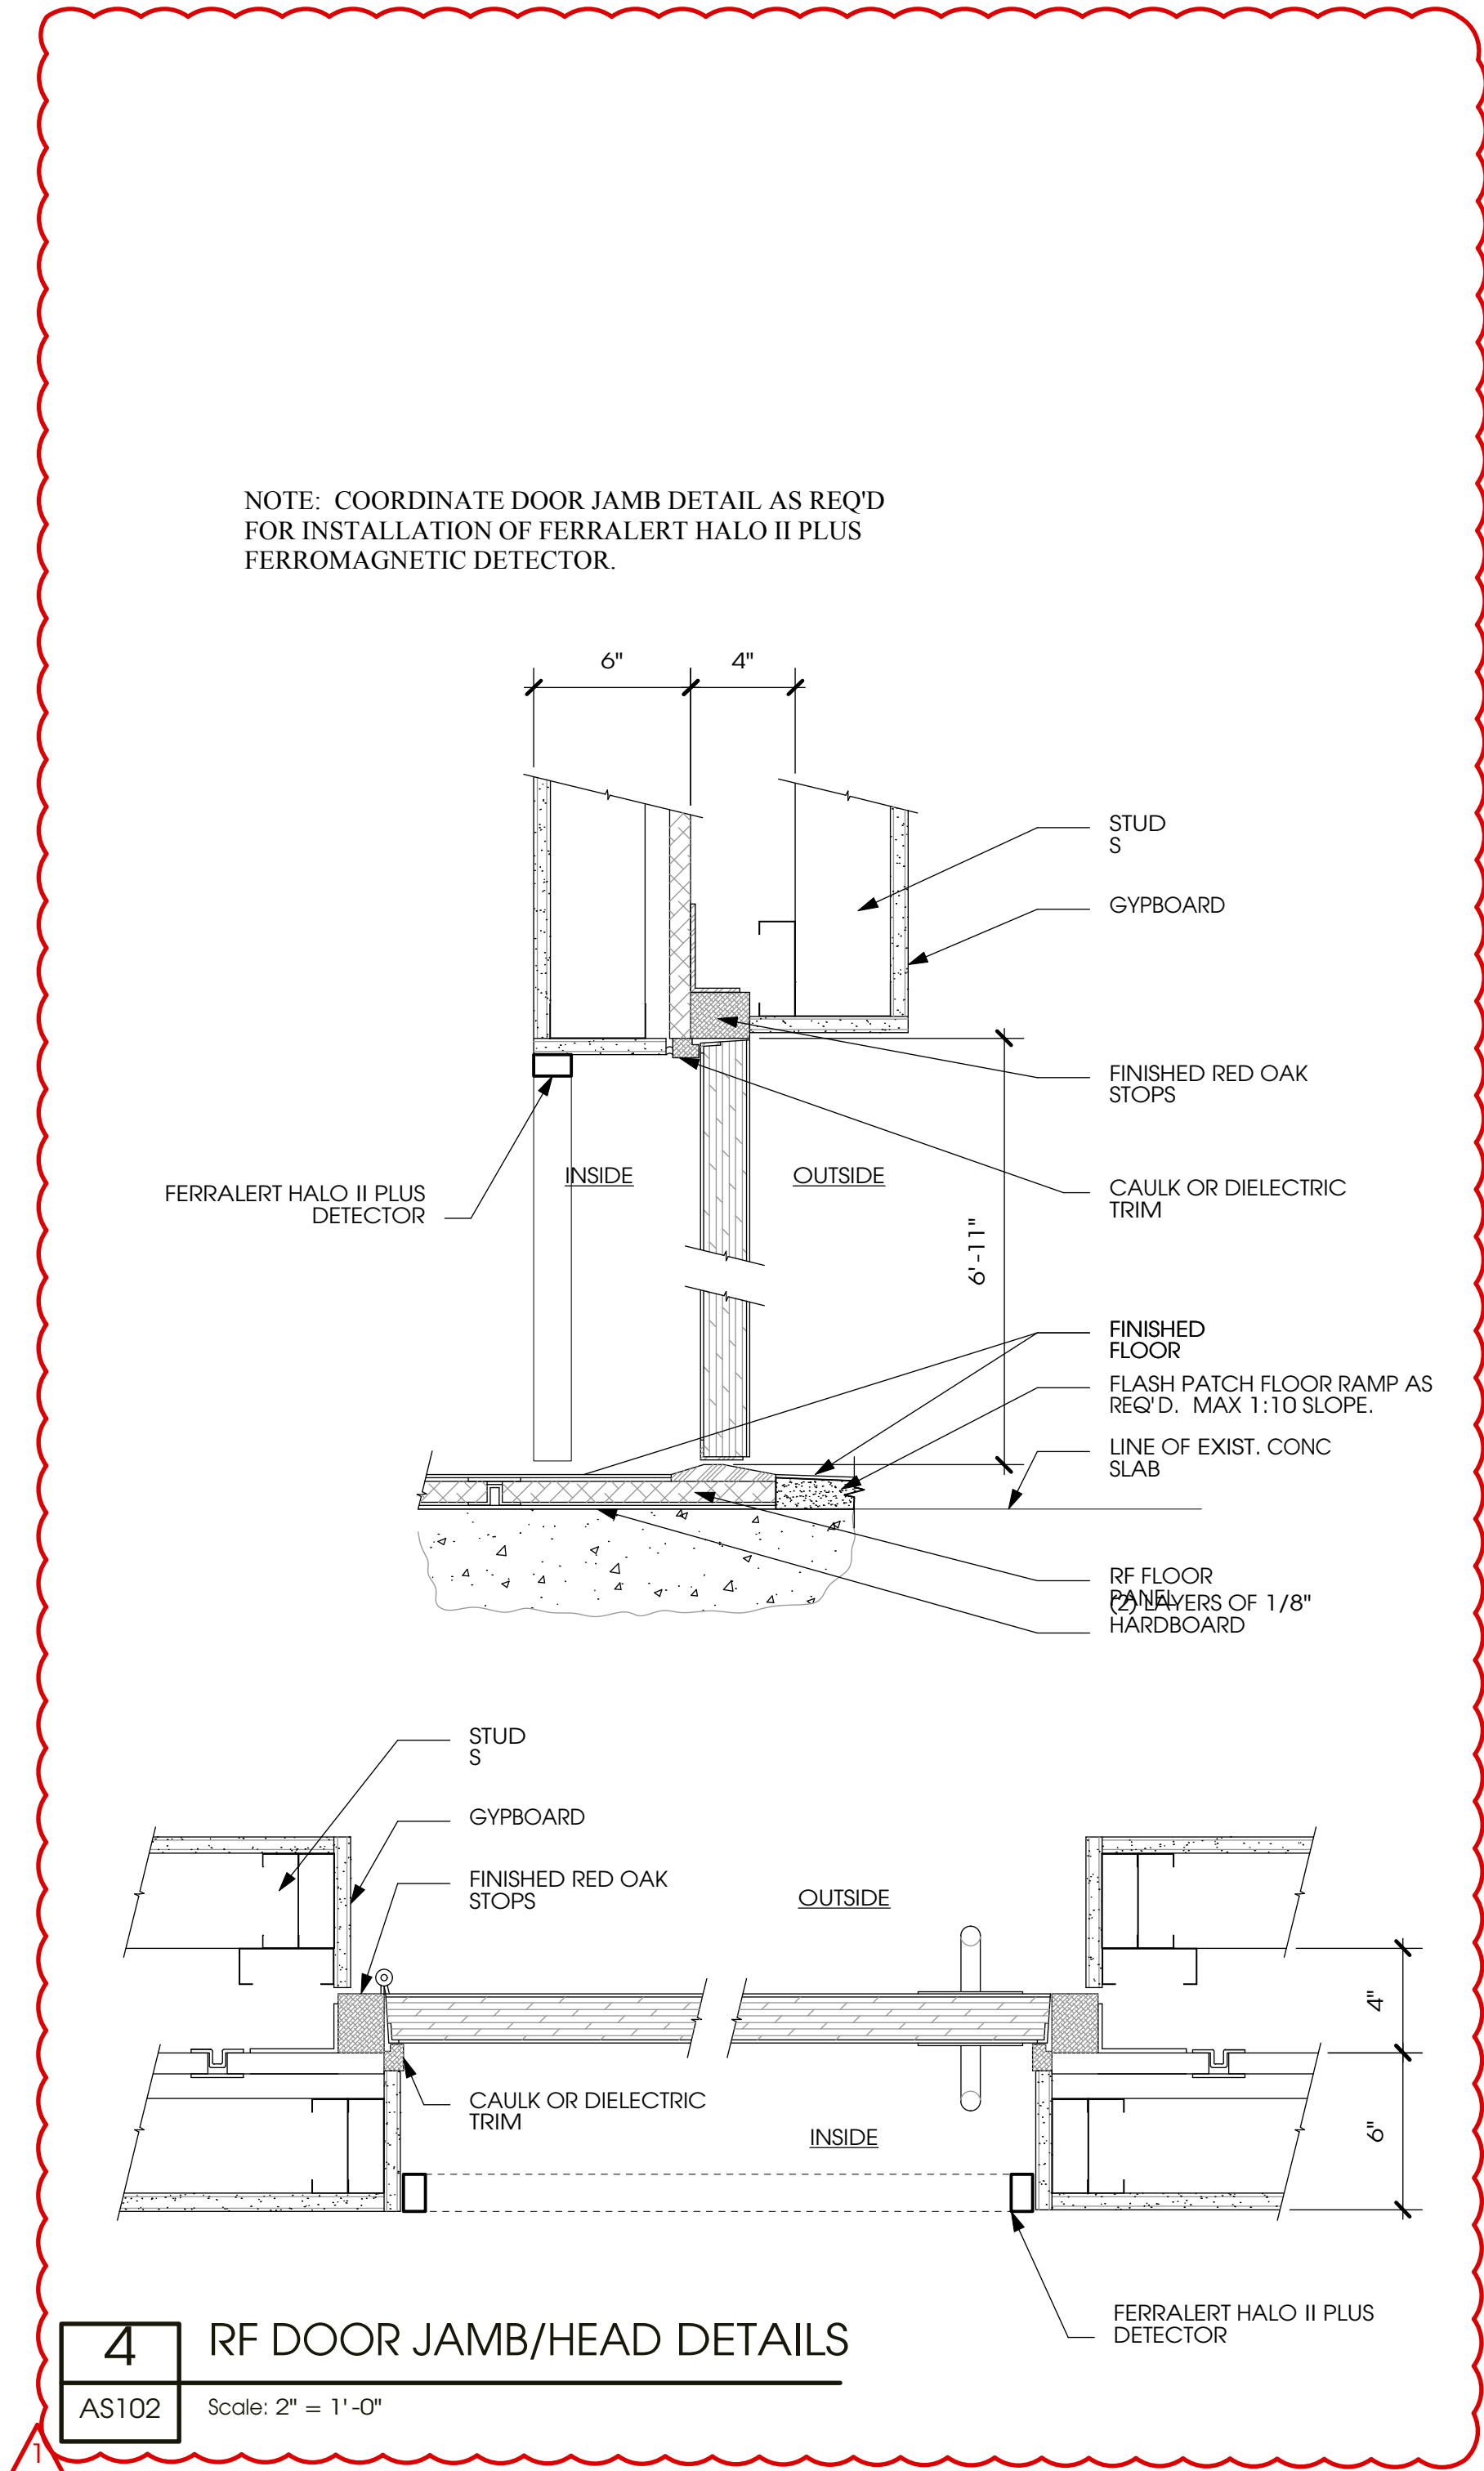

	MED GAS RE: MECH.		HVAC RETURN RE: MECH.
	SPRINKLER HEAD RE: FIRE PROTECTION		X-RAY SIGN RE: ELEC.
	HVAC SUPPLY RE: MECH.		SWITCH RE: ELEC.
	LAY-IN ACT GRID		THERMOSTAT RE: ELEC.
	1x4 LIGHT FIXTURE RE: ELEC.		ELECTRICAL RECEPTACLE RE: ELEC.
	2x4 LIGHT FIXTURE RE: ELEC.		TELEPHONE OUTLET RE: ELEC.
	RECESSED DOWN LIGHT RE: ELEC.		DATA/TELEPHONE OUTLET RE: ELEC.
	EXISTING WALL/ITEM TO REMAIN		NEW DOOR AND FRAME REF. DOOR SCHEDULE
	ITEMS TO BE REMOVED		NEW WINDOW AND FRAME REF. WINDOW SCHEDULE
	NEW LG METAL FRAMED WALL - LEAD LINED WALL		
	NEW LG METAL FRAMED WALL		
	NEW MILLWORK ITEM		

Revisions:	Date
REV 01 - VA REQUESTED CHANGES	12/31/14
100% Construction Documents	08/10/11
95% Construction Documents	05/12/11
50% Schematic Design	01/24/11

CONSULTANTS:	
Structural Engineer: MEP Engineer:	Associate Architect: Cost Estimating:
Bob D. Campbell & Co.TME, Inc.	CMR
4338 Belleview	5201 Johnson Dr., Suite 330
Kansas City, MO 64111	Mission, KS 66205
Fayetteville, AR 72703	One Santa Fe Plaza, Suite 101
	Oklahoma City, OK 73102



ARCHITECT:

RAD

RADIOLOGY PLANNING


RAD-Planning
802 Broadway 5th Floor
Kansas City, MO 64105
www.RAD-Planning.com 816.472.7722

Drawing Title New Plan Second Floor
Approved: Project Director

Project Title SITE PREP FOR MAGNETIC RESONANCE IMAGING EQUIPMENT
Location VETERANS HEALTHCARE SYSTEM OF THE OZARKS 1100 N. COLLEGE AVE, FAYETTEVILLE, AR 72703
Date August 10, 2011

Project Number 564-10-101
Building Number 2
Drawing Number AS102

Office of
Facilities
Management

Department of
Veterans Affairs