



05-01-D1-01 - PHYSICAL THERAPY/ KINESIOLOGY THERAPY:

The trainer should be approximately the full length of the room (North-South), do a 90 degree turn to the East at the South end of the room, and then span approximately ½ of the width of the room.

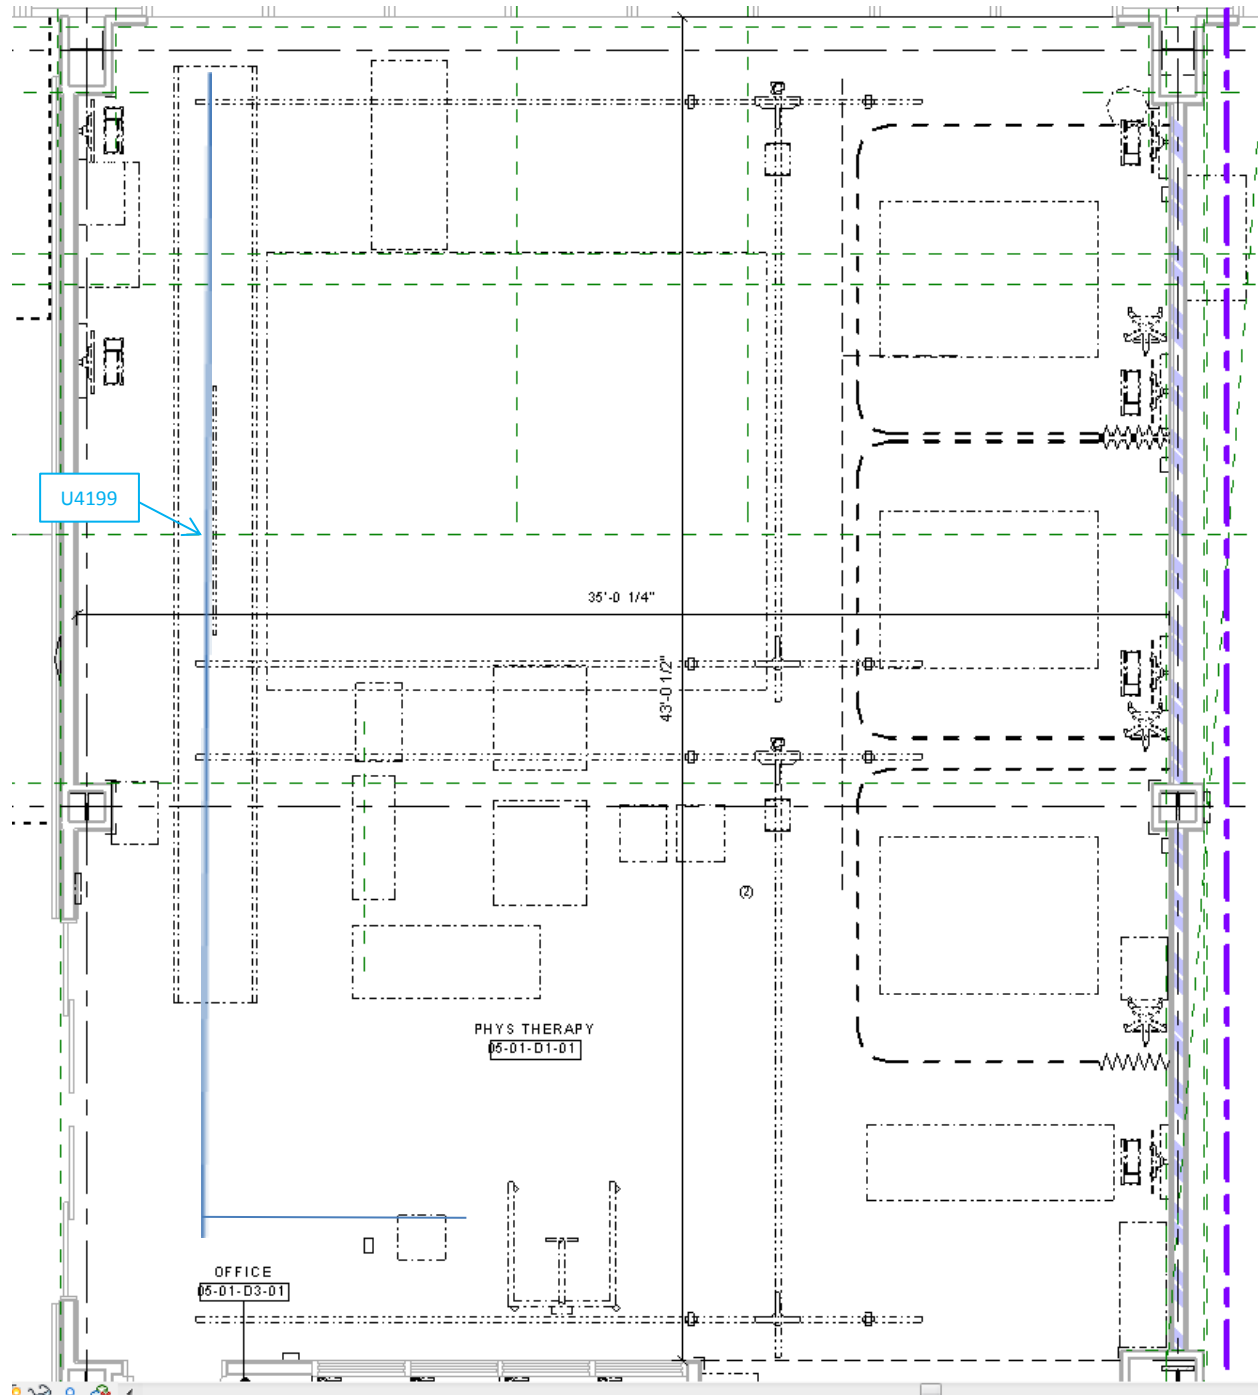

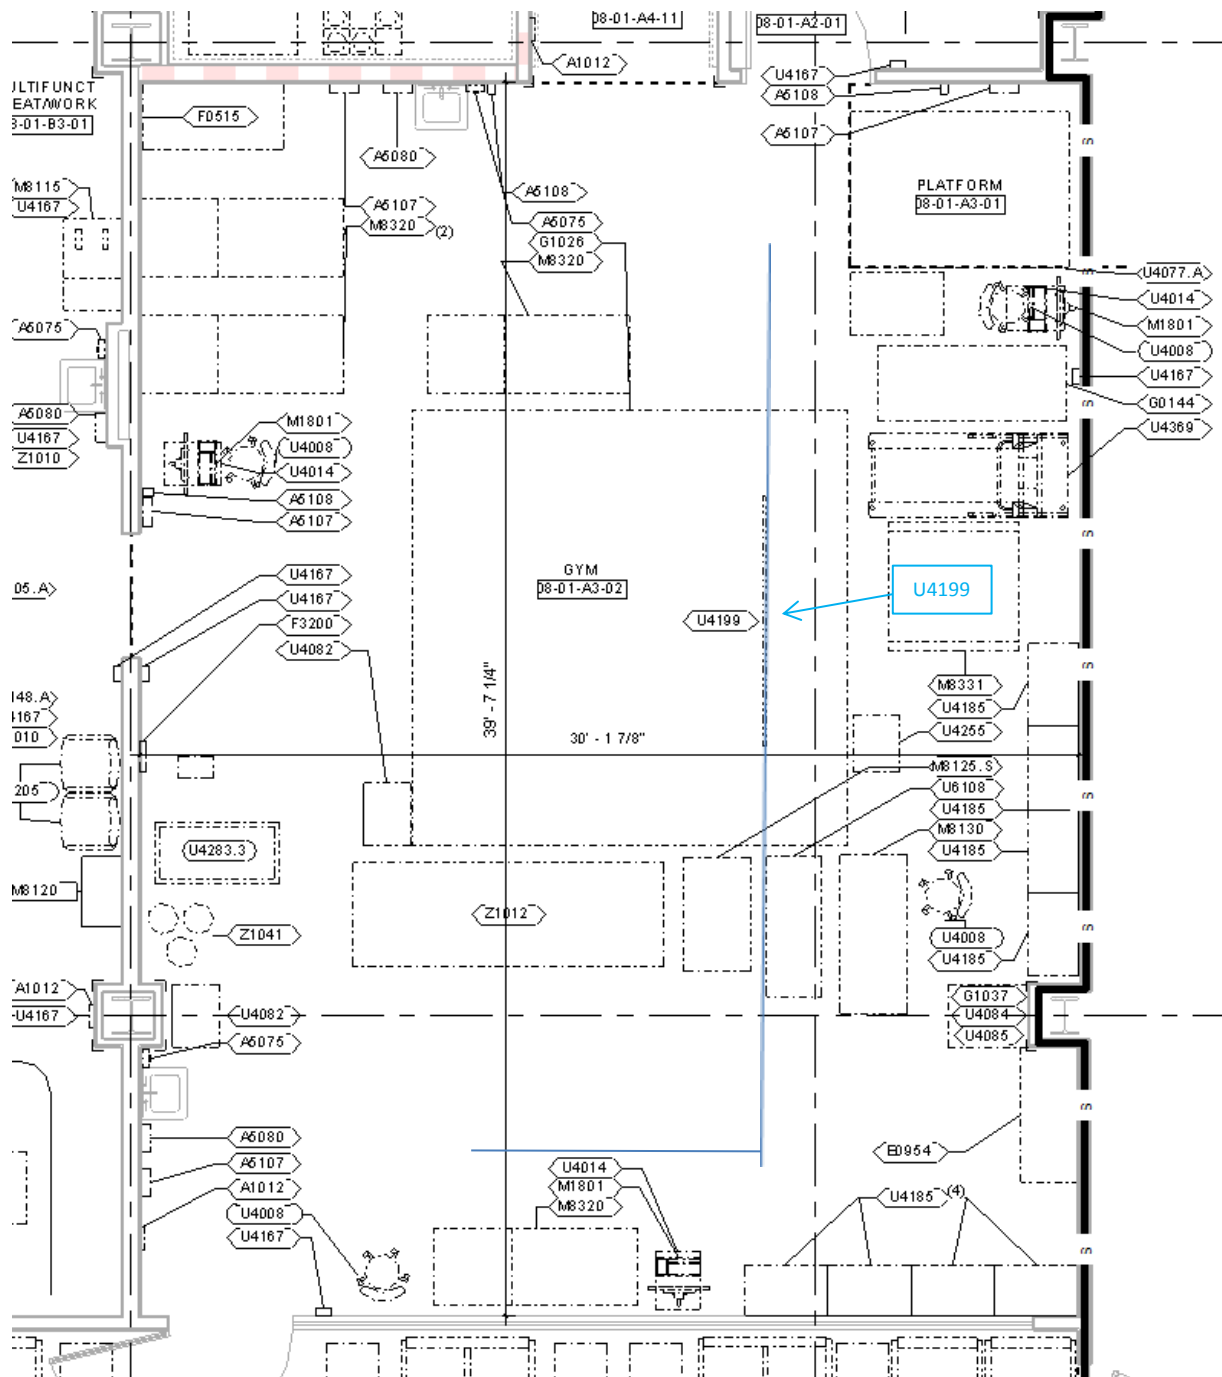

05-03-B2-01 – REHAB GYM:

The overhead patient lift (U4001) has been deleted from the Plan in the East half of the room in order to accommodate the Rehabilitation Trainer, Overhead Track (U4199).

