


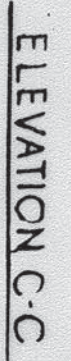

ELEVATION A-A

SECTION

--

3	
---	--

SEE HEATING DRAWS. FOR HEIGHT OF CHIMNEY

ABBREVIATION:
C. J = CONTROL JOINT IN CONCRETE
MASONRY UNIT PORTION OF
CAVITY WALL.

[illegible]

WORK AS CONSTRUCTED

HUNTINGTON D.O. FILE NO. HUNT

29-06-47