SEE SHEET 147-E-003 FOR FIRE ALARM DEVICES IN CONNECTOR. CONNECTOR DEVICES SHALL BE SERVED FROM BLDG 147 FIRE ALARM SYSTEM.

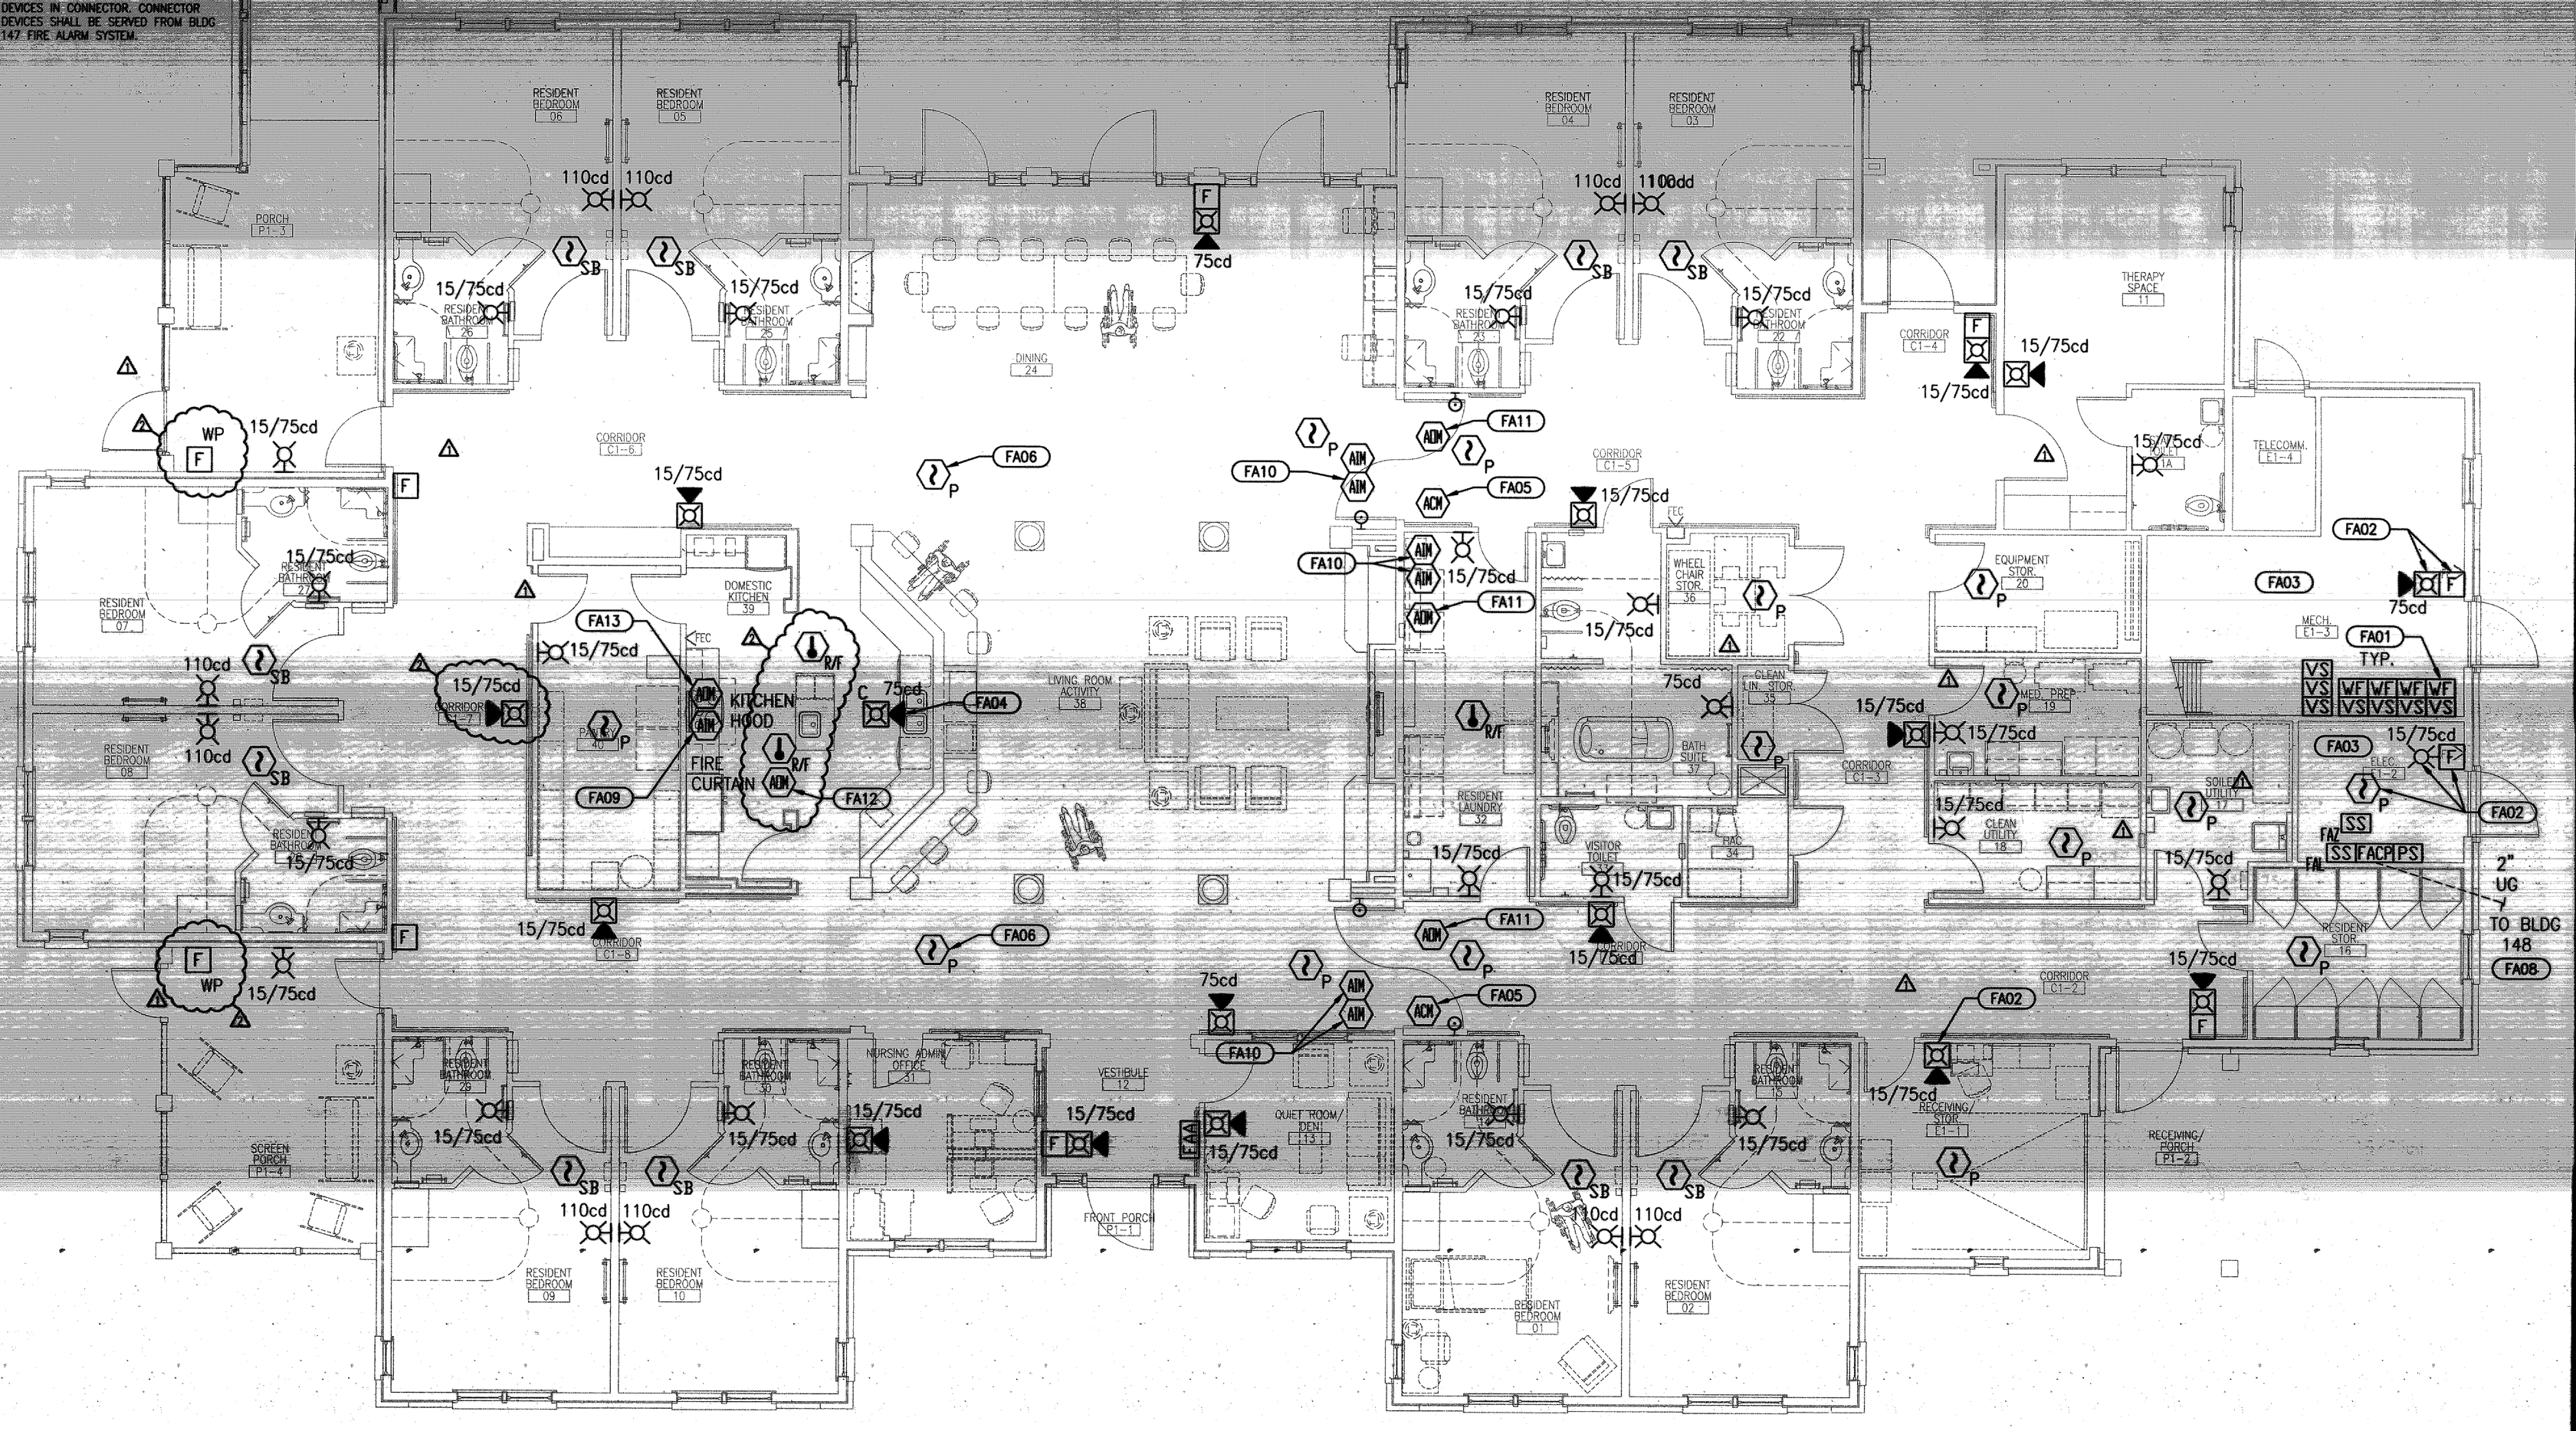


## FIRE ALARM PLAN

SCALE: 1/4" = 1'-0"

## DRAWING NOTES:

1. REFER TO DRAWING 147-FA001 FOR SYMBOLS, ABBREVIATIONS AND NOTES.

| Revisions | Date |
|---|---|
| 1 REVISION NO. 1 | 01/28/15 |
| 2 REVISION NO. 2 | 03/02/15 |


SHERLOCK SMITH & ADAMS
ARCHITECTS / ENGINEERS

2101 Magnolia Avenue South, Suite 100
Birmingham, Alabama 35205
Telephone: (205)254-9100 Fax (205)254-9144

3047 Carter Hill Road P.O. Drawer 11006
Montgomery, Alabama 36111-0006
Telephone: (334)263-6481 Fax (334)264-4509


ALABAMA REGISTERED PROFESSIONAL ENGINEER No. 25281 12/5/14 DAVID KYLE WILSON

| | | | |
|---|---|---|---|
| Drawing Title: FIRE ALARM PLAN | Project Title: OIF/OEF COTTAGE | | Date: 12 05 2014 |
| Approved: Chief, Engineer | Building Number: 147 | Checked: DKW | Drawn: MBA |
| | Location: VAMC – TUSCALOOSA, ALABAMA | | Project No.: 679-CSI-311 |
| | | | DRAWING NO.: 147-FA101 |
| | | | FILE NAME: 679.311.147.FA101(REV 2) |

Veterans Administration