PLUMBING KEYNOTES THIS SHEET ONLY.

1. 1½" CW AND ½" HW UP. PROVIDE BALL VALVES ABOVE ACCESS PANEL.
2. 1¼" CW AND ½" HW UP. PROVIDE BALL VALVES ABOVE ACCESS PANEL.
3. ¾" CW AND ¾" HW UP. PROVIDE SHUT OFF VALVES ABOVE ACCESS PANEL.
4. 1½" CW AND ¾" HW UP. PROVIDE BALL VALVES ABOVE ACCESS PANEL.
5. 3" CW, 2" HW, AND ½" HWR UP
6. ½" CW AND ½" HW UP. PROVIDE BALL VALVES ABOVE ACCESS PANEL.
7. ¾" CW UP. PROVIDE BALL VALVE ABOVE ACCESS PANEL.
8. SEE SITE PLAN FOR CONTINUATION OF 3" DOMESTIC WATER.
9. SEE SITE PLAN FOR CONTINUATION OF GAS LINE TO LOCAL UTILITY.

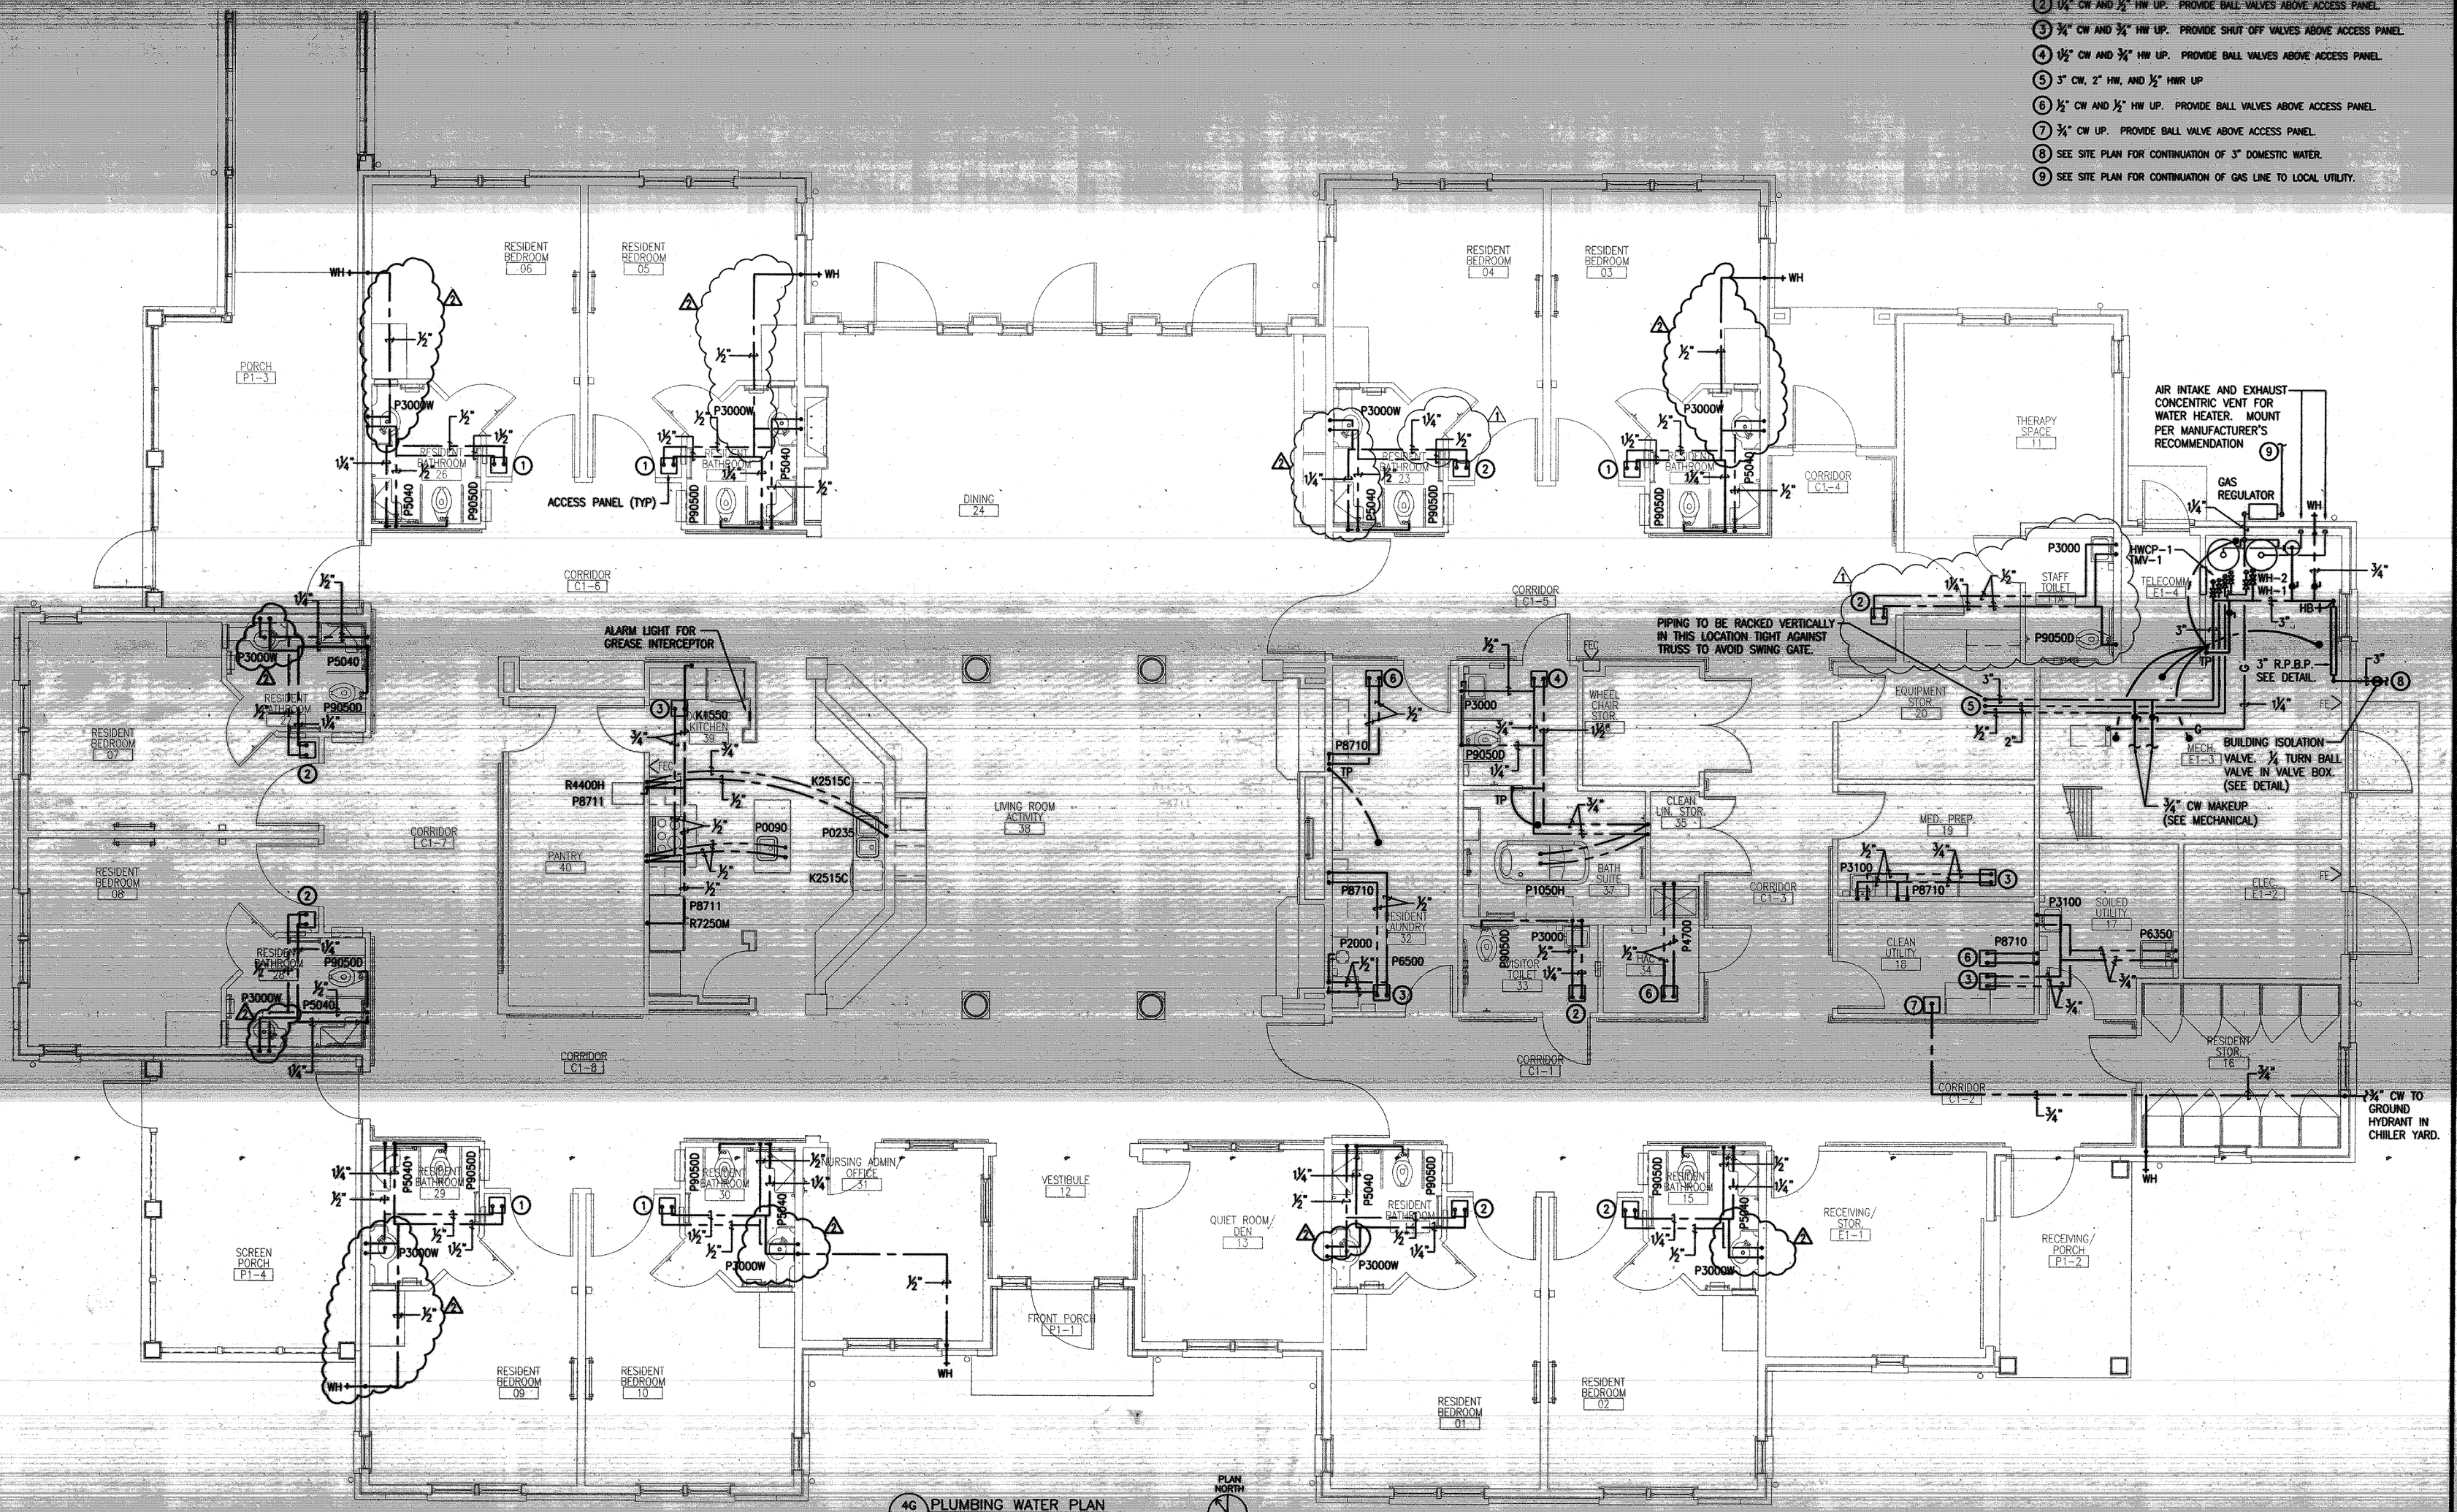

4G PLUMBING WATER PLAN
147-P-301 SCALE: 1/4" = 1'-0"

PLAN NORTH

NOTE: SEE WATER RISER PLAN FOR WATER HAMMER ARRESTOR.

Revisions	Date
⚠ REVISION NO. 1	01/28/15
⚠ REVISION NO. 2	03/02/15

SHERLOCK SMITH & ADAMS
ARCHITECTS / ENGINEERS
2101 Magnolia Avenue-South, Suite 100
Birmingham, Alabama 35205
Telephone: (205)254-9100 Fax (205)254-9144
3047 Carter Hill Road P.O. Drawer 11006
Montgomery, Alabama 36111-0006
Telephone: (334)263-6481 Fax (334)264-4509

ALABAMA LICENSED PROFESSIONAL ENGINEER NO. 16179 ROBERT L. YOUNG

Drawing Title: PLUMBING WATER PLAN
Approved: Chief, Engineer
Project Title: OIF/OEF COTTAGE
Location: VAMC – TUSCALOOSA, ALABAMA
Date: 12 05 2014
Project No.: 679-CSI-311
Building Number: 147
Checked: FLY
Drawn: EKIT
DRAWING NO.: 147-P-301
FILE NAME: P-301 TO P-302

Veterans Administration