


PLUMBING KEYNOTES: THIS SHEET ONLY

- 1 1/2" CW AND 1/2" HW DOWN
- 2 1/4" CW AND 1/2" HW DOWN
- 3 3/4" CW AND 3/4" HW DOWN
- 4 1/2" CW AND 3/4" HW DOWN
- 5 3" CW, 2" HW, AND 1/2" HW DOWN
- 6 1/2" CW AND 1/2" HW DOWN
- 7 3/4" CW DOWN

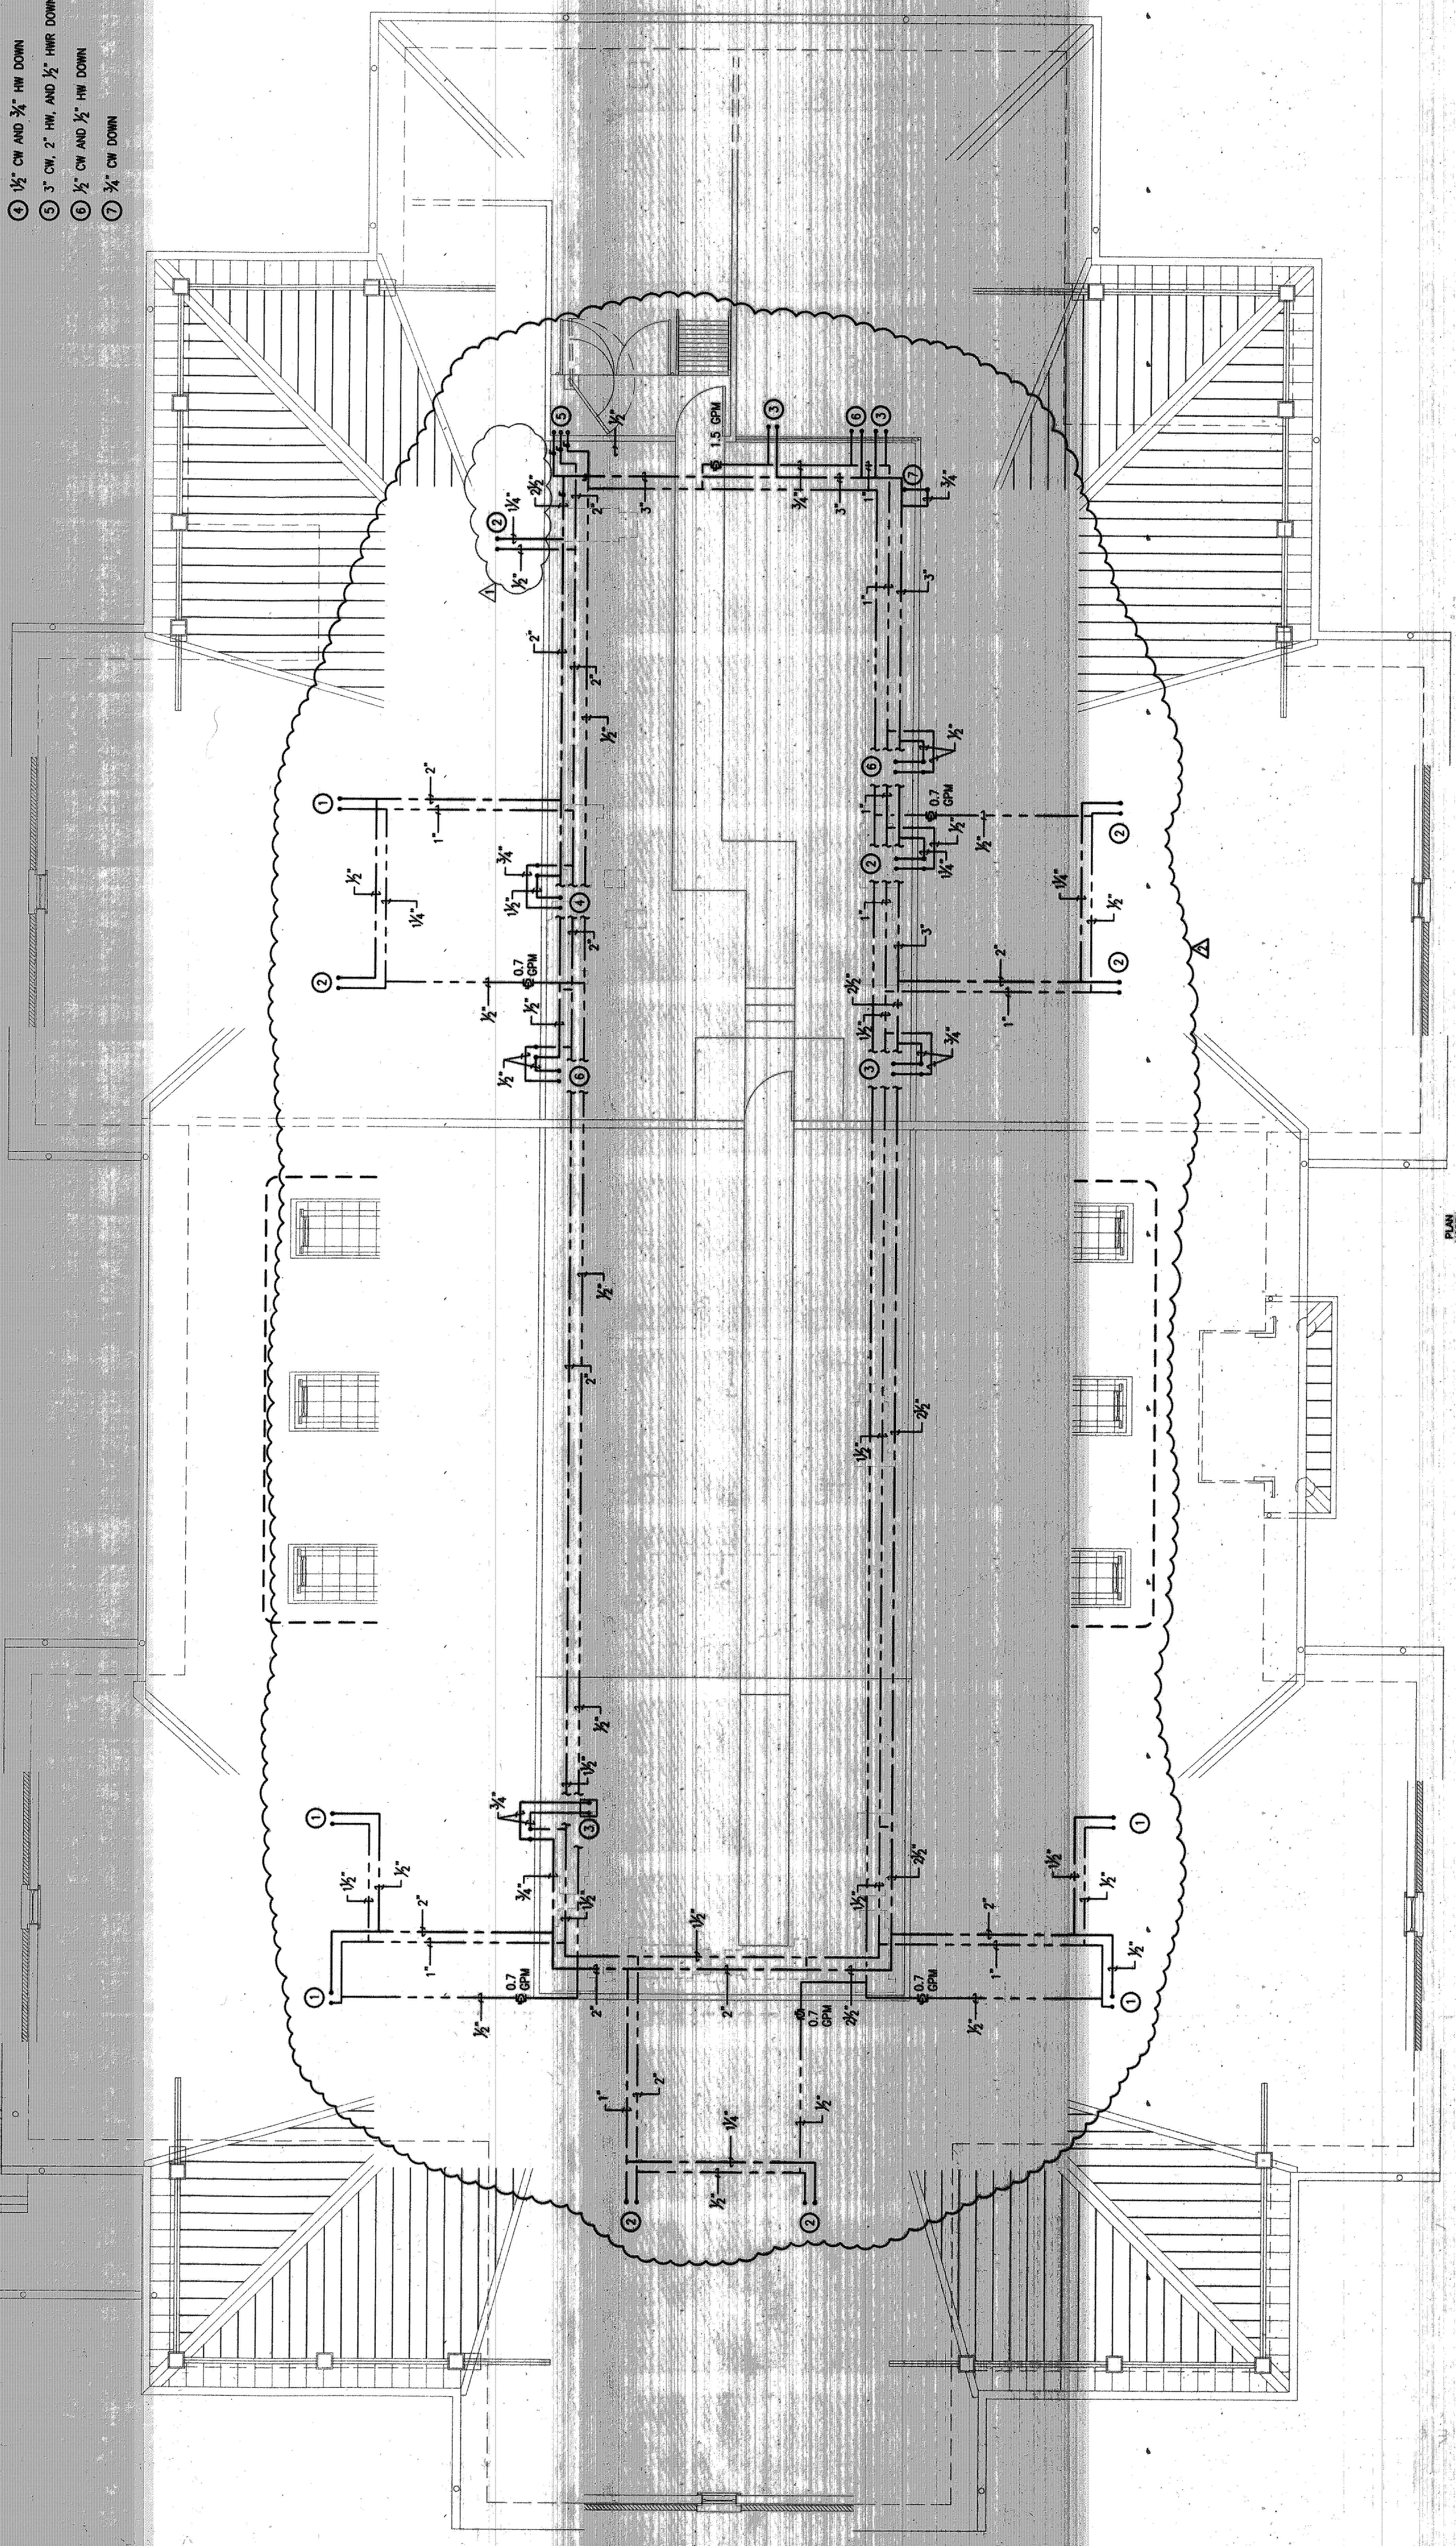

4G PLUMBING ATTIC WATER PLAN
SCALE 1/4" = 1'-0"
PLAN NORTH

Veterans Administration		Date 12-05-2004		Project No. 679-CS-311		Drawing No. 147-P-302		File Name P-301-10-P-302	
Project Title		OF/OEF COTTAGE		Building Number 407		Checked RLY		Drawn BBT	
Drawing Title		PLUMBING ATTIC WATER PLAN		Approved Chief Engineer Allen J. J.		Location		VAMC - TUSCALOOSA, ALABAMA	
SHERLOCK SMITH & ADAMS ARCHITECTS / ENGINEERS		2101 Magnolia Avenue South, Suite 100 Birmingham, Alabama 35205 Telephone: (205)254-9100 Fax (205)254-9144		3047 Carter Hill Road Montgomery, Alabama 36111-0006 Telephone: (334)263-6481 Fax (334)264-4509		01/28/15		Date	