
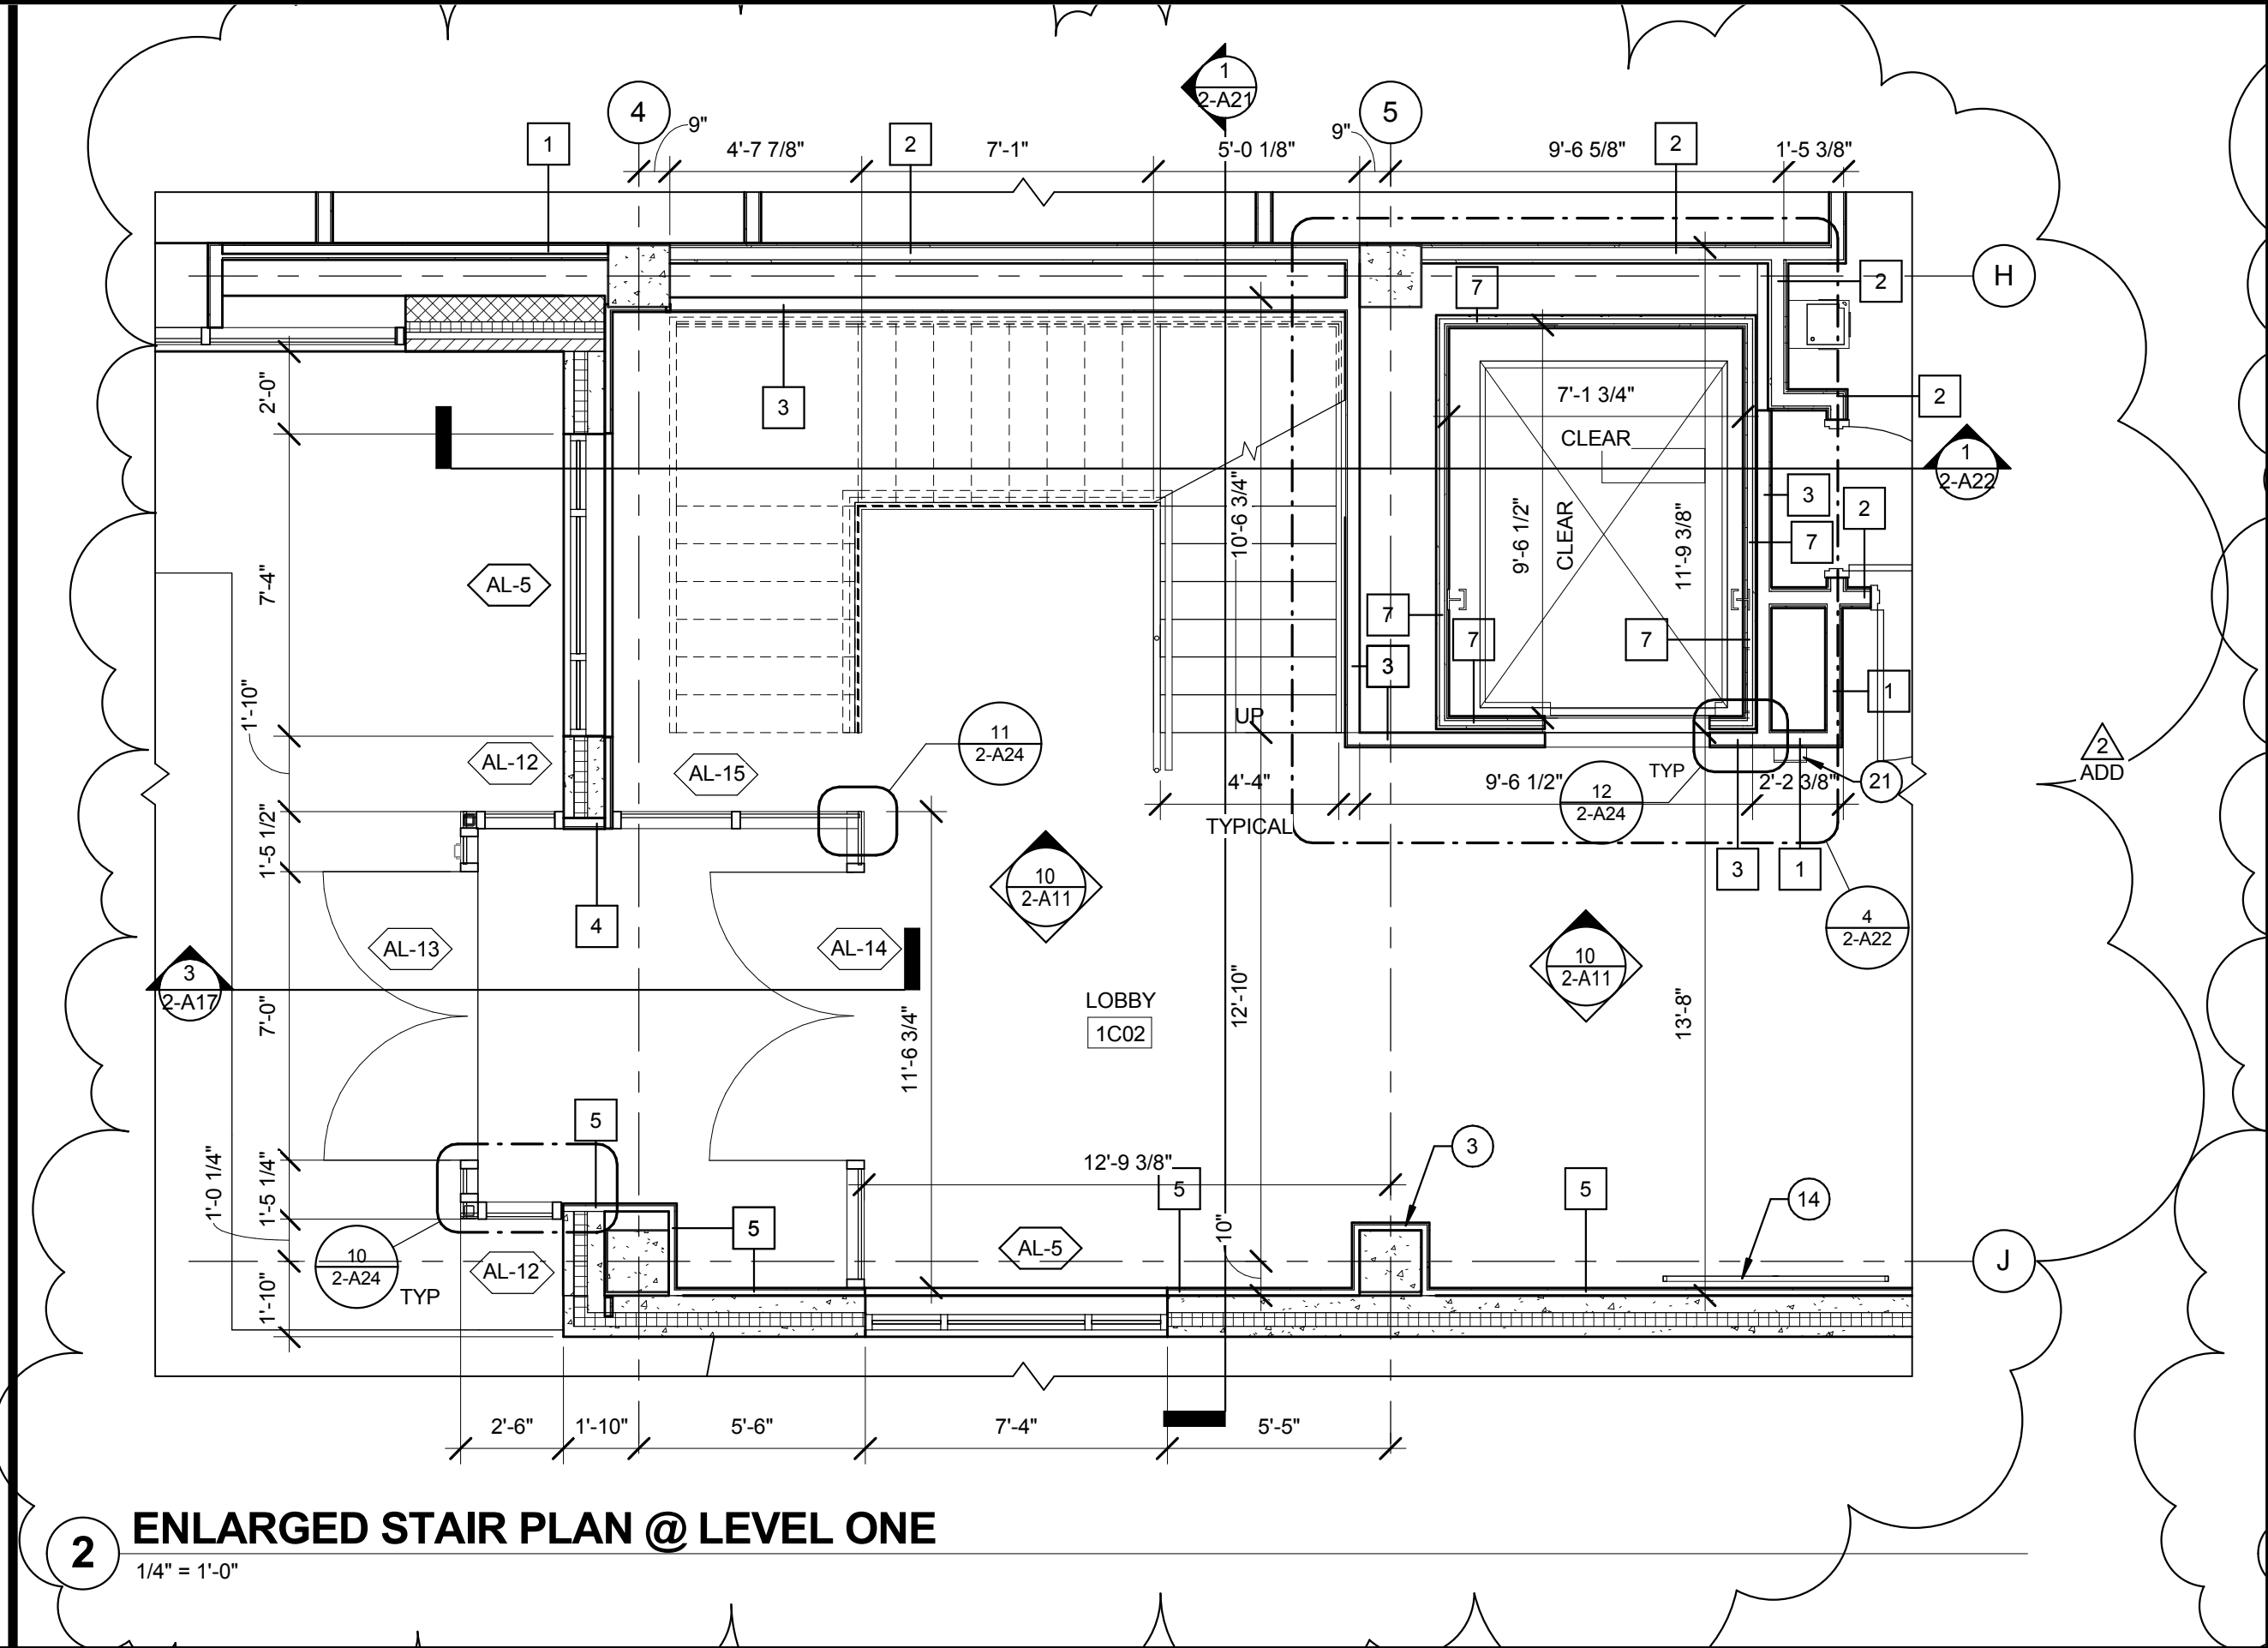


one-quarter inch = one foot

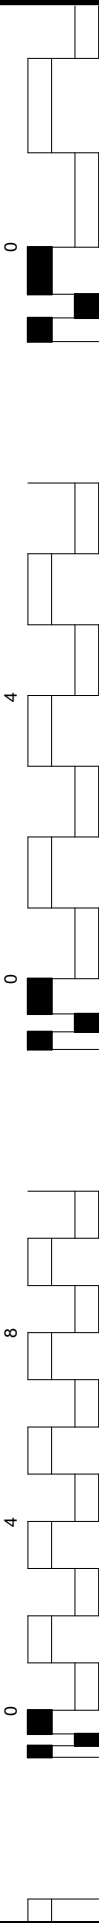

2 ENLARGED STAIR PLAN @ LEVEL ONE
1/4" = 1'-0"

$$1/4" = 1'-0"$$

RENOVATE AND EXPAND SPACE FOR PATIENT SUPPORT AREAS

IOWA CITY VA HEALTH CARE SYSTEM
IOWA CITY, IOWA

2-1

0.

110240-0

ISSUED FOR
ADD 2

SD-1

DATE	DRAWN
------	-------

03/06/2015	SCALE
Author	ABBOY

Answer	s indicated
--------	-------------

FIELD BOOK
REFERENCE DRAWING

Book # 3 A21

2A-7

SHIVE|ATTERY

ARCHITECTURE + ENGINEERING
Iowa | Illinois | Indiana | Missouri <http://www.shive-hattery.com>