


3/9/2015 8:16:23 AM

C:\shive\Revit\_Local\1102400-A-NEW BUILDING 2\_easibet.rvt

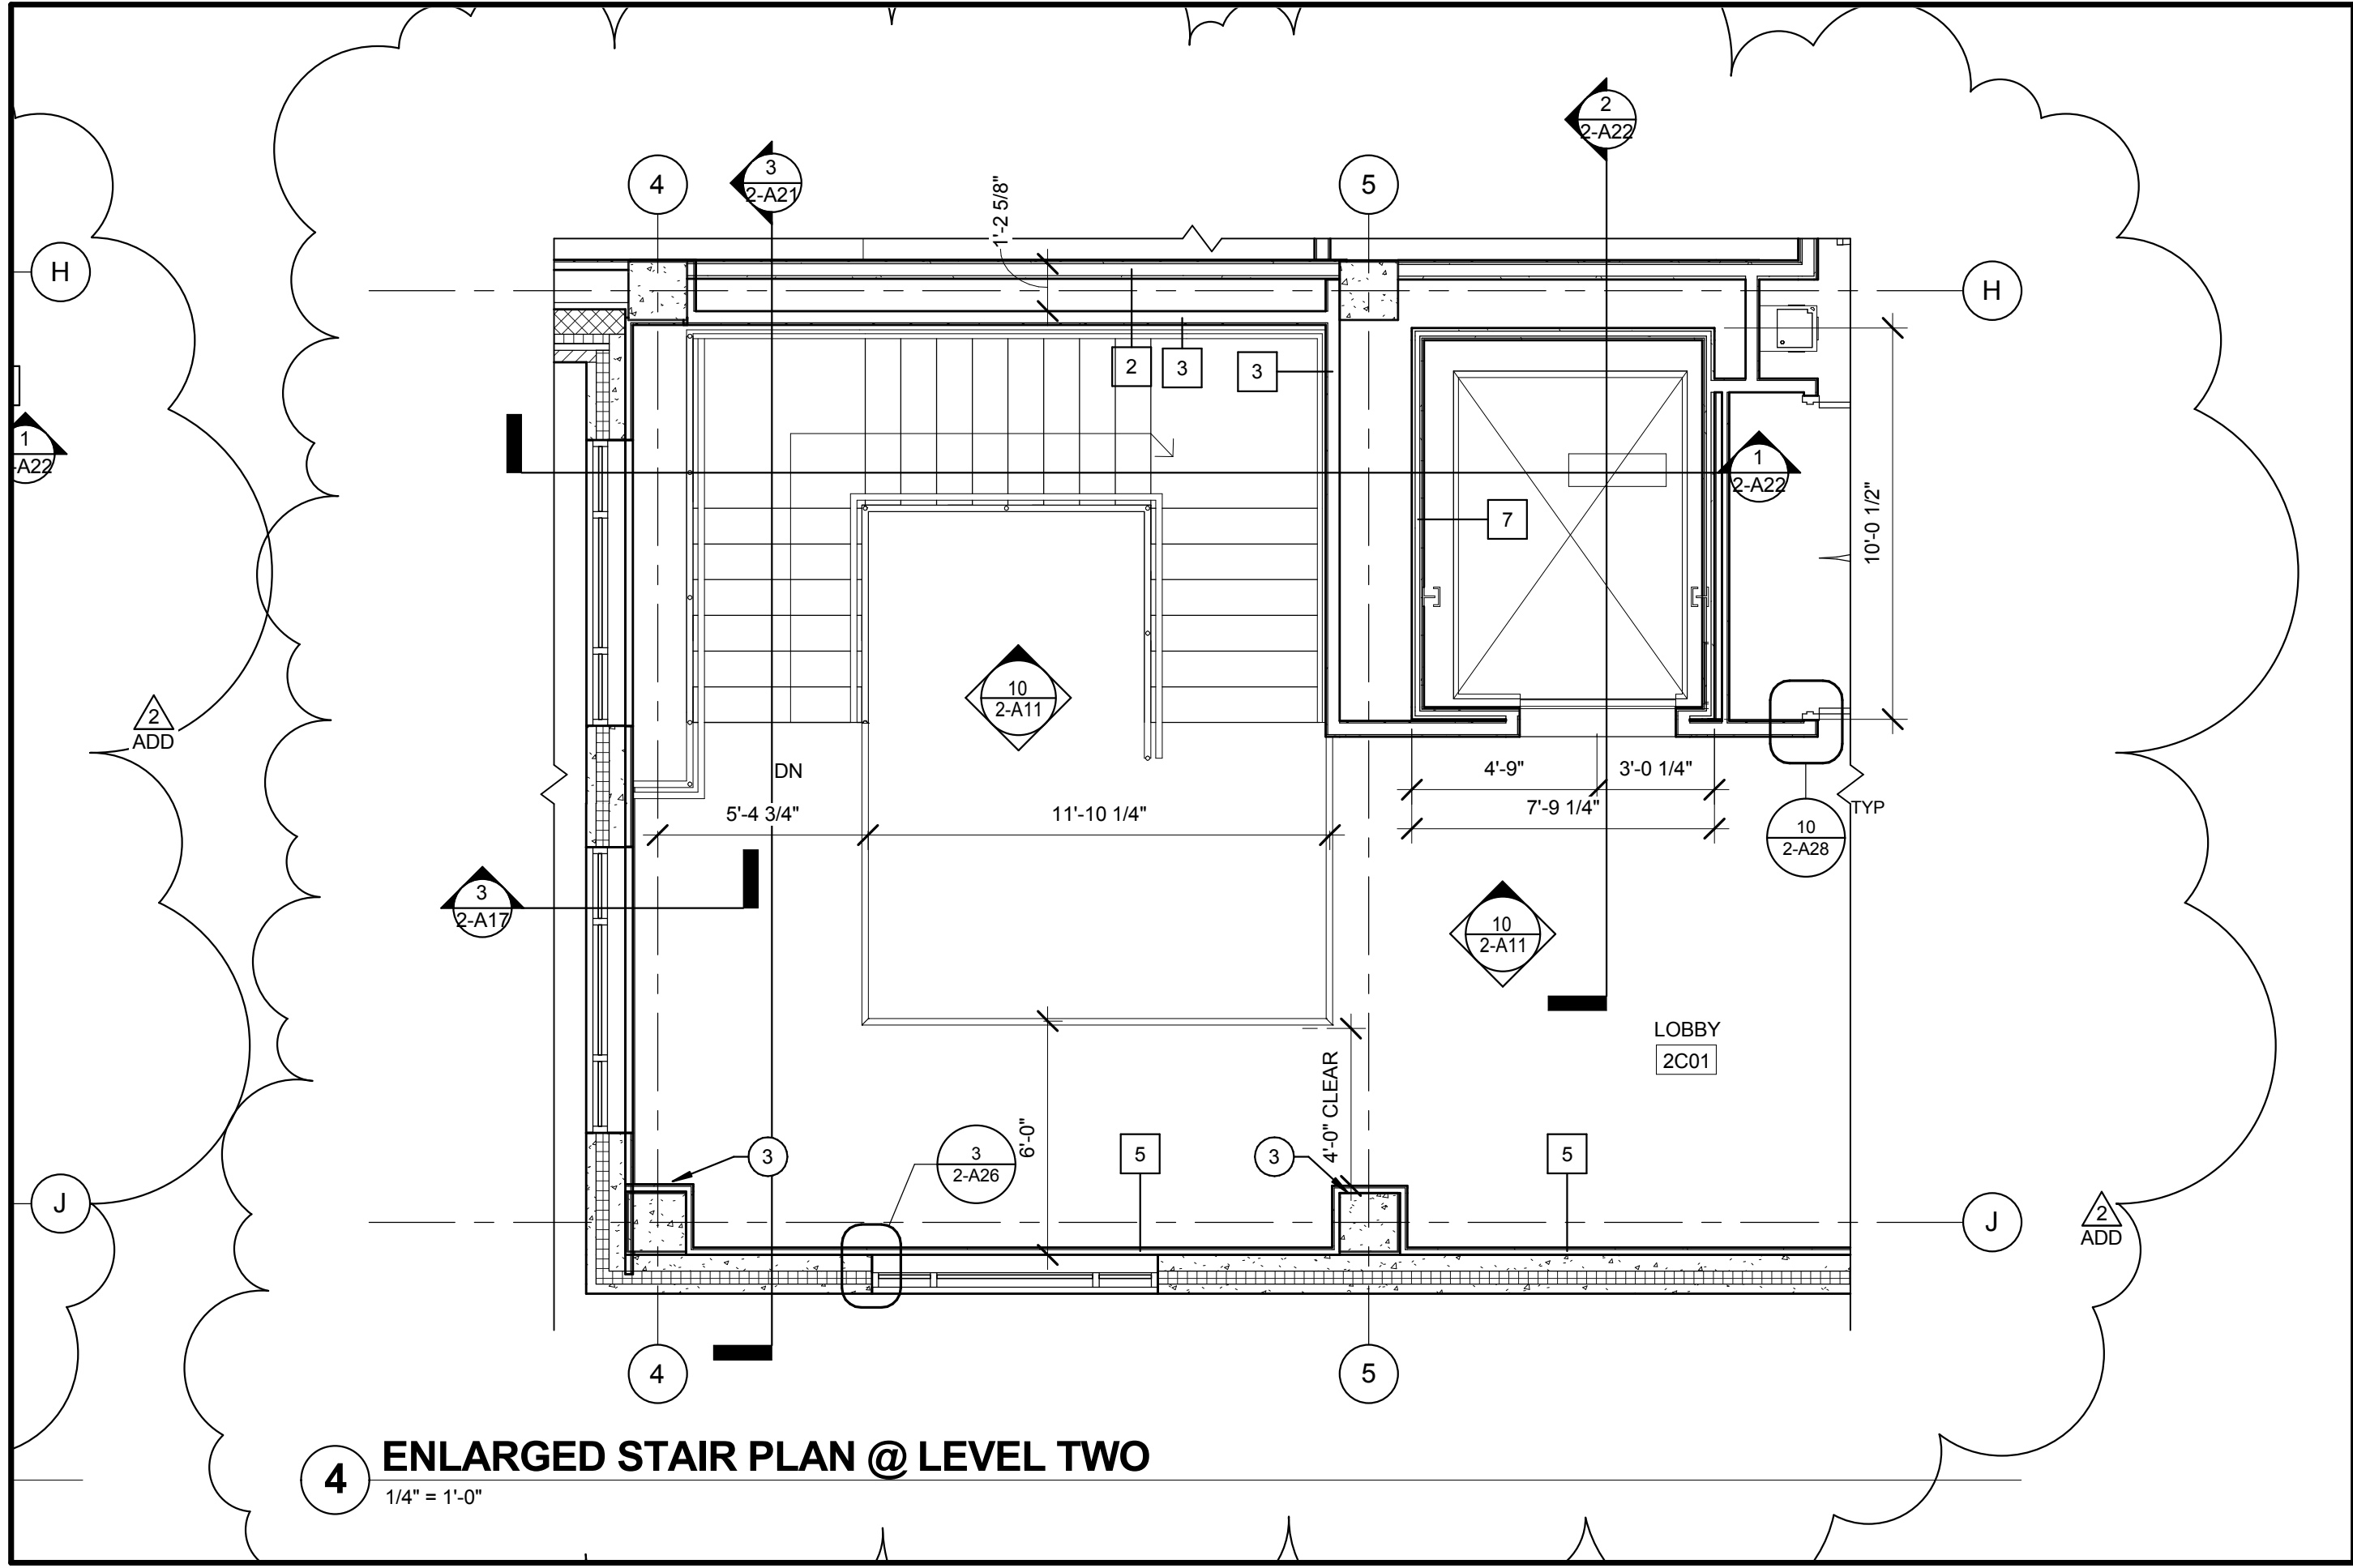

**4 ENLARGED STAIR PLAN @ LEVEL TWO**  
1/4" = 1'-0"

RENOVATE AND EXPAND SPACE FOR PATIENT SUPPORT AREAS

2-1  
IOWA CITY VA HEALTH CARE SYSTEM  
IOWA CITY, IOWA

DATE	SCALE	As indicated	Field BOOK	Book #
03/06/2015	APPROVED	Author	REFERENCE DRAWING	2-A21

PROJECT NO. 110240-0
ISSUED FOR ADD 2
SD-2

**SHIVE-HATTERY**  
ARCHITECTURE + ENGINEERING  
Iowa | Illinois | Indiana | Missouri | <http://www.shive-hattery.com>