



3/9/2015 8:18:29 AM

C:\shive\Revit_Local\1102400-A-NEW BUILDING 2_eas\lbe.rvt

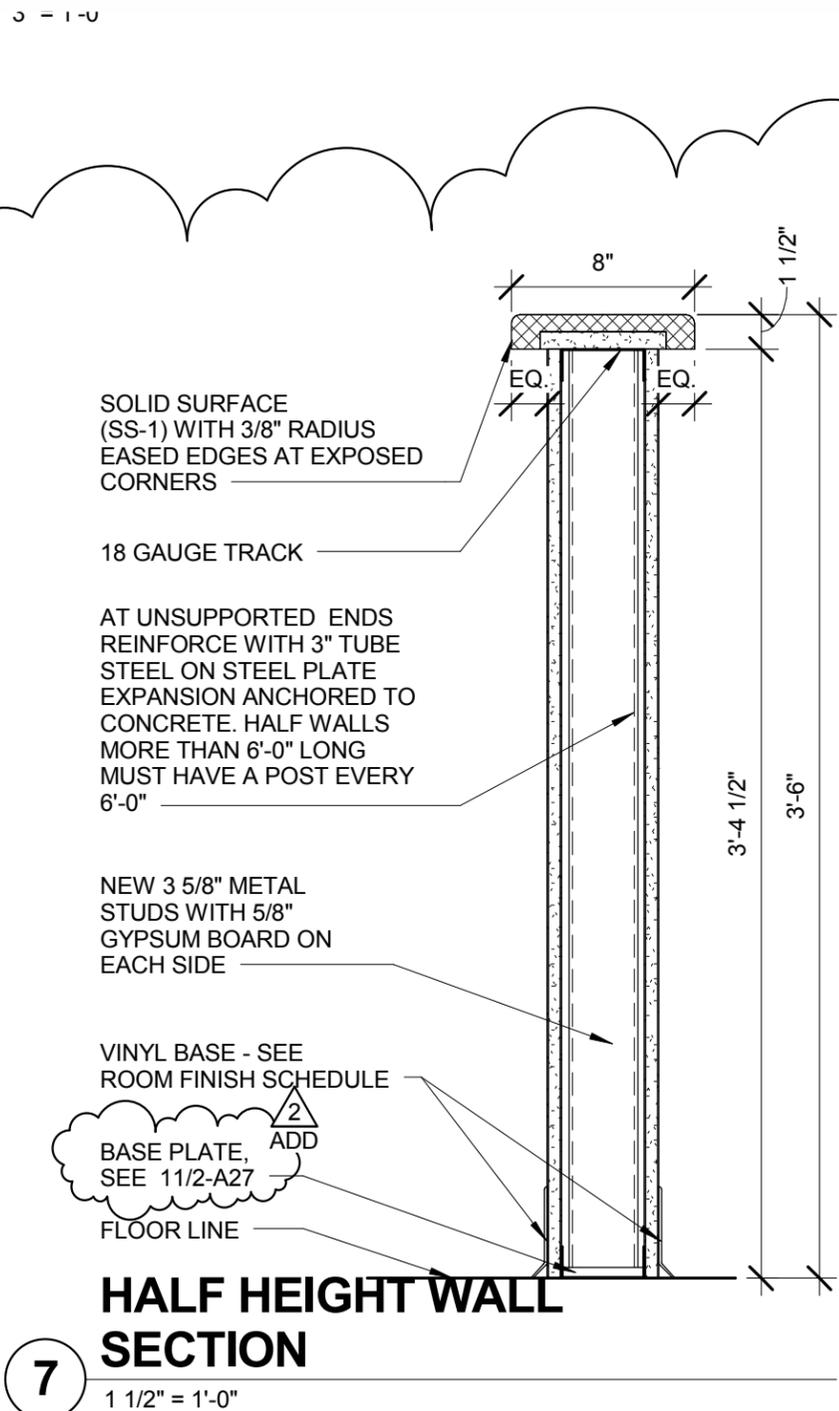

7 HALF HEIGHT WALL SECTION
1 1/2" = 1'-0"

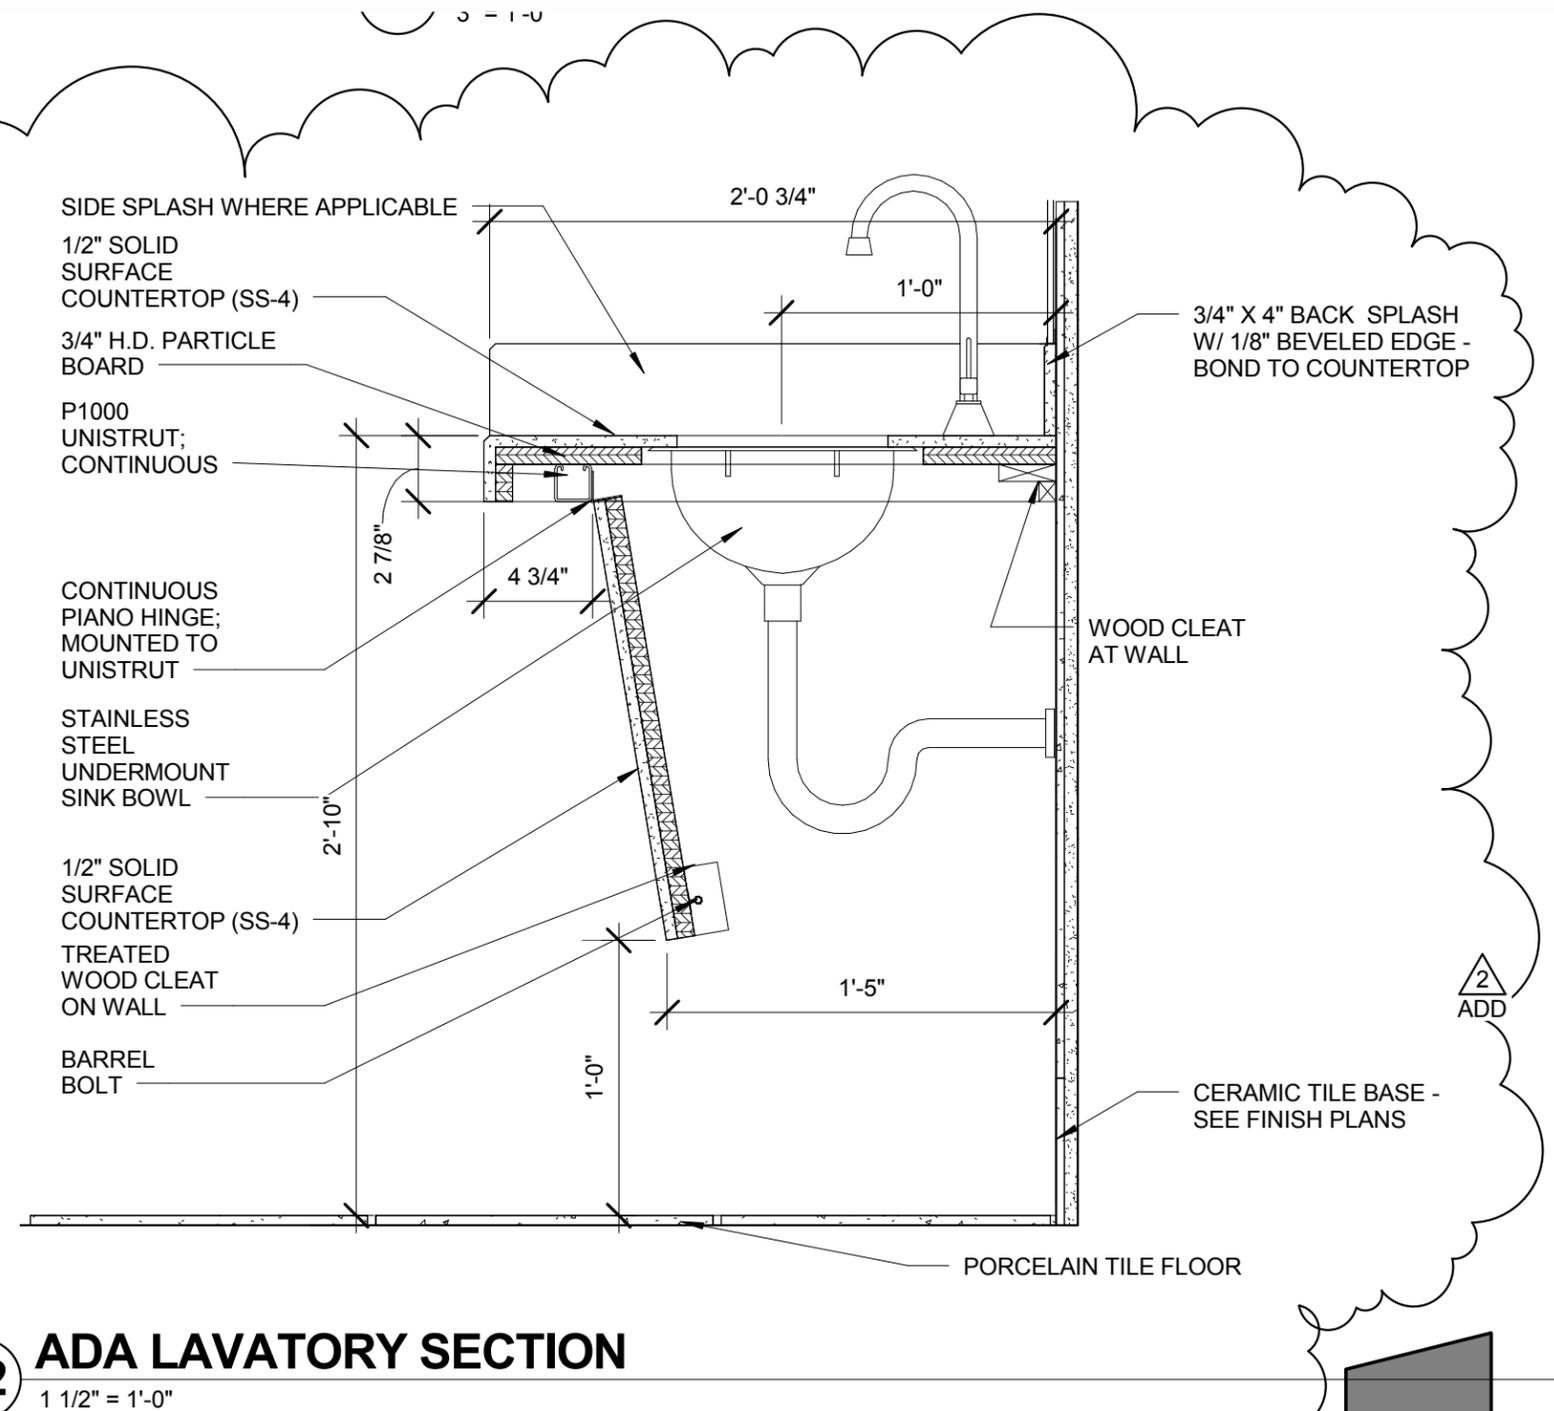

12 ADA LAVATORY SECTION
1 1/2" = 1'-0"

1/2x3 1/2x9 BASE PLATE WITH (2) 1/2" DIA ANCHORS EPOXY-SET

RENOVATE AND EXPAND SPACE FOR PATIENT SUPPORT AREAS

2-1
IOWA CITY VA HEALTH CARE SYSTEM
IOWA CITY, IOWA

DATE	03/06/2015	SCALE	As indicated	FIELD BOOK	Book #	2-A27
DRAWN	EAS	APPROVED	Approver	REFERENCE DRAWING		

PROJECT NO.
110240-0

ISSUED FOR
ADD 2

SD-4