




10 CORNER GUARD DETAIL
1 1/2" = 1'-0"

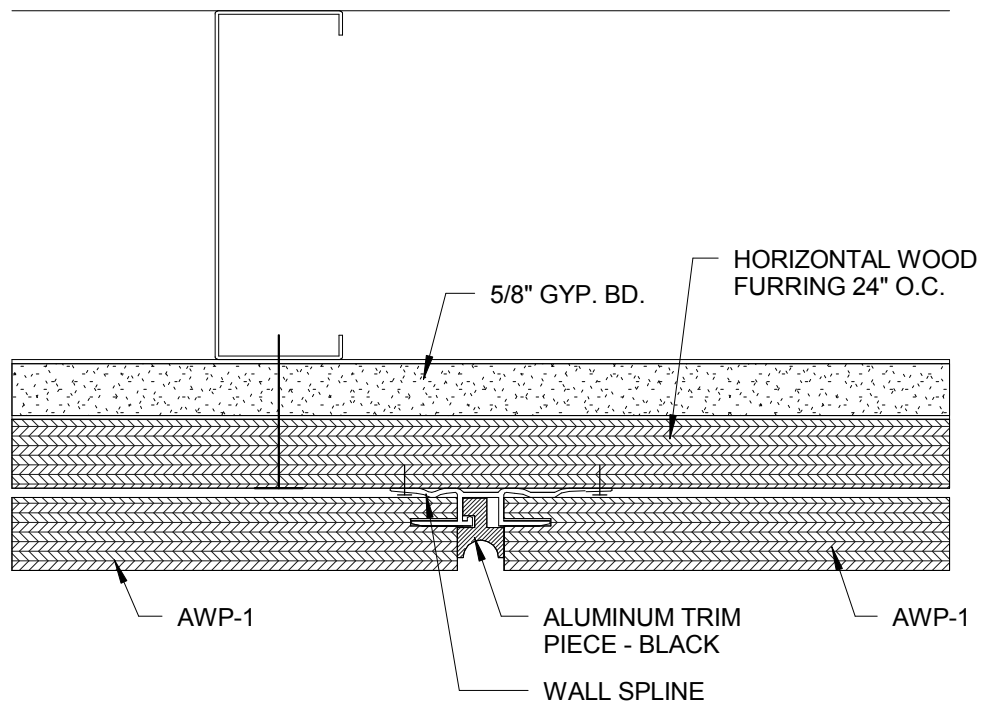


11 AWP-1 DETAILS
6" = 1'-0"

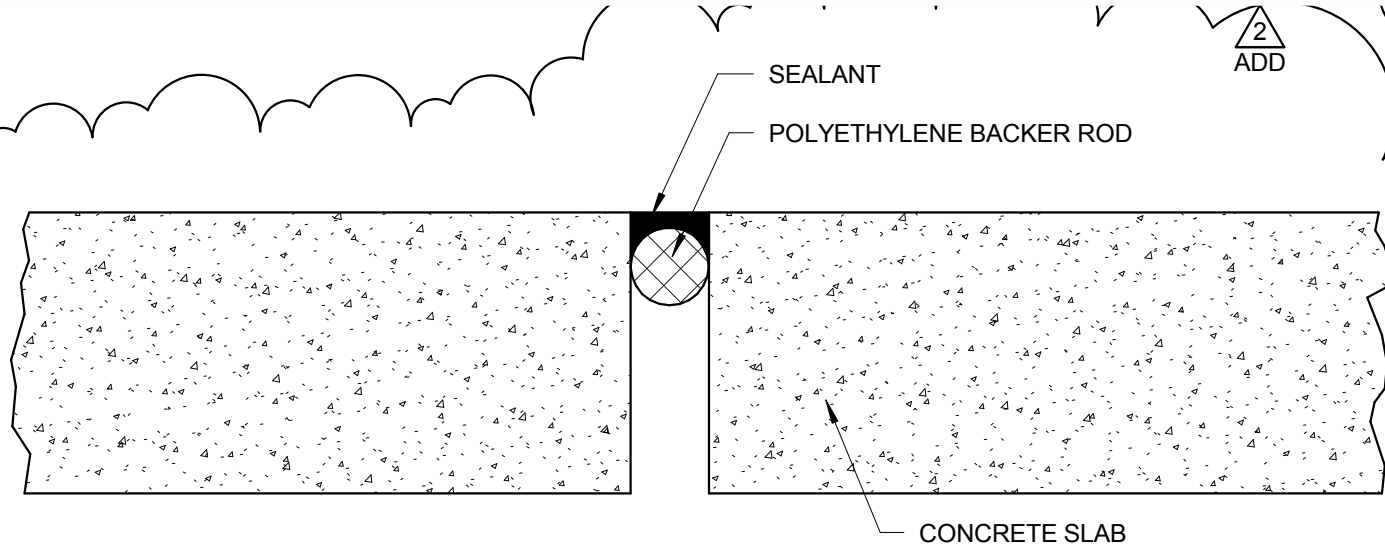

12 EXPANSION JOINT
12" = 1'-0"

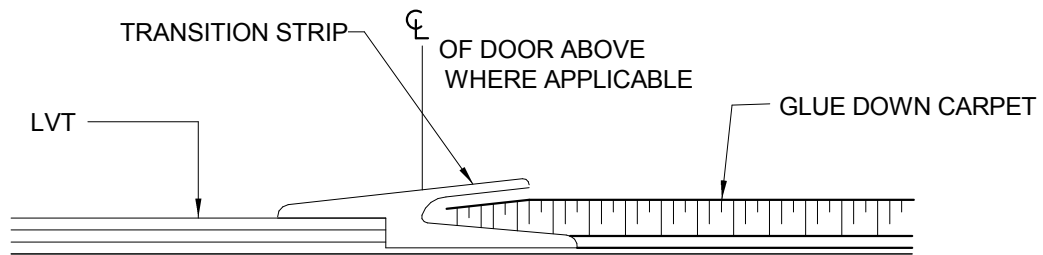

13 LUXURY VINYL TILE TO CARPET
12" = 1'-0"

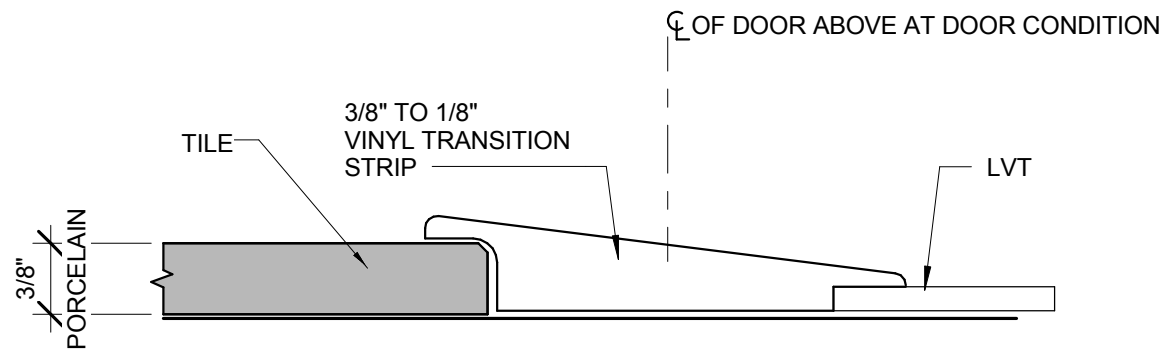

14 PORCELAIN TILE TO LUXURY VINYL TILE
12" = 1'-0"

15
3" = 1'-0"

RENOVATE AND EXPAND SPACE FOR PATIENT SUPPORT AREAS

2-1
IOWA CITY VA HEALTH CARE SYSTEM
IOWA CITY, IOWA

DATE	SCALE	As indicated	Field Book	Book #
03/06/2015	APPROVED	Author	REFERENCE DRAWING	2-A28

PROJECT NO.
110240-0

ISSUED FOR
ADD 2

SD-6

Drawing Title

SHIVE-HATTERY
ARCHITECTURE + ENGINEERING
Iowa | Illinois | Indiana | Missouri | <http://www.shive-hattery.com>