


4

3" = 1'-0"

CURTAINWALL/STOREFRONT HEAD AT BRICK

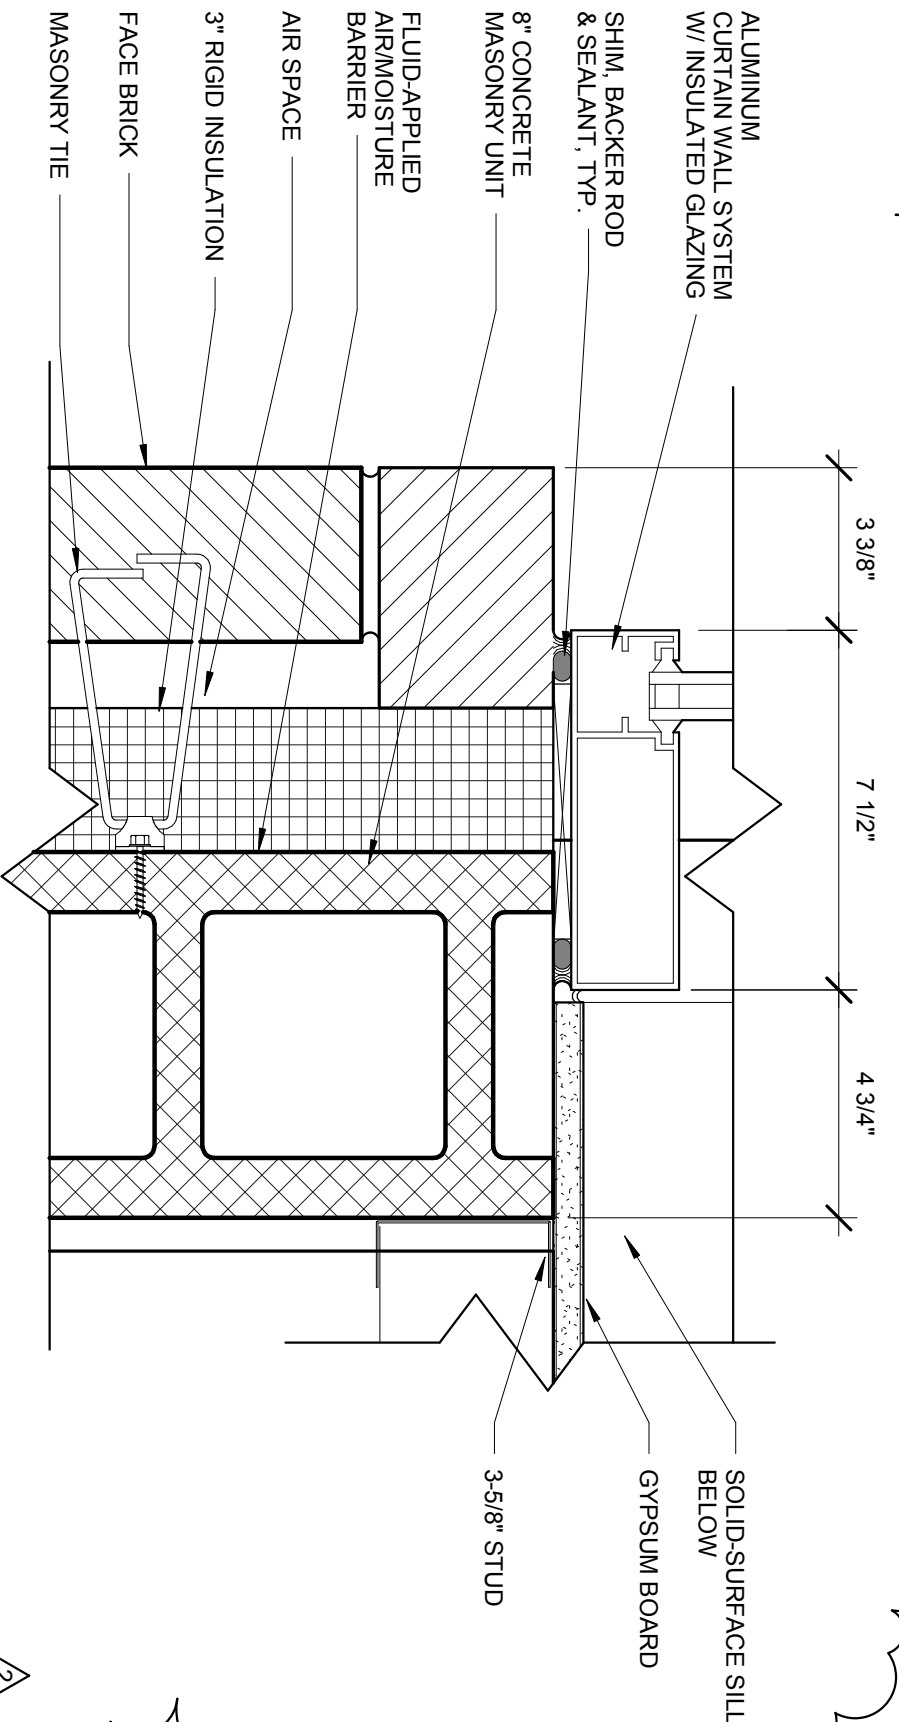

8

3" = 1'-0"

CURTAINWALL/STOREFRONT JAMB AT BRICK

RENOVATE AND EXPAND SPACE FOR PATIENT SUPPORT AREAS			
IOWA CITY VA HEALTH CARE SYSTEM IOWA CITY, IOWA			
DATE	03/06/2015	SCALE	As indicated
DRAWN	Author	APPROVED	Approver
PROJECT NO. 1102400-0		FIELD BOOK	
ISSUED FOR ADD 2		REFERENCE DRAWING	
SD-8		Book # 2-A29	