


3/9/2015 8:21:53 AM

C:\shive\Revit_Local\1102400-A-NEW BUILDING 2_easeib.rvt

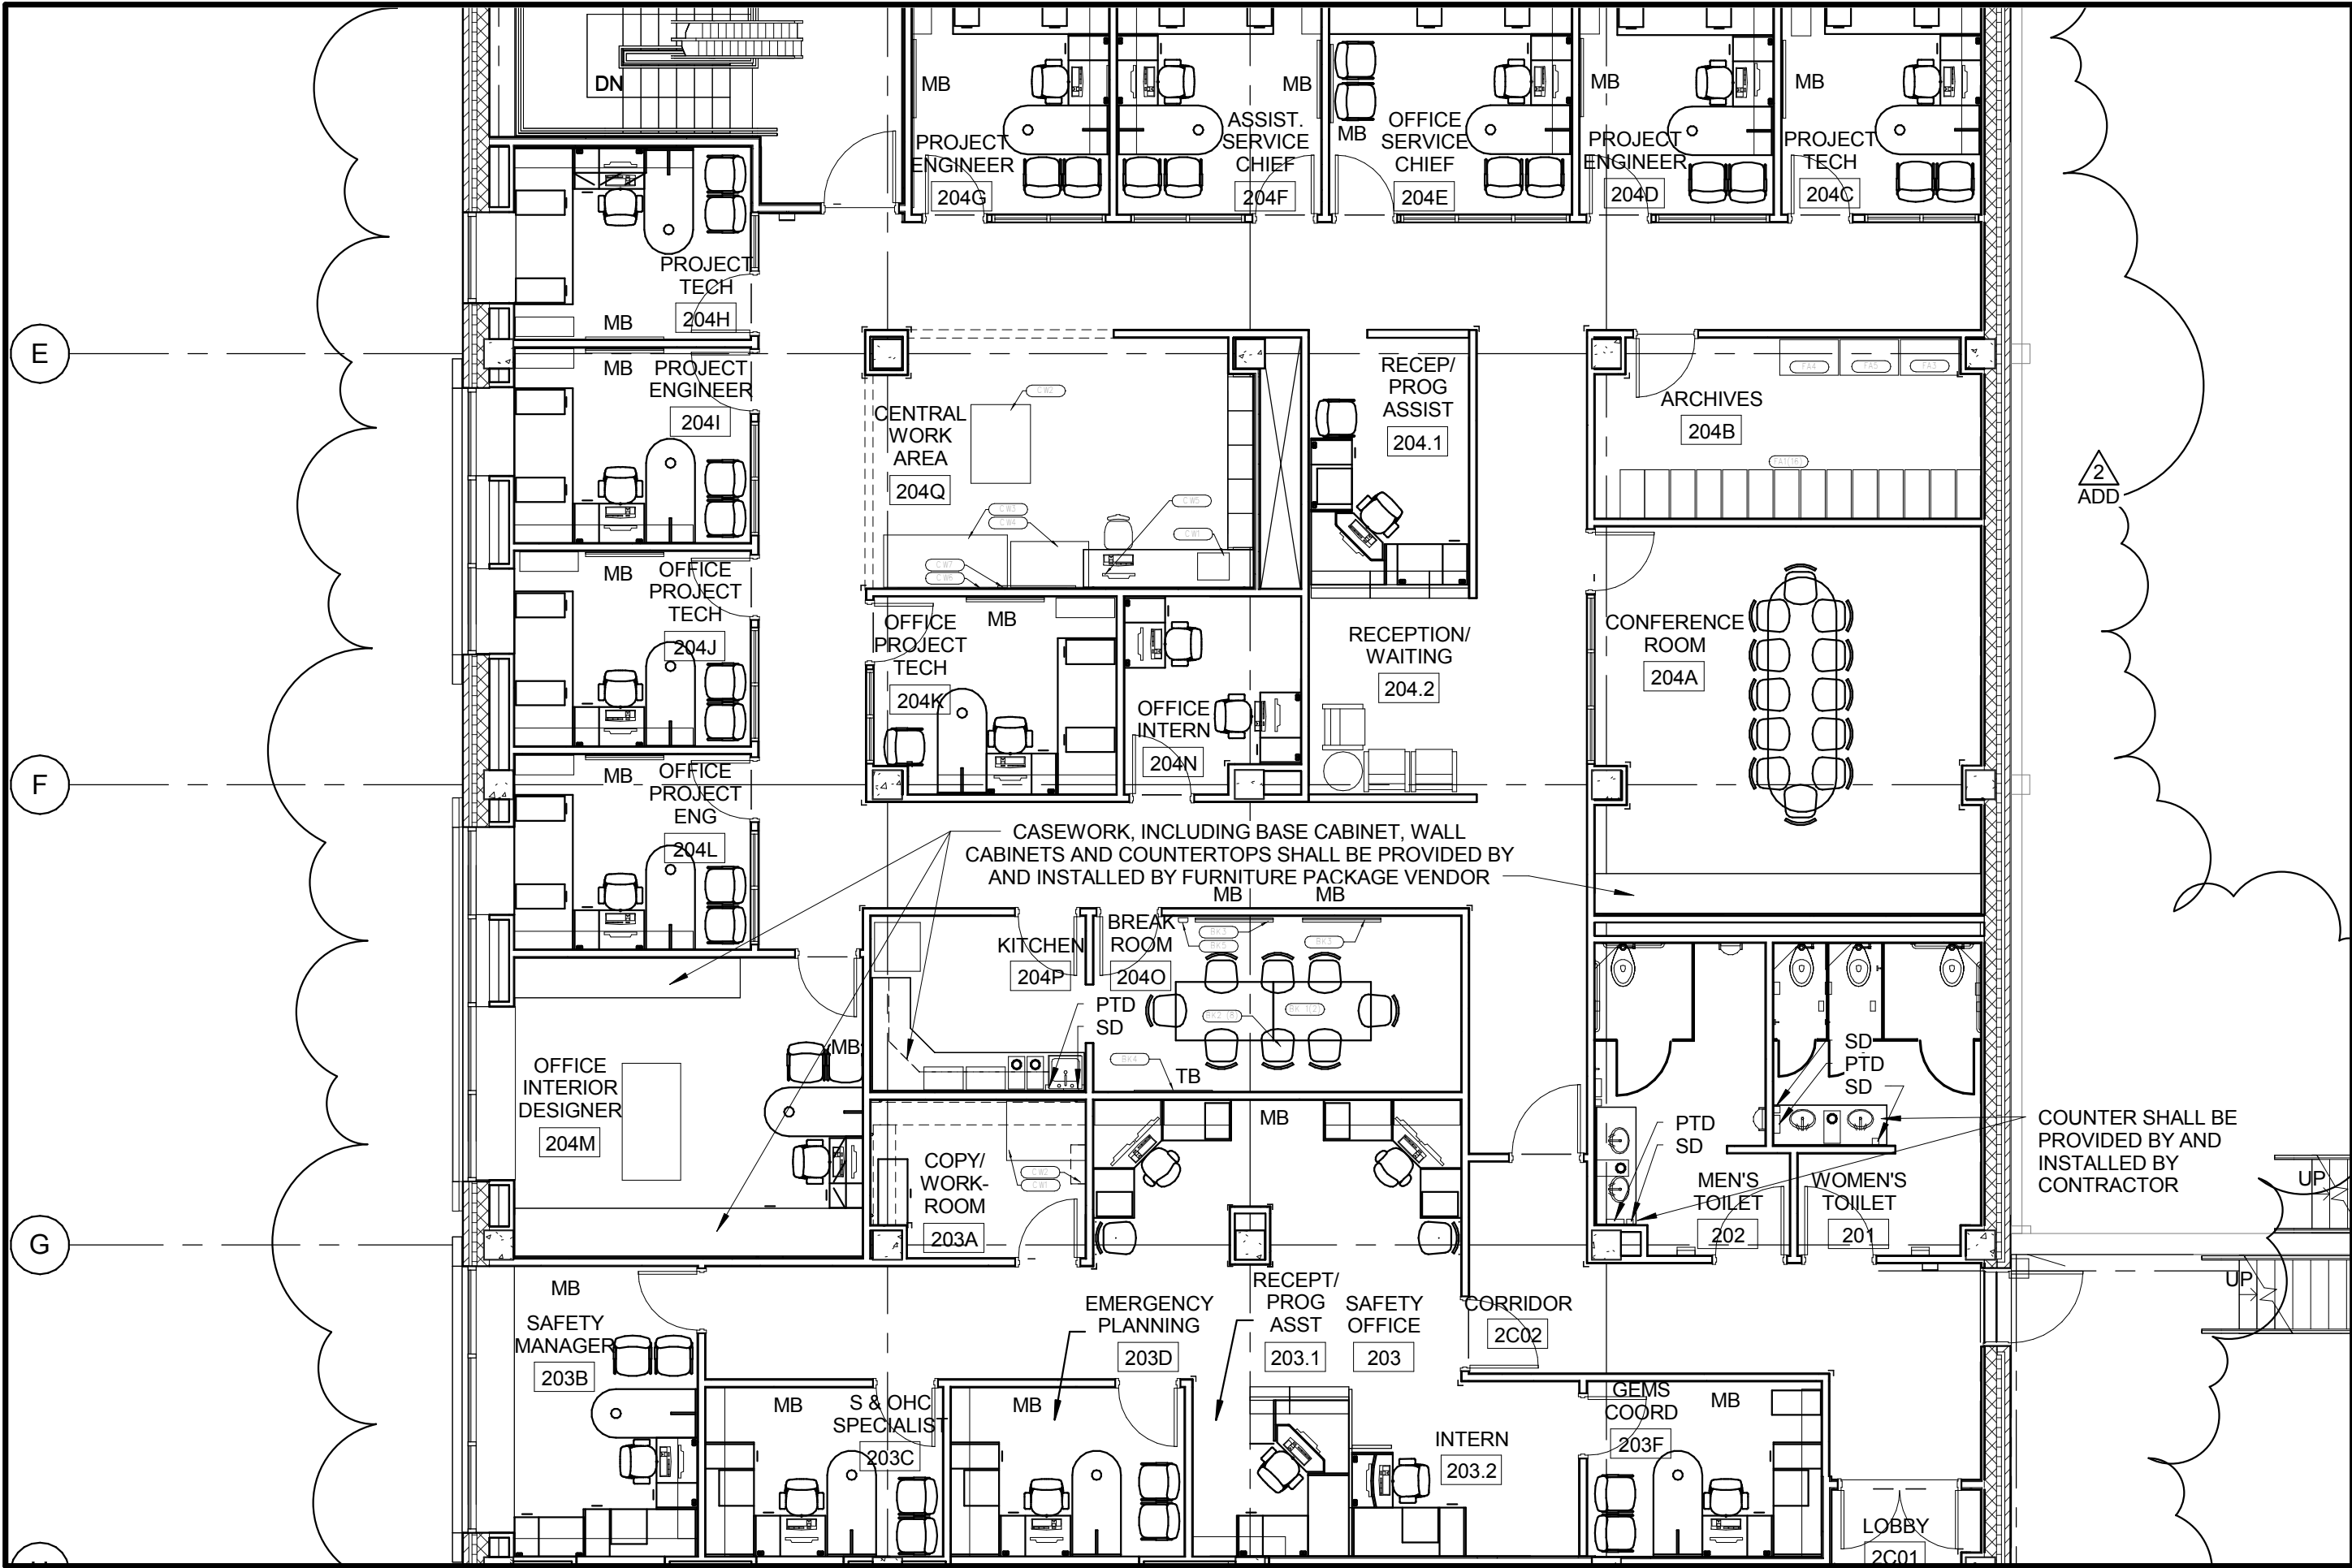

RENOVATE AND EXPAND SPACE FOR PATIENT SUPPORT AREAS

2-1
IOWA CITY VA HEALTH CARE SYSTEM
IOWA CITY, IOWA

PROJECT NO.
110240-0

ISSUED FOR
ADD 2

SD-9

DATE	SCALE	APPROVED	Author	Approver	REFERENCE DRAWING	Book #
03/06/2015	1/8" = 1'-0"	APPROVED				2-A10

SHIVE-HATTERY
ARCHITECTURE + ENGINEERING
Iowa | Illinois | Indiana | Missouri | <http://www.shive-hattery.com>