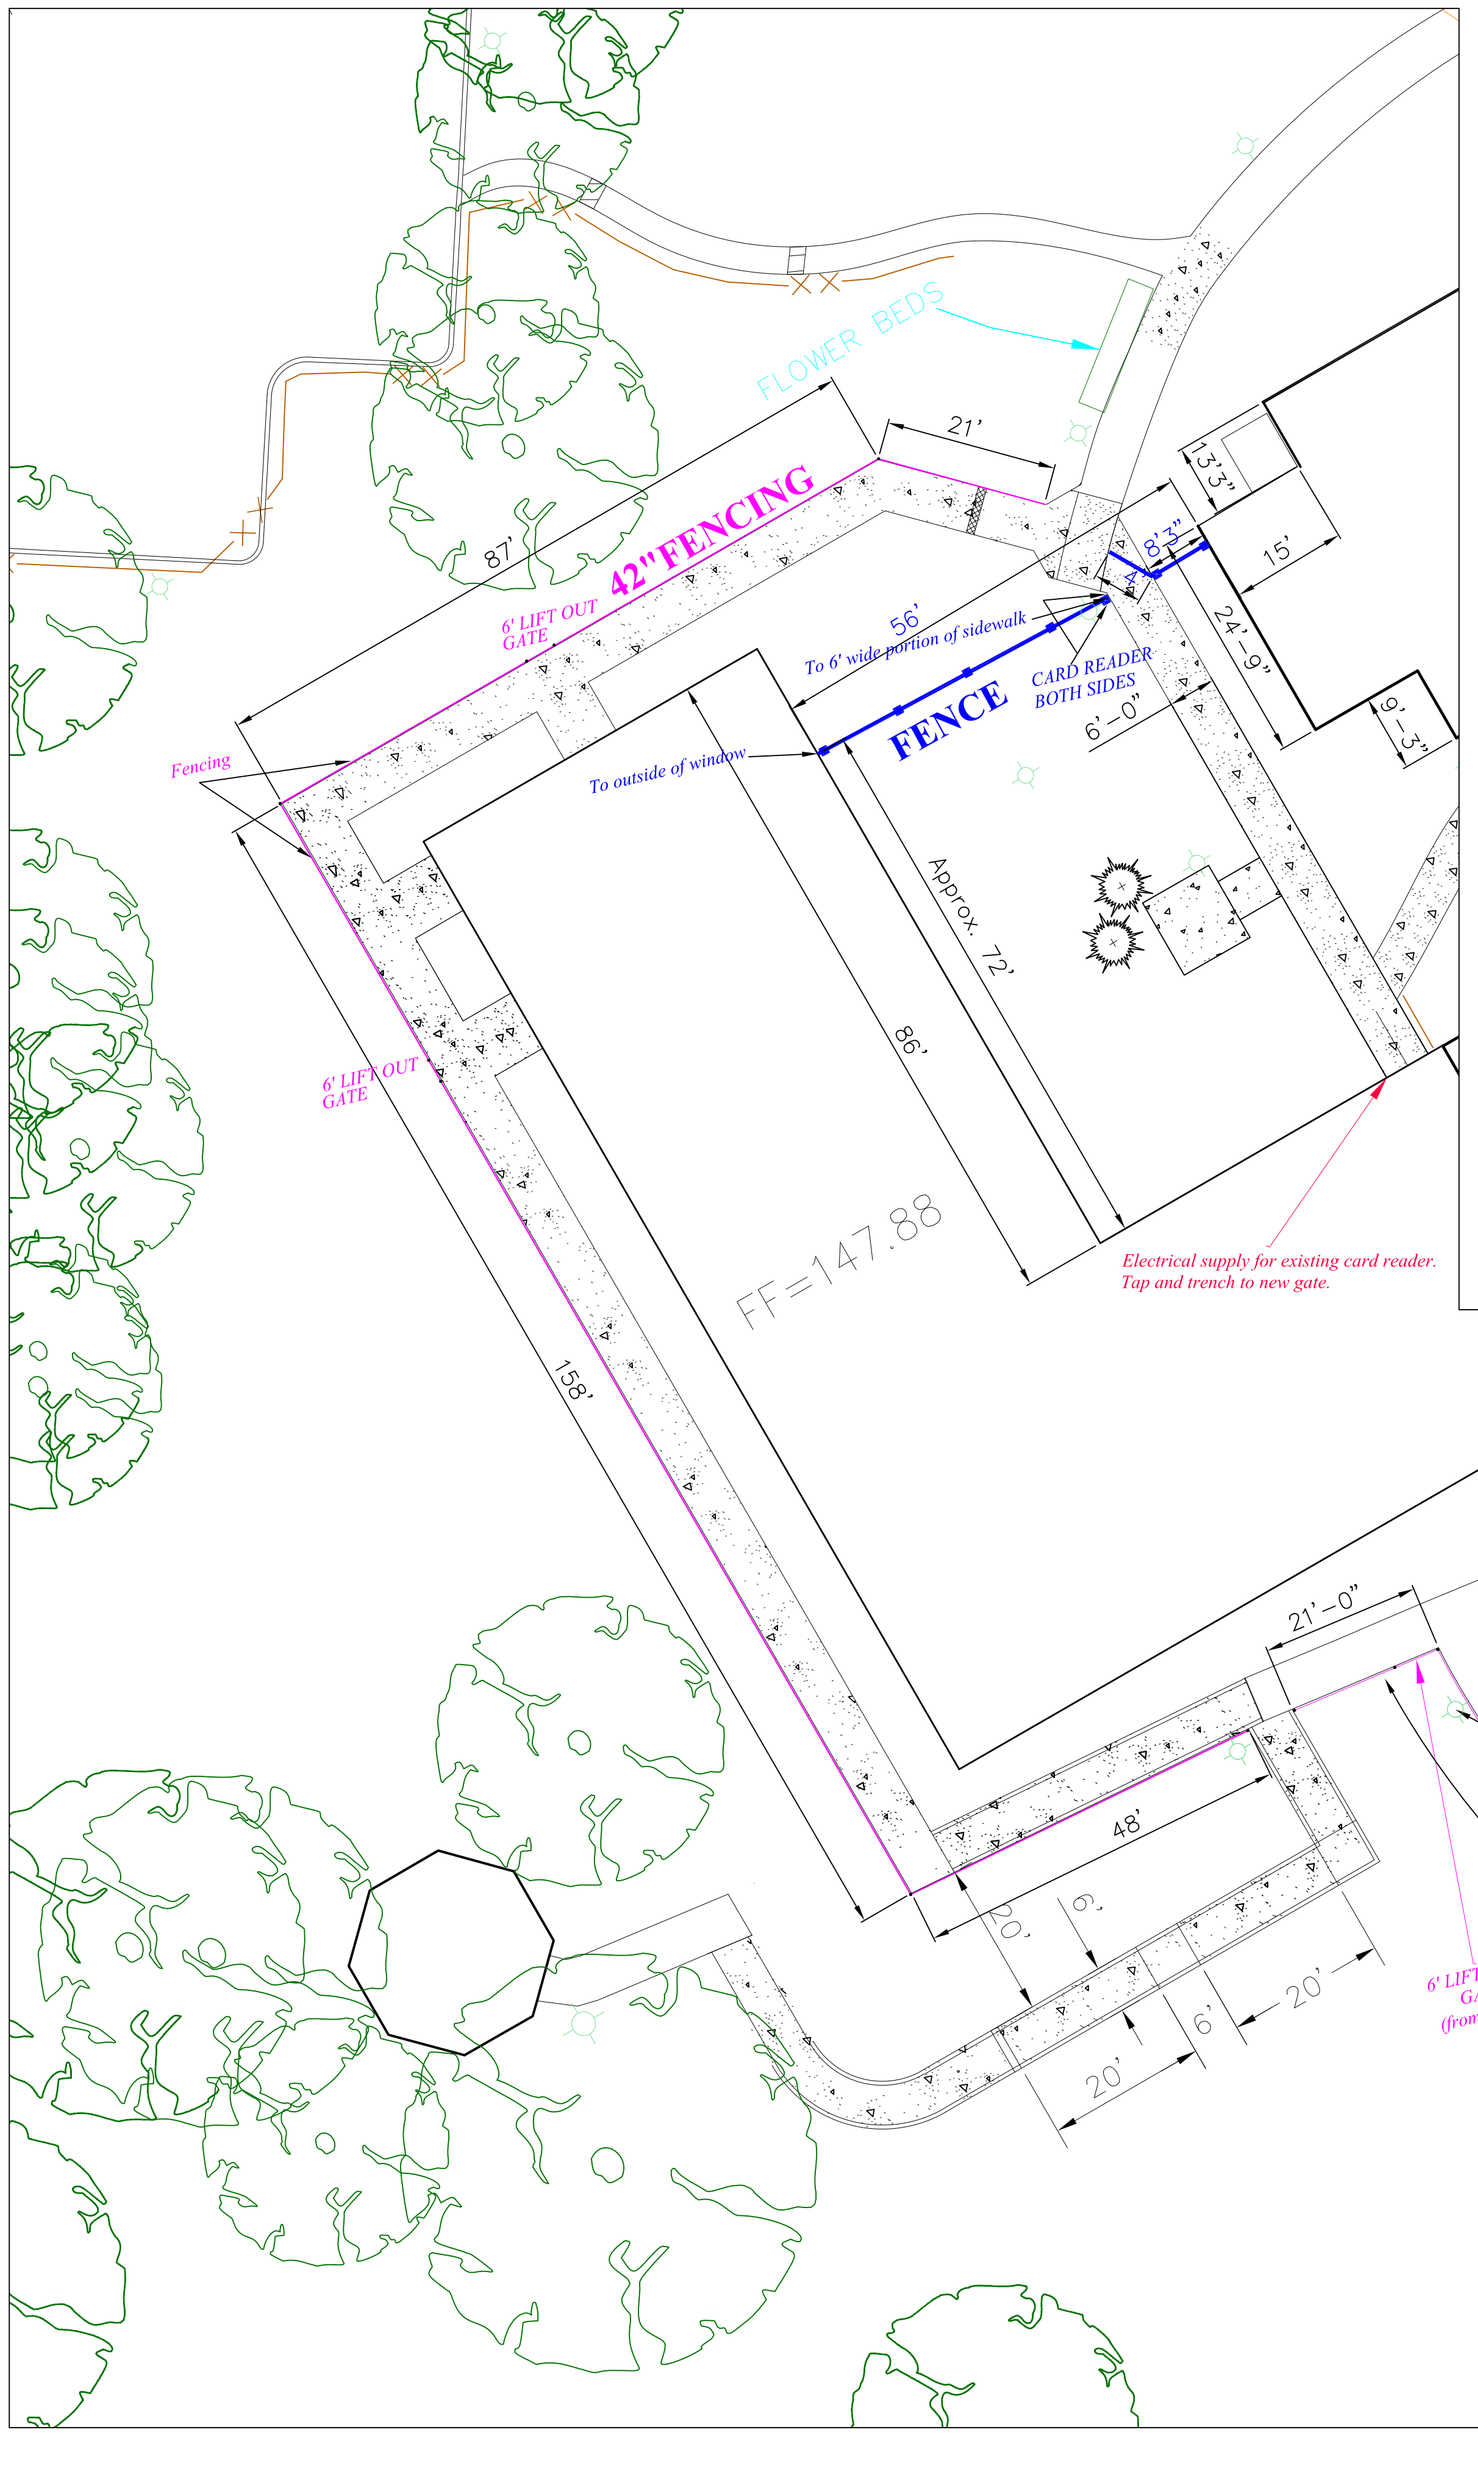

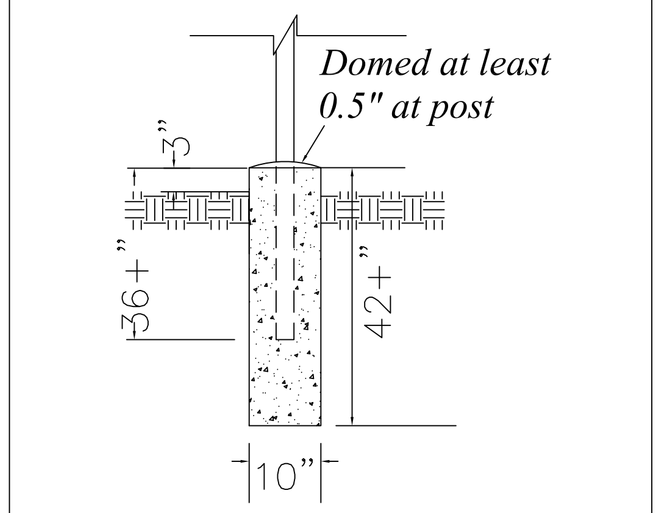

POST INSTALLATION DETAIL

LEGEND

- 8' FENCING
- 42" FENCING
- CONCRETE
- EARTH

REVISED

Project Title
COMMUNITY LIVING CENTER - VA MEDICAL CENTER
ALEXANDRIA, LOUISIANA

Drawing Title
BUILDING 45 SITE PLAN FOR FENCING

Building Number: 45
Checked: JJT
Drawn: HJH
Location: Alexandria, Louisiana
Approved: Division Chief
Approved: Service Director

Department of Veterans Affairs

Date: 27 JAN 2015

Project No.: 502-14-121

DRAWING NO.: 001 OF