


"Renovate 13B Acute Care & ICU"

Solicitation No. VA247-15-B-0288

Ms. Demorest,

Reference:

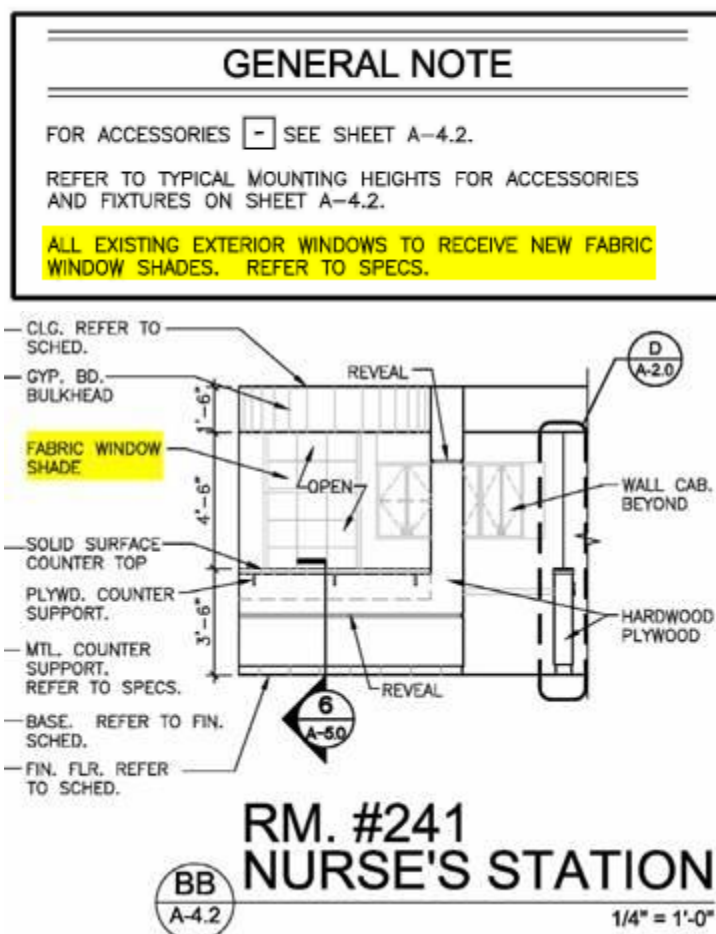

DRAWING A-4.2

Question #1: Is the statement on A-4.2 correct; that all exterior windows are to receive new fabric window shades? (VA) Yes all exposed exterior windows will receive window treatment.

Question #2: Can window sizes be provided for all windows to receive window shades? (VA) Estimate all windows to be 32"x67".