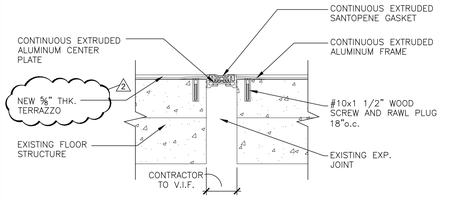

N A-2.1 FLR. EXP. JOINT COVER DTL.

3" = 1'-0"

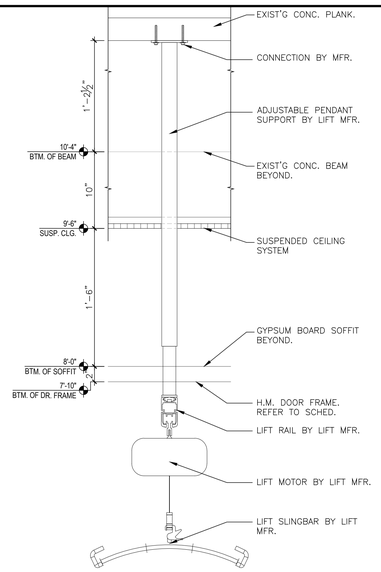

P A-2.1 PATIENT LIFT MOUNT DTL.

1 1/2" = 1'-0"

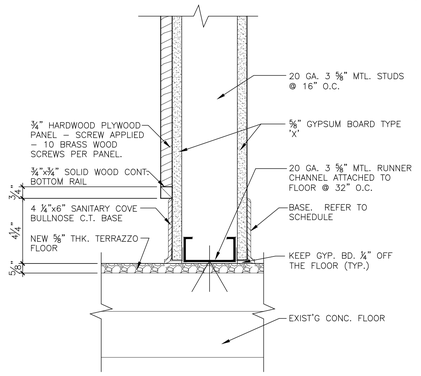

Q A-2.1 C.T. BASE DTL.

3" = 1'-0"

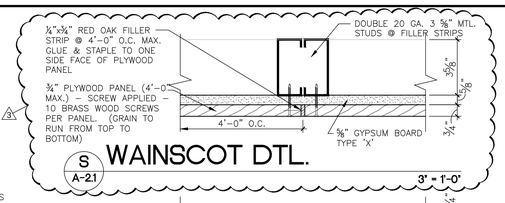

S A-2.1 WAINSCOT DTL.

3" = 1'-0"

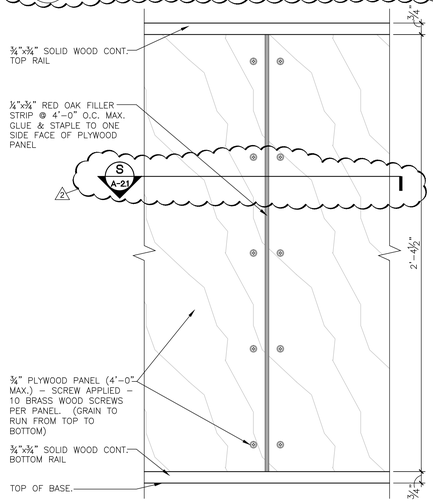

R A-2.1 WAINSCOT DTL.

3" = 1'-0"

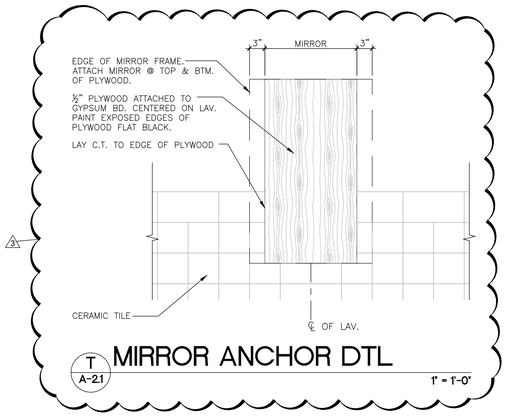

T A-2.1 MIRROR ANCHOR DTL

1" = 1'-0"

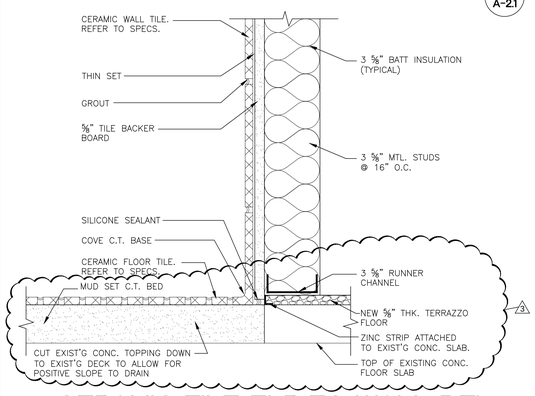

H A-2.1 CERAMIC TILE FLR TO WALL DTL.

3" = 1'-0"

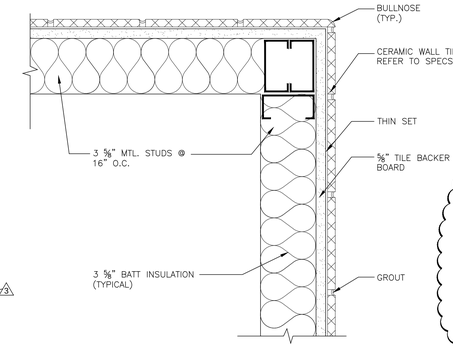

J A-2.1 OUTSIDE CORNER BULLNOSE CERAMIC TILE DTL.

3" = 1'-0"

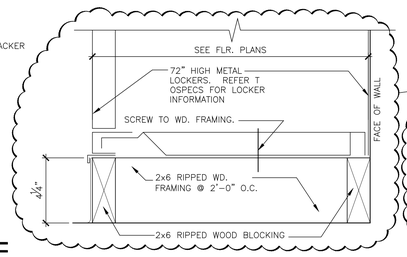

K A-2.1 LOCKER BASE DTL.

3" = 1'-0"

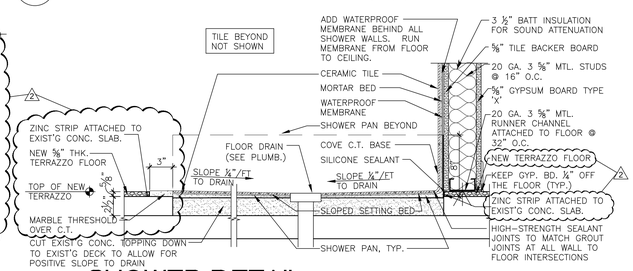

L A-2.1 SHOWER DETAIL

1 1/2" = 1'-0"

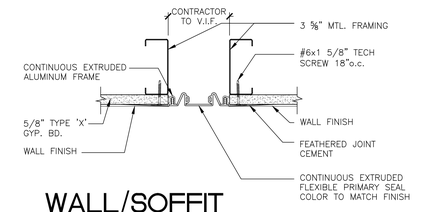

M A-2.1 WALL/SOFFIT EXP. JOINT COVER DTL.

3" = 1'-0"

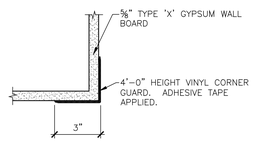

G A-2.1 CORNER GUARD DTL.

3" = 1'-0"

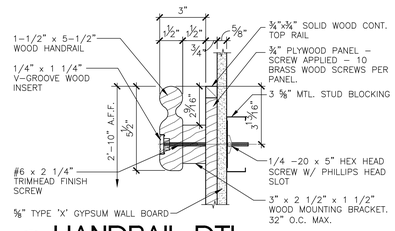

A A-2.1 HANDRAIL DTL.

3" = 1'-0"

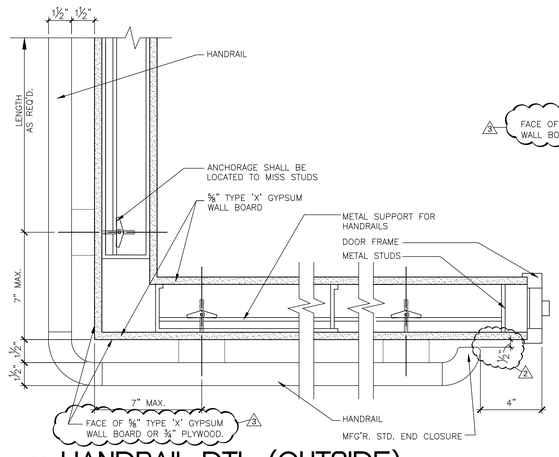

B A-2.1 HANDRAIL DTL. (OUTSIDE)

3" = 1'-0"

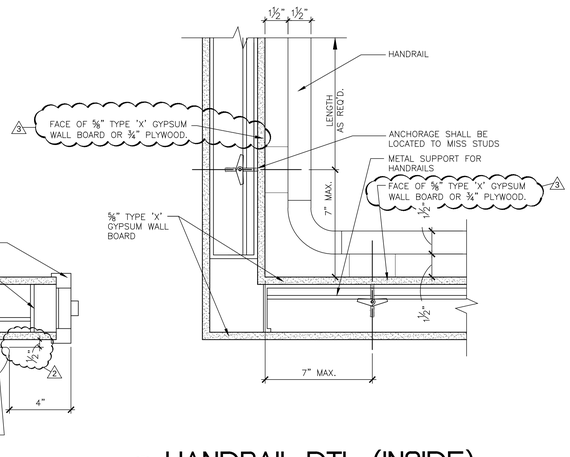

C A-2.1 HANDRAIL DTL. (INSIDE)

3" = 1'-0"

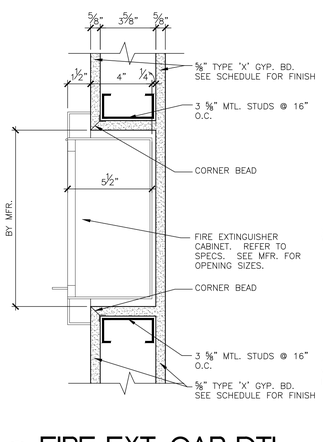

D A-2.1 FIRE EXT. CAB DTL.

3" = 1'-0"

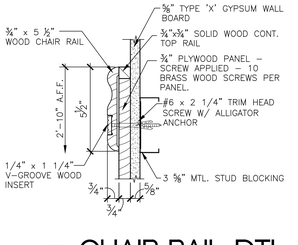

E A-2.1 CHAIR RAIL DTL.

3" = 1'-0"

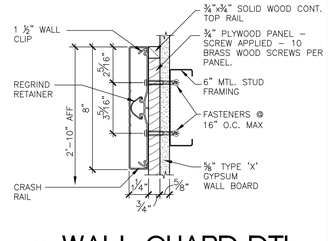

F A-2.1 WALL GUARD DTL.

3" = 1'-0"

CONSTRUCTION DOCUMENTS - 100% SUBMISSION

Revisions	Date
1 REVIEW REVISIONS	02/25/15
2 ADDENDUM ISSUE	03/19/15
3 ADDENDUM ISSUE	03/26/15

ARCHITECT AND CONSULTANTS:

DEANE + STROLLO, LLC
718 Virginia Drive
Orlando, FL. 32803
T: (407) 423-5355 F: (407) 422-5994

MOSES & ASSOCIATES
2209 NW 40th Ter. Ste. A
Gainesville, FL. 32605
T: (352) 372-1911 F: (352) 372-0186

DEPARTMENT OF VETERAN AFFAIRS
ENGINEERING SERVICE
ENGINEERING PLANNING AND ANALYSIS

Approved:

Engineering Asst. Chief
Engineering Maint. And Oper.
Engineering Equipment Manager
Engineering Health & Safety
Engineering Planning & Analysis
C.O.R.

Drawing Title: SECTIONS AND DETAILS

Project Title: RENOVATE 13B FOR ACUTE CARE AND INTENSIVE CARE UNIT

Date: JANUARY 30, 2015

Project No.: 557-14-105

Approved: Chief, Engineering Service: –

Building Number: 13B

Checked: JS,KS

Drawn: GC

Approved: Service Director: –

Location: 1826 VETERANS BLVD. - DUBLIN, GA 31021

DRAWING NO. A-2.1R

Dwg. 11 OF 60

Engineering Service

VA U.S. Department of Veterans Affairs

VA FORM 08-6231, DEC 1989