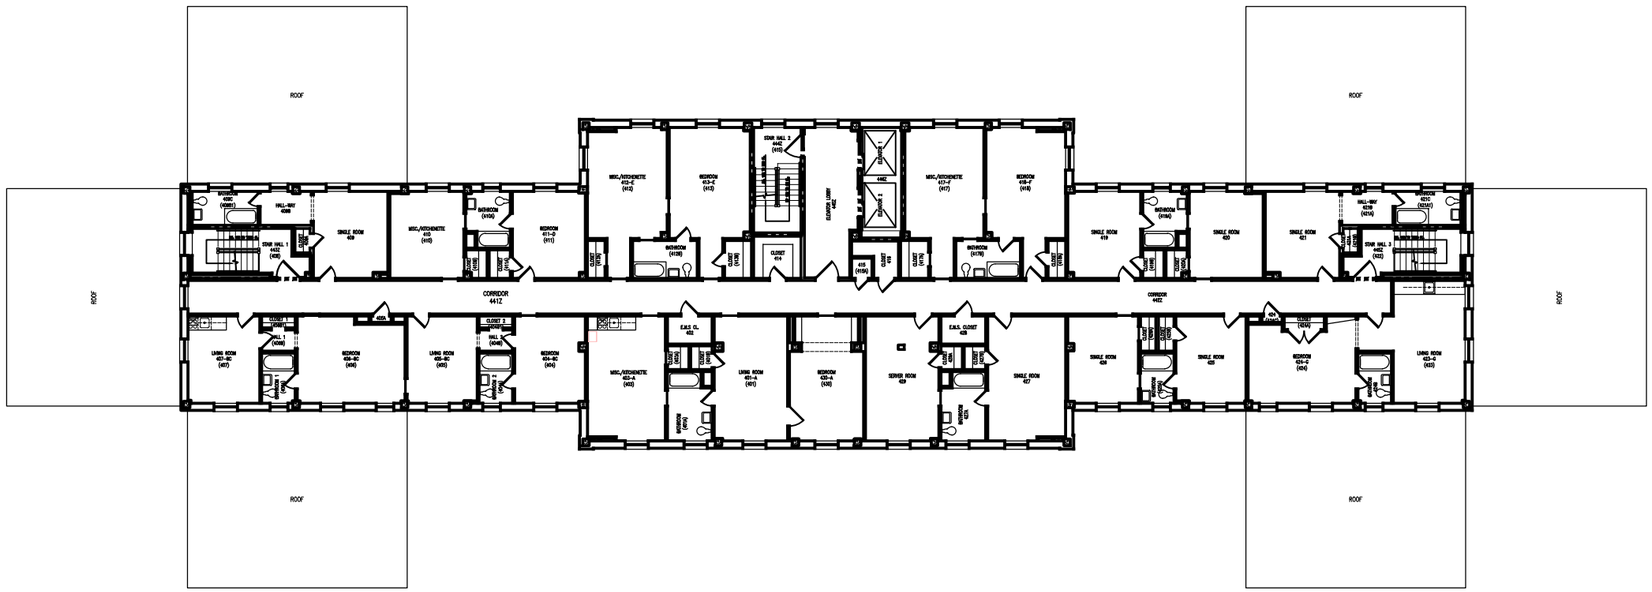

FOURTH FLOOR PLAN

Space Occupancy Table

Building	Floor	Room	Area	Department	Division	Careline	Description
30	04	---	117.95 SF	UNASSIGNED SPACE	OTHER	Unassigned Space	ELEVATOR SHAFTS
30	04	401-A	13.42 SF	RESIDENTIAL QUARTERS	OTHER	Tenant Space	CLOSET
30	04	401-A	81.67 SF	RESIDENTIAL QUARTERS	OTHER	Tenant Space	BATHROOM
30	04	401-A	206.67 SF	RESIDENTIAL QUARTERS	OTHER	Tenant Space	BEDROOM
30	04	402	31.50 SF	ENVIRONMENTAL MGT. SVC.	NON-CLINICAL	Environmental Mgt. Svc.	E.M.S. CLOSET
30	04	403-A	246.53 SF	RESIDENTIAL QUARTERS	VACANT	SPACE BANK (VACANT)	MISC./KITCHENETTE
30	04	403-A	13.42 SF	RESIDENTIAL QUARTERS	VACANT	SPACE BANK (VACANT)	CLOSET
30	04	404-BC	11.11 SF	RESIDENTIAL QUARTERS	OTHER	Tenant Space	CLOSET 2
30	04	404-BC	18.67 SF	RESIDENTIAL QUARTERS	OTHER	Tenant Space	HALL 2
30	04	404-BC	156.47 SF	RESIDENTIAL QUARTERS	OTHER	Tenant Space	BEDROOM
30	04	404-BC	46.67 SF	RESIDENTIAL QUARTERS	OTHER	Tenant Space	BATHROOM 2
30	04	405-BC	155.28 SF	RESIDENTIAL QUARTERS	OTHER	Tenant Space	LIVING ROOM
30	04	405A	6.77 SF	RESIDENTIAL QUARTERS	OTHER	Tenant Space	F.A. CLOSET
30	04	406-BC	46.67 SF	RESIDENTIAL QUARTERS	OTHER	Tenant Space	BATHROOM 1
30	04	406-BC	18.67 SF	RESIDENTIAL QUARTERS	OTHER	Tenant Space	HALL 1
30	04	406-BC	11.11 SF	RESIDENTIAL QUARTERS	OTHER	Tenant Space	CLOSET
30	04	406-BC	229.73 SF	RESIDENTIAL QUARTERS	OTHER	Tenant Space	MISC./KITCHENETTE
30	04	407-BC	172.00 SF	RESIDENTIAL QUARTERS	OTHER	Tenant Space	BEDROOM 1
30	04	409	166.03 SF	RESIDENTIAL QUARTERS	OTHER	Tenant Space	SINGLE ROOM
30	04	409A	11.46 SF	RESIDENTIAL QUARTERS	OTHER	Tenant Space	CLOSET
30	04	409B	50.80 SF	RESIDENTIAL QUARTERS	OTHER	Tenant Space	HALL-WAY
30	04	409C	75.40 SF	RESIDENTIAL QUARTERS	OTHER	Tenant Space	BATHROOM
30	04	410-D	163.64 SF	RESIDENTIAL QUARTERS	VACANT	SPACE BANK (VACANT)	MISC./KITCHENETTE
30	04	410-D	16.04 SF	RESIDENTIAL QUARTERS	VACANT	SPACE BANK (VACANT)	CLOSET
30	04	410-D	68.25 SF	RESIDENTIAL QUARTERS	VACANT	SPACE BANK (VACANT)	BATHROOM
30	04	411-D	161.25 SF	RESIDENTIAL QUARTERS	VACANT	SPACE BANK (VACANT)	BEDROOM
30	04	411-D	16.04 SF	RESIDENTIAL QUARTERS	VACANT	SPACE BANK (VACANT)	CLOSET
30	04	412-E	17.75 SF	RESIDENTIAL QUARTERS	VACANT	SPACE BANK (VACANT)	CLOSET
30	04	412-E	252.52 SF	RESIDENTIAL QUARTERS	VACANT	SPACE BANK (VACANT)	MISC./KITCHENETTE
30	04	412-E	60.00 SF	RESIDENTIAL QUARTERS	OTHER	Tenant Space	BATHROOM
30	04	413-E	25.50 SF	RESIDENTIAL QUARTERS	OTHER	Tenant Space	CLOSET
30	04	413-E	248.45 SF	RESIDENTIAL QUARTERS	OTHER	Tenant Space	BEDROOM
30	04	414	51.47 SF	RESIDENTIAL QUARTERS	OTHER	Tenant Space	CLOSET
30	04	415	11.11 SF	RESIDENTIAL QUARTERS	OTHER	Tenant Space	CLOSET
30	04	416	32.89 SF	RESIDENTIAL QUARTERS	OTHER	Tenant Space	CLOSET
30	04	417-F	242.48 SF	RESIDENTIAL QUARTERS	VACANT	SPACE BANK (VACANT)	MISC./KITCHENETTE
30	04	417-F	27.00 SF	RESIDENTIAL QUARTERS	VACANT	SPACE BANK (VACANT)	CLOSET
30	04	417-F	60.00 SF	RESIDENTIAL QUARTERS	OTHER	Tenant Space	BATHROOM
30	04	418-F	252.52 SF	RESIDENTIAL QUARTERS	OTHER	Tenant Space	BEDROOM
30	04	418-F	17.75 SF	RESIDENTIAL QUARTERS	OTHER	Tenant Space	CLOSET
30	04	419	161.25 SF	RESIDENTIAL QUARTERS	VACANT	SPACE BANK (VACANT)	SINGLE ROOM
30	04	419A	68.25 SF	RESIDENTIAL QUARTERS	VACANT	SPACE BANK (VACANT)	BATHROOM
30	04	419B	16.04 SF	RESIDENTIAL QUARTERS	VACANT	SPACE BANK (VACANT)	CLOSET
30	04	420	163.64 SF	RESIDENTIAL QUARTERS	VACANT	SPACE BANK (VACANT)	SINGLE ROOM
30	04	420A	16.04 SF	RESIDENTIAL QUARTERS	VACANT	SPACE BANK (VACANT)	CLOSET
30	04	421	166.03 SF	RESIDENTIAL QUARTERS	OTHER	Tenant Space	SINGLE ROOM
30	04	421A	11.46 SF	RESIDENTIAL QUARTERS	OTHER	Tenant Space	CLOSET
30	04	421B	50.80 SF	RESIDENTIAL QUARTERS	OTHER	Tenant Space	HALL-WAY
30	04	421C	75.40 SF	RESIDENTIAL QUARTERS	OTHER	Tenant Space	BATHROOM
30	04	423-G	236.00 SF	RESIDENTIAL QUARTERS	VACANT	SPACE BANK (VACANT)	MISC./KITCHENETTE
30	04	423-G	28.78 SF	RESIDENTIAL QUARTERS	VACANT	SPACE BANK (VACANT)	ENTRY
30	04	424	6.77 SF	RESIDENTIAL QUARTERS	OTHER	Tenant Space	F.A. CLOSET
30	04	424-G	214.95 SF	RESIDENTIAL QUARTERS	VACANT	SPACE BANK (VACANT)	BEDROOM
30	04	424-G	14.78 SF	RESIDENTIAL QUARTERS	VACANT	SPACE BANK (VACANT)	CLOSET
30	04	424-G	46.67 SF	RESIDENTIAL QUARTERS	VACANT	SPACE BANK (VACANT)	BATHROOM
30	04	425	155.28 SF	RESIDENTIAL QUARTERS	OTHER	Tenant Space	SINGLE ROOM
30	04	425A	46.67 SF	RESIDENTIAL QUARTERS	OTHER	Tenant Space	BATHROOM
30	04	425B	14.89 SF	RESIDENTIAL QUARTERS	OTHER	Tenant Space	CLOSET
30	04	426	156.47 SF	RESIDENTIAL QUARTERS	VACANT	SPACE BANK (VACANT)	SINGLE ROOM
30	04	426A	14.89 SF	RESIDENTIAL QUARTERS	VACANT	SPACE BANK (VACANT)	CLOSET
30	04	427	246.53 SF	RESIDENTIAL QUARTERS	OTHER	Tenant Space	SINGLE ROOM
30	04	427A	81.67 SF	RESIDENTIAL QUARTERS	OTHER	Tenant Space	BATHROOM
30	04	427B	13.42 SF	RESIDENTIAL QUARTERS	OTHER	Tenant Space	CLOSET
30	04	428	31.50 SF	ENVIRONMENTAL MGT. SVC.	NON-CLINICAL	Environmental Mgt. Svc.	E.M.S. CLOSET
30	04	429	226.67 SF	RESIDENTIAL QUARTERS	VACANT	Information Resource Mgt.	SINGLE ROOM
30	04	429A	13.42 SF	RESIDENTIAL QUARTERS	VACANT	Information Resource Mgt.	CLOSET
30	04	430-A	228.33 SF	RESIDENTIAL QUARTERS	OTHER	Tenant Space	LIVING ROOM
30	04	440Z	196.29 SF	RESIDENTIAL QUARTERS	OTHER	Tenant Space	ELEVATOR LOBBY
30	04	441Z	517.33 SF	RESIDENTIAL QUARTERS	OTHER	Tenant Space	CORRIDOR
30	04	442Z	453.33 SF	RESIDENTIAL QUARTERS	OTHER	Tenant Space	CORRIDOR
30	04	443Z	144.24 SF	RESIDENTIAL QUARTERS	OTHER	Tenant Space	STAIR HALL 1
30	04	444Z	130.90 SF	RESIDENTIAL QUARTERS	OTHER	Tenant Space	STAIR HALL 2
30	04	445Z	144.24 SF	RESIDENTIAL QUARTERS	OTHER	Tenant Space	STAIR HALL 3
			7726.52 SF				

1 HR FIRE RATED BARRIER

2 HR FIRE RATED BARRIER

Revisions	Date
Careline Updates	01-28-2008
Plan Updates	01-18-2008
Title Block and Color Table Modifications	01-17-2008
As-Built (Indus Systems)	10-29-2004

CONSULTANTS:

Indus Systems, Inc.
2352, Main Street, Concord MA 01742
Tel: 978-461-0555
www.indus-systems.com

ARCHITECT/ENGINEERS:

NORTH:

Drawing Title: Architectural Plan FOURTH FLOOR Scale: 1/8" = 1'-0"

Project Title: As-Built

Project Number: -

Building(s) Number: 30

Drawing Number: A-05

DWG. 5 OF 7

Approved Director

Approved Chief of Engineering

Location: Monrose, New York

Date: 02-26-2009

Checked

Drawn: AMI

Office of Facilities Management

VA FORM 08-6231, OCT 1978