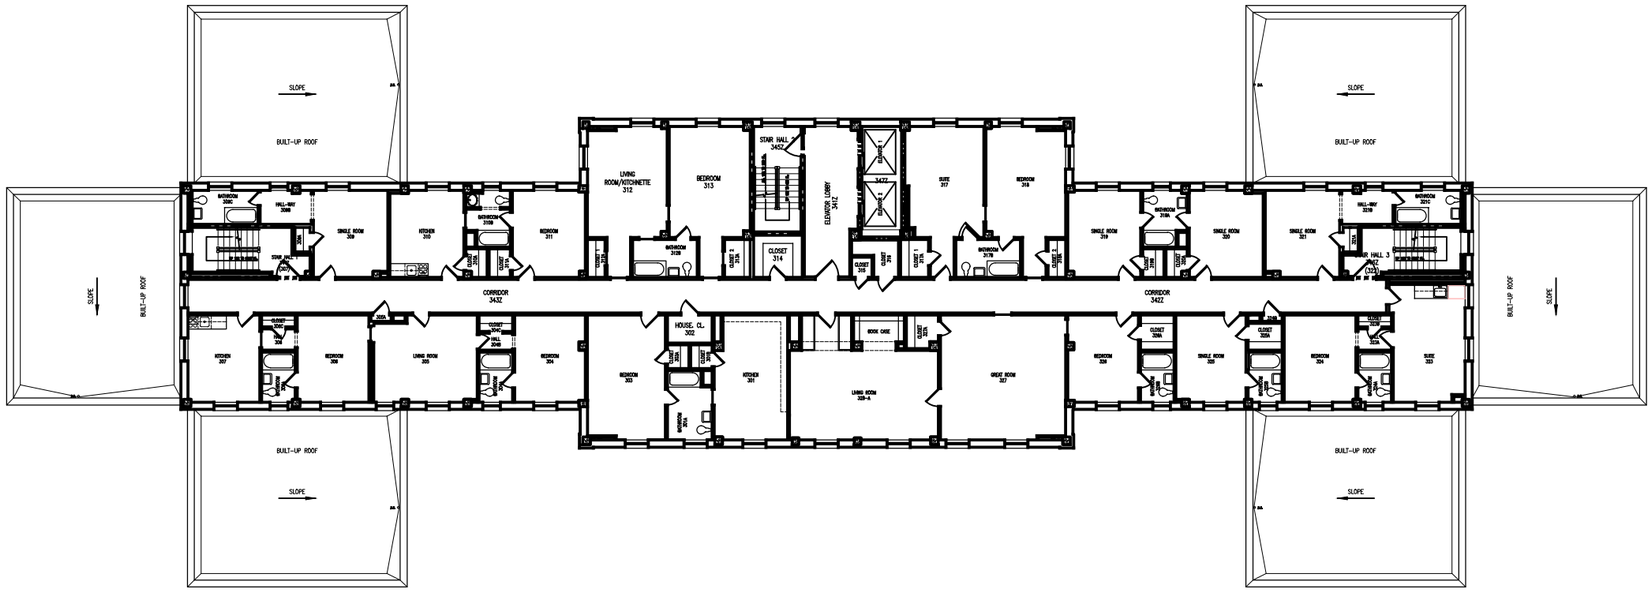

Space Occupancy Table

Building	Floor	Room	Area	Department	Division	Careline	Description
30	03	---	117.95 SF	UNASSIGNED SPACE	OTHER	Unassigned Space	ELEVATOR SHAFTS
30	03	301-A	228.67 SF	RESIDENTIAL QUARTERS	VACANT	SPACE BANK (VACANT)	KITCHEN
30	03	301A	81.67 SF	RESIDENTIAL QUARTERS	VACANT	SPACE BANK (VACANT)	BATHROOM
30	03	301B	13.42 SF	RESIDENTIAL QUARTERS	VACANT	SPACE BANK (VACANT)	CLOSET
30	03	302	31.50 SF	ENVIRONMENTAL MGT. SVC.	NON-CLINICAL	Environmental Mgt. Svc.	E.M.S. CLOSET
30	03	303	246.53 SF	RESIDENTIAL QUARTERS	VACANT	SPACE BANK (VACANT)	BEDROOM
30	03	303A	13.42 SF	RESIDENTIAL QUARTERS	VACANT	SPACE BANK (VACANT)	CLOSET
30	03	304	156.47 SF	RESIDENTIAL QUARTERS	OTHER	Tenant Space	BEDROOM
30	03	304B	15.11 SF	RESIDENTIAL QUARTERS	OTHER	Tenant Space	HALL
30	03	304C	14.67 SF	RESIDENTIAL QUARTERS	OTHER	Tenant Space	CLOSET
30	03	305	228.75 SF	RESIDENTIAL QUARTERS	OTHER	Tenant Space	LIVING ROOM
30	03	305A	46.67 SF	RESIDENTIAL QUARTERS	OTHER	Tenant Space	BATHROOM
30	03	305B	4.17 SF	RESIDENTIAL QUARTERS	OTHER	Tenant Space	F.A. CLOSET
30	03	306	158.86 SF	RESIDENTIAL QUARTERS	OTHER	Tenant Space	BEDROOM
30	03	306A	46.67 SF	RESIDENTIAL QUARTERS	OTHER	Tenant Space	BATHROOM
30	03	306B	18.67 SF	RESIDENTIAL QUARTERS	OTHER	Tenant Space	HALL
30	03	306C	11.11 SF	RESIDENTIAL QUARTERS	OTHER	Tenant Space	CLOSET
30	03	307	172.00 SF	RESIDENTIAL QUARTERS	OTHER	Tenant Space	KITCHEN
30	03	309	164.83 SF	RESIDENTIAL QUARTERS	OTHER	Tenant Space	SINGLE ROOM
30	03	309A	11.81 SF	RESIDENTIAL QUARTERS	OTHER	Tenant Space	CLOSET
30	03	309B	51.33 SF	RESIDENTIAL QUARTERS	OTHER	Tenant Space	HALL-WAY
30	03	309C	75.40 SF	RESIDENTIAL QUARTERS	OTHER	Tenant Space	BATHROOM
30	03	310	163.64 SF	RESIDENTIAL QUARTERS	OTHER	Tenant Space	KITCHEN
30	03	310A	16.04 SF	RESIDENTIAL QUARTERS	OTHER	Tenant Space	CLOSET
30	03	310B	68.25 SF	RESIDENTIAL QUARTERS	OTHER	Tenant Space	BATHROOM
30	03	311	161.25 SF	RESIDENTIAL QUARTERS	OTHER	Tenant Space	SINGLE ROOM
30	03	311A	16.04 SF	RESIDENTIAL QUARTERS	OTHER	Tenant Space	CLOSET
30	03	312	252.52 SF	RESIDENTIAL QUARTERS	VACANT	SPACE BANK (VACANT)	MISC./KITCHENETTE
30	03	312-E	17.75 SF	RESIDENTIAL QUARTERS	VACANT	SPACE BANK (VACANT)	CLOSET 1
30	03	312B	60.00 SF	RESIDENTIAL QUARTERS	VACANT	SPACE BANK (VACANT)	BATHROOM
30	03	313-E	248.45 SF	RESIDENTIAL QUARTERS	VACANT	SPACE BANK (VACANT)	BEDROOM
30	03	313-E	25.50 SF	RESIDENTIAL QUARTERS	VACANT	SPACE BANK (VACANT)	CLOSET 2
30	03	314	51.47 SF	RESIDENTIAL QUARTERS	OTHER	Tenant Space	CLOSET
30	03	315	11.11 SF	RESIDENTIAL QUARTERS	OTHER	Tenant Space	CLOSET
30	03	316	32.89 SF	RESIDENTIAL QUARTERS	OTHER	Tenant Space	CLOSET
30	03	317	242.48 SF	RESIDENTIAL QUARTERS	VACANT	SPACE BANK (VACANT)	MISC./KITCHENETTE
30	03	317A	27.00 SF	RESIDENTIAL QUARTERS	VACANT	SPACE BANK (VACANT)	CLOSET 1
30	03	317B	60.00 SF	RESIDENTIAL QUARTERS	VACANT	SPACE BANK (VACANT)	BATHROOM
30	03	318	252.52 SF	RESIDENTIAL QUARTERS	VACANT	SPACE BANK (VACANT)	BEDROOM
30	03	318A	17.75 SF	RESIDENTIAL QUARTERS	VACANT	SPACE BANK (VACANT)	CLOSET 2
30	03	319	161.25 SF	RESIDENTIAL QUARTERS	OTHER	Tenant Space	SIGLE ROOM
30	03	319A	68.25 SF	RESIDENTIAL QUARTERS	OTHER	Tenant Space	BATHROOM
30	03	319B	16.04 SF	RESIDENTIAL QUARTERS	OTHER	Tenant Space	CLOSET
30	03	320	163.64 SF	RESIDENTIAL QUARTERS	OTHER	Tenant Space	SINGLE ROOM
30	03	320A	16.04 SF	RESIDENTIAL QUARTERS	OTHER	Tenant Space	CLOSET
30	03	321	166.03 SF	RESIDENTIAL QUARTERS	OTHER	Tenant Space	SINGLE ROOM
30	03	321A	11.46 SF	RESIDENTIAL QUARTERS	OTHER	Tenant Space	CLOSET
30	03	321B	50.80 SF	RESIDENTIAL QUARTERS	OTHER	Tenant Space	HALL-WAY
30	03	321C	75.40 SF	RESIDENTIAL QUARTERS	OTHER	Tenant Space	BATHROOM
30	03	323	240.00 SF	RESIDENTIAL QUARTERS	VACANT	SPACE BANK (VACANT)	MISC./KITCHENETTE
30	03	323A	18.67 SF	RESIDENTIAL QUARTERS	VACANT	SPACE BANK (VACANT)	HALL
30	03	323B	11.11 SF	RESIDENTIAL QUARTERS	VACANT	SPACE BANK (VACANT)	CLOSET
30	03	324	158.86 SF	RESIDENTIAL QUARTERS	VACANT	SPACE BANK (VACANT)	BEDROOM
30	03	324A	46.67 SF	RESIDENTIAL QUARTERS	VACANT	SPACE BANK (VACANT)	BATHROOM
30	03	324B	3.43 SF	RESIDENTIAL QUARTERS	OTHER	Tenant Space	F.A. CLOSET
30	03	325	155.28 SF	RESIDENTIAL QUARTERS	OTHER	Tenant Space	SINGLE ROOM
30	03	325A	26.81 SF	RESIDENTIAL QUARTERS	OTHER	Tenant Space	CLOSET
30	03	325B	47.40 SF	RESIDENTIAL QUARTERS	OTHER	Tenant Space	BATHROOM
30	03	326	156.47 SF	RESIDENTIAL QUARTERS	OTHER	Tenant Space	BEDROOM
30	03	326A	29.78 SF	RESIDENTIAL QUARTERS	OTHER	Tenant Space	CLOSET
30	03	326B	46.67 SF	RESIDENTIAL QUARTERS	OTHER	Tenant Space	BATHROOM
30	03	327	388.20 SF	RESIDENTIAL QUARTERS	VACANT	SPACE BANK (VACANT)	GREAT ROOM
30	03	327A	27.33 SF	RESIDENTIAL QUARTERS	VACANT	SPACE BANK (VACANT)	CLOSET
30	03	328	426.00 SF	RESIDENTIAL QUARTERS	VACANT	SPACE BANK (VACANT)	GREAT ROOM
30	03	341Z	196.29 SF	RESIDENTIAL QUARTERS	OTHER	Tenant Space	ELEVATOR LOBBY
30	03	342Z	449.22 SF	RESIDENTIAL QUARTERS	OTHER	Tenant Space	CORRIDOR
30	03	343Z	517.44 SF	RESIDENTIAL QUARTERS	OTHER	Tenant Space	CORRIDOR
30	03	344Z	144.55 SF	RESIDENTIAL QUARTERS	OTHER	Tenant Space	STAIR HALL 1
30	03	345Z	130.90 SF	RESIDENTIAL QUARTERS	OTHER	Tenant Space	STAIR HALL 2
30	03	346Z	144.24 SF	RESIDENTIAL QUARTERS	OTHER	Tenant Space	STAIR HALL 3
			7726.52 SF				

1 HR FIRE RATED BARRIER

2 HR FIRE RATED BARRIER

three inches = one foot 5
one and one half inches = one foot 1
one inch = one foot 0
three quarters inch = one foot 2
one half inch = one foot 4
three eighths inch = one foot 4
one quarter inch = one foot 8
one eighth inch = one foot 16

Careline Updates	01-28-2008
Plan Updates	01-18-2008
Title Block and Color Table Modifications	01-17-2008
As-Built (Indus Systems)	10-29-2004
Revisions	Date

CONSULTANTS:

Indus Systems, Inc.
2353, Main Street, Concord MA 01742
Tel: 978-461-0555
www.indus-systems.com

ARCHITECT/ENGINEERS:

NORTH:

Drawing Title: Architectural Plan THIRD FLOOR Scale: 1/8" = 1'-0"

Project Title: As-Built

Project Number: -

Building(s) Number: 30

Drawing Number: A-04

DWG. 4 OF 7

Approved Director

Approved Chief of Engineering

Location: Monrose, New York

Date: 02-26-2009

Checked

Drawn: AMI

Office of Facilities Management

VA FORM 08-6231, OCT 1978