


# WEST VIRGINIA NATIONAL CEMETERY

*Map of Slope / Drainage  
Problem Areas*

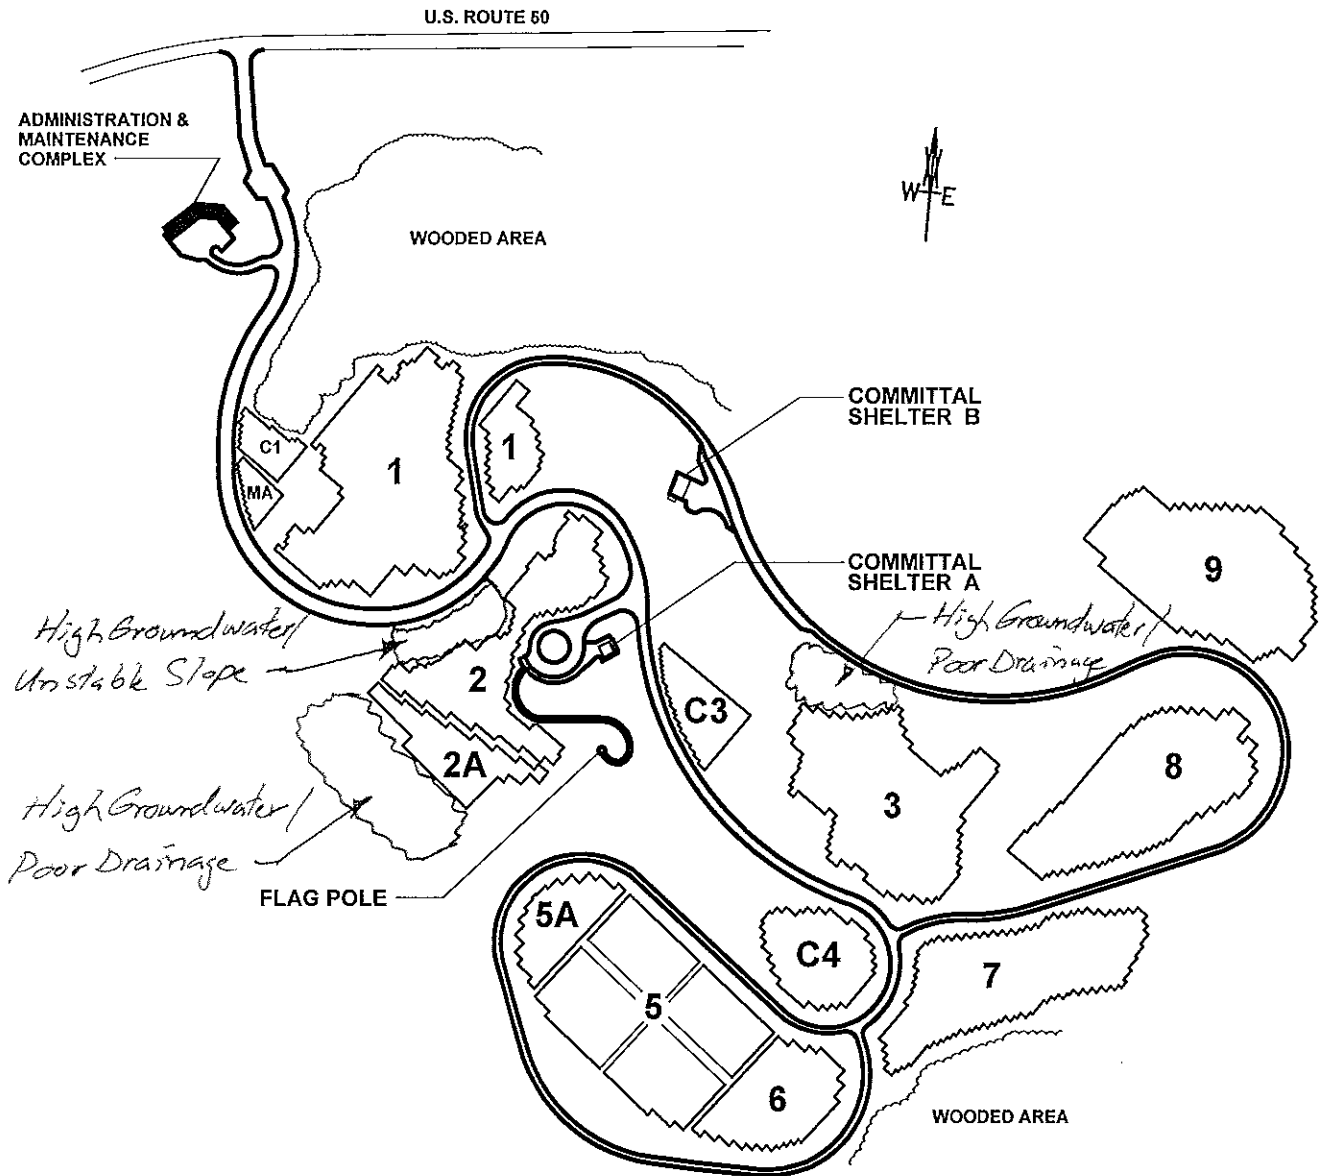

*Attachment A*