


Approx 1" = 6'

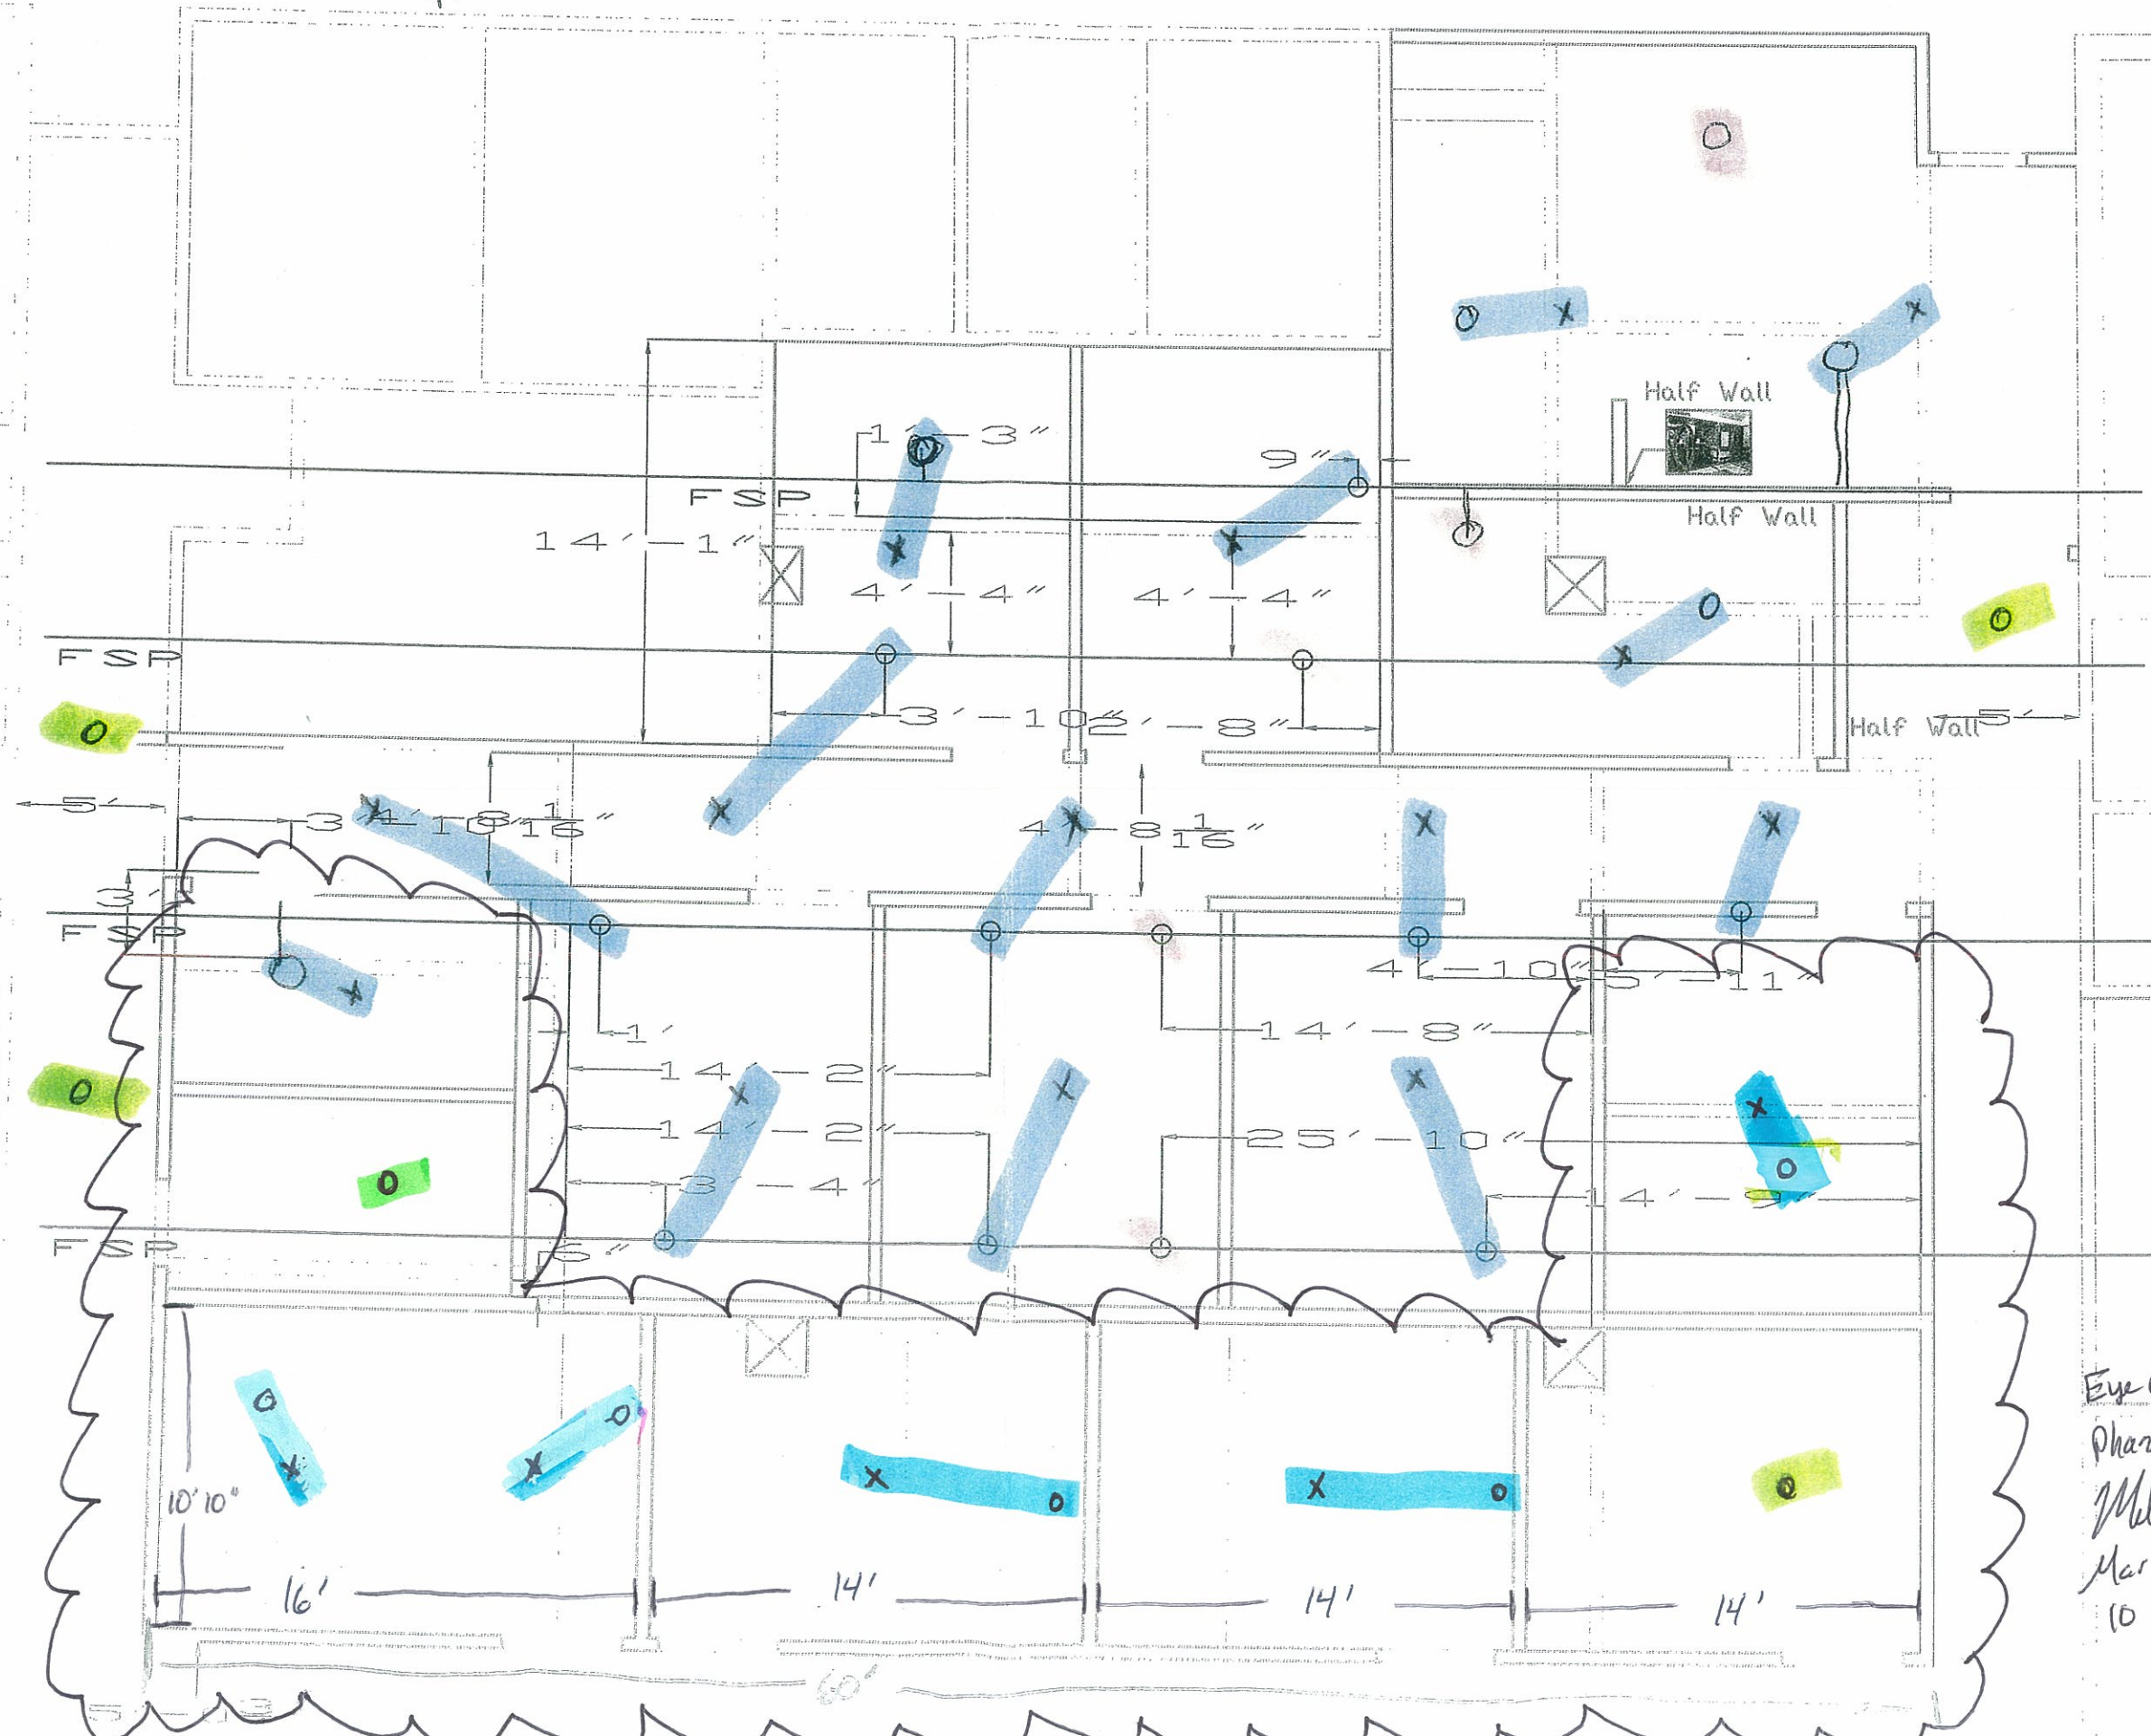

Area of Work

Remain  
Move to X  
Cap off

Eye Clinic  
Phase III  
Mike  
Mark Fienhold  
10 Oct 14