


Repair Emergency Department Entrance, Building 200

Date: 3/5/2015


Not Construction Documents

Project # 578-15-023

Overview Plan

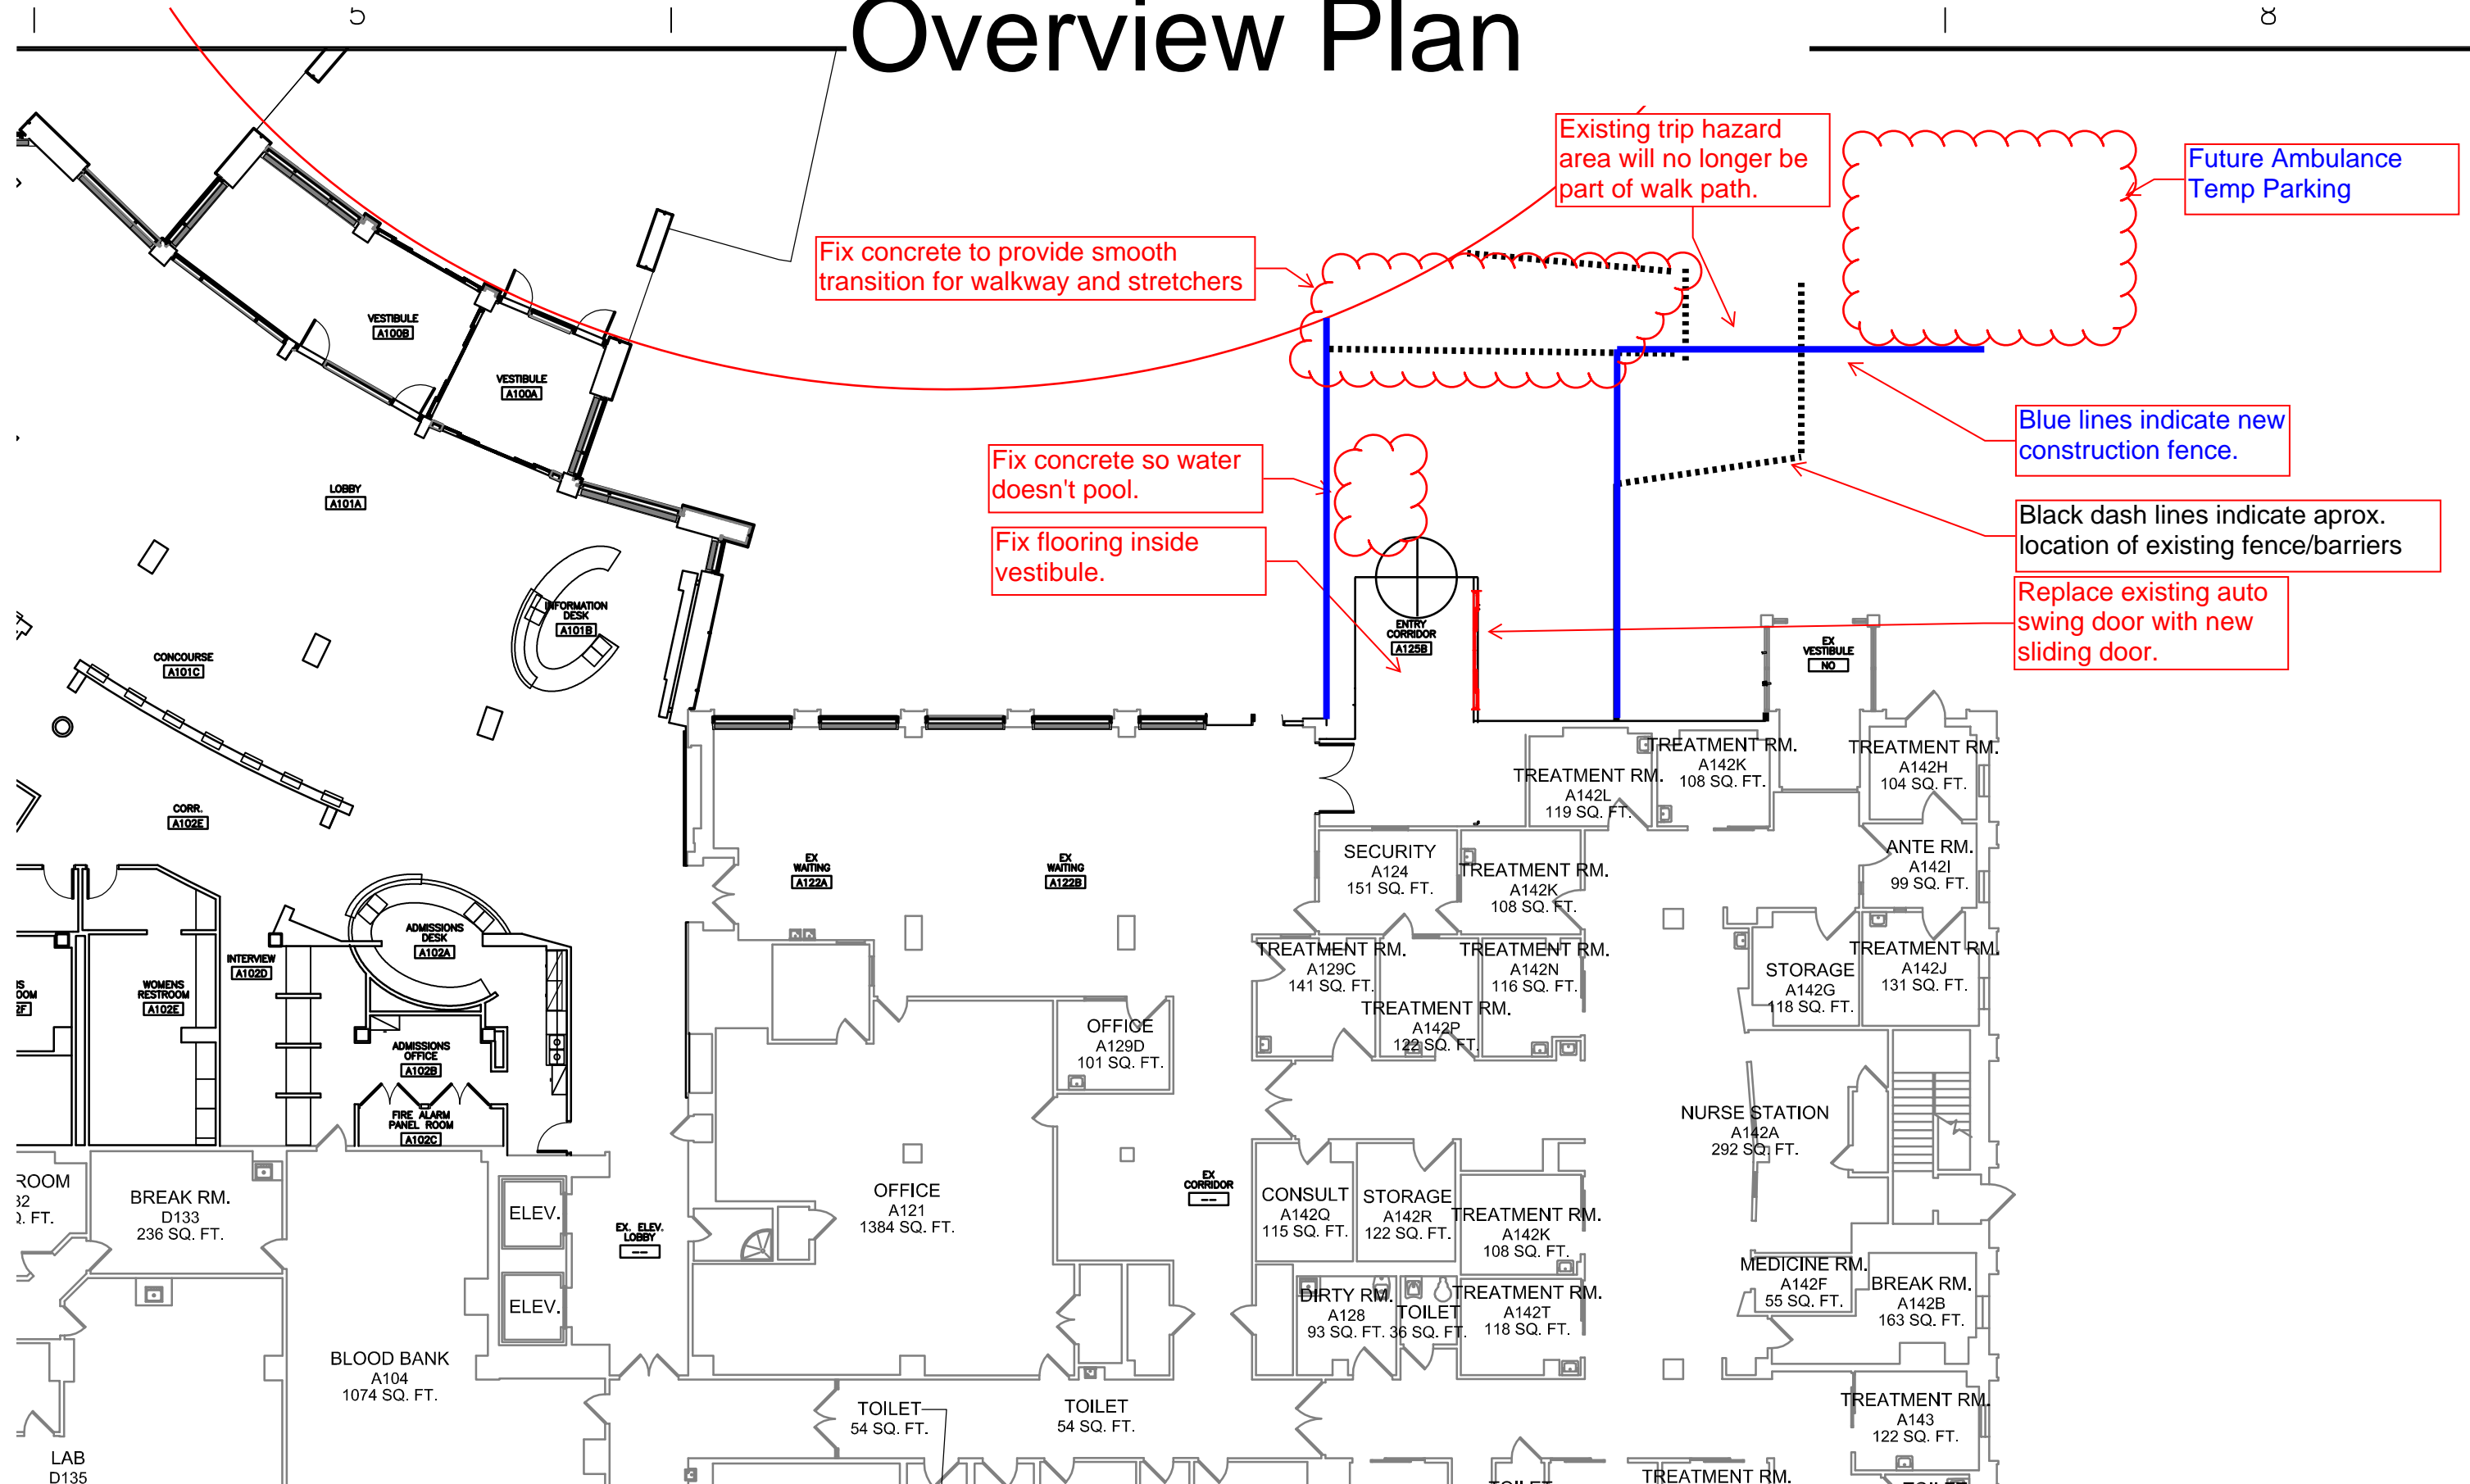


Phase 1 Install New Sliding Door

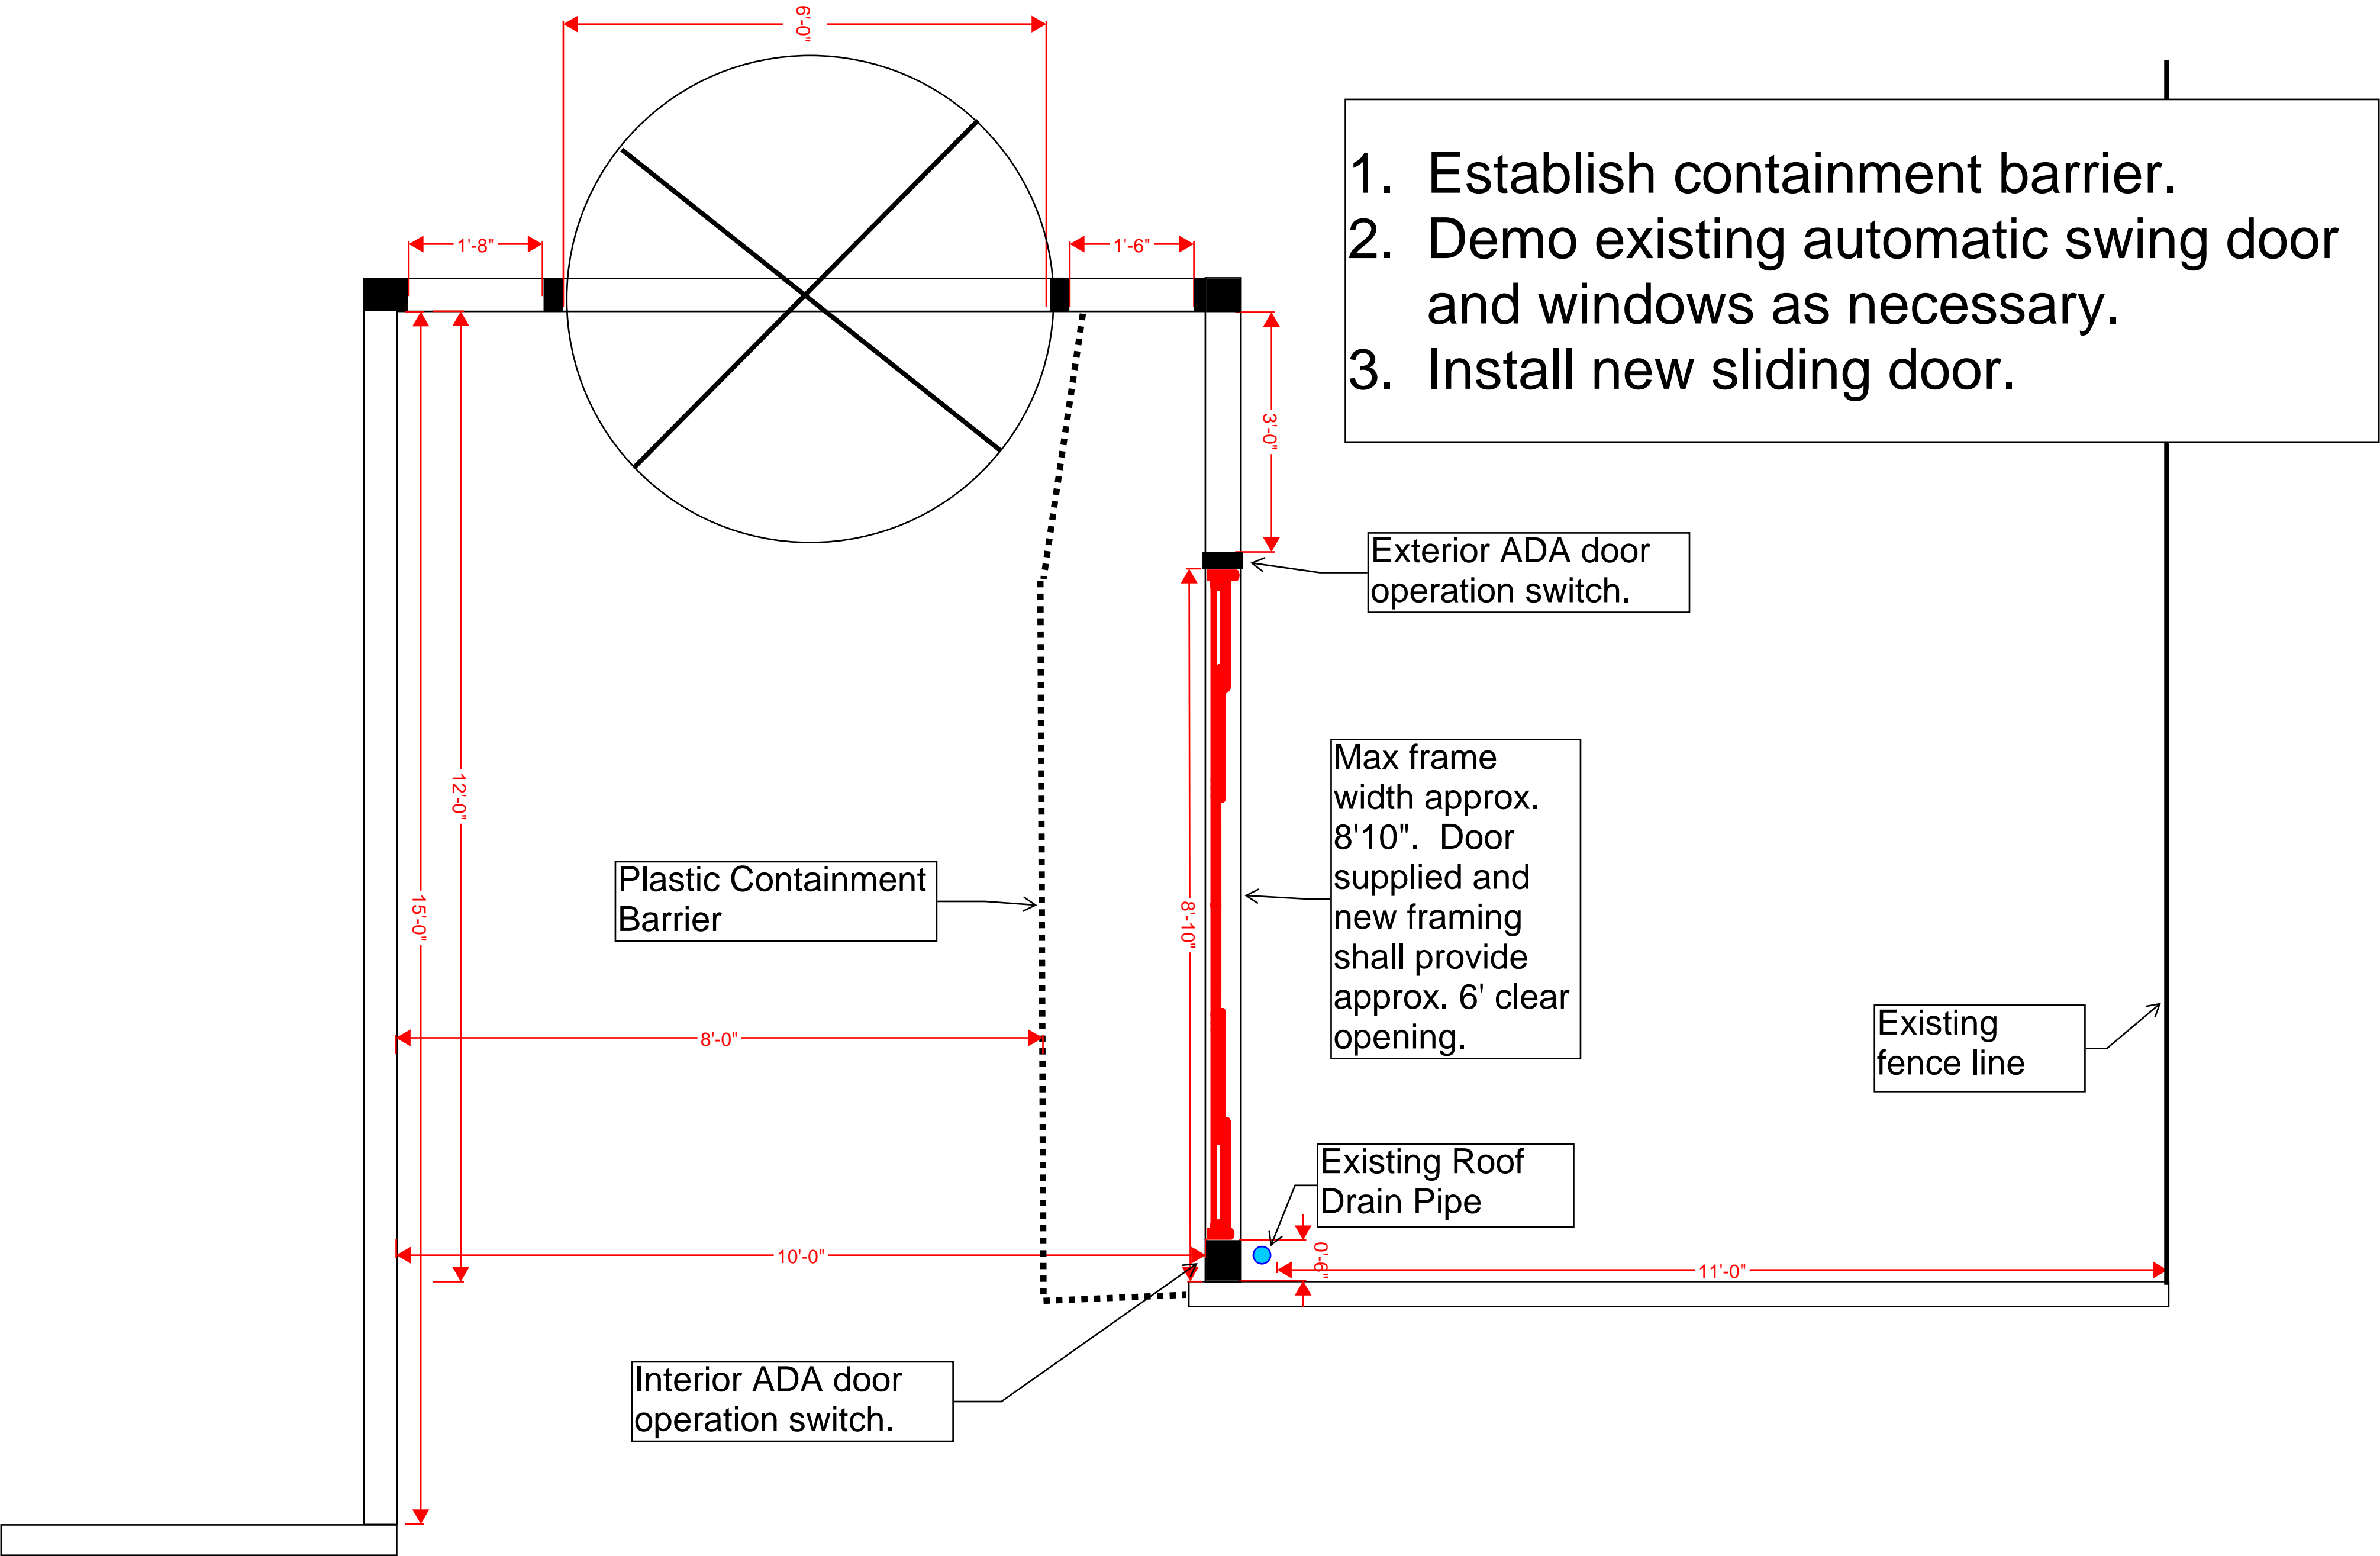

Drawing Title: Phase 1 Replace Swing Door with Automatic Sliding

Dimensions are for bidding purposes only. All dimensions need to be field verified. These are not construction documents


Phase 2 Repair Flooring

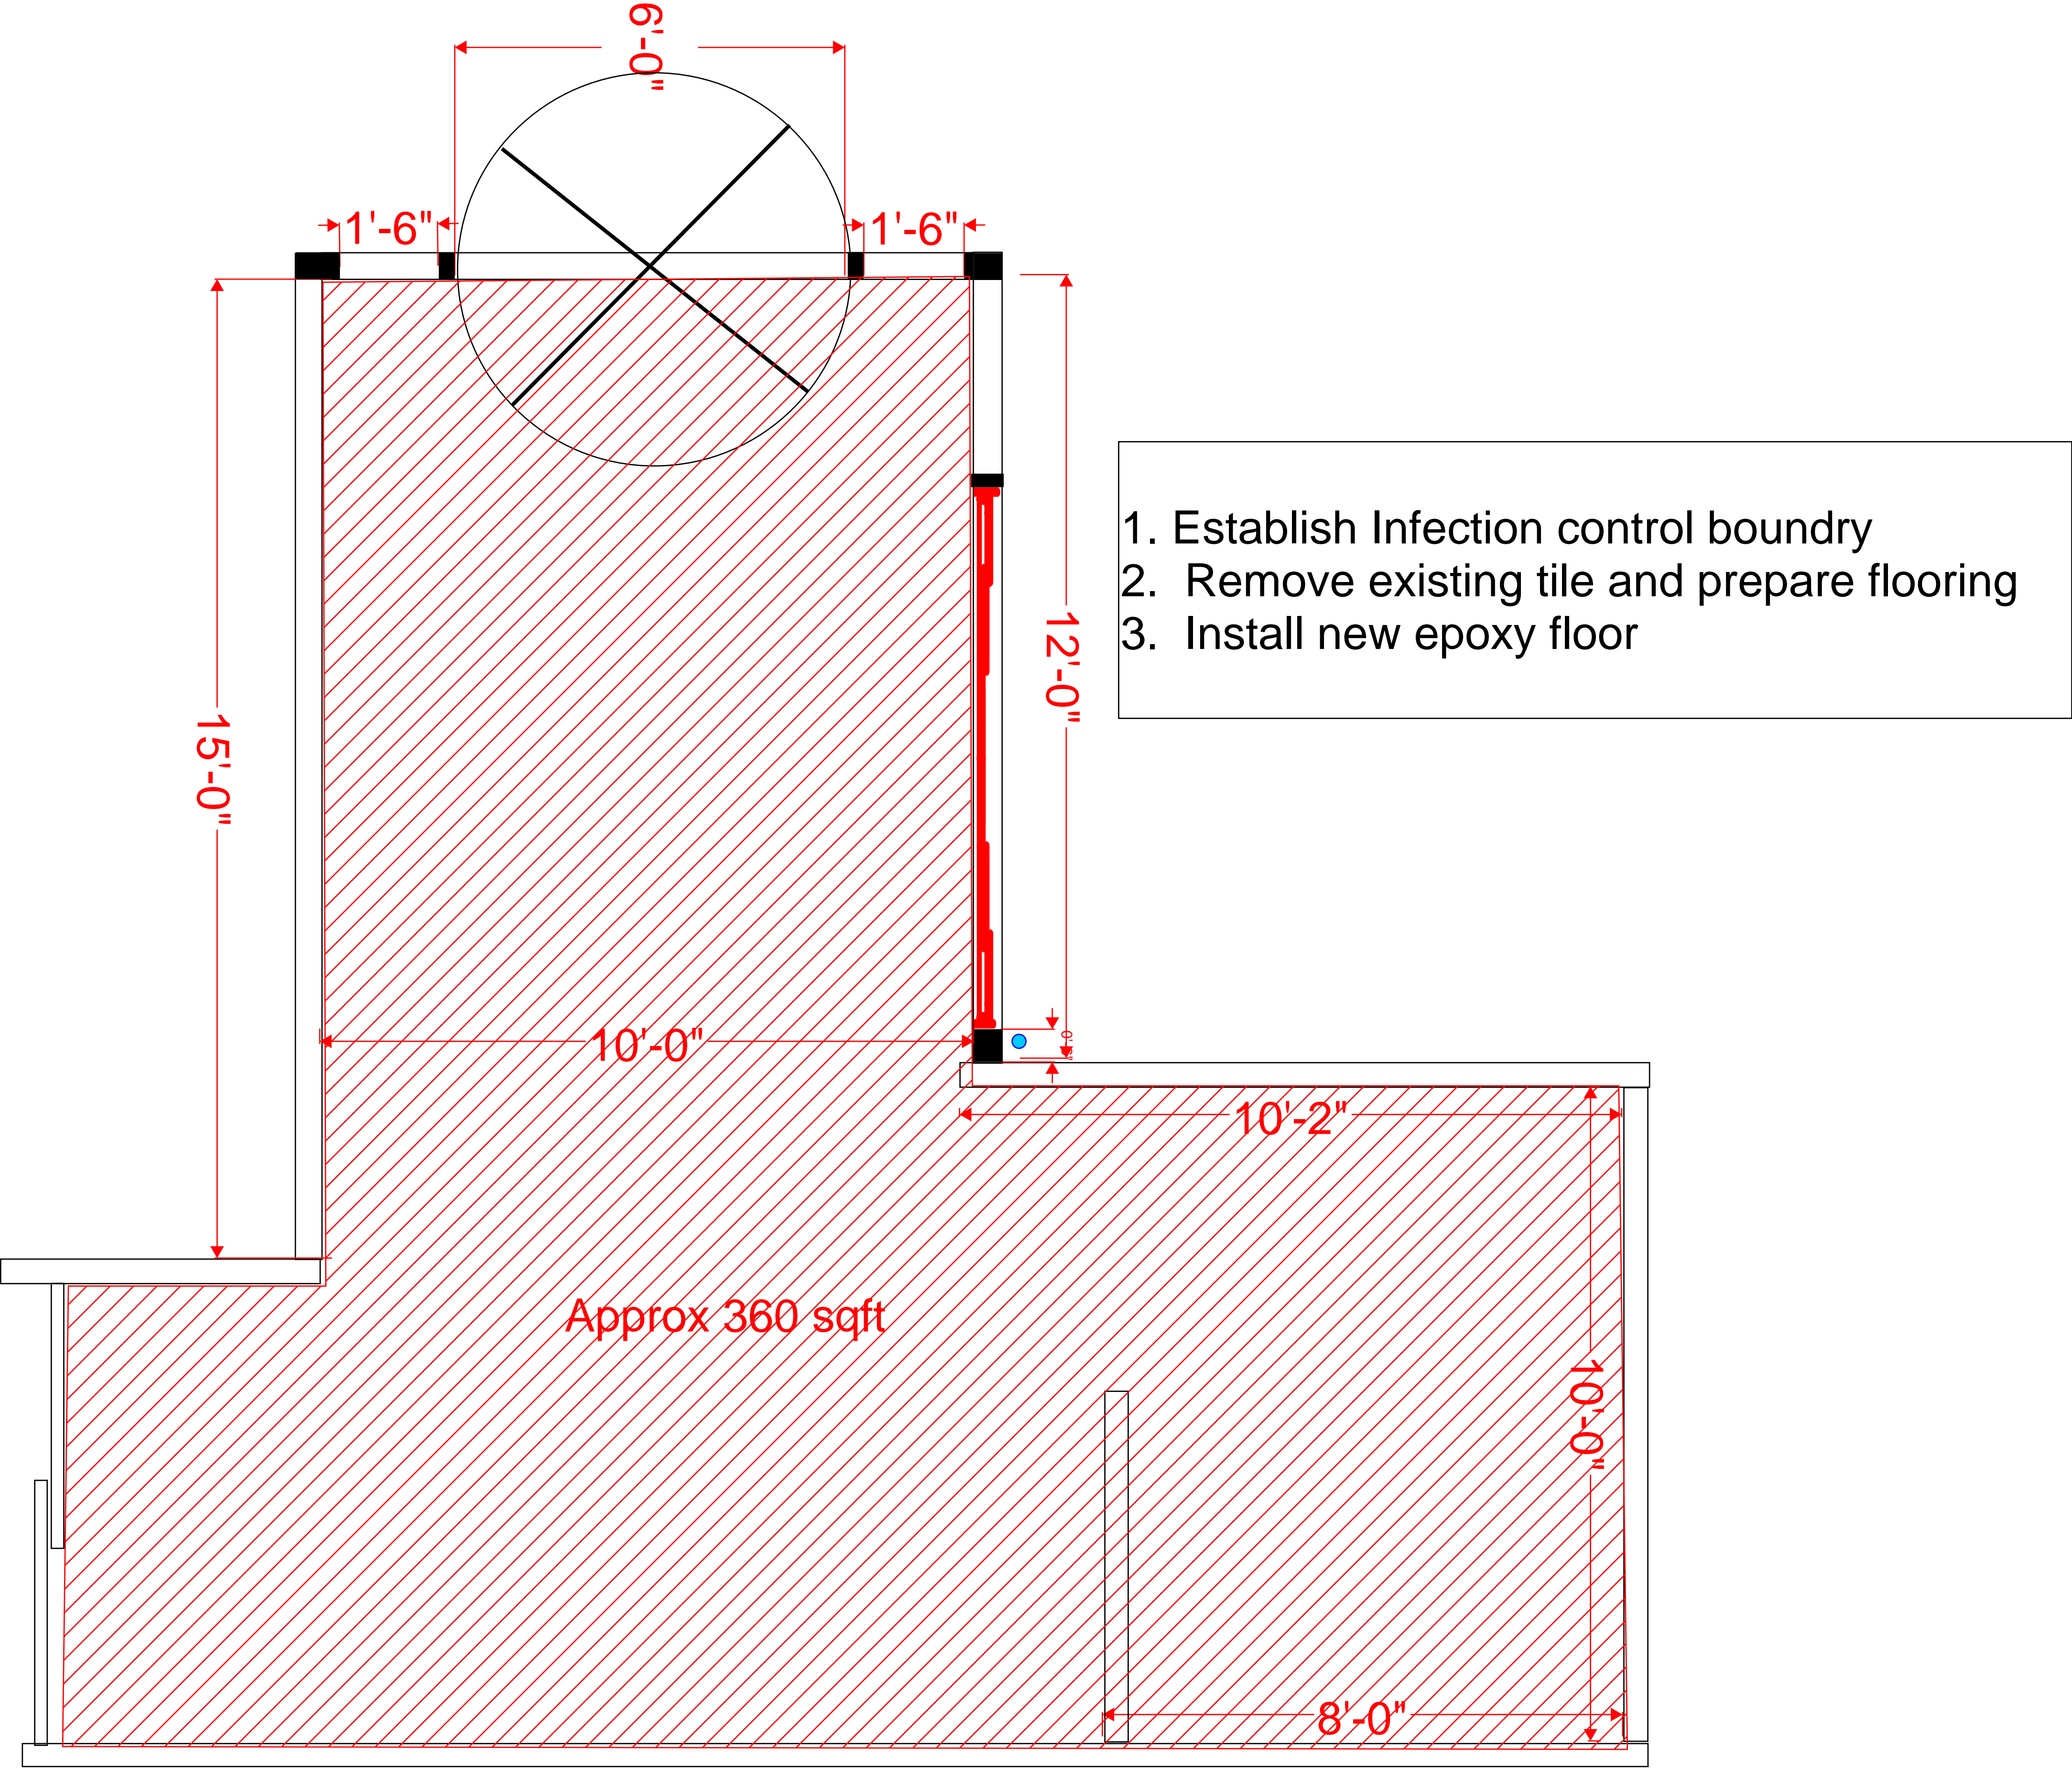

Drawing Title: Phase 2 Repair
Flooring

Dimensions are for bidding
purposes only. All dimensions
need to be field verified. These
are not construction documents

Existing Elevation View

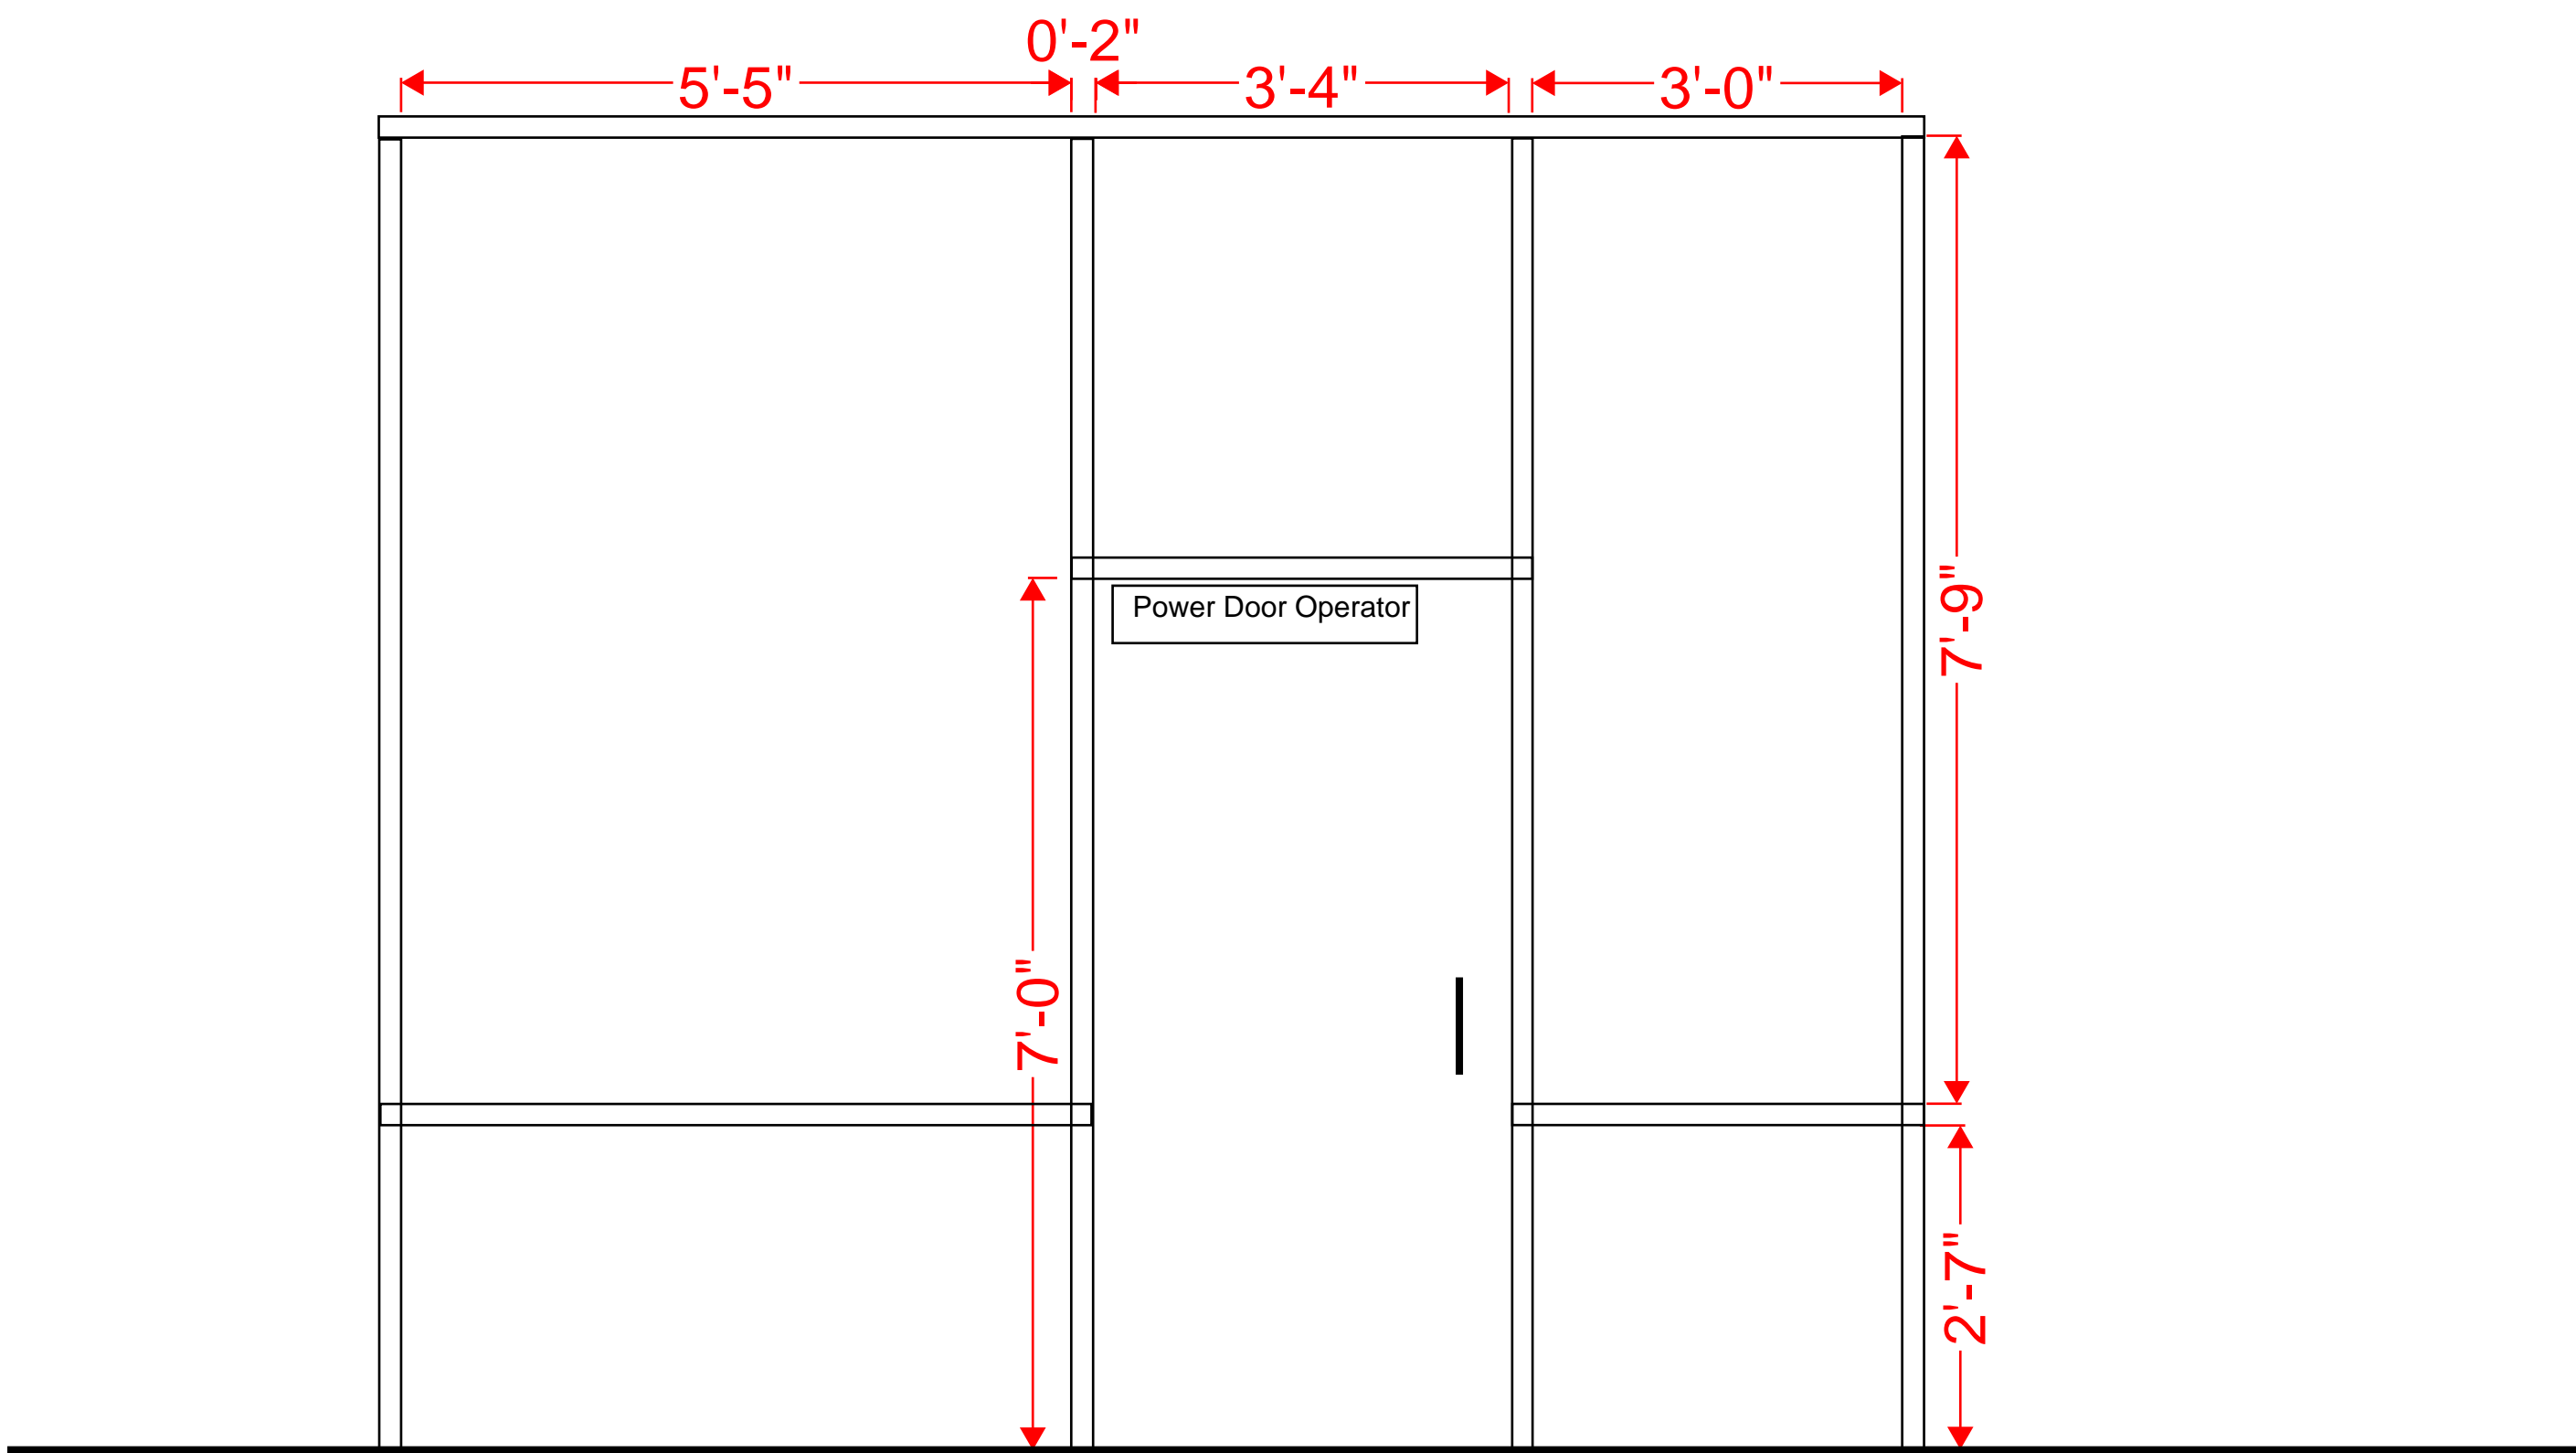

Drawing Title: Existing
Exterior
Elevation

Dimensions are for bidding purposes only.
All dimensions need to be field verified.
These are not construction documents

