


three inches = one foot
one and one half inches = one foot
three quarters inch = one foot
one half inch = one foot
three eighths inch = one foot
one quarter inch = one foot
one eighth inch = one foot
one eighth inch = one foot

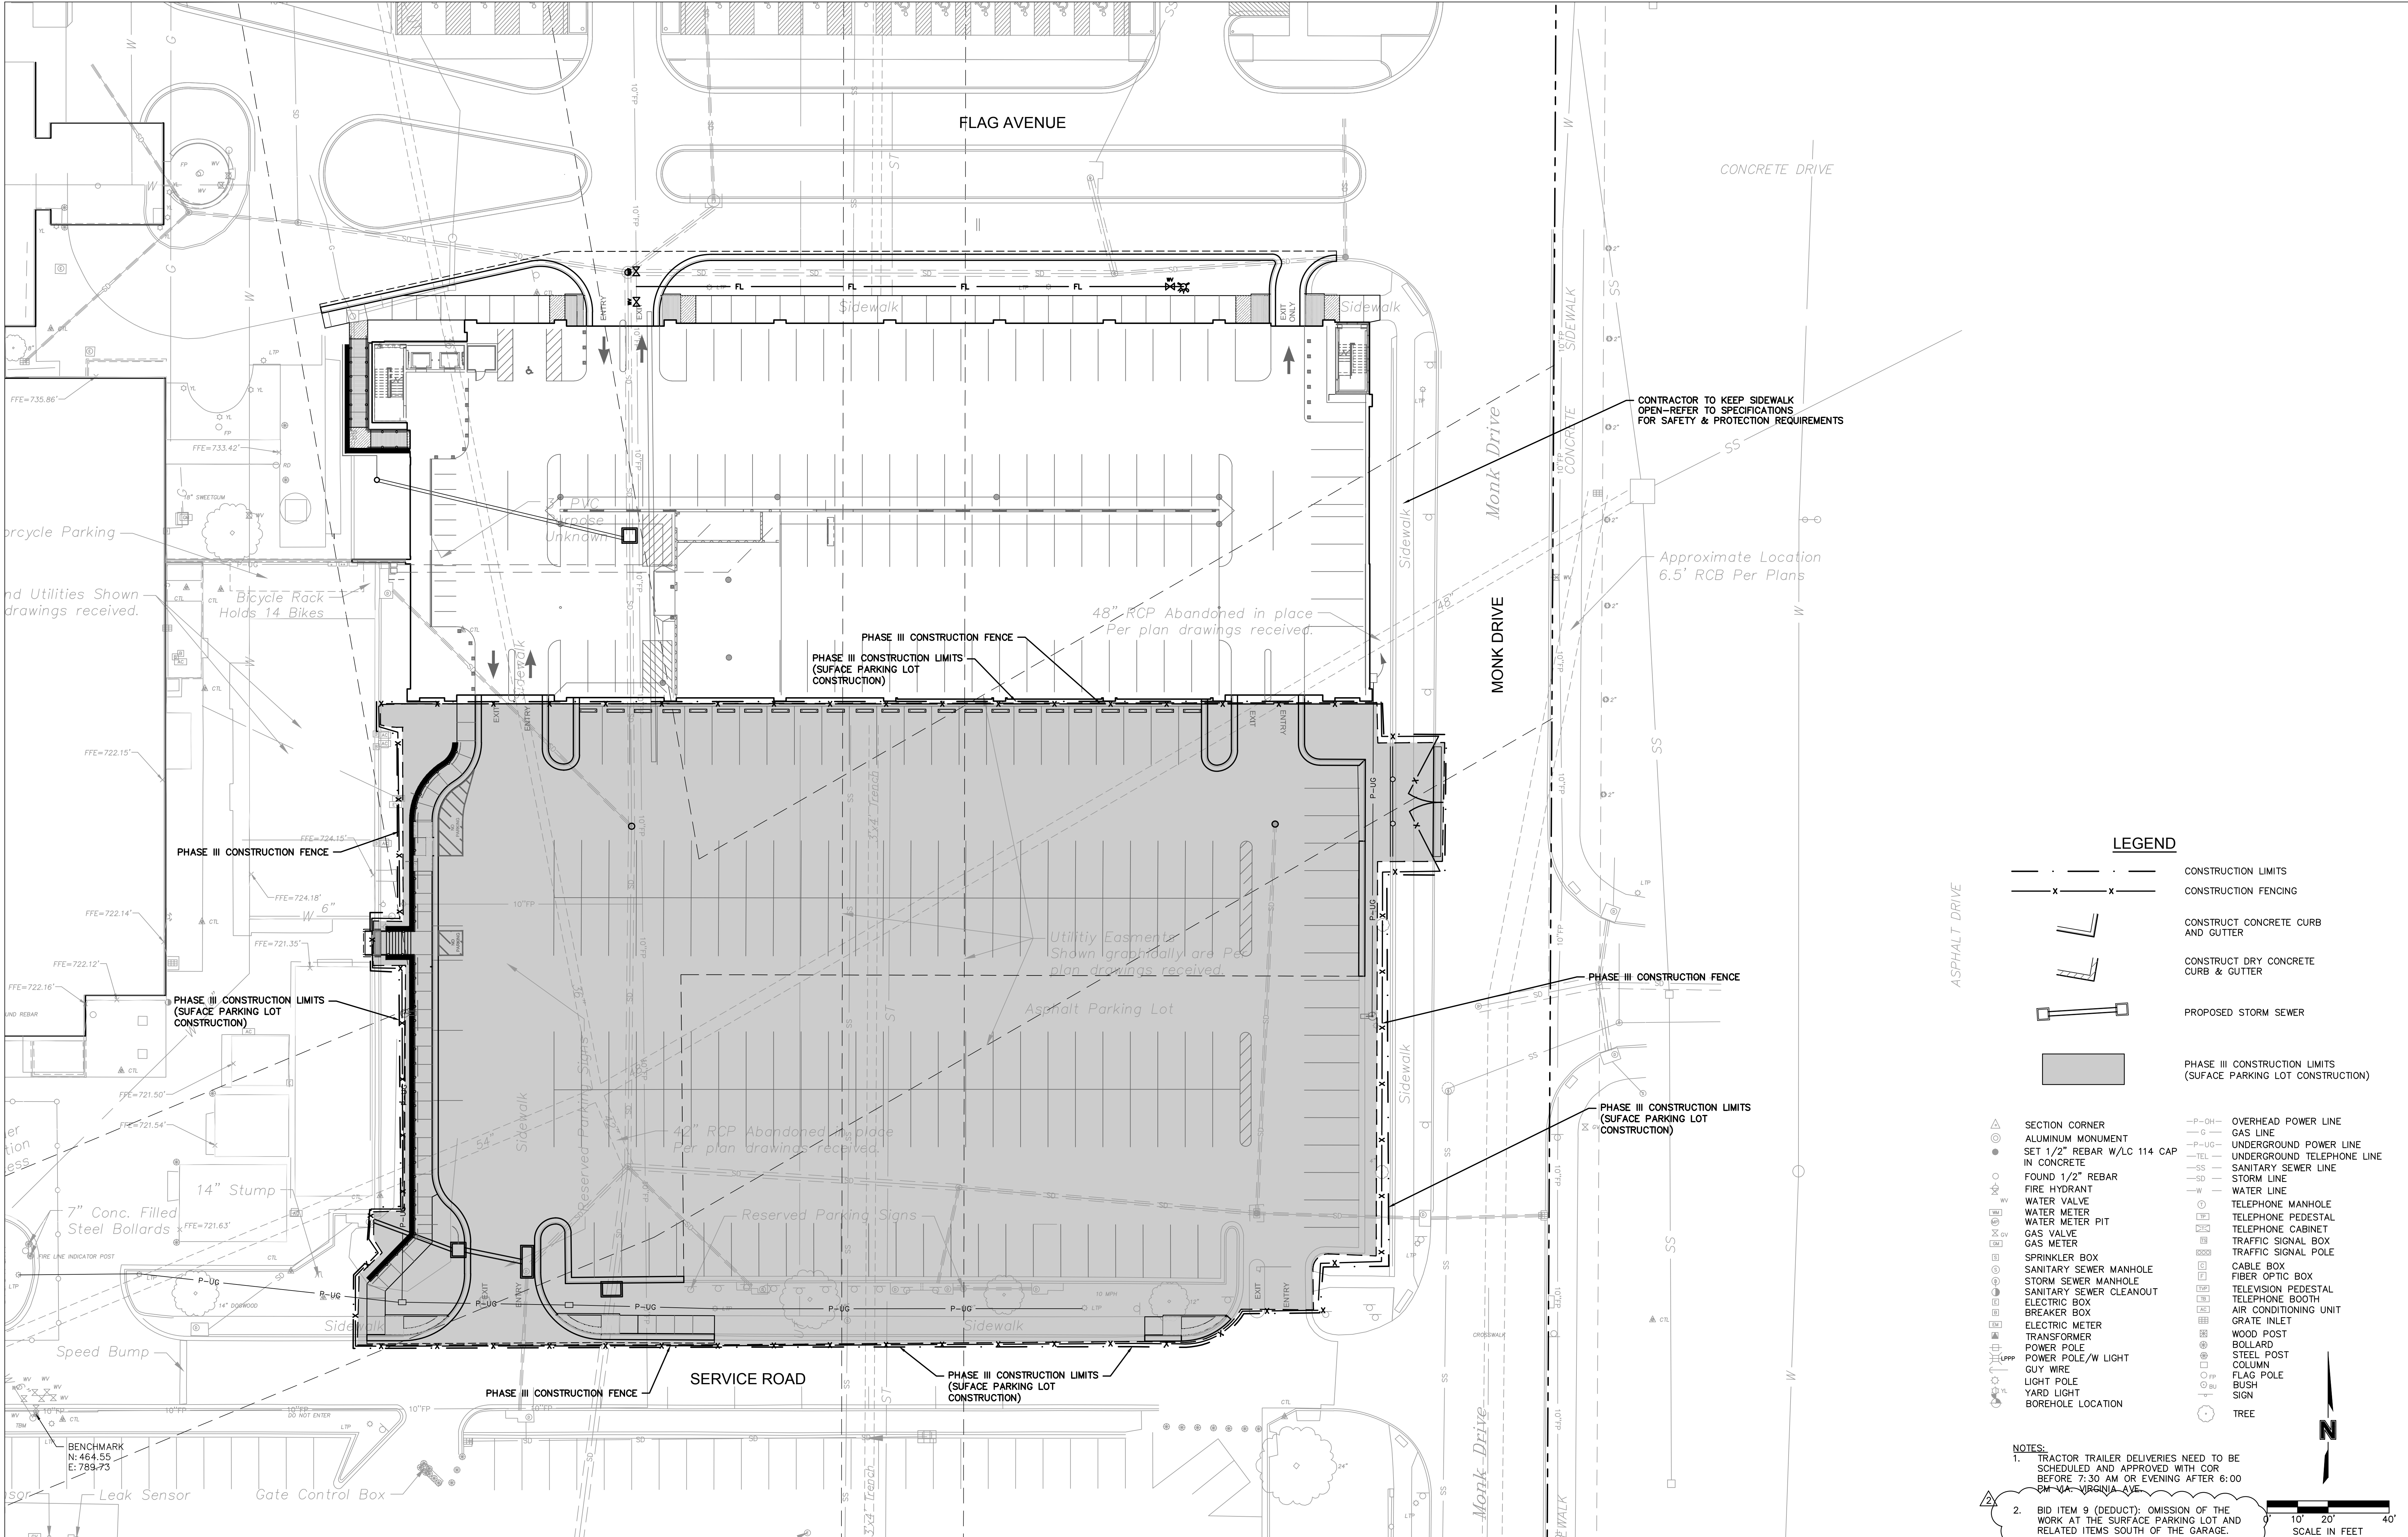

- LEGEND**
- CONSTRUCTION LIMITS
 - CONSTRUCTION FENCING
 - CONSTRUCT CONCRETE CURB AND GUTTER
 - CONSTRUCT DRY CONCRETE CURB & GUTTER
 - PROPOSED STORM SEWER
 - PHASE III CONSTRUCTION LIMITS (SURFACE PARKING LOT CONSTRUCTION)
- SECTION CORNER**
- ALUMINUM MONUMENT
 - SET 1/2" REBAR W/LC 114 CAP IN CONCRETE
 - FOUND 1/2" REBAR
 - FIRE HYDRANT
 - WATER VALVE
 - WATER METER
 - WATER METER PIT
 - GAS VALVE
 - GAS METER
 - SPRINKLER BOX
 - SANITARY SEWER MANHOLE
 - STORM SEWER MANHOLE
 - SANITARY SEWER CLEANOUT
 - ELECTRIC BOX
 - BREAKER BOX
 - ELECTRIC METER
 - TRANSFORMER
 - POWER POLE
 - POWER POLE/W LIGHT
 - GUY WIRE
 - LIGHT POLE
 - YARD LIGHT
 - BOREHOLE LOCATION
- OVERHEAD POWER LINE**
- GAS LINE
 - UNDERGROUND POWER LINE
 - UNDERGROUND TELEPHONE LINE
 - SANITARY SEWER LINE
 - STORM LINE
 - WATER LINE
- TELEPHONE MANHOLE**
- TELEPHONE PEDESTAL
 - TELEPHONE CABINET
 - TRAFFIC SIGNAL BOX
 - TRAFFIC SIGNAL POLE
 - CABLE BOX
 - FIBER OPTIC BOX
 - TELEVISION PEDESTAL
 - TELEPHONE BOOTH
 - AIR-CONDITIONING UNIT
 - GRATE INLET
 - WOOD POST
 - BOLLARD
 - STEEL POST
 - COLUMN
 - FLAG POLE
 - BUSH
 - SIGN
 - TREE

NOTES:

- TRACTOR TRAILER DELIVERIES NEED TO BE SCHEDULED AND APPROVED WITH COR BEFORE 7:30 AM OR EVENING AFTER 6:00 PM VIA VIRGINIA AVE
- BID ITEM 9 (DEDUCT): OMISSION OF THE WORK AT THE SURFACE PARKING LOT AND RELATED ITEMS SOUTH OF THE GARAGE.

CONSULTANTS:		OFFEROR:		ARCHITECT/ENGINEERS:		Drawing Title		Project Title		Project Number		Office of Construction and Facilities Management Department of Veterans Affairs
						PHASE III PLAN		CONSTRUCT PARKING STRUCTURE		589-332		
						Approved: Project Director		Location Columbia, Missouri		Building Number		
AMENDMENT 2 Revisions:								Date 03/18/15		Checked TD		
										Drawn SMP		CS-105

