

CAR COUNT						
9'-0" 90° STANDARD SPACE						
LEVEL	STANDARD	COMPACT	CAR ACCESSIBLE	VAN ACCESSIBLE	MOTORCYCLE	TOTAL
P1	89	0	0	1	10	100
P2	109	0	6	2	0	117
P3	109	0	6	2	0	117
P4	111	0	7	2	0	118
P5	98	0	0	0	0	98
	516	0	19	5	10	550*

* INCLUDES MOTORCYCLE STALLS


PARKING EFFICIENCY - OVERALL			
LEVEL	AREA	TOTAL SPACES	EFFICIENCY
LEVEL P1	35,282 SF	89	396
LEVEL P2	37,397 SF	117	320
LEVEL P3	37,396 SF	117	320
LEVEL P4	37,395 SF	118	317
LEVEL P5	30,866 SF	98	315

BID ITEM (DEDUCT) CAR COUNT						
9'-0" 90° STANDARD SPACE						
LEVEL	STANDARD	COMPACT	CAR ACCESSIBLE	VAN ACCESSIBLE	MOTORCYCLE	TOTAL
P1	89	0	0	1	10	100
P2	109	0	6	2	0	117
P3	109	0	6	2	0	117
P4	98	0	0	0	0	98
	405	0	12	5	10	432

BID ITEM (DEDUCT) PARKING EFFICIENCY - OVERALL			
LEVEL	AREA	TOTAL SPACES	EFFICIENCY
LEVEL P1	35,282 SF	89	396
LEVEL P2	37,397 SF	117	320
LEVEL P3	37,396 SF	117	320
LEVEL P4	30,866 SF	98	315


SIGN MARK: SEE SIGN SCHEDULE ON SHEET AG-601
FACE OF SIGN

NOTES:
1. TYPICAL ALL LEVELS.

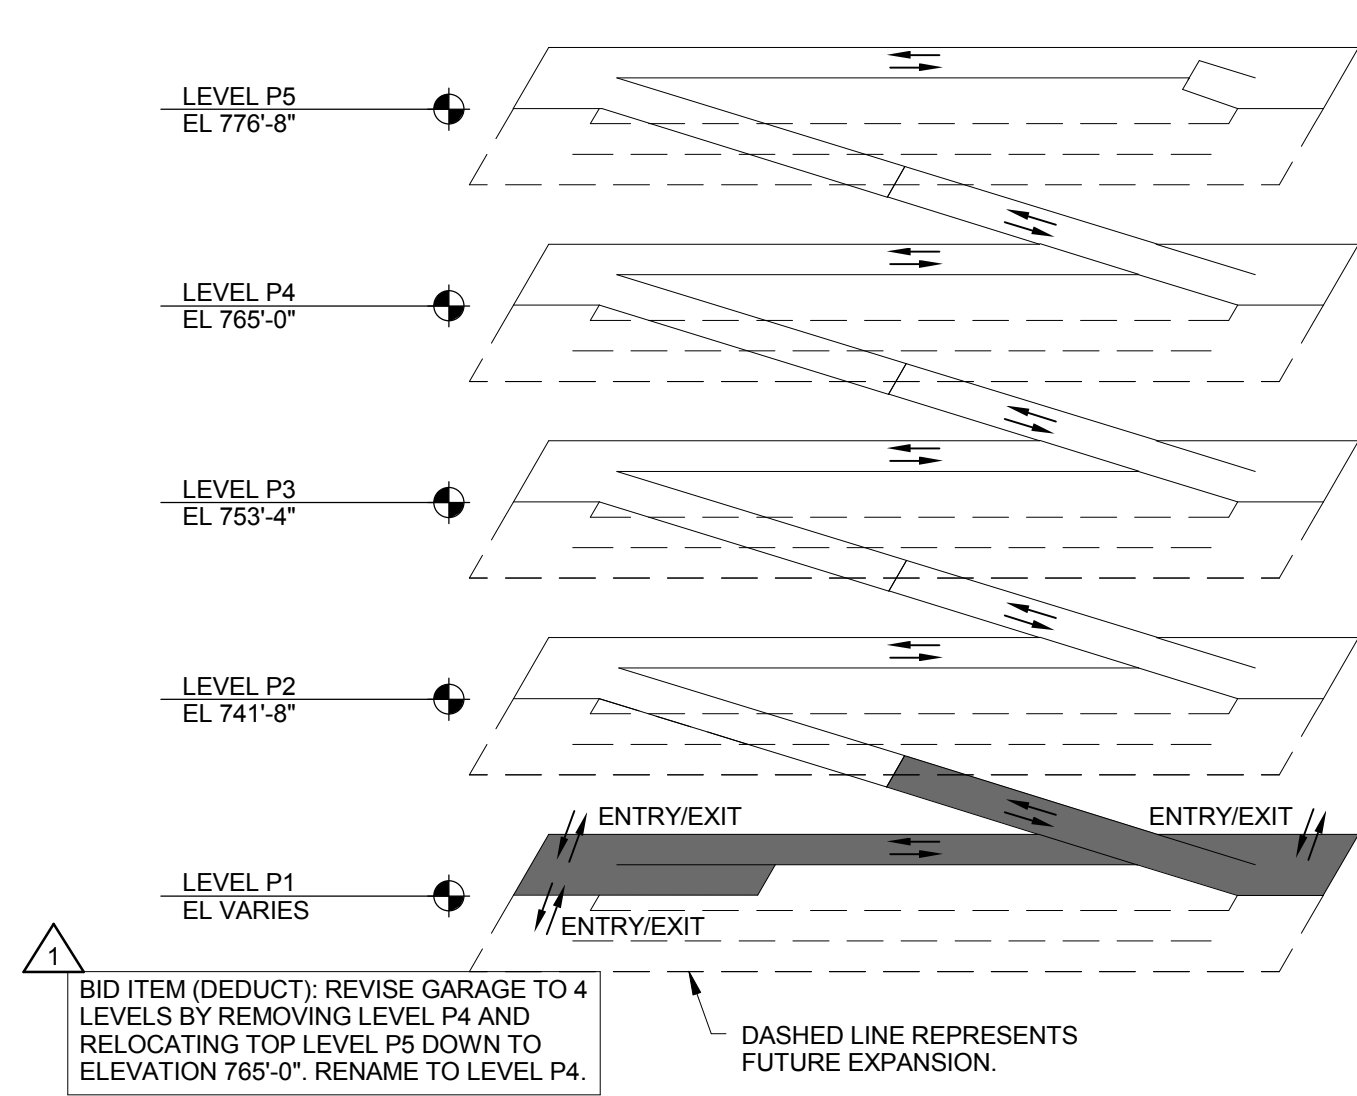


B6 SIGN KEY

ISOMETRIC - LEVEL P1

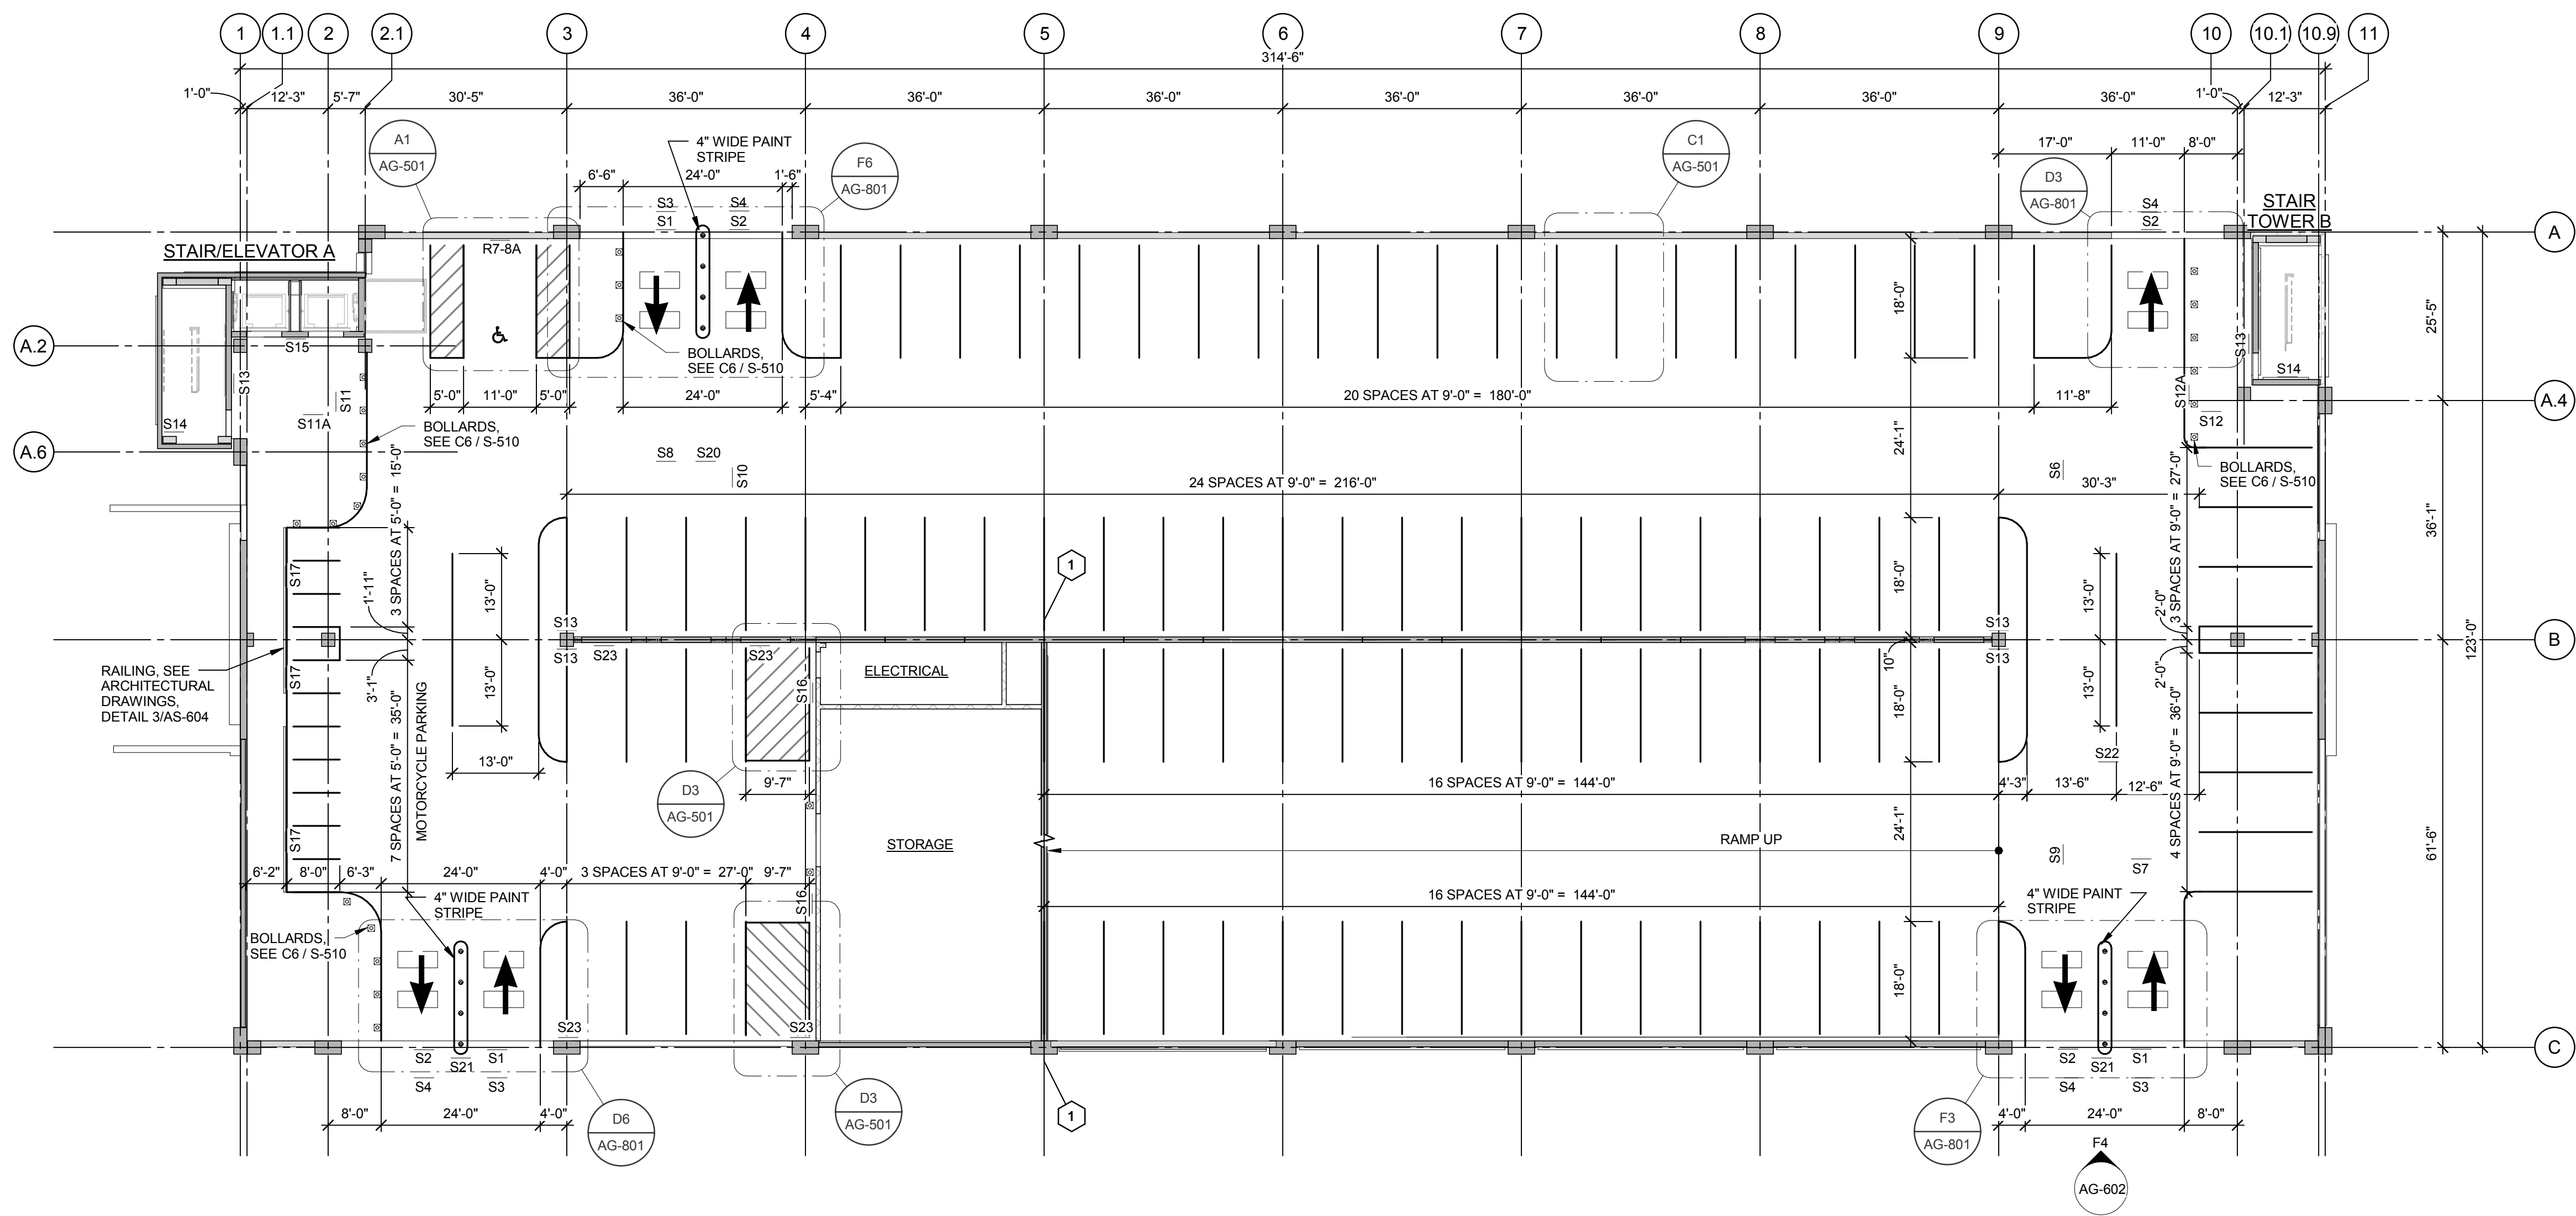

F1 LEVEL P1 PLAN


1/16" = 1'-0"

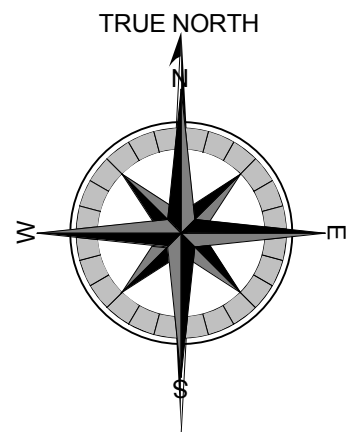

AMENDMENT 2	04/07/2015
AMENDMENT 1	03/18/2015
Revisions:	Date

CONSULTANTS:

OFFEROR:

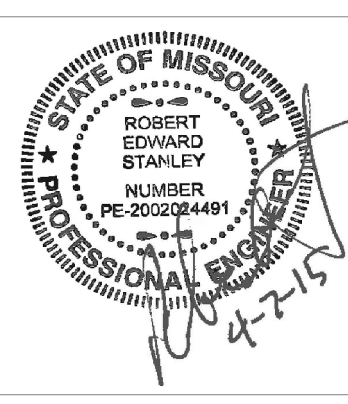

ARCHITECT/ENGINEERS:



Drawing Title

LEVEL P1 PLAN

Approved: Project Director

Project Title
CONSTRUCT PARKING STRUCTURE

Location
Columbia, Missouri

Date
03/18/2015

Checked
RES

Drawn
KMM

Project Number
589-332

Building Number
-

Drawing Number
AG-101

Dwg. of --

Office of
Construction
and Facilities
Management

