


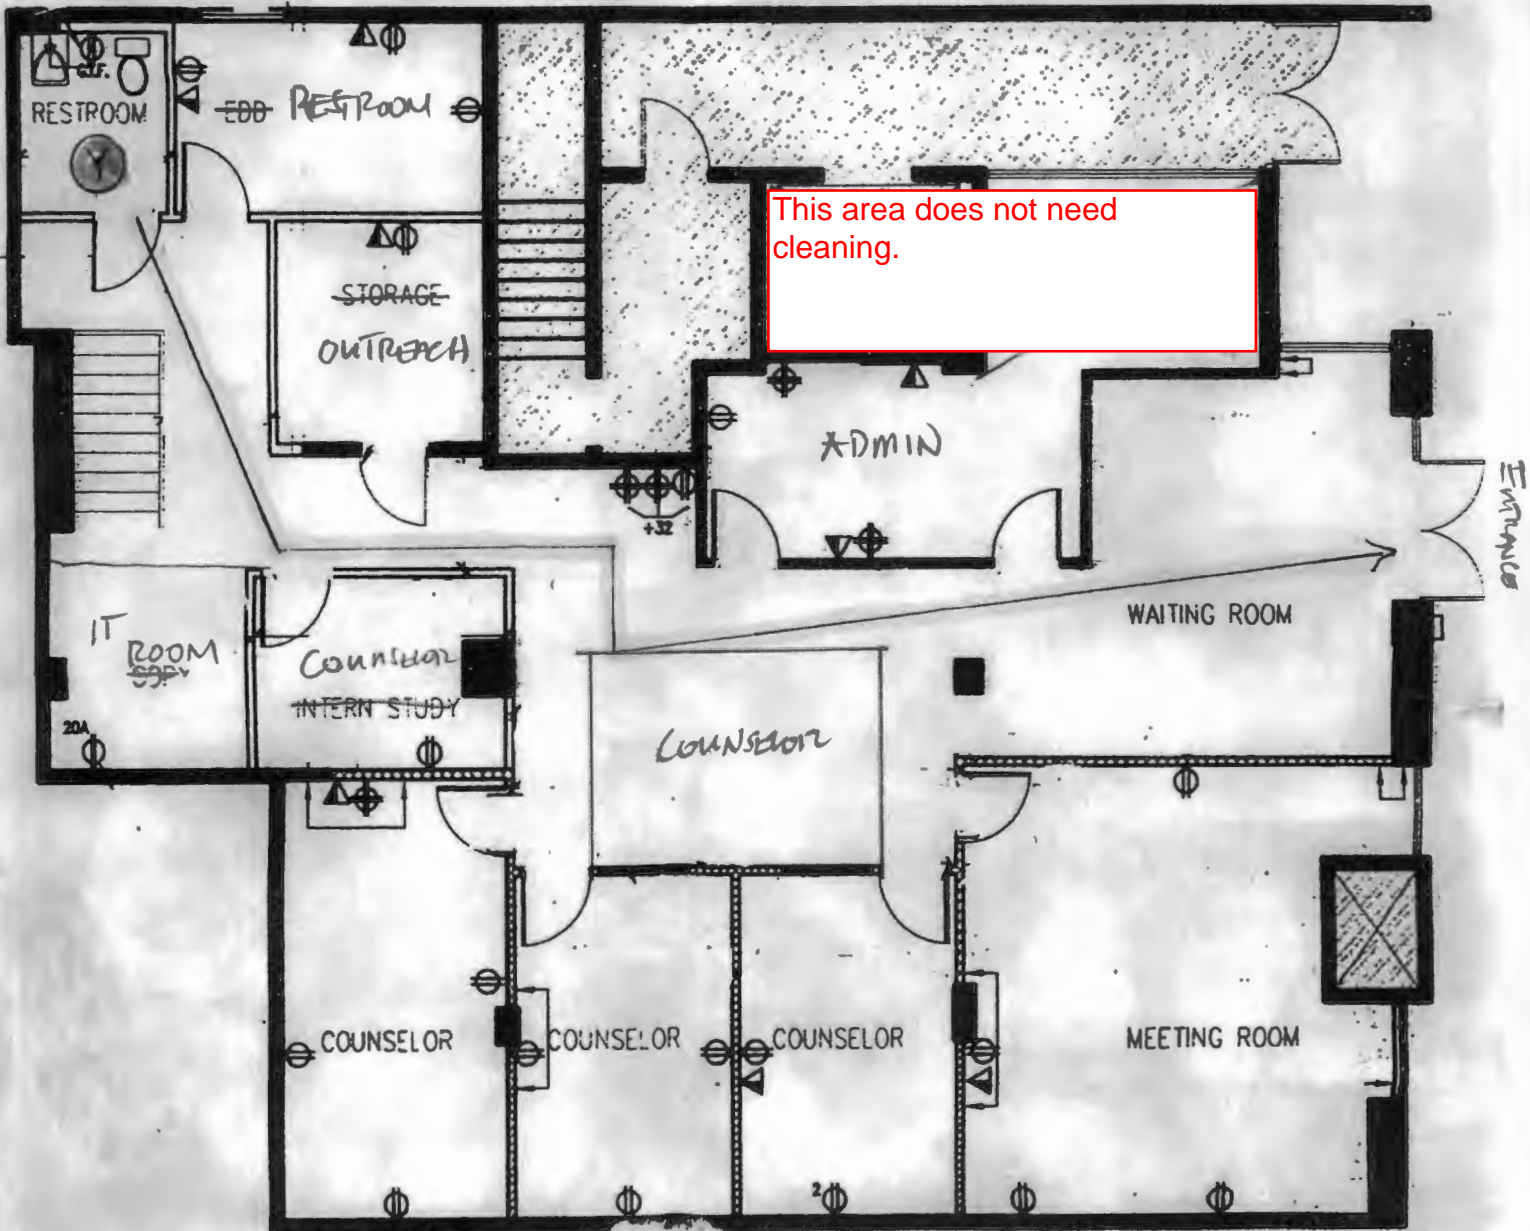

You are here. Follow orange line to main entrance of building to exit in case of an emergency.



ON PLA