

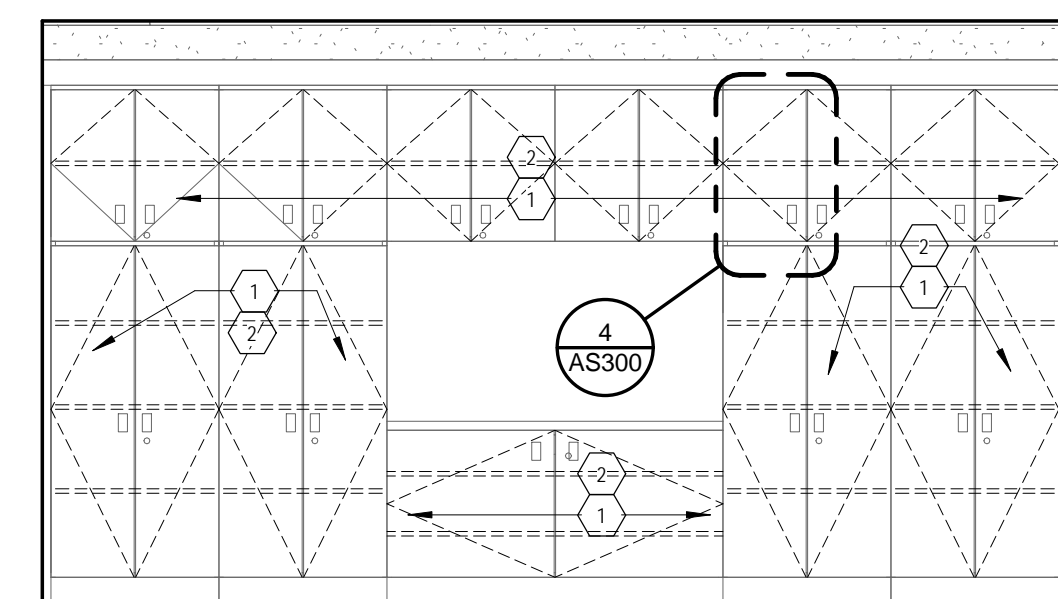



5 PATIENT STORAGE 4B24A E. WALL
AI100 3/8" = 1'-0"

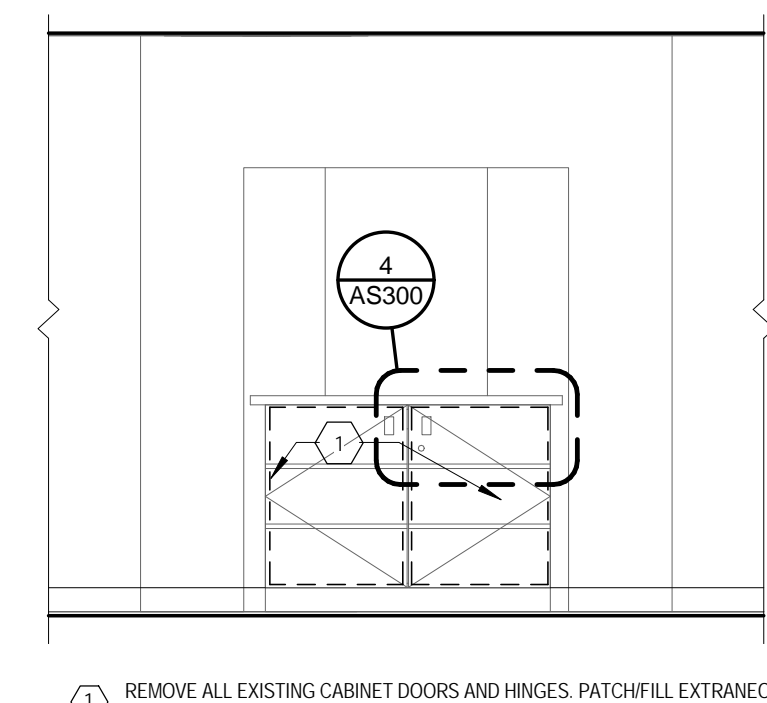

14b DAY RM. 4B33B N. WALL

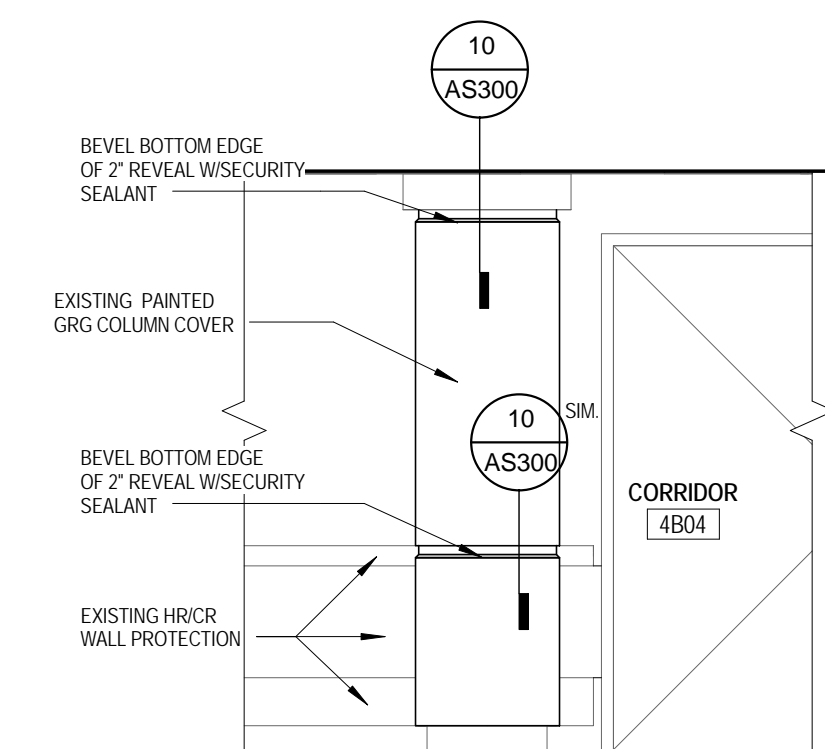

18 S0. ELEV. CORRIDOR 4B04 - EXISTING COLUMN COVER
AI100 3/8" = 1'-0"

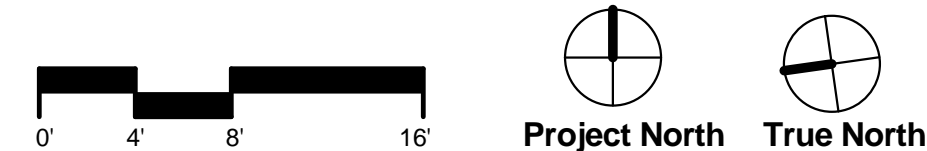[illegible]

CONSULTANTS:

H.F. LENZ COMPANY

1407 Scalp Avenue Johnstown, PA 15904
Phone: 814-269-9300 FAX: 814-269-9301
cadd@hflenzen.com www.hflenzen.com

Engineers • Planners • Surveyors • Energy Consultants

ARCHITECT/ENGINEERS:

 **architecture
planning
interior design**

IKM Incorporated
One PPG Place
Pittsburgh, PA 15222
412-281-1337
www.ikminc.com

Drawing Title

Enlarged Plan and Interior Elevations

Approved: Project Director

Project Title	Clarksburg VAMC Fourth Floor B Acute Inpatient Mental Health Lock Down Conversion
---------------	---

Location	VAMC Clarksburg West Virginia
----------	-------------------------------

Date
March 13, 2015

Checked

Drawn	
-------	--

VA Project Number
540-11-106
IKM Project Number
11-024.1

Building Number

Drawing Number

AI100

Dwg. of

Office of
Construction
and Facilities
Management

