


NOTES:

- FLOODWALL AND FOOTING TO BE REMOVED BETWEEN CONTROL JOINTS AS DIMENSIONED. SEE SPEC. 01010 TO DETERMINE TIMING OF REMOVAL OF EXISTING AND PLACEMENT OF NEW WALL. HORIZONTAL REINFORCING TO BE DOWELED INTO EXISTING WALL WHEN NEW IS PLACED.
- FLOOD BARRIER SHALL BE 8'-0" HIGH X 20'-0" WITH MANUAL CLOSURE AND PNEUMATIC SEALS INFLATED BY A COMPRESSED AIR TANK SUPPLY.

LARGE SCALE PLAN - SERVICE AREA AND FLOODWALL

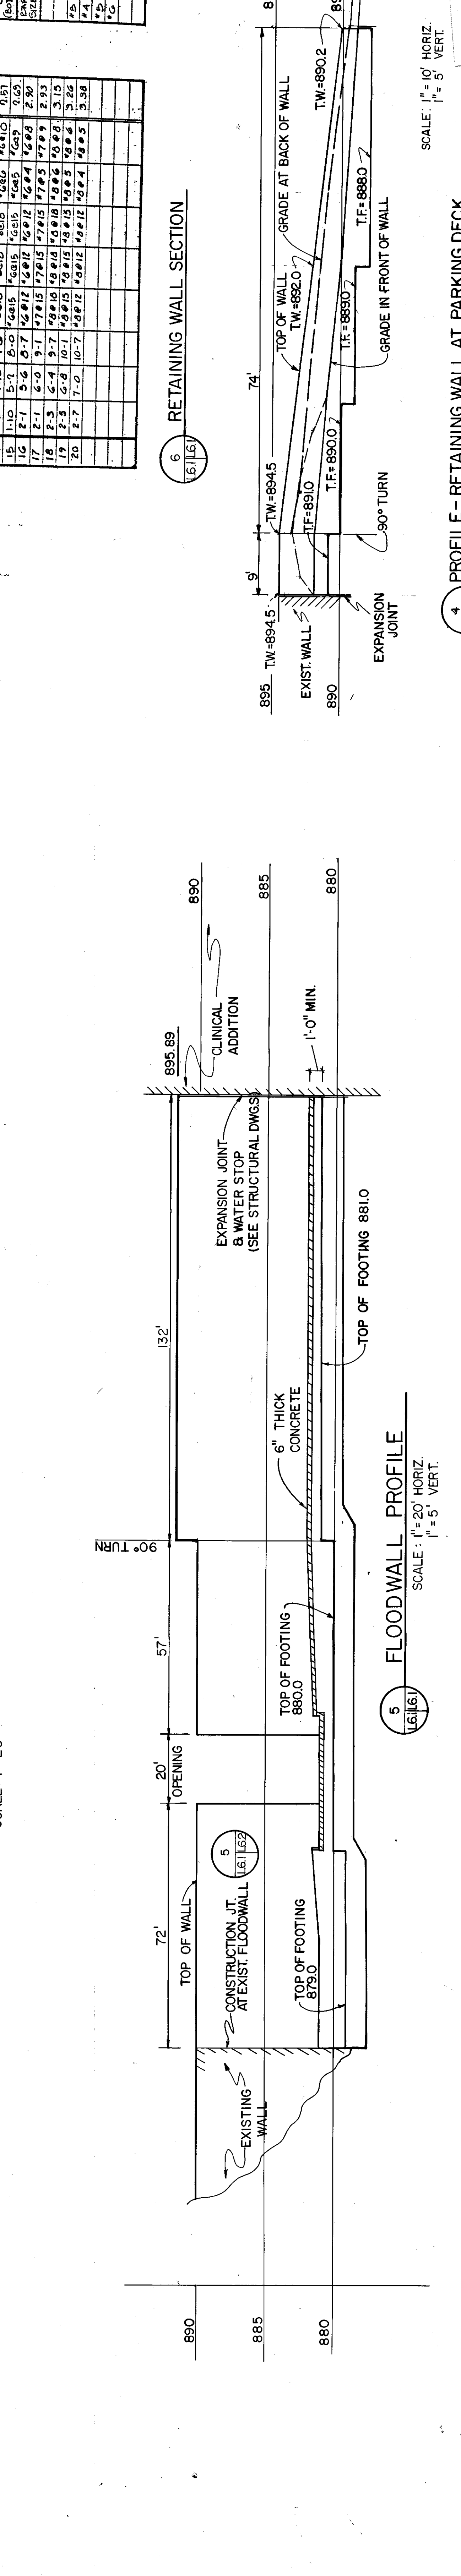

CLINICAL ADDITION

DATE: 15 FEB 91
PROJECT NO: 508-08C
DRAWING NO: L6.1

DETAILS

Project Title: CLINICAL ADDITION
Building Number: 1
Location: VAMC, Atlanta, GA

NIX AECK ROSSER WHITE

MANN

A Joint Venture

RESIDENT ENGINEER'S RECORD PRINTS

CORRECTED PER: [Signature]
DATE: 10/1/90