LEGEND

- LIMIT OF WORK
- TREE PROTECTION FENCE (3 / L-6.4)
- TEMPORARY CONSTRUCTION FENCE
- REMOVE AND LEGALLY DISPOSE OF CHAIN LINK FENCE
- EXISTING CURB TO BE DEMOLISHED AND LEGALLY DISPOSED OF.
- ASPHALT
- CONCRETE

KEY NOTES:

1. SAW CUT AND DEMOLISH EXISTING CURB WHERE NEW CURB WILL BE INSTALLED. SEE SITE PLAN L-2.1
2. EXISTING CONCRETE PAVING TO BE DEMOLISHED – FULL DEPTH INCLUDING BASE COURSE.
3. PROTECT EXISTING CURBS, CURB AND GUTTER, BUILDINGS AND BUILDING SLABS AND FOUNDATIONS TO REMAIN.
4. PROTECT ALL INLETS AND MANHOLES TO REMAIN. REMOVE AND SALVAGE GRATES AND MANHOLE COVERS FOR REINSTALLATION.
5. DEMOLISH EXISTING ASPHALT FULL DEPTH INCLUDING BASE COURSE.
6. DEMOLISH AND LEGALLY DISPOSE OF LIGHT POLE.
7. STORAGE CONTAINER (CONEX) TO BE REINSTALLED. SEE SITE PLAN SHEET L-2.1.
8. DEMOLISH DOUBLE WIDE TRAILER AND BACK STAIRS, DISCONNECT SEWER AND WATER LINE TO EXISTING TRAILER. DISCONNECT POWER AND DATA WIRING TO EXISTING TRAILER. SAVE WIRING TO RECONNECT AFTER NEW TRAILER HAS BEEN INSTALLED.
9. DEMOLISH DECK, STEPS, LANDSCAPE, CANOPY AND PLANTERS. PROTECT LANDSCAPE TO REMAIN.
10. DEMOLISH EXISTING UNDERGROUND STORAGE TANK AND PIPING IN ACCORDANCE WITH SPECIFICATION SECTION 02 65 00.
11. DEMOLISH ALL UNDERGROUND FUEL TANKS, PIPING, DISPENSERS, FIRE SUPPRESSION AND ALL OTHER APPURTENANCES IN ACCORDANCE WITH SPECIFICATION SECTION 02 65 00.
12. DEMOLISH ISLAND COMPLETELY INCLUDING GRASS, SOIL, CURBS, AND U BOXES.
13. DEMOLISH EXISTING CATCH BASIN.
14. PROTECT EXISTING FENCE AND GATES TO REMAIN.

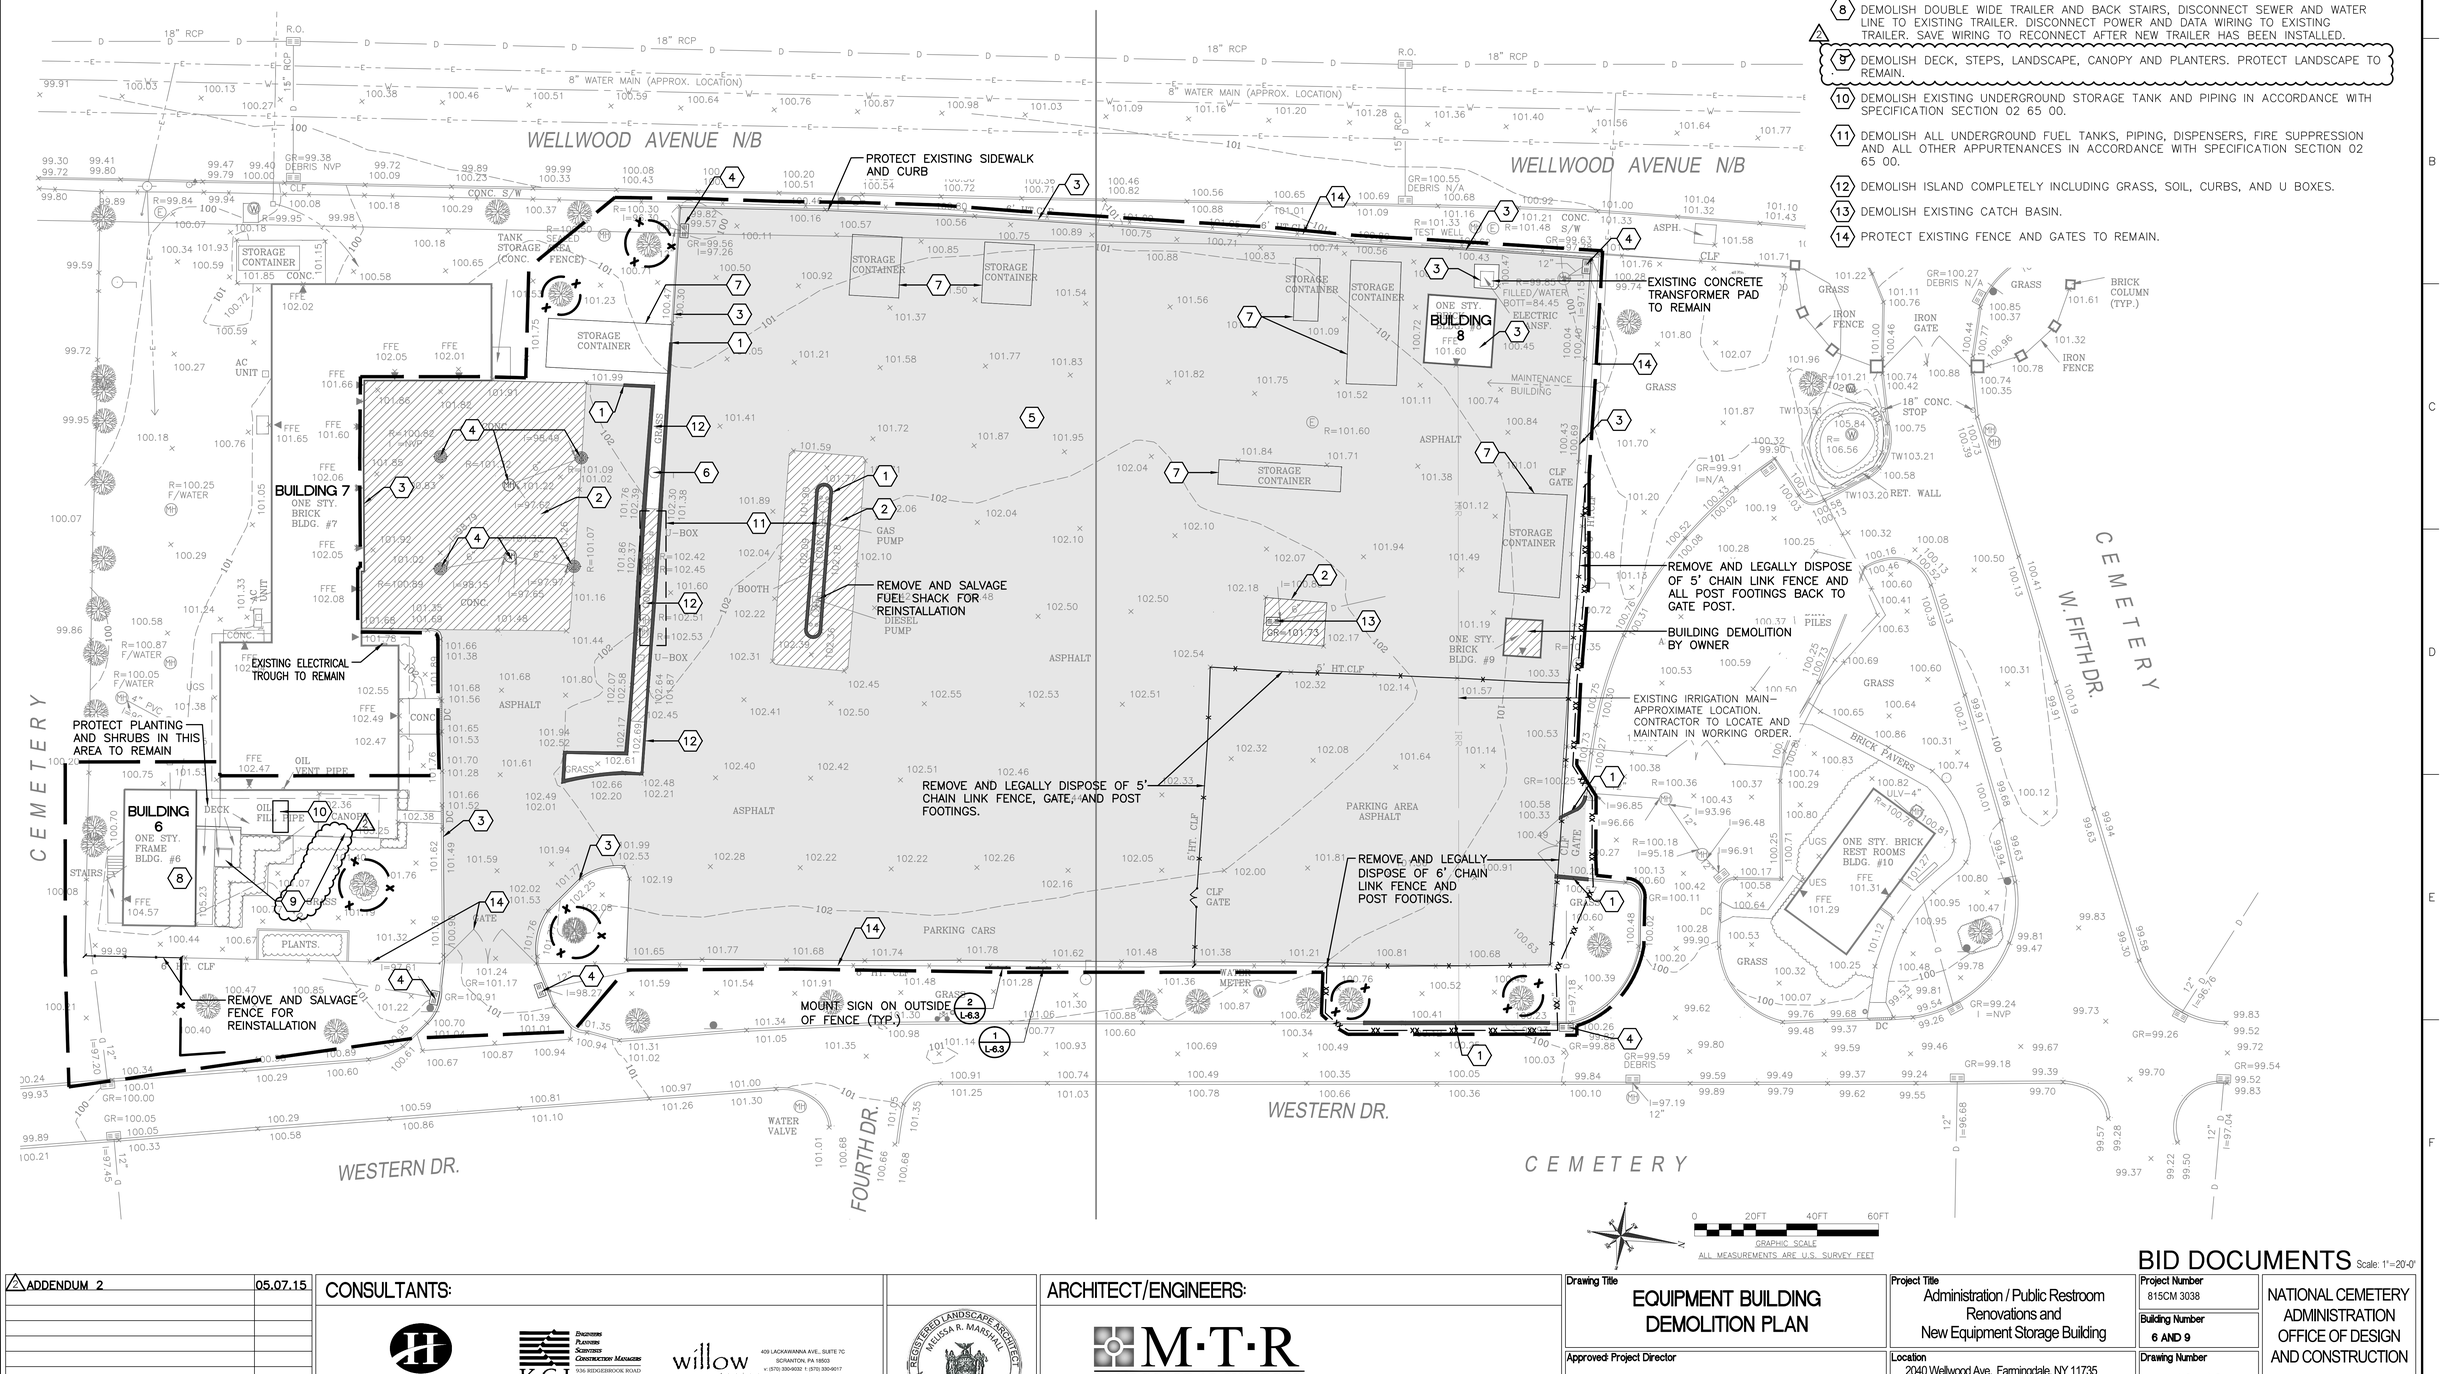

Revisions	Date
2 ADDENDUM 2	05.07.15

CONSULTANTS:

Hirani Group

KCI TECHNOLOGIES — Engineers, Planners, Surveyors, Construction Managers. 536 RIDGEBROOK ROAD, SPARKS, MD 21152. PHONE: (410) 316-7800. FAX: (410) 316-7868. WWW.KCI.COM

willow design ARCHITECTURE — 409 LACKAWANNA AVE., SUITE 7C, SCRANTON, PA 18503. v: (570) 350-6020 f: (570) 330-9017. www.willowdesign.biz. (SERVICE DISABLED VETERAN OWNED SMALL BUSINESS)

REGISTERED LANDSCAPE ARCHITECT — MELISSA R. MARSHALL — 002382 — STATE OF NEW YORK

ARCHITECT/ENGINEERS:

M·T·R LANDSCAPE ARCHITECTS — 101 Bellevue Road Pittsburgh, PA 15229 (412) 931-6455

Drawing Title: EQUIPMENT BUILDING DEMOLITION PLAN

Approved: Project Director

Project Title: Administration / Public Restroom Renovations and New Equipment Storage Building

Location: 2040 Wellwood Ave. Farmingdale, NY 11735

Date: AUGUST 6, 2014 | Checked: MD / KR | Drawn: AW

Project Number: 815CM 3038

Building Number: 6 AND 9

Drawing Number: D-1.1

Dwg. 5 of 76

BID DOCUMENTS Scale: 1"=20'-0"

NATIONAL CEMETERY ADMINISTRATION OFFICE OF DESIGN AND CONSTRUCTION

Department of Veterans Affairs

VA FORM 08-6231

R:\MTR Projects\VA DIQ\Long Island National Cemetery\DD's\Sheets\D-1.1 New Equipment Bldg Demo Plan.dwg 5-07-15 10:50:51 AM azimbovsky