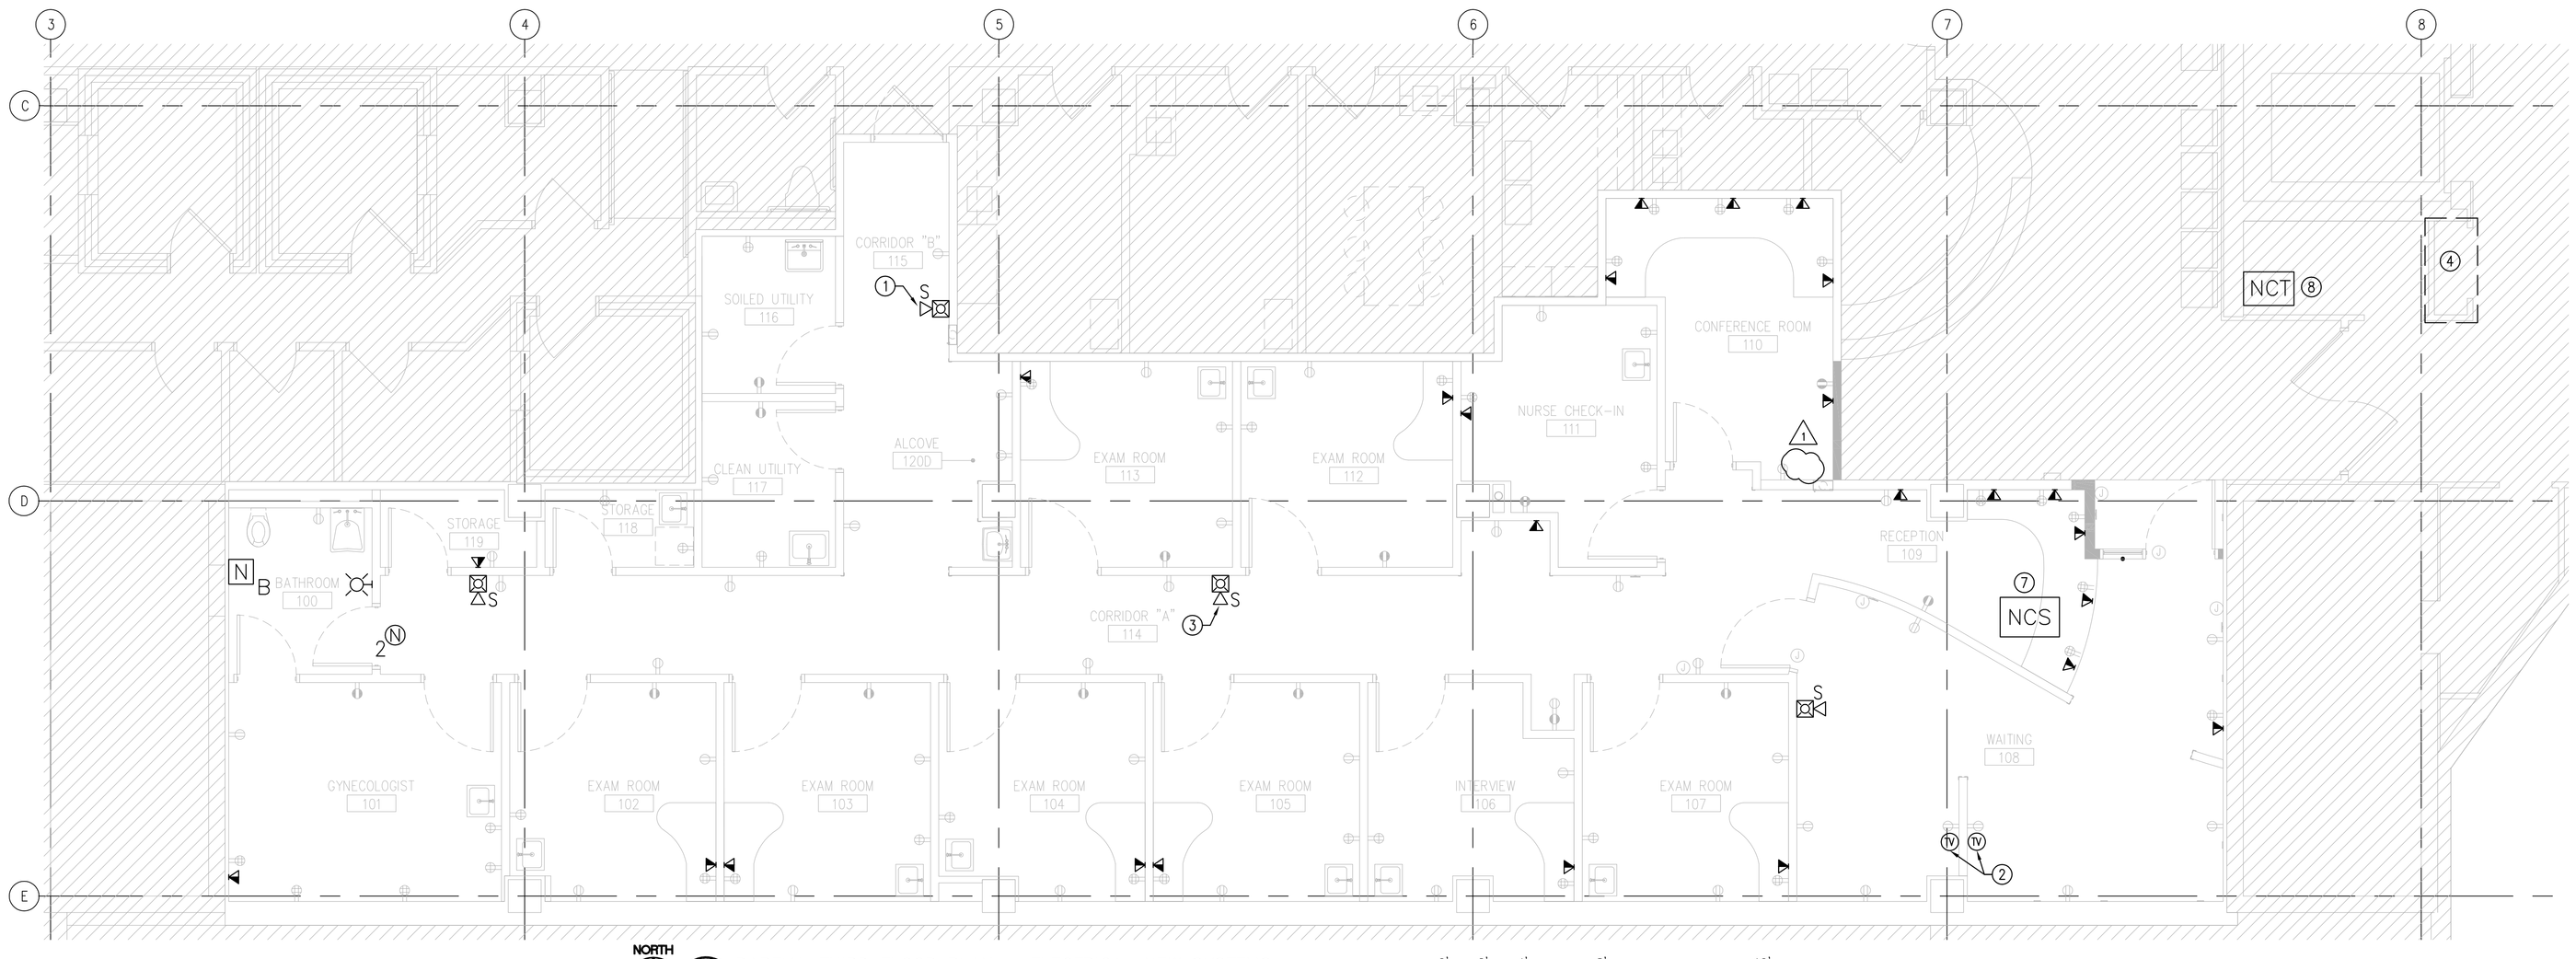

NORTH

1 PARTIAL THIRD FLOOR PLAN – ELECTRICAL NEW SYSTEMS

1/4" = 1'-0"

0' 2' 4' 8' 16'

GENERAL NOTES

1. ALL DATA OUTLET, PHONE OUTLET AND PHONE/DATA OUTLET SHOWN ARE NEW UNLESS NOTED OTHERWISE.
2. ALL FIRE ALARM DEVICES SHOWN ARE NEW UNLESS NOTED OTHERWISE.
3. ALL TELECOMMUNICATION CABLES TO BE IN 1" CONDUIT FROM BOX IN WALL STUBBED TO ABOVE NEAREST ACCESSIBLE CEILING.
4. PROVIDE TELECOMMUNICATION PATHWAYS ALONG CORRIDORS CONSISTING OF J HOOKS 5 FEET ON CENTER FOR SUPPORTING CABLES. TELEPHONE AND DATA CABLES TO BE BUNDLED SEPARATELY FROM EACH OTHER WITH NO MORE THAN 48 CABLES PER BUNDLE.
5. ALL TELECOMMUNICATION CABLES SHOWN FOR THIS AREA TO BE ROUTED TO THE TELECOMMUNICATION CLOSET SHOWN ON THE SECOND FLOOR.

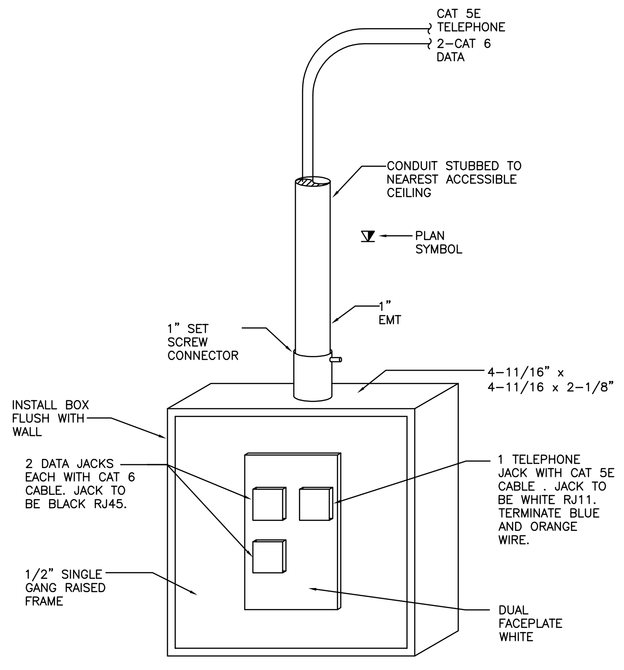

3 TYPICAL COMBINATION DATA AND VOICE OUTLET

NO SCALE

KEY NOTES

1. EXISTING FIRE ALARM SPEAKER/STROBE.
2. OUTLET FOR CABLE TV. MOUNT AT 72" AFF.
3. RELOCATED FIRE ALARM SPEAKER/STROBE. PROVIDE NEW FIRE ALARM WIRING TO EXISTING FIRE ALARM SYSTEM.
4. ROUTE CABLING FROM NEW TELEPHONE/DATA OUTLETS TO THIS CLOSET AND THROUGH SLEEVES IN FLOOR TO CLOSET BELOW. SEE NOTE 5 AND DETAIL 2 THIS SHEET.
5. ROUTE CABLES FROM FLOOR ABOVE FORM THIS CLOSET ABOVE CEILING TO ROOM D2201A.
6. ALL NEW CABLES FROM NEW TELEPHONE/DATA OUTLETS IN WOMEN'S CLINIC ON THIRD FLOOR TO BE TERMINATED IN EXISTING PATCH PANELS WITHIN THIS CLOSET.
7. NURSE CALL STATION MOUNTED ON DESK AT STATION.
8. NURSE CALL TERMINAL CABINET HEAD-END EQUIPMENT.

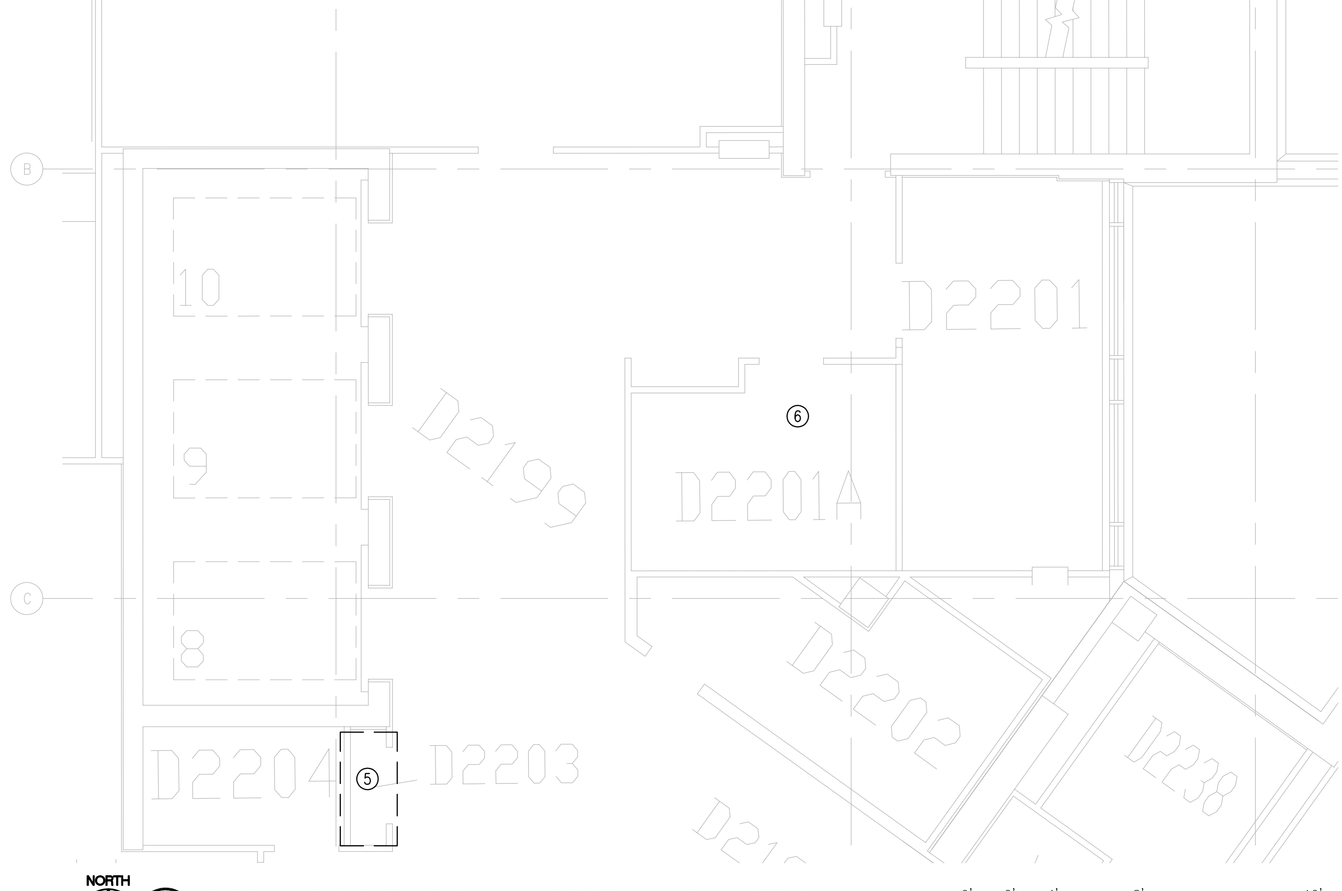

NORTH

2 PARTIAL SECOND FLOOR PLAN – ELECTRICAL NEW SYSTEMS

1/4" = 1'-0"

0' 2' 4' 8' 16'

ADDENDUM#1	5/8/2015
100% CONSTRUCTION DOCUMENTS	4/8/2015
95% CONSTRUCTION DOCUMENTS	3/4/2015
65% CONSTRUCTION DOCUMENTS	1/14/2015
50% DESIGN DEVELOPMENT	10/1/2014
25% SD SUBMITTAL	1/14/2015
Revisions	Date

KEYPLAN

TRUE NORTH PLAN NORTH

AREA OF WORK

ENGINEERS + CONSULTANTS:

EPSTEIN

Architecture
Interiors
Engineering
Construction

600 W. Fulton Street
Chicago, IL 60661-1259
T 312.454.9100

www.epsteinglobal.com

ARCHITECT + ENGINEERS:

BANCROFT ARCHITECTS + ENGINEERS

700 Nicholas Blvd. Suite 403
Elk Grove Village, IL 60007
T:847.952.9362 F:847.952.9403

Drawing Title: PARTIAL THIRD FLOOR PLAN - ELECTRICAL NEW SYSTEMS

Approved: Project Director

Project Title: William S. Middleton VA Hospital RENOVATE 3D WOMEN'S HEALTH CLINIC

Location: WILLIAM S. MIDDLETON VA HOSPITAL

Date: 4/8/2015 | Checked: MS | Drawn: MA

Project Number: 607-14-108

Building Number: 1

Drawing Number: E-301

Office of Construction and Facilities Management

Department of Veterans Affairs

VA FORM 08-6231

"ACCOMPANYING AMENDMENT VA69D-15-B-0708 – A00002"

three inches = one foot 6"
one and one half inches = one foot 1 6" 0
one inch = one foot 2 6" 0
three quarters inch = one foot 2 6" 0
one half inch = one foot 4 0
three eighths inch = one foot 4 0
one quarter inch = one foot 8 4 0
one eighth inch = one foot 16 8 4 0
D:\Projects\14000\14168\DISCIPLINE\Elec\Working Sheets\14168-E-301.dwg 5-08-15 01:45:20 PM mshepherd