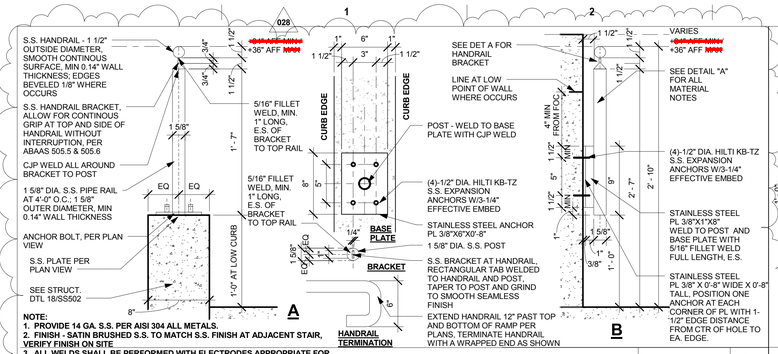

NOTE:
1. PROVIDE 14 GA. S.S. PER AISI 304 ALL METALS.
2. FINISH - SATIN BRUSHED S.S. TO MATCH S.S. FINISH AT ADJACENT STAIR, VERIFY FINISH ON SITE
3. ALL WELDS SHALL BE PERFORMED WITH ELECTRODES APPROPRIATE FOR STAINLESS STEEL.
4. SUBMIT SHOP DRAWINGS FOR REVIEW.

HANDRAIL DETAIL | 1 1/2" = 1'-0" | 25

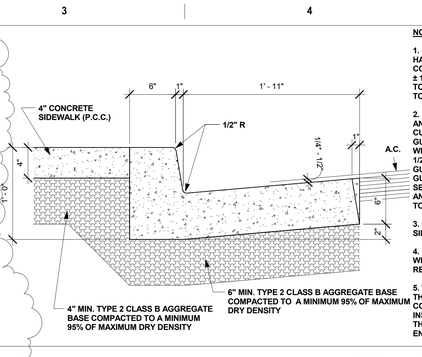

NOTES:

1. FIBER-REINFORCED PORTLAND CEMENT CONCRETE (P.C.C.) SHALL HAVE THE FOLLOWING CHARACTERISTICS: 4000 PSI MIN. COMPRESSIVE STRENGTH @ 28 DAYS, MIN. 6 SACKS ENTRAINMENT 6% ± 1.5%, SLUMP AT 1 TO 4 INCHES. ALL MATERIALS SHALL CONFORM TO SSPWC SECTION 202. POLYPROPYLENE FIBERS SHALL BE ADDED TO THE P.C.C. PER THE MANUFACTURER'S RECOMMENDATIONS.

2. EXPANSION JOINTS 1/2-INCH WIDE SHALL BE LOCATED IN CURBS AND GUTTERS AT EACH SIDE OF STRUCTURES, AT THE ENDS OF ALL CURB RETURNS, AND ABUTTING HARDENED IN-PLACE CURB AND GUTTER, EXCEPT THAT EXPANSION JOINTS SHALL BE 1/2-INCH THICK, WITHIN 20 FEET OF AN ISLAND NOSE. EXPANSION JOINTS SHALL BE 1/2-INCH THICK, SHAPED TO THE CROSS SECTION OF THE CURB AND GUTTER, AND CONSTRUCTED AT RIGHT ANGLES TO THE CURB AND GUTTER. JOINT FILLER MATERIAL SHALL CONFORM TO SSPWC SECTION 202.10 WEAKENED PLANE JOINTS SHALL BE EVERY 10 FEET AND LOCATED ON THE BACK, TOP AND FACE OF THE CURB AND THE TOP OF THE GUTTER PAN.

3. CURB & GUTTER SECTIONS SHALL BE PLACED SEPARATELY FROM SIDEWALK SECTIONS.

4. "BATTERED" CONSTRUCTION ALLOWED FOR NEW CONSTRUCTION , WHILE "VERTICAL" CONSTRUCTION PERMITTED FOR RECONSTRUCTION.

5. WHERE ALTERNATE STANDARDS OF CURB AND GUTTER EXIST, AND THE REPLACEMENT CURB AND GUTTER IS GREATER THAN 20 CONTINUOUS FEET IN LENGTH, TYPE 1-A CURB AND GUTTER SHALL BE INSTALLED WITH THE APPROPRIATE TRANSITIONS TO MATCH INTO THE EXISTING CURB AND GUTTER, IF DIRECTED BY THE CITY ENGINEER.

TYPE 1-A P.C.C. CURB & GUTTER | 1 1/2" = 1'-0" | 15

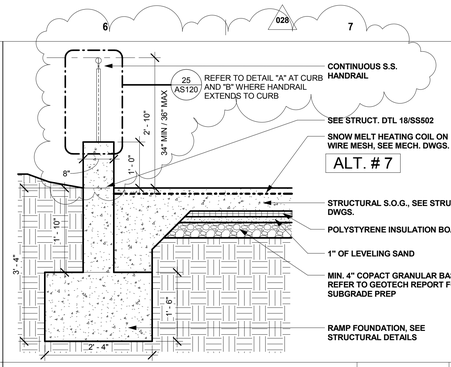

SLAB ON GRADE RAMP DETAIL | 3/4" = 1'-0" | 10

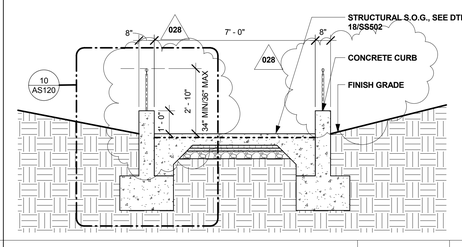

RAMP SECTION | 3/8" = 1'-0" | 5

EXTERIOR RAMP SECTION | 1/4" = 1'-0" | 3

EXIT RAMP - FIRST FLOOR | 1/4" = 1'-0" | 1

1	FOR CONSTRUCTION (AMENDMENTS 1-6)	08/27/2012
022	Instruction Bulletin 022	02/17/2014
028	Instruction Bulletin 028	07/11/2014

Consultants

COLLABORATIVE DESIGN STUDIO architecture of experience and place
www.collaborativedesignstudio.com
T 775.348.7777 F 775.348.0904
9444 DOUBLE R BLVD SUITE B | RENO NV 89521

Reviewing Agency - Fire Protection

AON
Fire Protection Engineering
Aon Fire Protection Engineering Corporation
11770 Bernardo Plaza Court | Suite 116 | San Diego, CA 92128
t +1.858.673.5845 | f + 1.858.673.5849 | www.aonfpe.com
Fire Protection | Code | Risk | Life Safety | Security

LICENSED ARCHITECT ARTHUR E. BORNER 4006 STATE OF NEVADA 12/31/2015

Architects/Engineers

RBB ARCHITECTS INC
10980 Wilshire Boulevard
Los Angeles, California
90024-3905
Telephone 310 473 3555
Facsimile 310 473 3555
www.rbbinc.com

917 7th St. 2nd Floor Ste. 3
Sacramento, California
95814
Telephone 310 473 3555
Facsimile 310 473 3555
www.rbbinc.com

Drawing Title
SITE RAMP DETAILS

Scale
As indicated

Approved Project Director

Project Title
VA SIERRA NEVADA HEALTHCARE SYSTEM
BLDG 1A - SEISMIC CORRECTIONS

Project No. RBB #1013700
VA Contract No. VA261-P-088

Location
975 KIRMAN AVE., RENO, NEVADA 89502

Date 05/01/2012
Checked RP
Drawn RP

VA Project No. 654-336
Building No. 1A
Drawing No. AS120

Office of Construction and Facilities Management
Department of Veteran Affairs

FOR CONSTRUCTION