ASBESTOS CONTAINING MATERIALS

A. FLOOR TILE
B. BLACK FLOOR TILE MASTIC
C. CAL-MAG PIPE INSULATION
D. MUDDED PIPE FITTINGS
E. MUDDED TANK INSULATION
F. RED STONE FLOORING
G. ASSUMED PIPE AND PIPE FITTING INSULATION
H. ASSUMED FIRE DOORS
I. ASSUMED ELEVATOR DOOR INSULATION
J. ASSUMED ELEVATOR CAB INSULATION
K. ASSUMED ELEVATOR BRAKE PADS
L. ASSUMED CORK INSULATION MASTIC
M. ASSUMED ROOFING

△ – AREA DESIGNATION

○ – ASBESTOS CONTAINING MATERIAL DESIGNATION

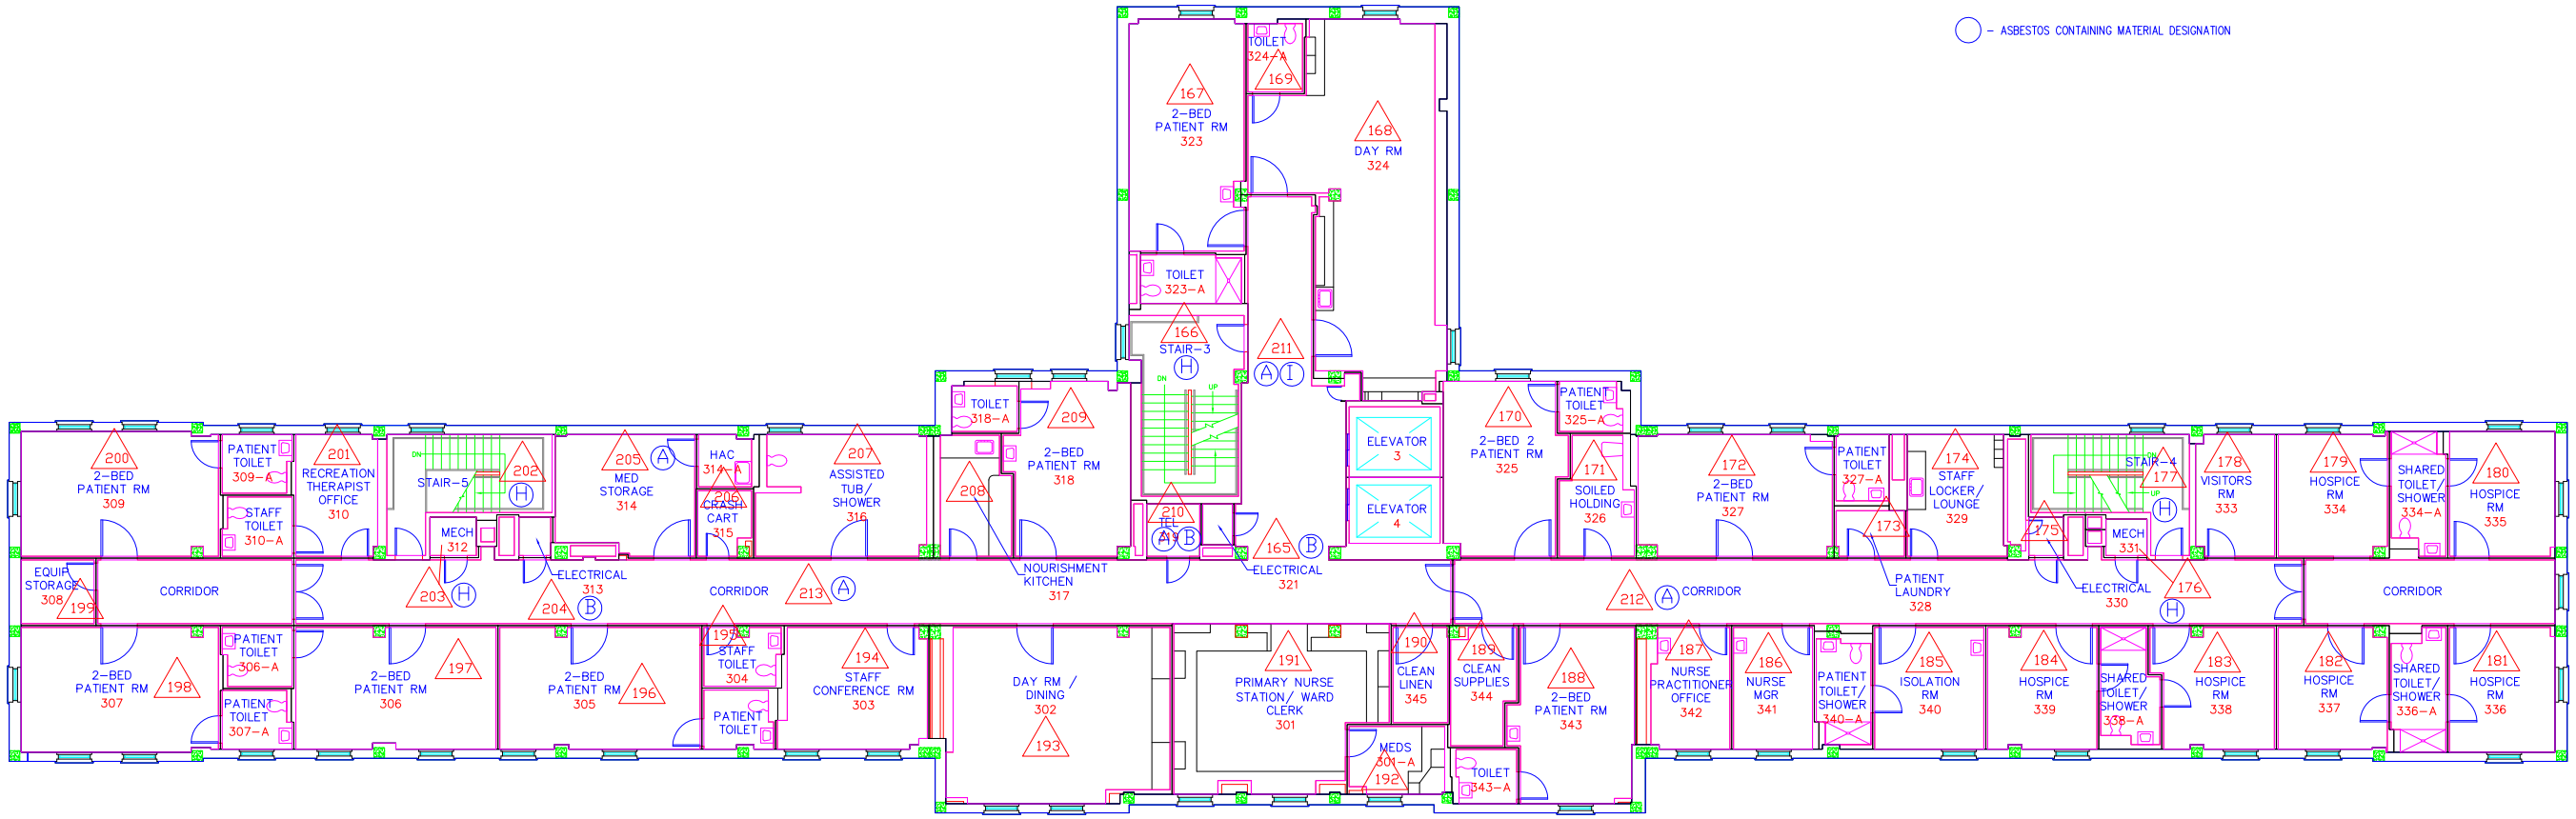

Revisions	Date	AEROSOL MONITORING & ANALYSIS, INC. 1331 ASHTON ROAD, P.O. BOX 646 HANOVER, MARYLAND 21076 WEBSITE: WWW.AMACINDUSTRIES.COM PHONE: 410-684-3327 FAX: 410-684-3384 Professional Seal		Drawing Title: THIRD FLOOR PLAN ARCHITECTURAL	Project Title: Asbestos Drawings	Date: 11-04-2011	VAMC, PERRYPOINT
				Approved:	Building Number: 23H; Checked; Drawn	Project No.	Department of Veterans Affairs
				Approved:	Location: VAMC PERRYPOINT MARYLAND	Drawing No.: H-23H4	VA