


AMENDMENT A00003 TO  
SOLICITATION VA262-15-B-0027  
ATTACHMENT 1

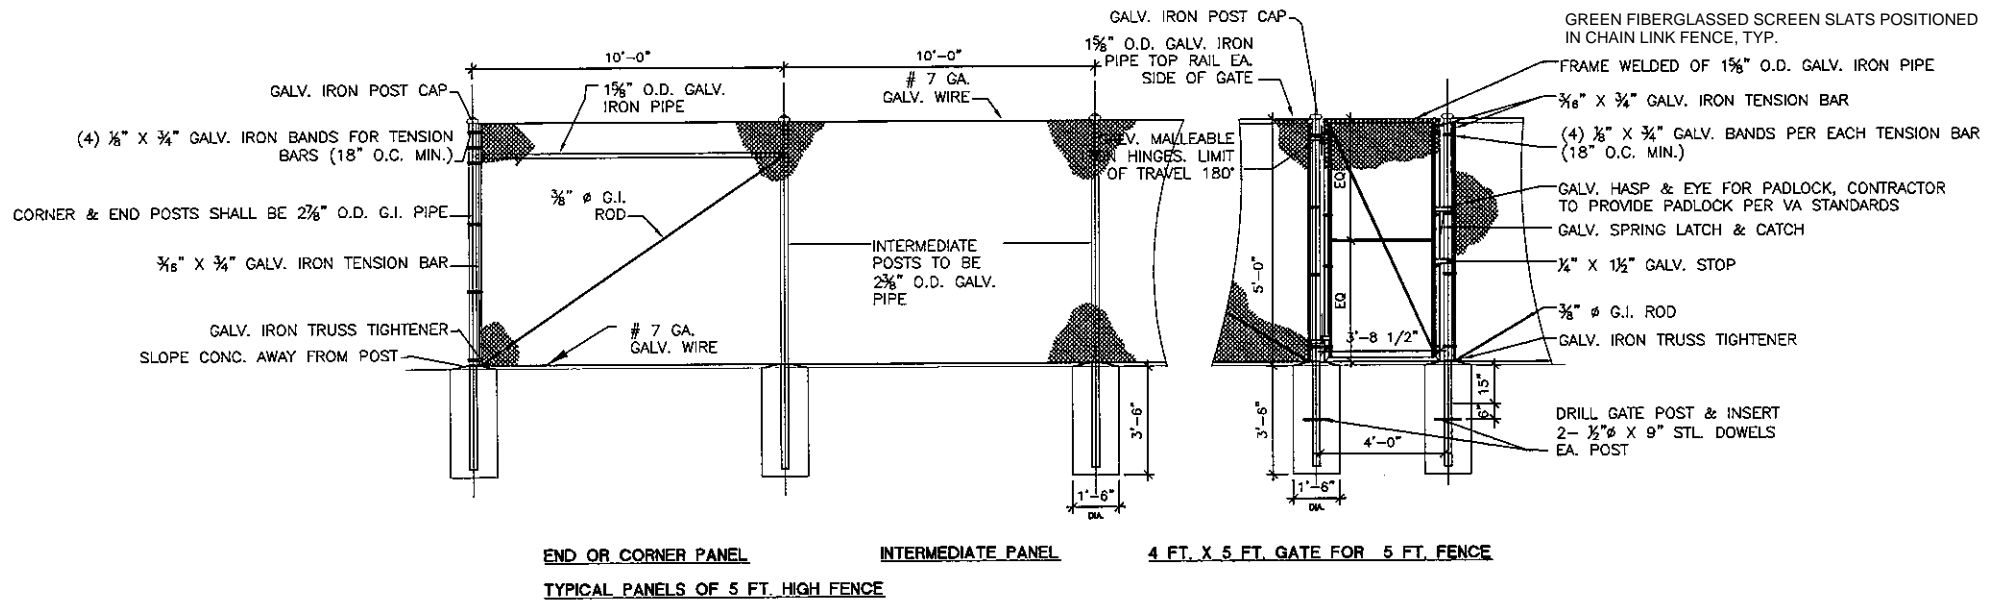

TYP. GALV. CHAIN LINK FENCE DETAIL