



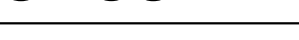

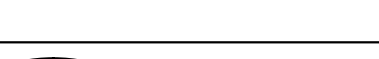


	A	B	C	D	E
\msw\Network\Project_Books\0115_150552-000_1200_Breitkopf\1205_AutoCAD_Paper\Flux\05-4062.181.BP - May 27, 2015 - 15 - 32					

- 2.1 INSTALL NEW TERMINAL UNITS & DUCTWORK.
- 2.2 CONNECT TO (E) DUCT.



				CONSULTANTS:		KEY PLAN		ARCHITECT/ENGINEERS:		Drawing Title SECOND FLOOR MECH NEW PLAN		Project Title Renovate for Medical Offices Building 101 - 2nd Floor		Project Number 640-13-143P		Office of Facilities Management			
				 CAPITAL ENGINEERING CONSULTANTS, INC. RANCHO CORDOVA, CALIFORNIA		 DATE SIGNED: _____		 ARCHITECTS 239 9TH STREET SAN FRANCISCO, CA 94103 T 415.703.0328 F 415.707.6328 www.meiarchitects.com		Approved: Project Director		Location VA Palo Alto, CA		Building Number BLDG 101/2ND FLR					
 AMENDMENT NO. 5		5.29.15		 CM - IB/TS PM - DESIGN TEAM		 130502.00 PROJECT NO.						Date November 7, 2014		Checked				Drawn	
Revisions:		Date																 Department of Veterans Affairs	