
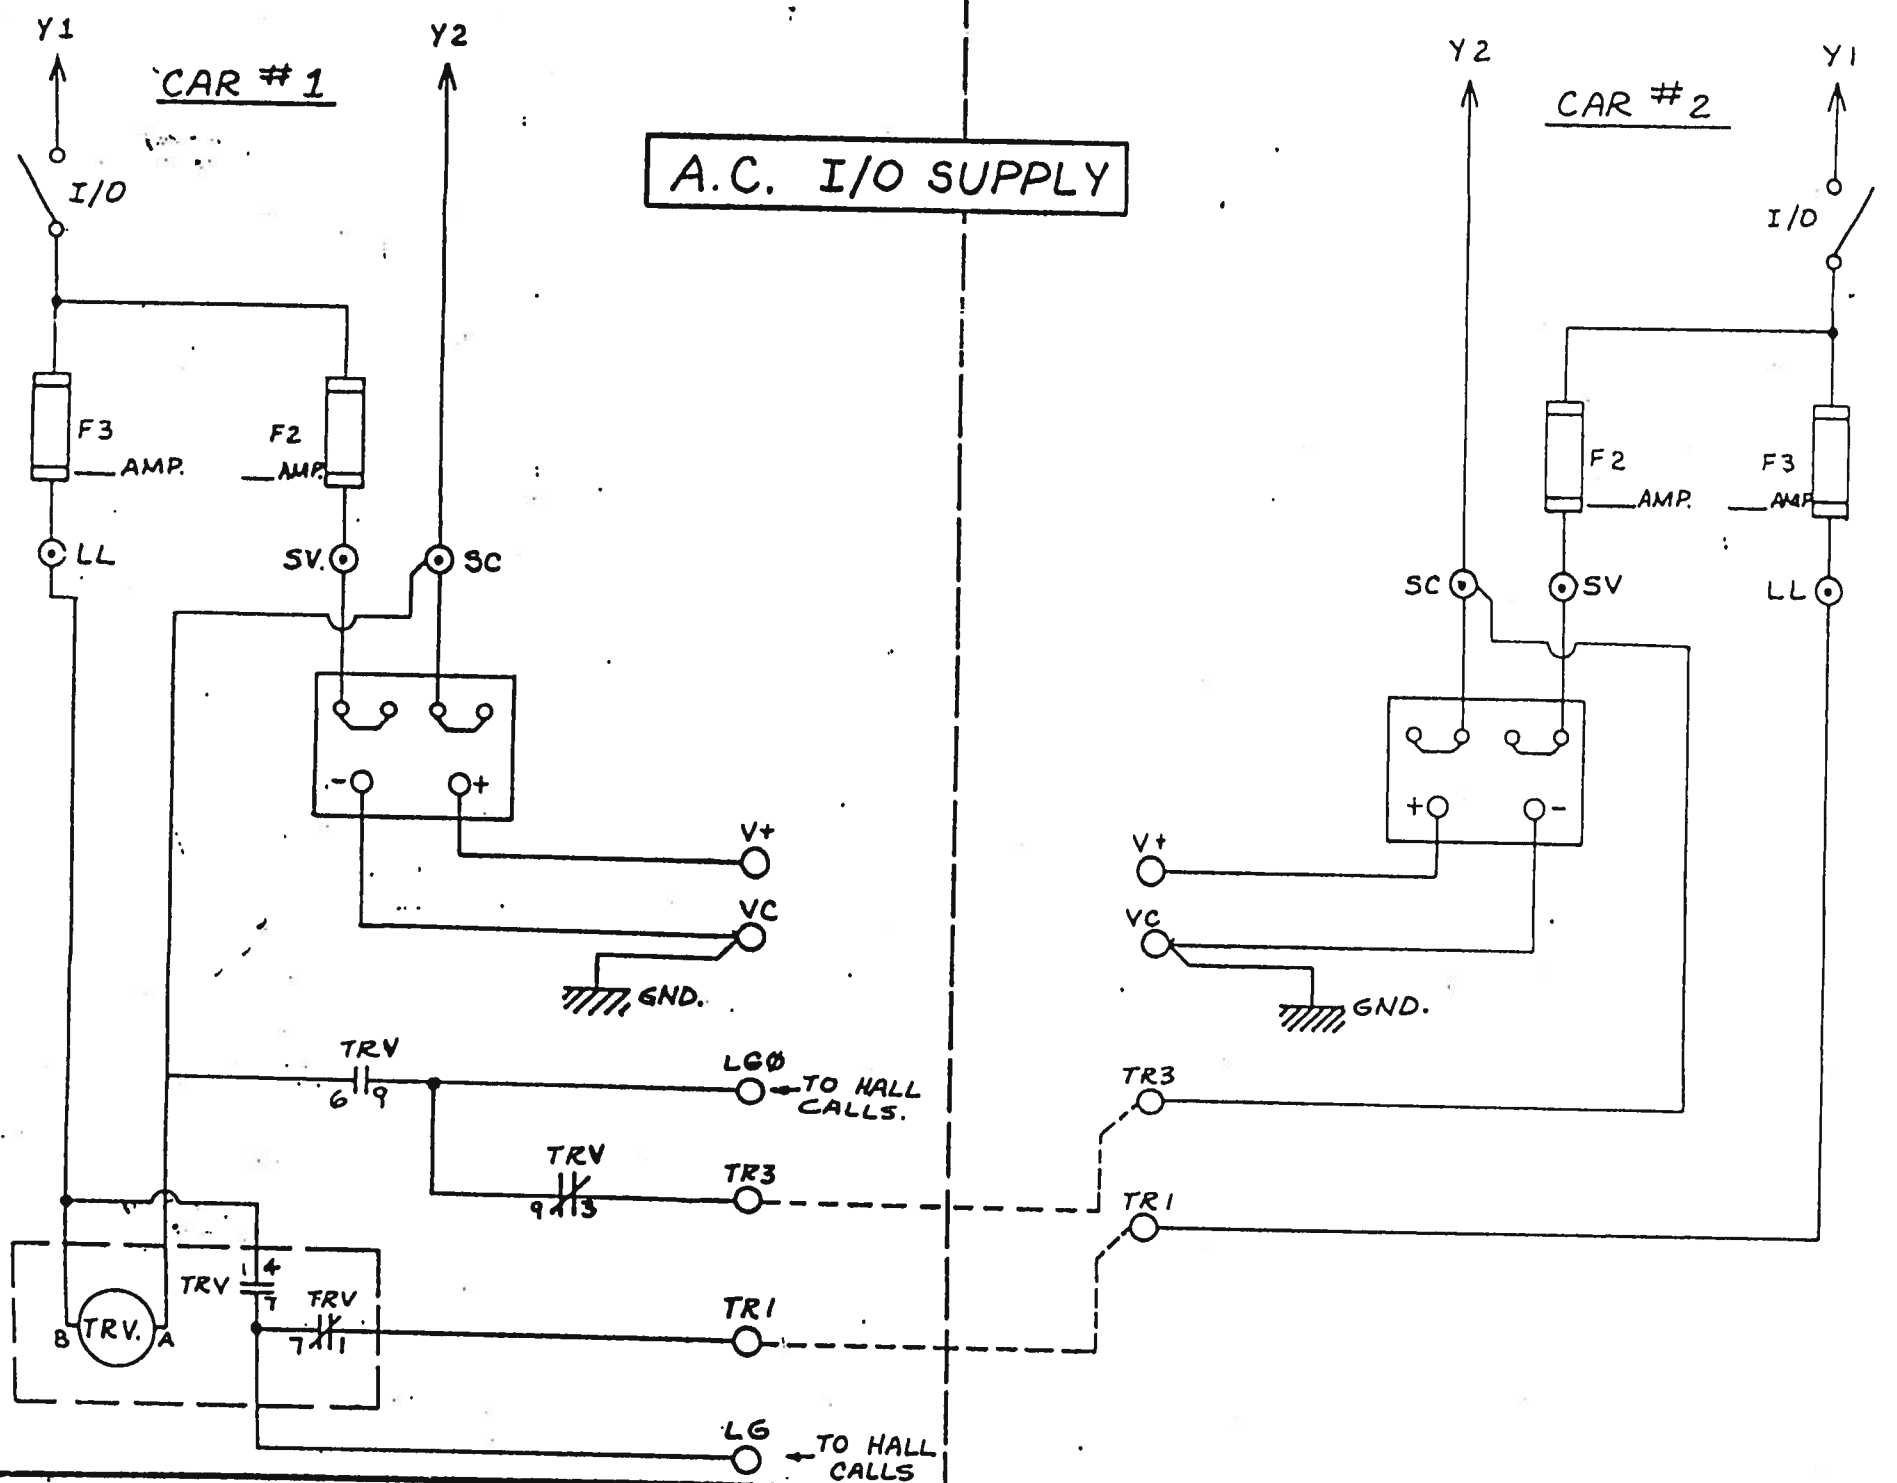



A/B


B/C

C/D

D

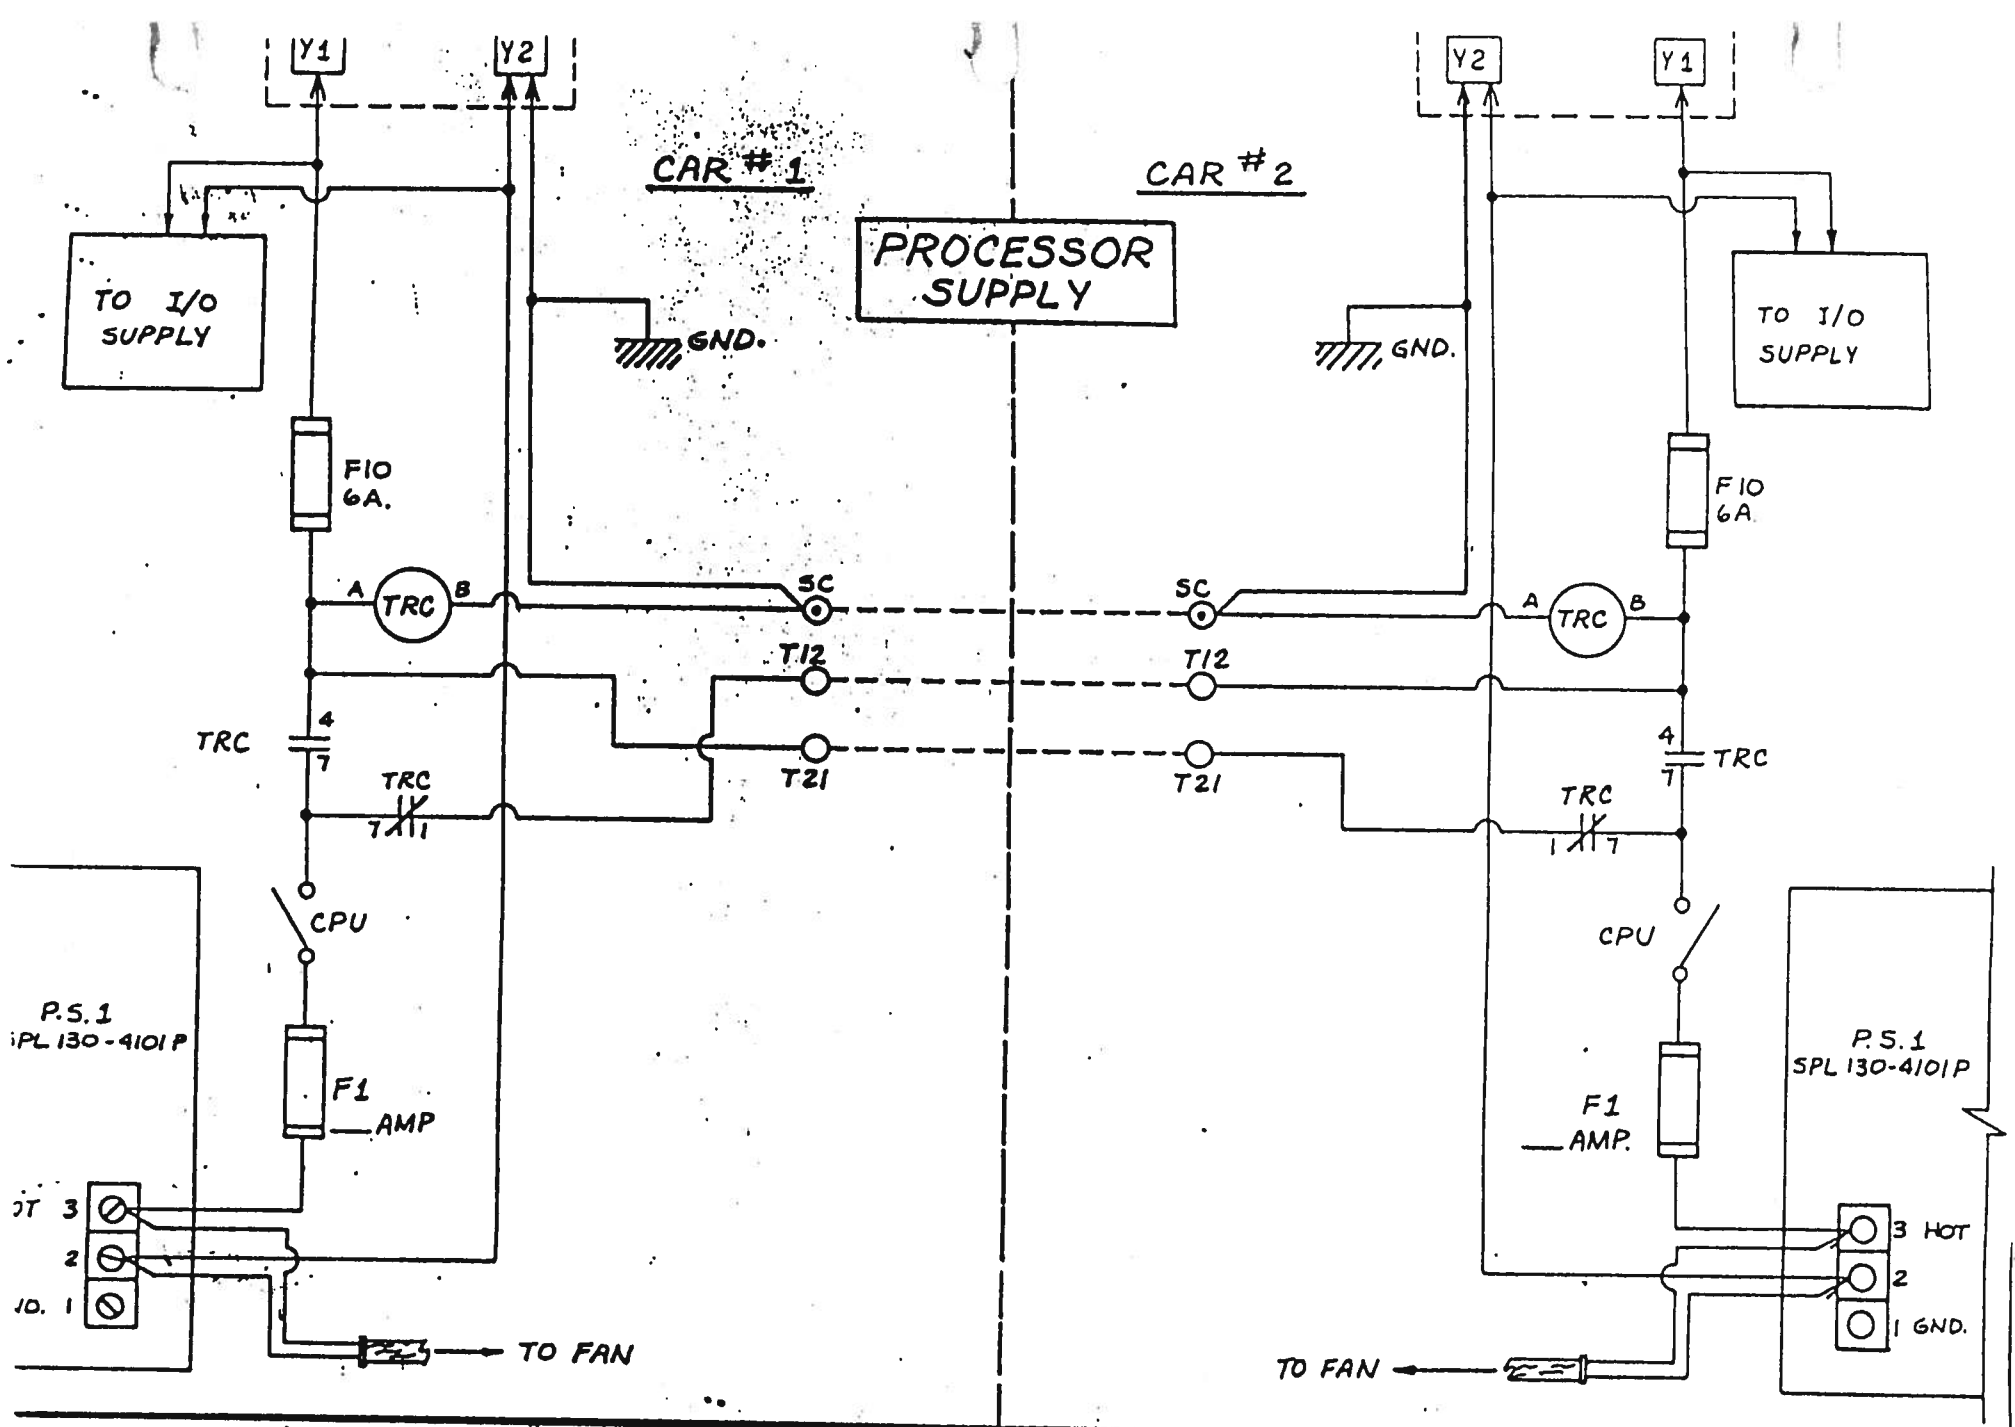


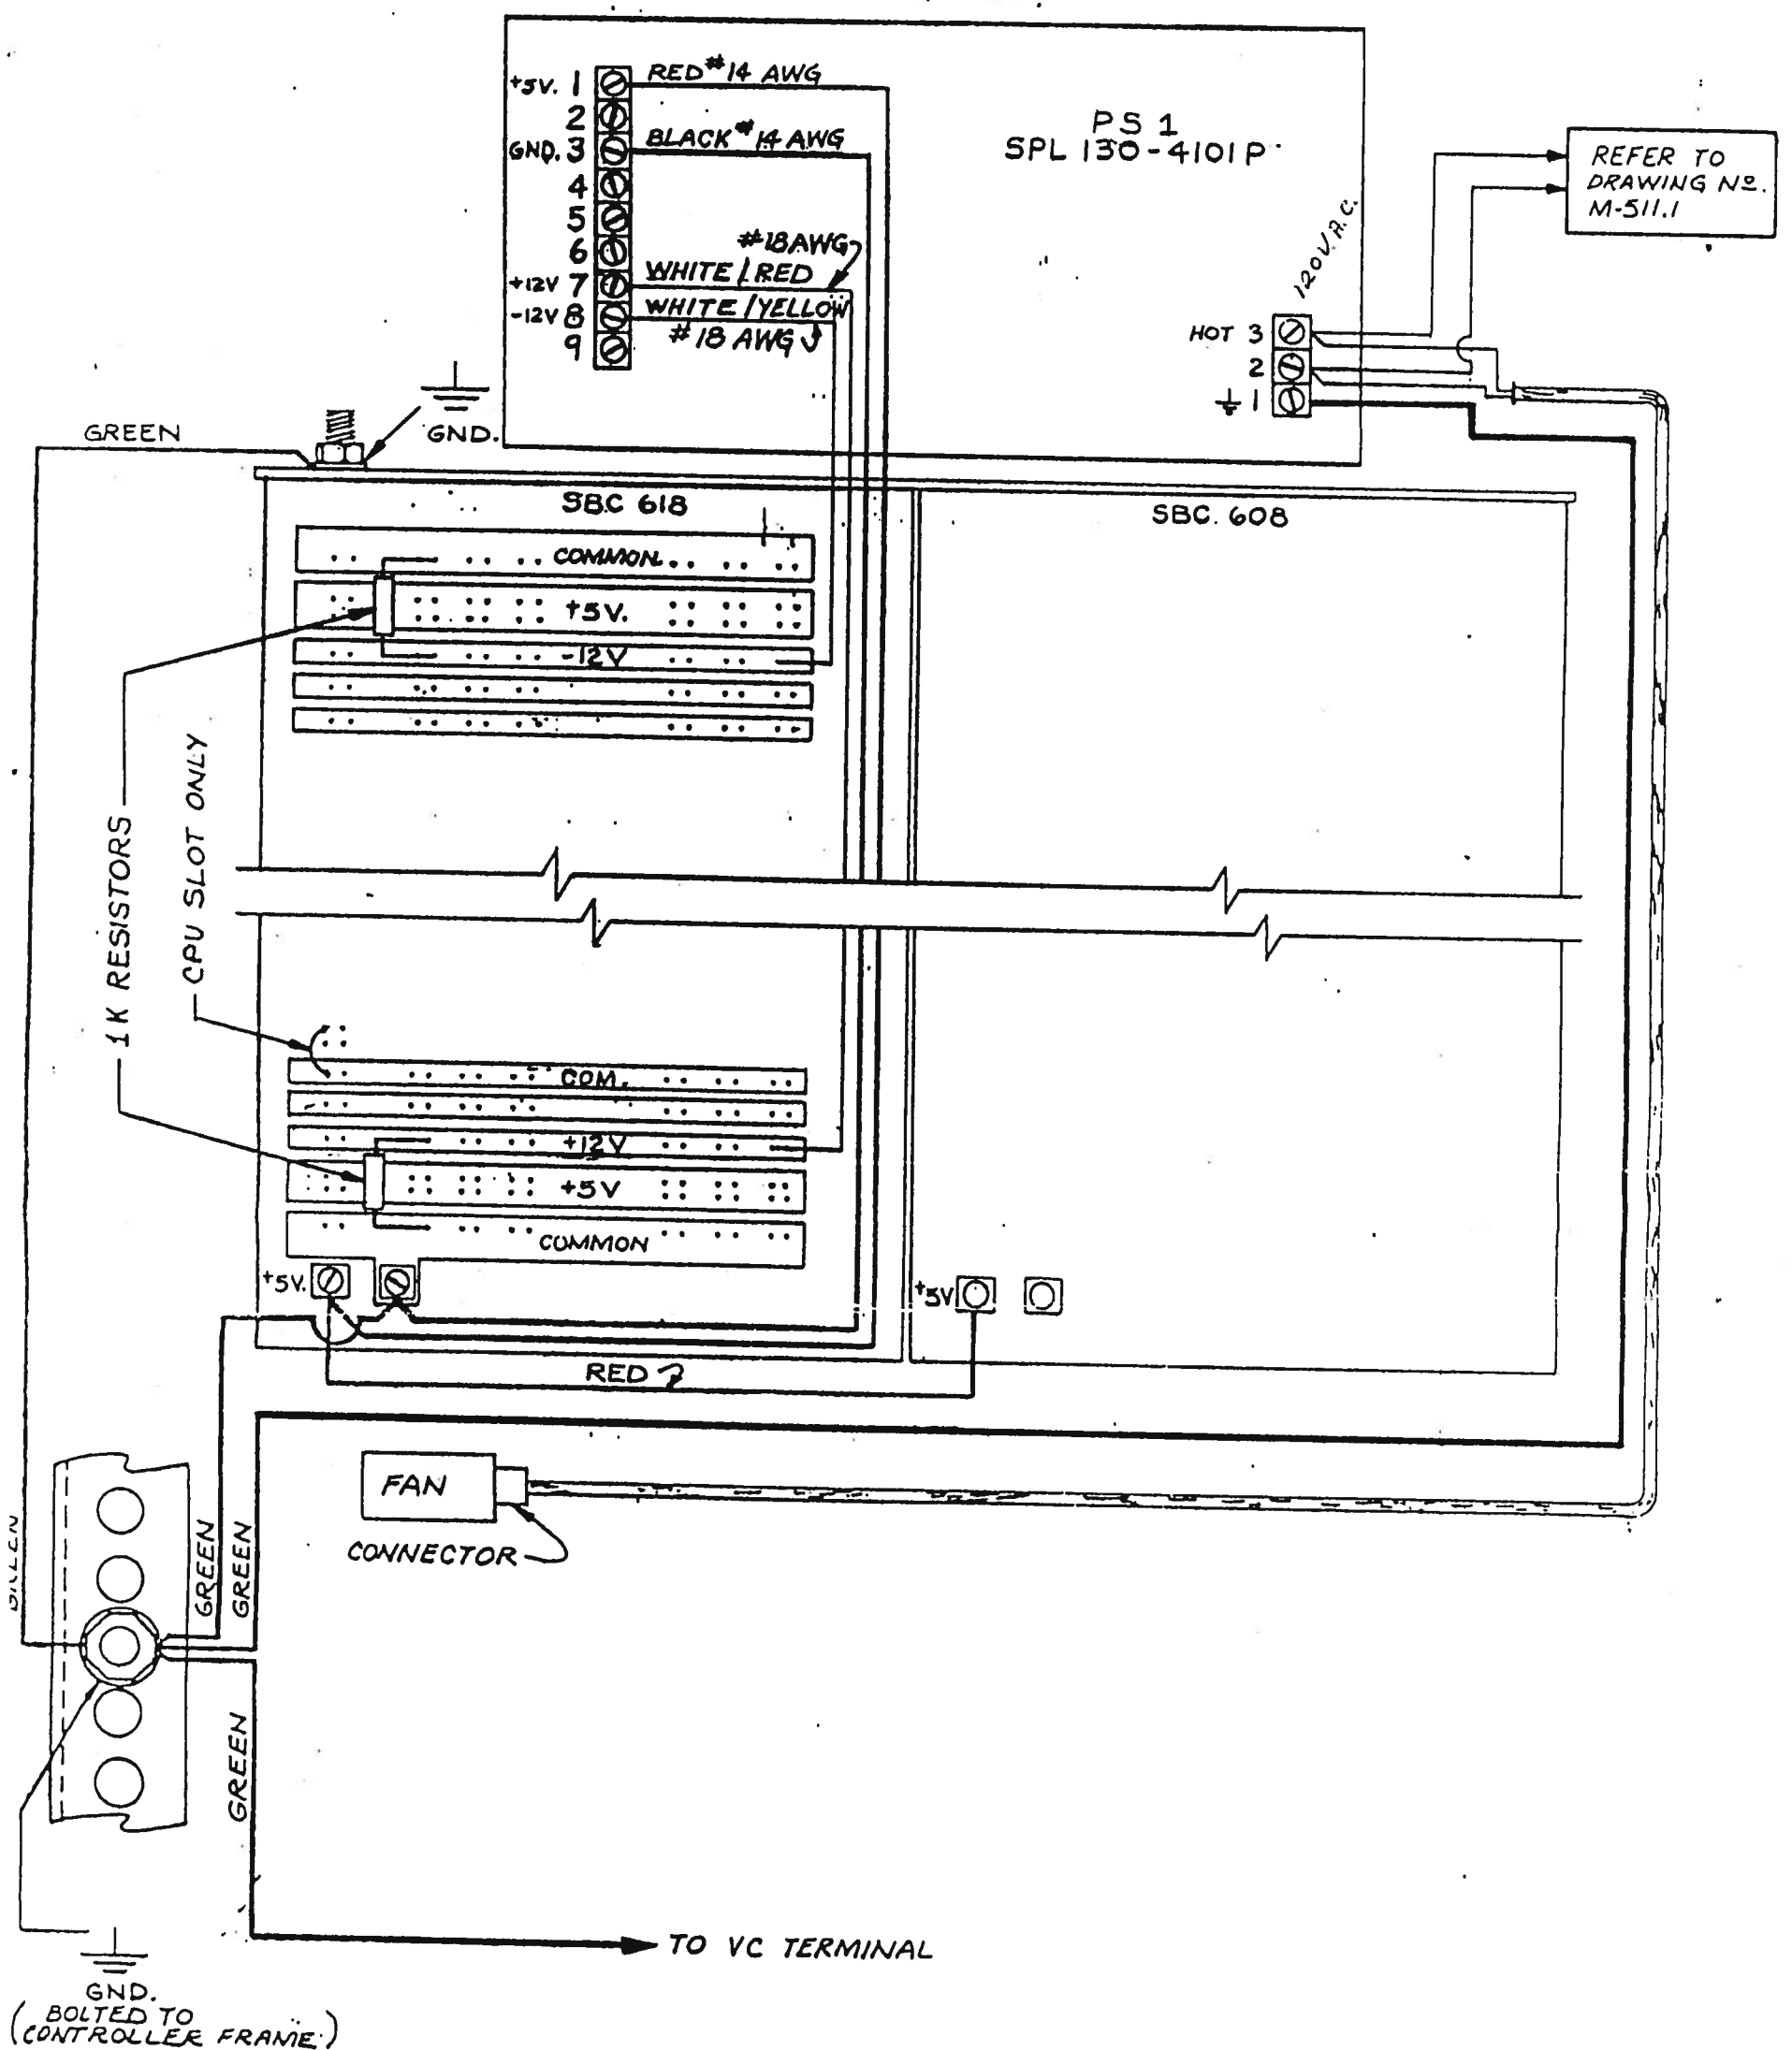

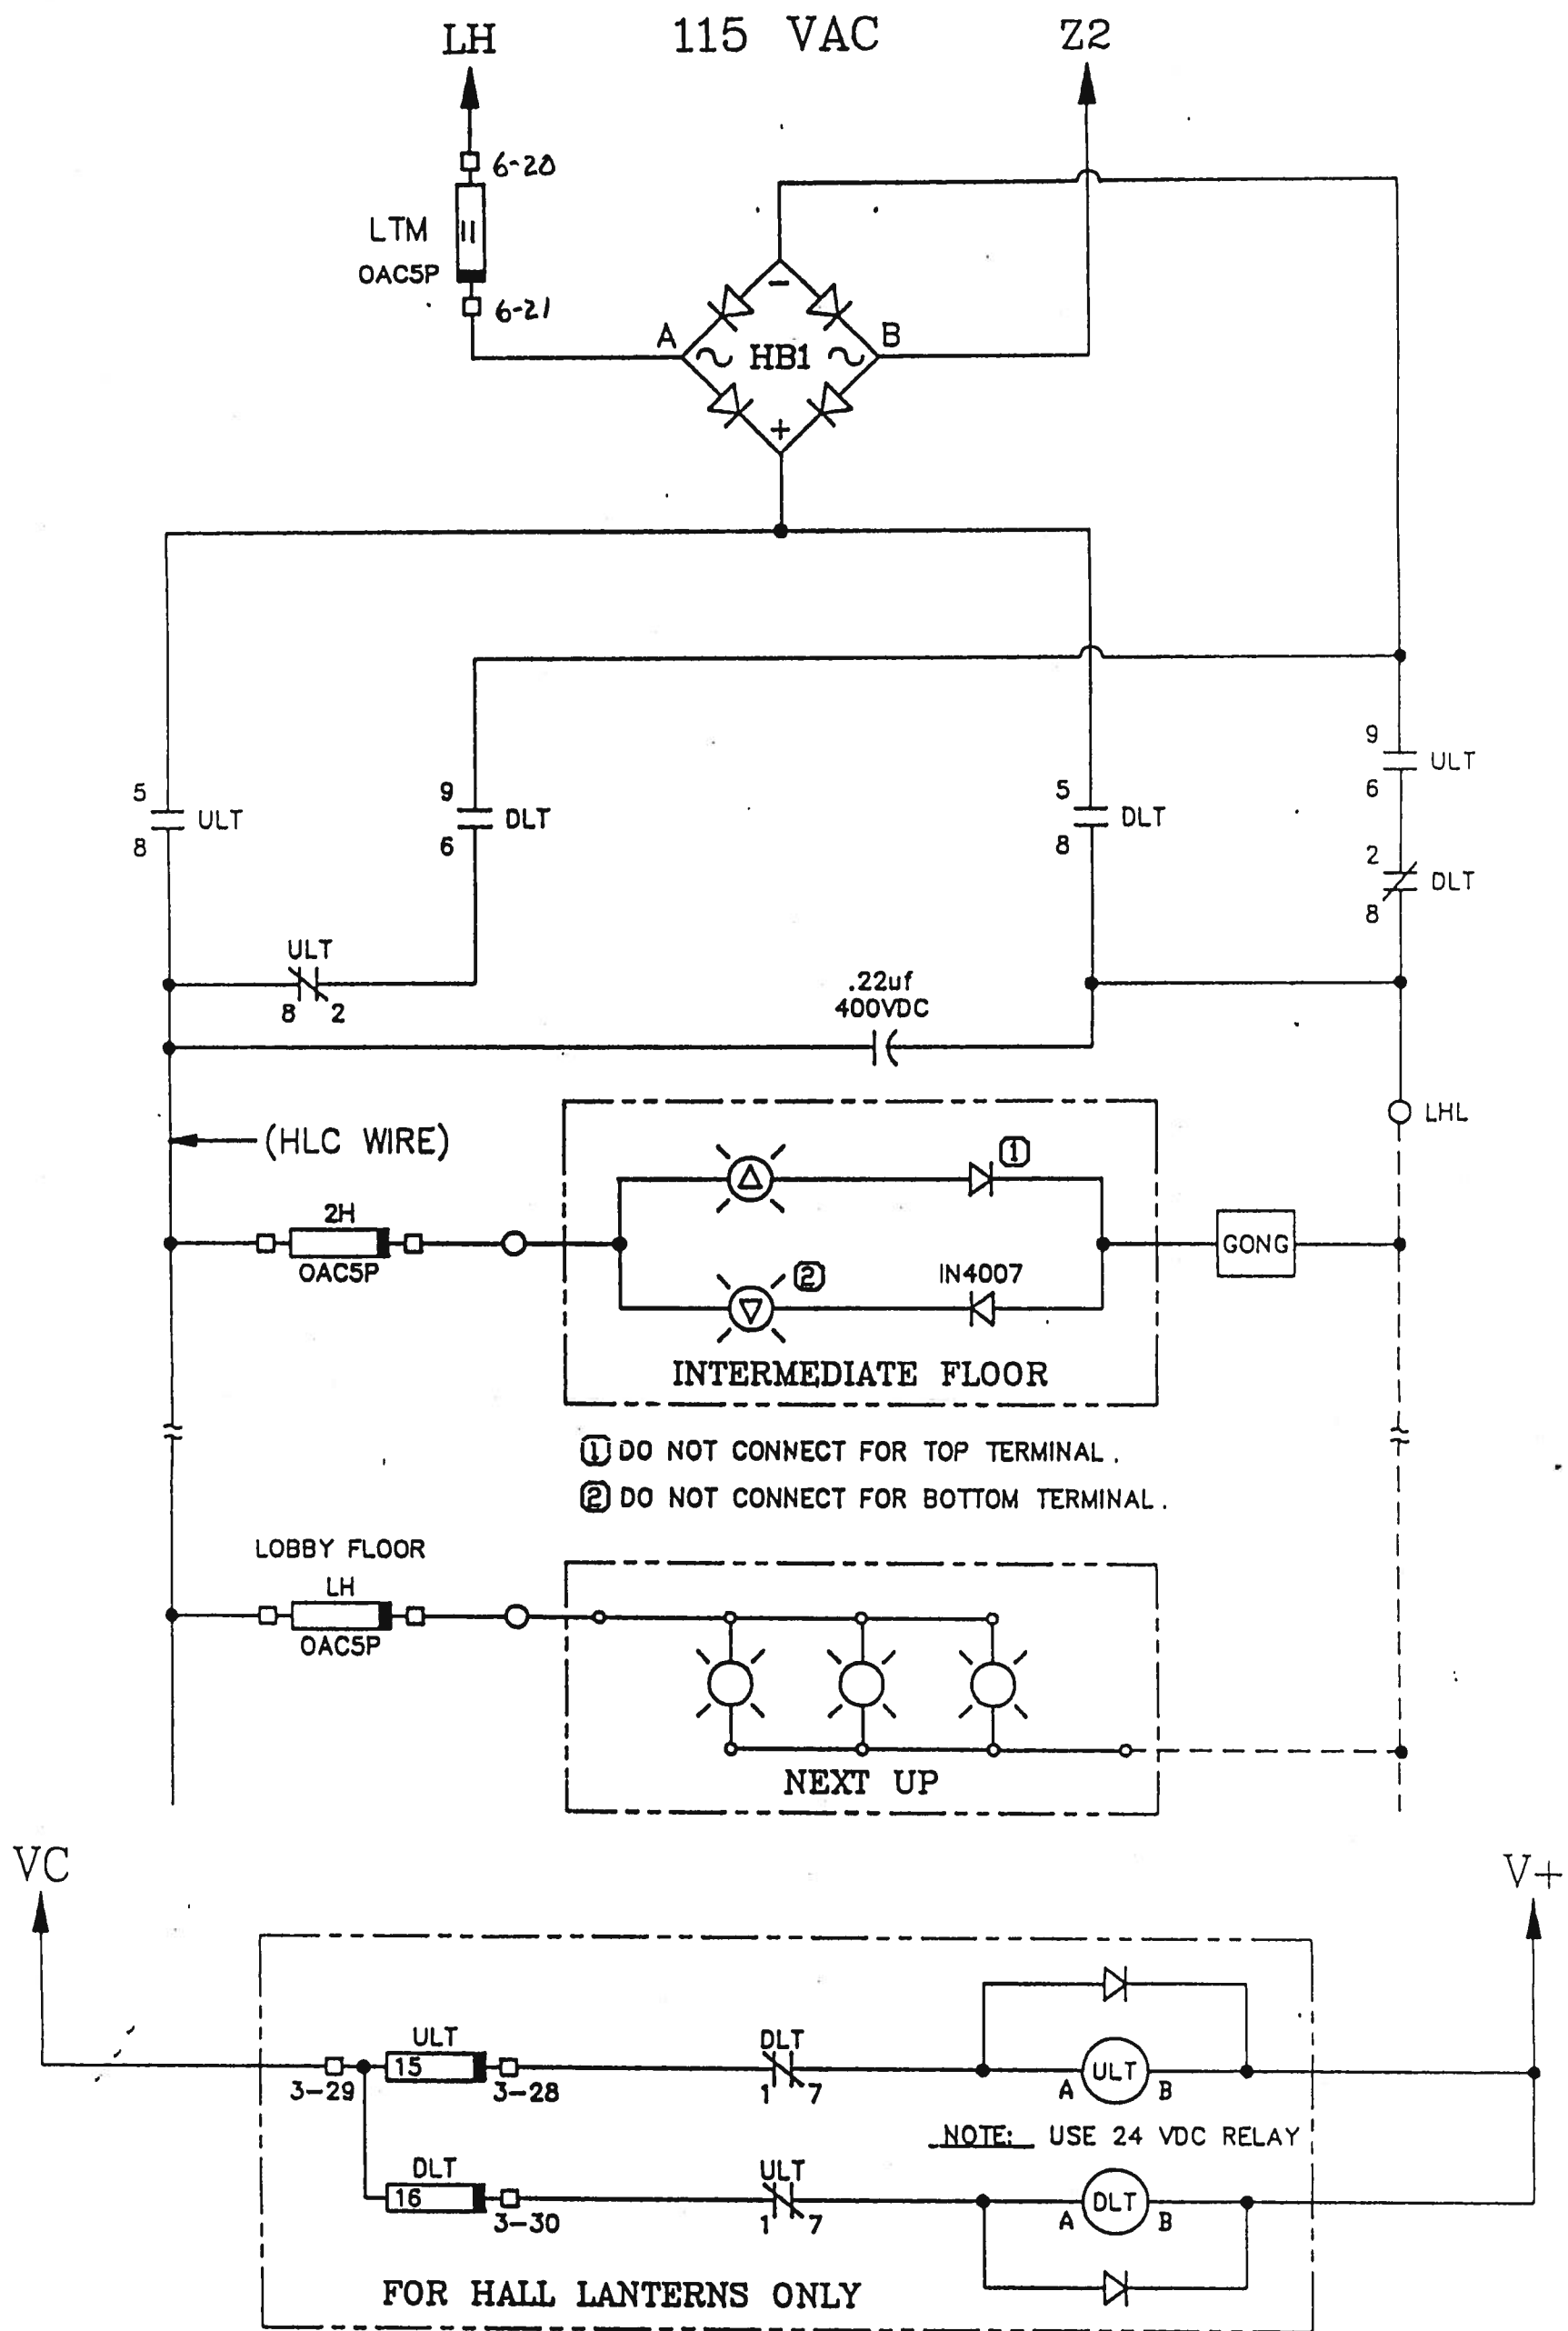


115 VOLTS AC HALL LANTERN CIRCUIT

COMPUTERIZED ELEVATOR CONTROL CORP.	DATE	RECORD CHANGES
636 11TH AVENUE NEW YORK, NEW YORK 10036 TEL. (212) 397-0606		
BUILDING: V.A.M.C.		
LOCATION: PERRY POINT MD.		
CONTRACTOR: ELEX ELEVATOR		
CAR NO. 1 #2	DATE: 1-11-88	
DRAWING NO. MG501-1	JOB NO. 1406	

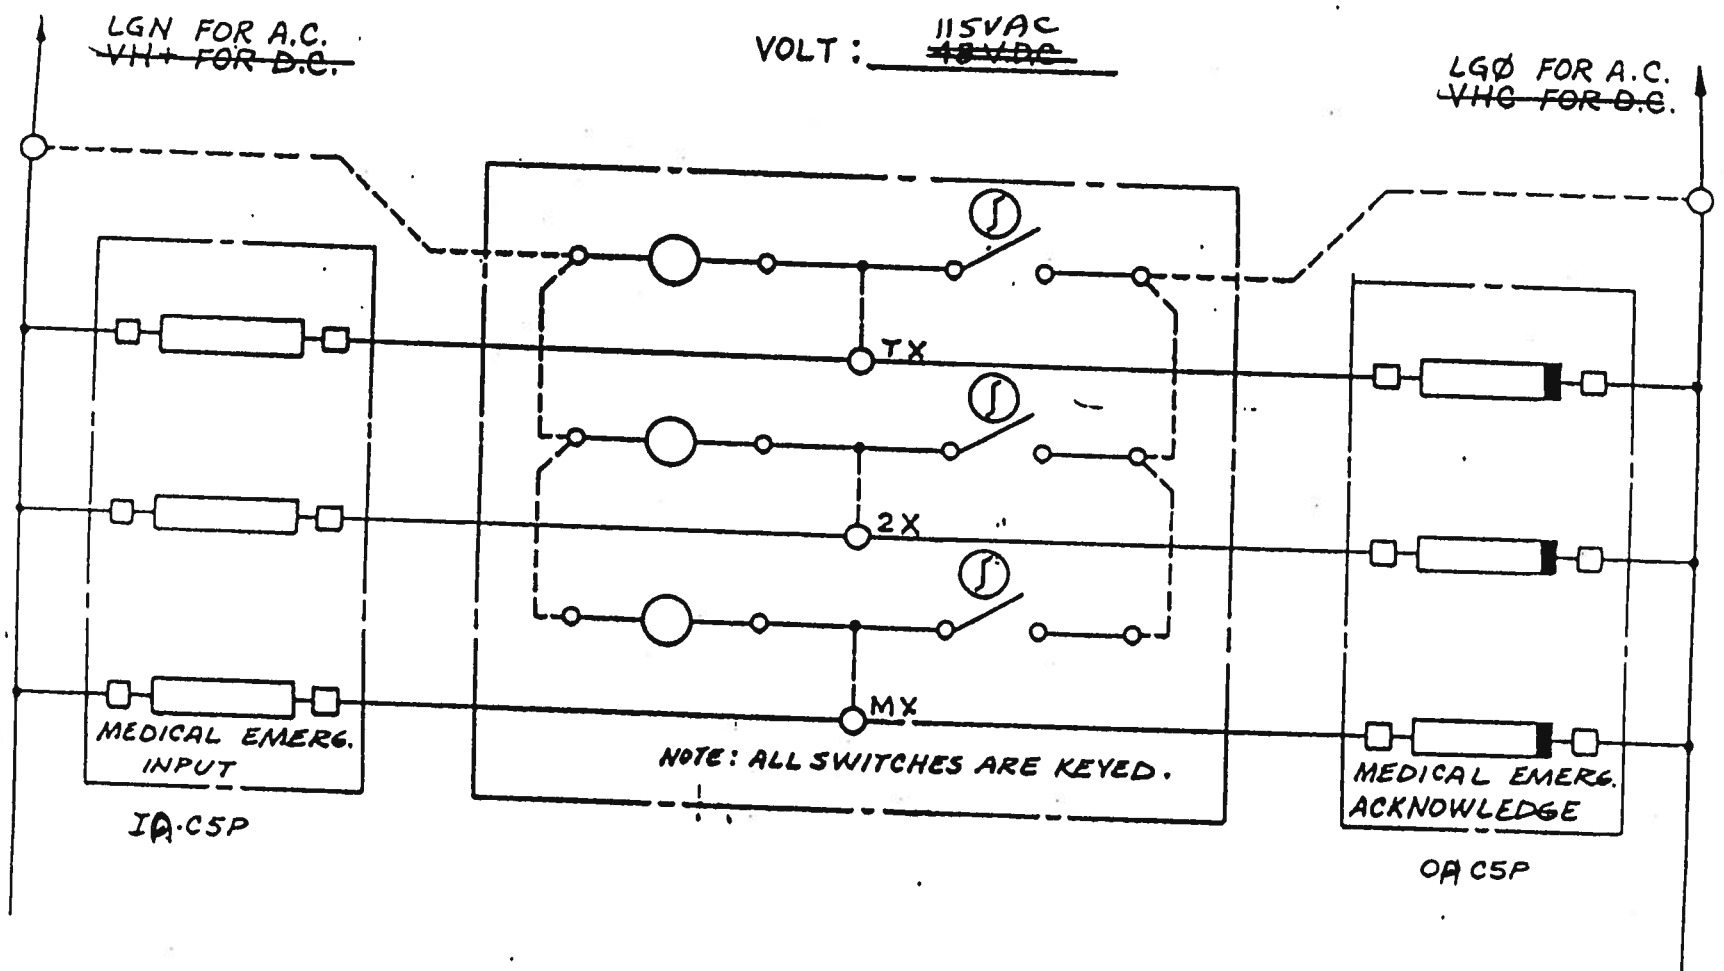

MEDICAL EMERGENCY
HOISTWAY INTERFACE WIRING

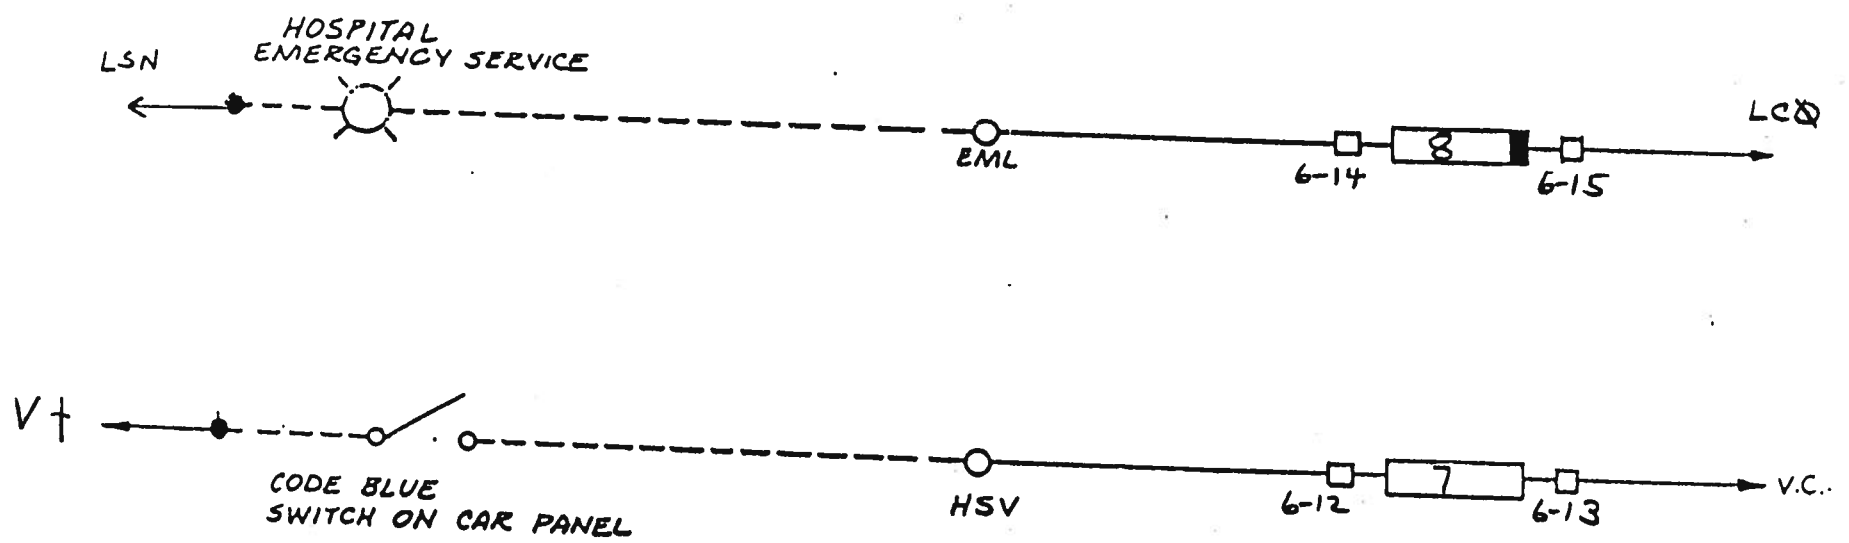

MEDICAL EMERGENCY SWITCH & JEWEL.

5C4550-A

DRWG. NO. W.D. 201.1,2






"CODE BLUE"

JOB NO. 1406

DATE: 1-11-88


PAGE OF

REF: V.A.M.C. PERRY POINT

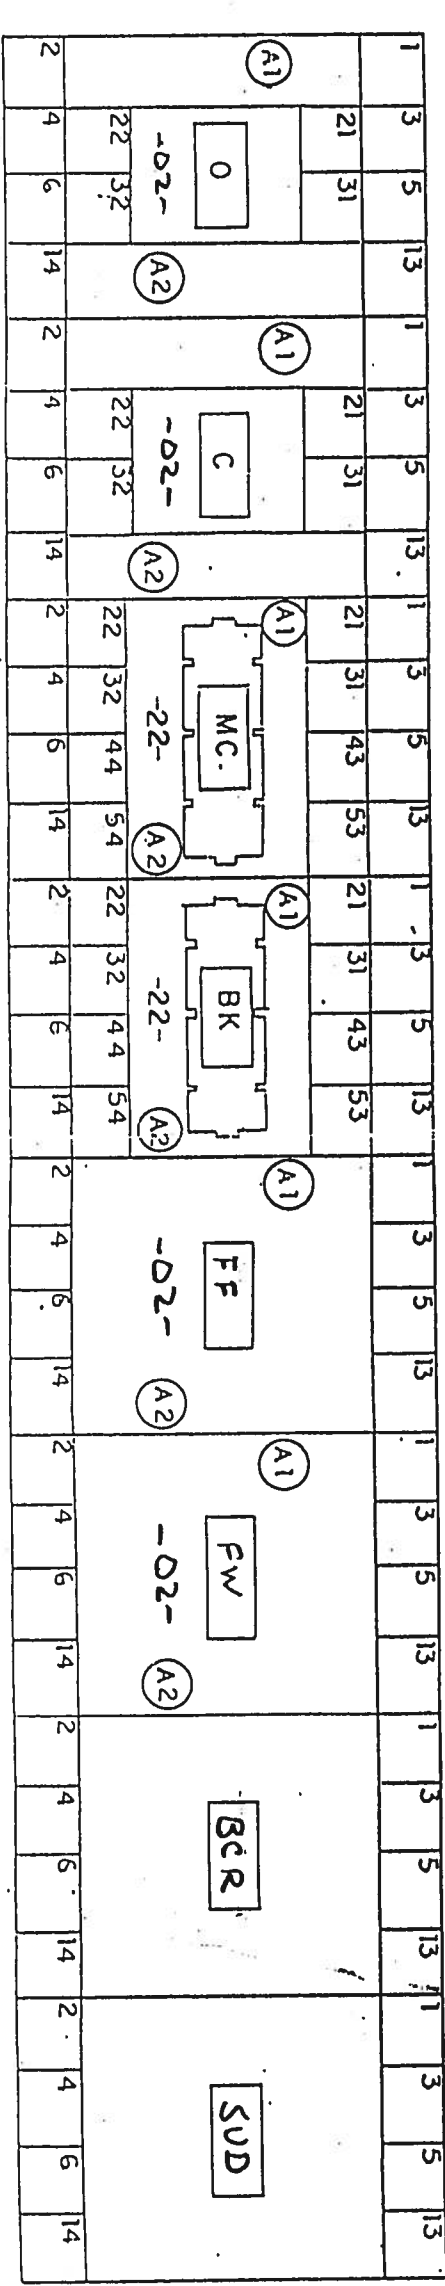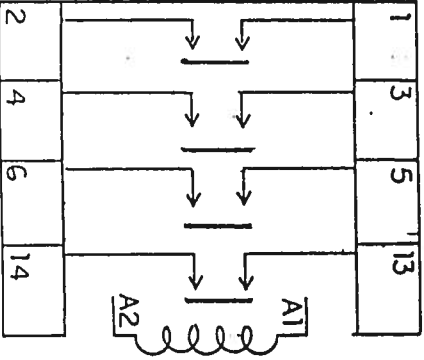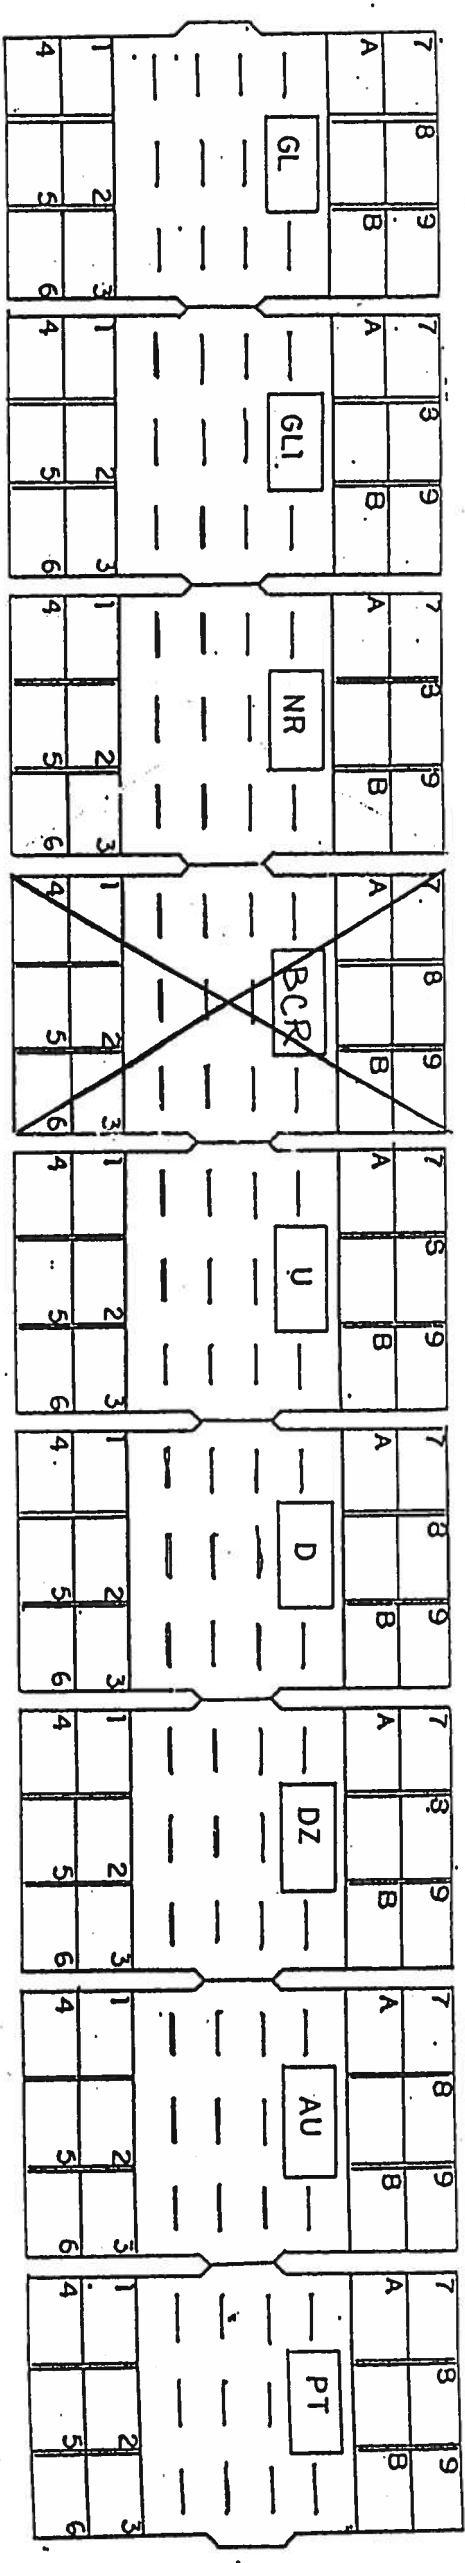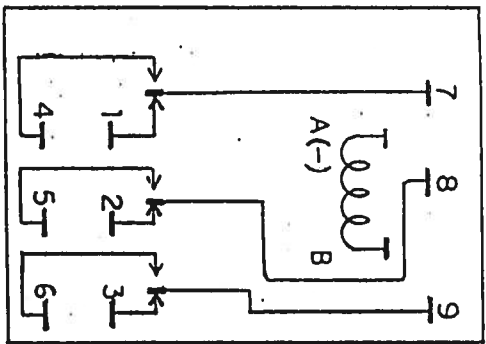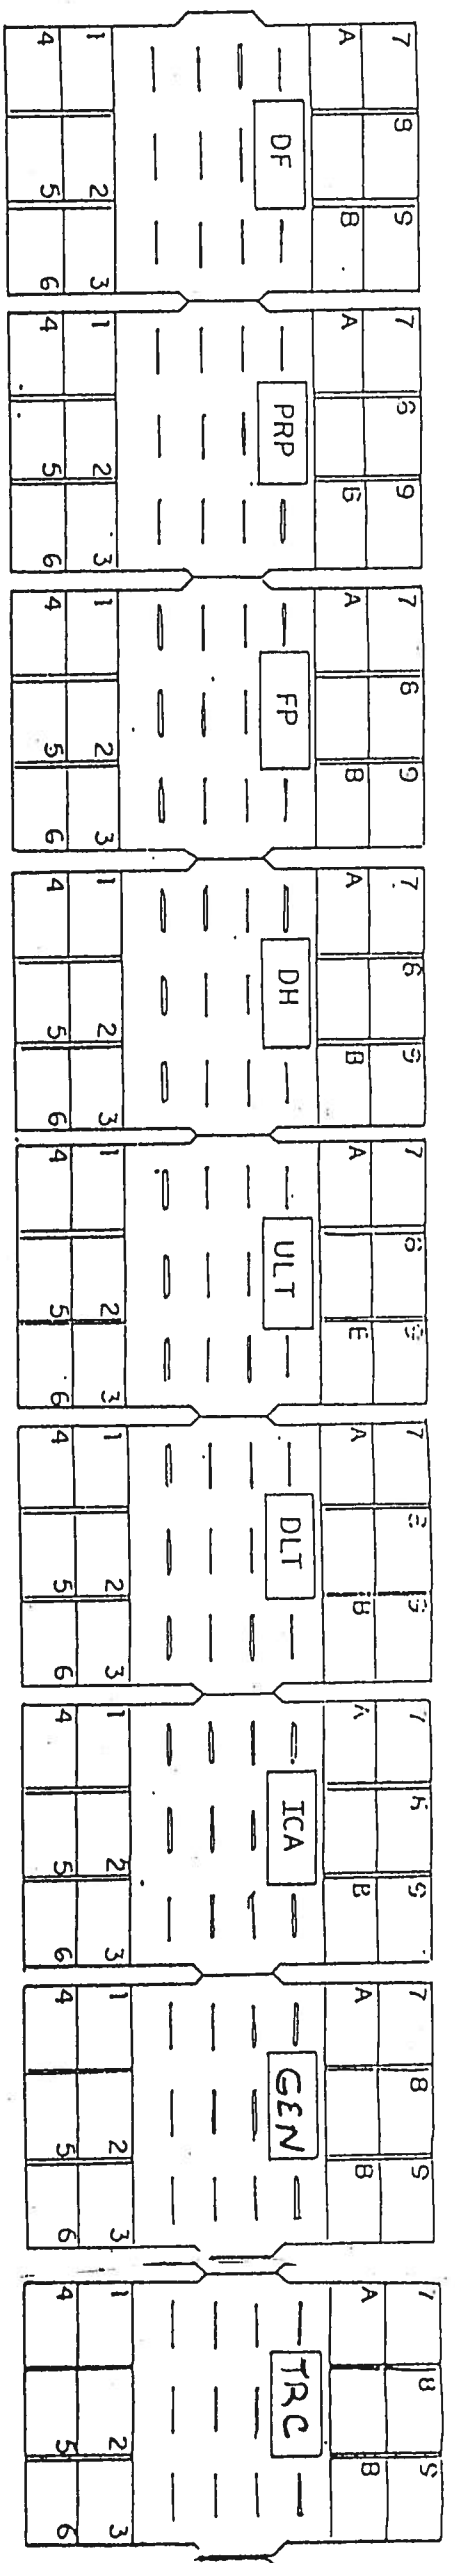

MAIN LINE
SERVICE
DISCONNECT
SWITCH
(PROVIDED BY OTHERS)
480 VOLTS

3 PHASE
FUSE BLOCK

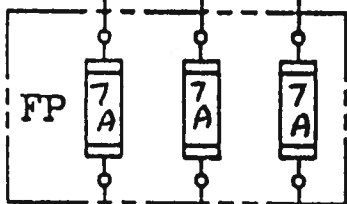

H1 H2 H3

11 12 13 14 15
208 230 240 460 480

21 22 23 24 25
208 230 240 460 480

31 32 33 34 35
208 230 240 460 480

PART NUMBER 3T84721

Z1 Z2

Y1



Y2

X0



X1

X2

X3

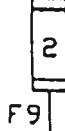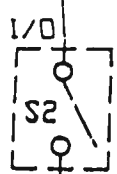


LH Z2
LANTERN

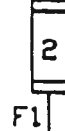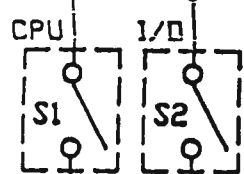

SCPU




SV

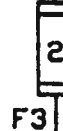


LL

BLOWER

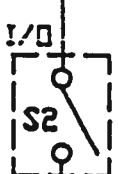

LCS

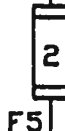

LSN

LC0

X0

FRAME


(GREEN)

(GREEN)

(GREEN)


VC

TO CAR CAGE

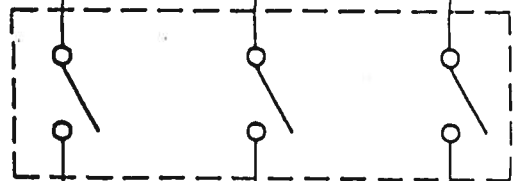


CB1
SIZE 15 AMPS

L11

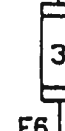


D11

L12

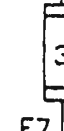

D12

L13

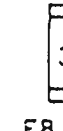

D13

DOOR OPERATOR

POWER DISTRIBUTION

COMPUTERIZED ELEVATOR CONTROL CORP.

636 11TH AVENUE NEW YORK, NEW YORK 10036 TEL (212) 397-0606

BUILDING: V.A.M.C.

LOCATION: PERRY POINT MD

CONTRACTOR: ELEX ELEVATOR

CAR NO. 1#2


DATE: 1-11-88

DRAWING NO. MG452-2

JOB NO. 1406

DATE

RECORD CHANGES

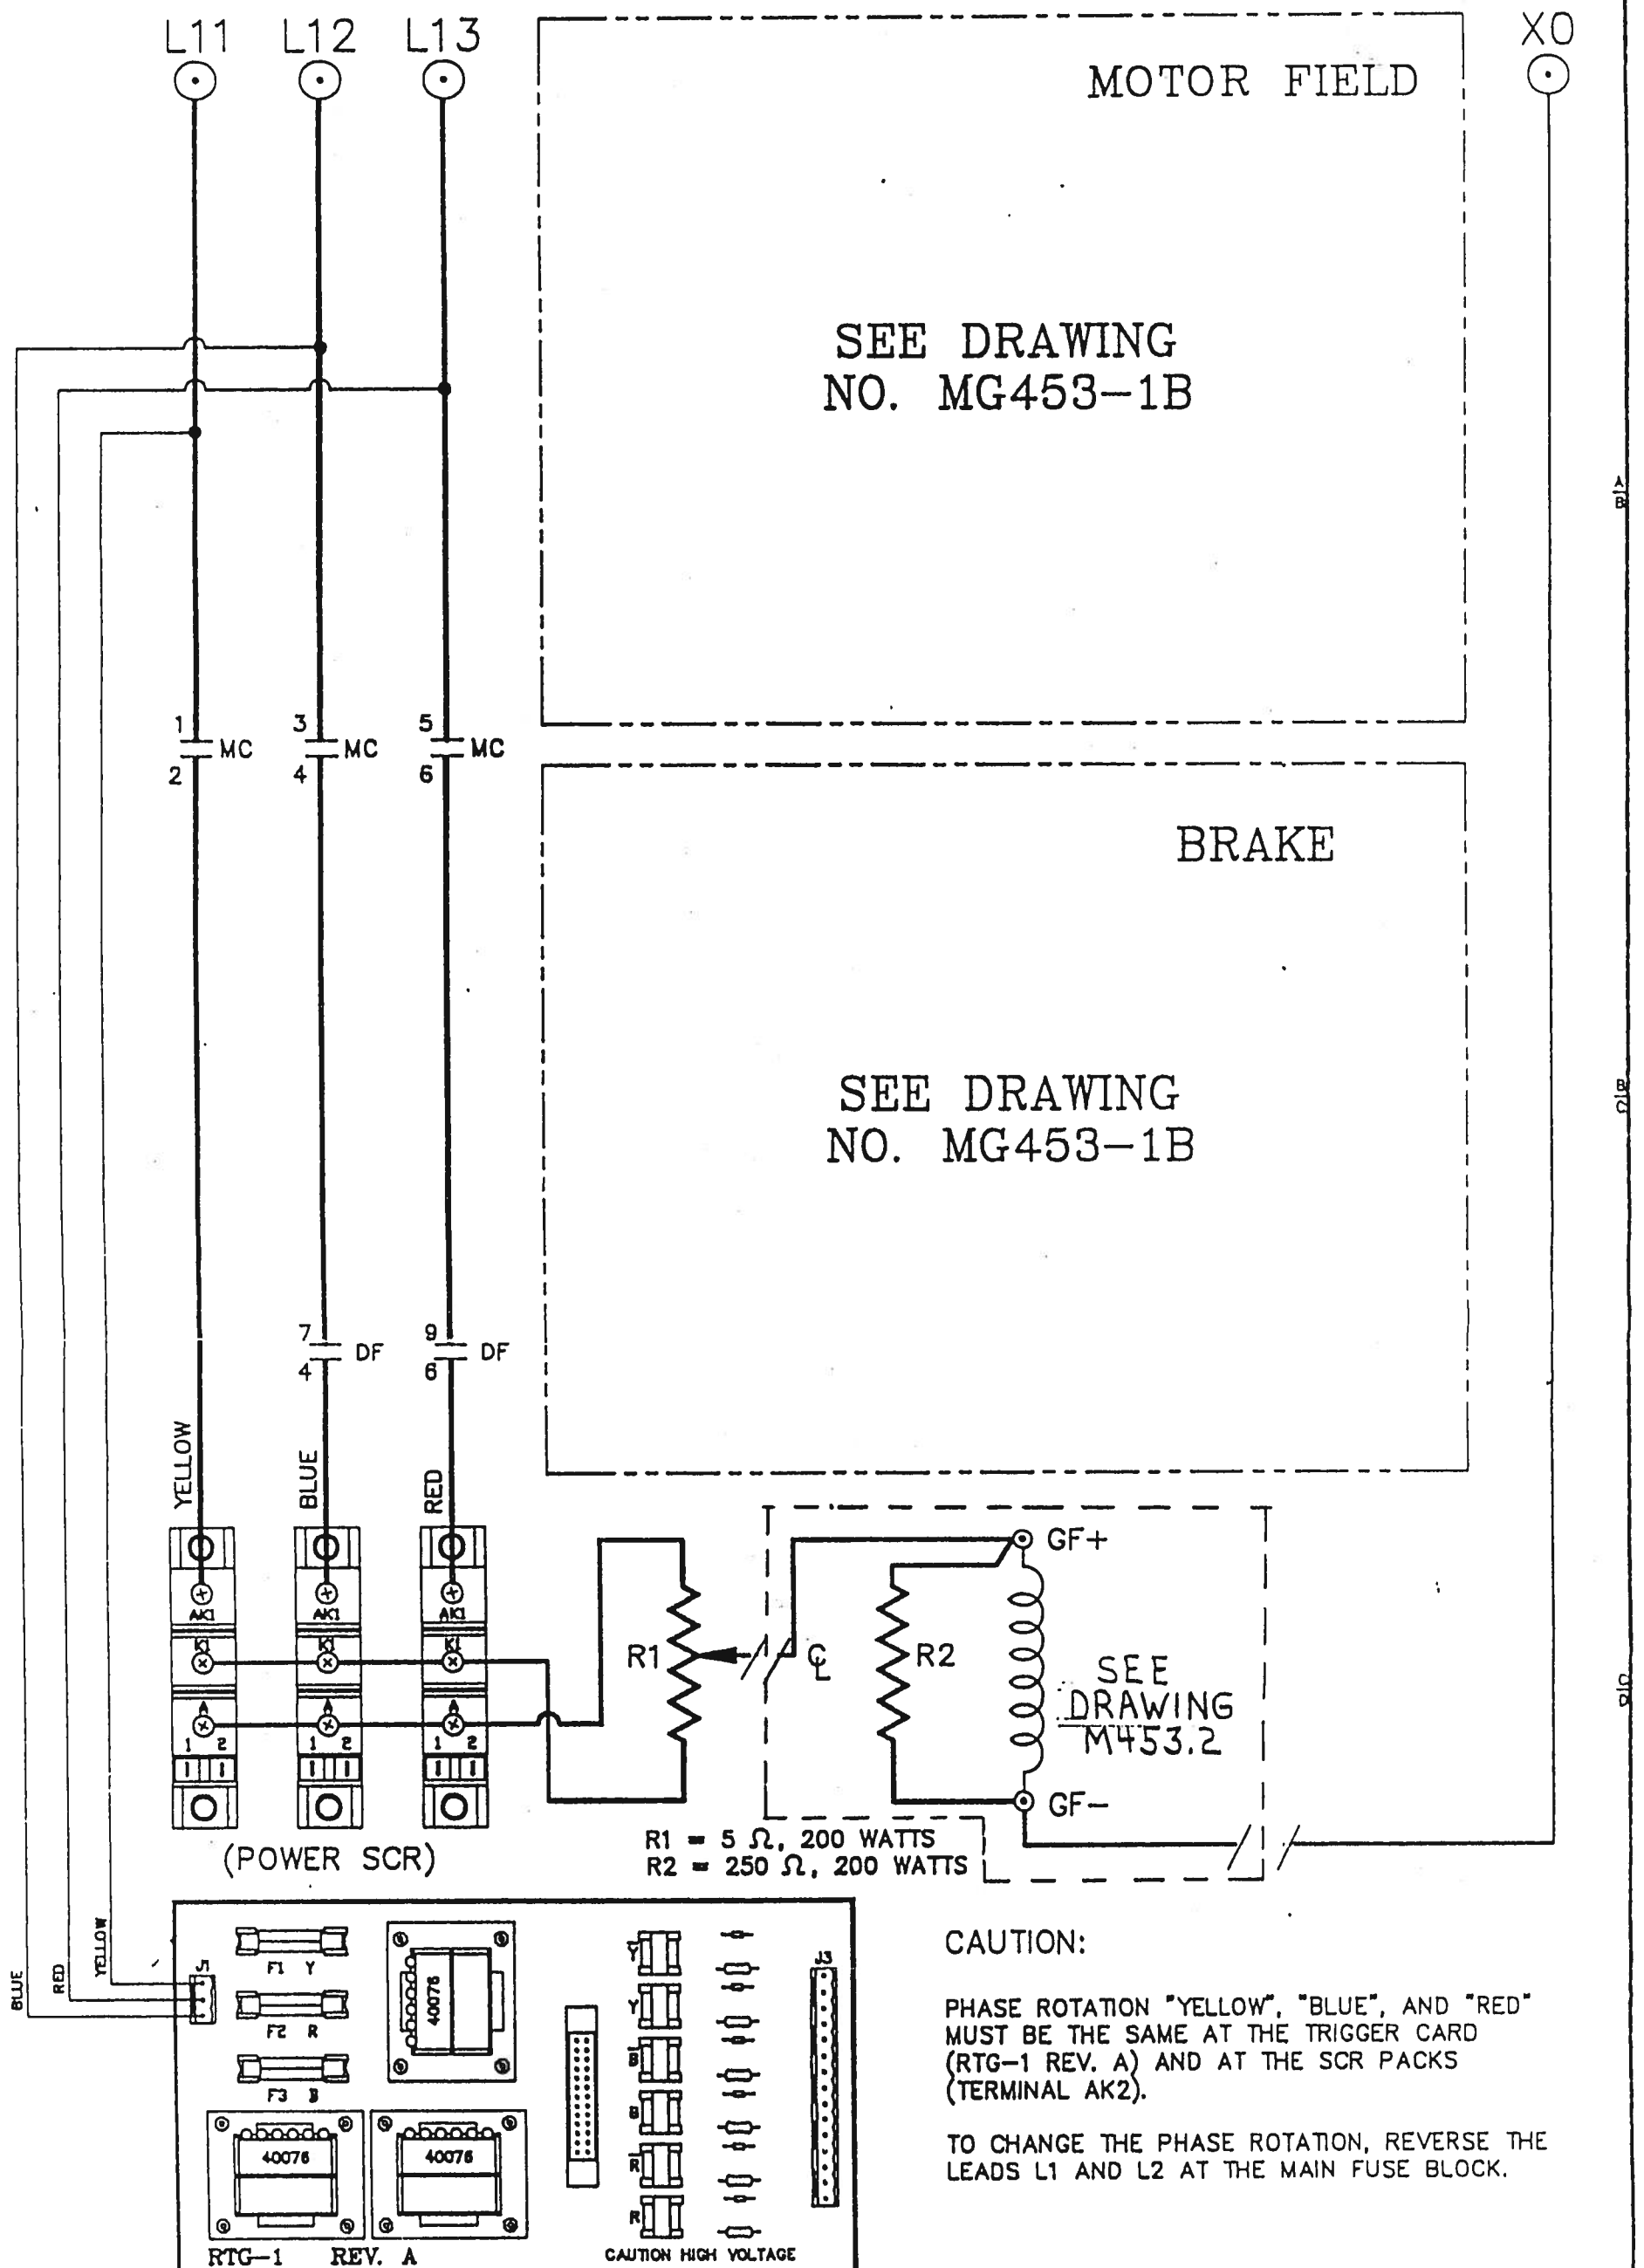

POWER CONTROL

COMPUTERIZED ELEVATOR CONTROL CORP.

636 11TH AVENUE NEW YORK, NEW YORK 10036 TEL (212) 397-0606

BUILDING: V. A. M. C.

LOCATION: PERRY POINT MD.

CONTRACTOR: ELEX ELEVATOR

CAR NO. 122

DATE: 1-11-88

DRAWING NO. MG453-1A

JOB NO. 1406

DATE _____

RECORD CHANGES

CAUTION:

PHASE ROTATION "YELLOW", "BLUE", AND "RED"
MUST BE THE SAME AT THE TRIGGER CARD
(RTG-1 REV. A) AND AT THE SCR PACKS
(TERMINAL AK2).

TO CHANGE THE PHASE ROTATION, REVERSE THE
LEADS L1 AND L2 AT THE MAIN FUSE BLOCK.

DRIVE LOGIC INTERFACE

RECORD CHANGES

DATE

ADD AUTOMATIC FAULT RESET

9-11-1987

COMPUTERIZED ELEVATOR CONTROL CORP.

636 11TH AVENUE NEW YORK, NEW YORK 10036 TEL. (212) 397-0606

BUILDING: V.B.M.C.

LOCATION: PERRY POINT M.D.

CONTRACTOR: ELEX ELEVATOR


DATE: 1-11-88


CAR NO. 152

JOB NO. 1406

NOTES:

- * TERMINAL IS POSITIVE FOR UP DIRECTION.
- ** IF SHIELDED CABLE IS UNAVAILABLE, CONNECT "V+" TO TOP OF CAR "V+" AND USE A SINGLE WIRE FOR "DP".
- *** USE THREE WIRE JACKETED OR SHIELDED CABLE (16 GA.).

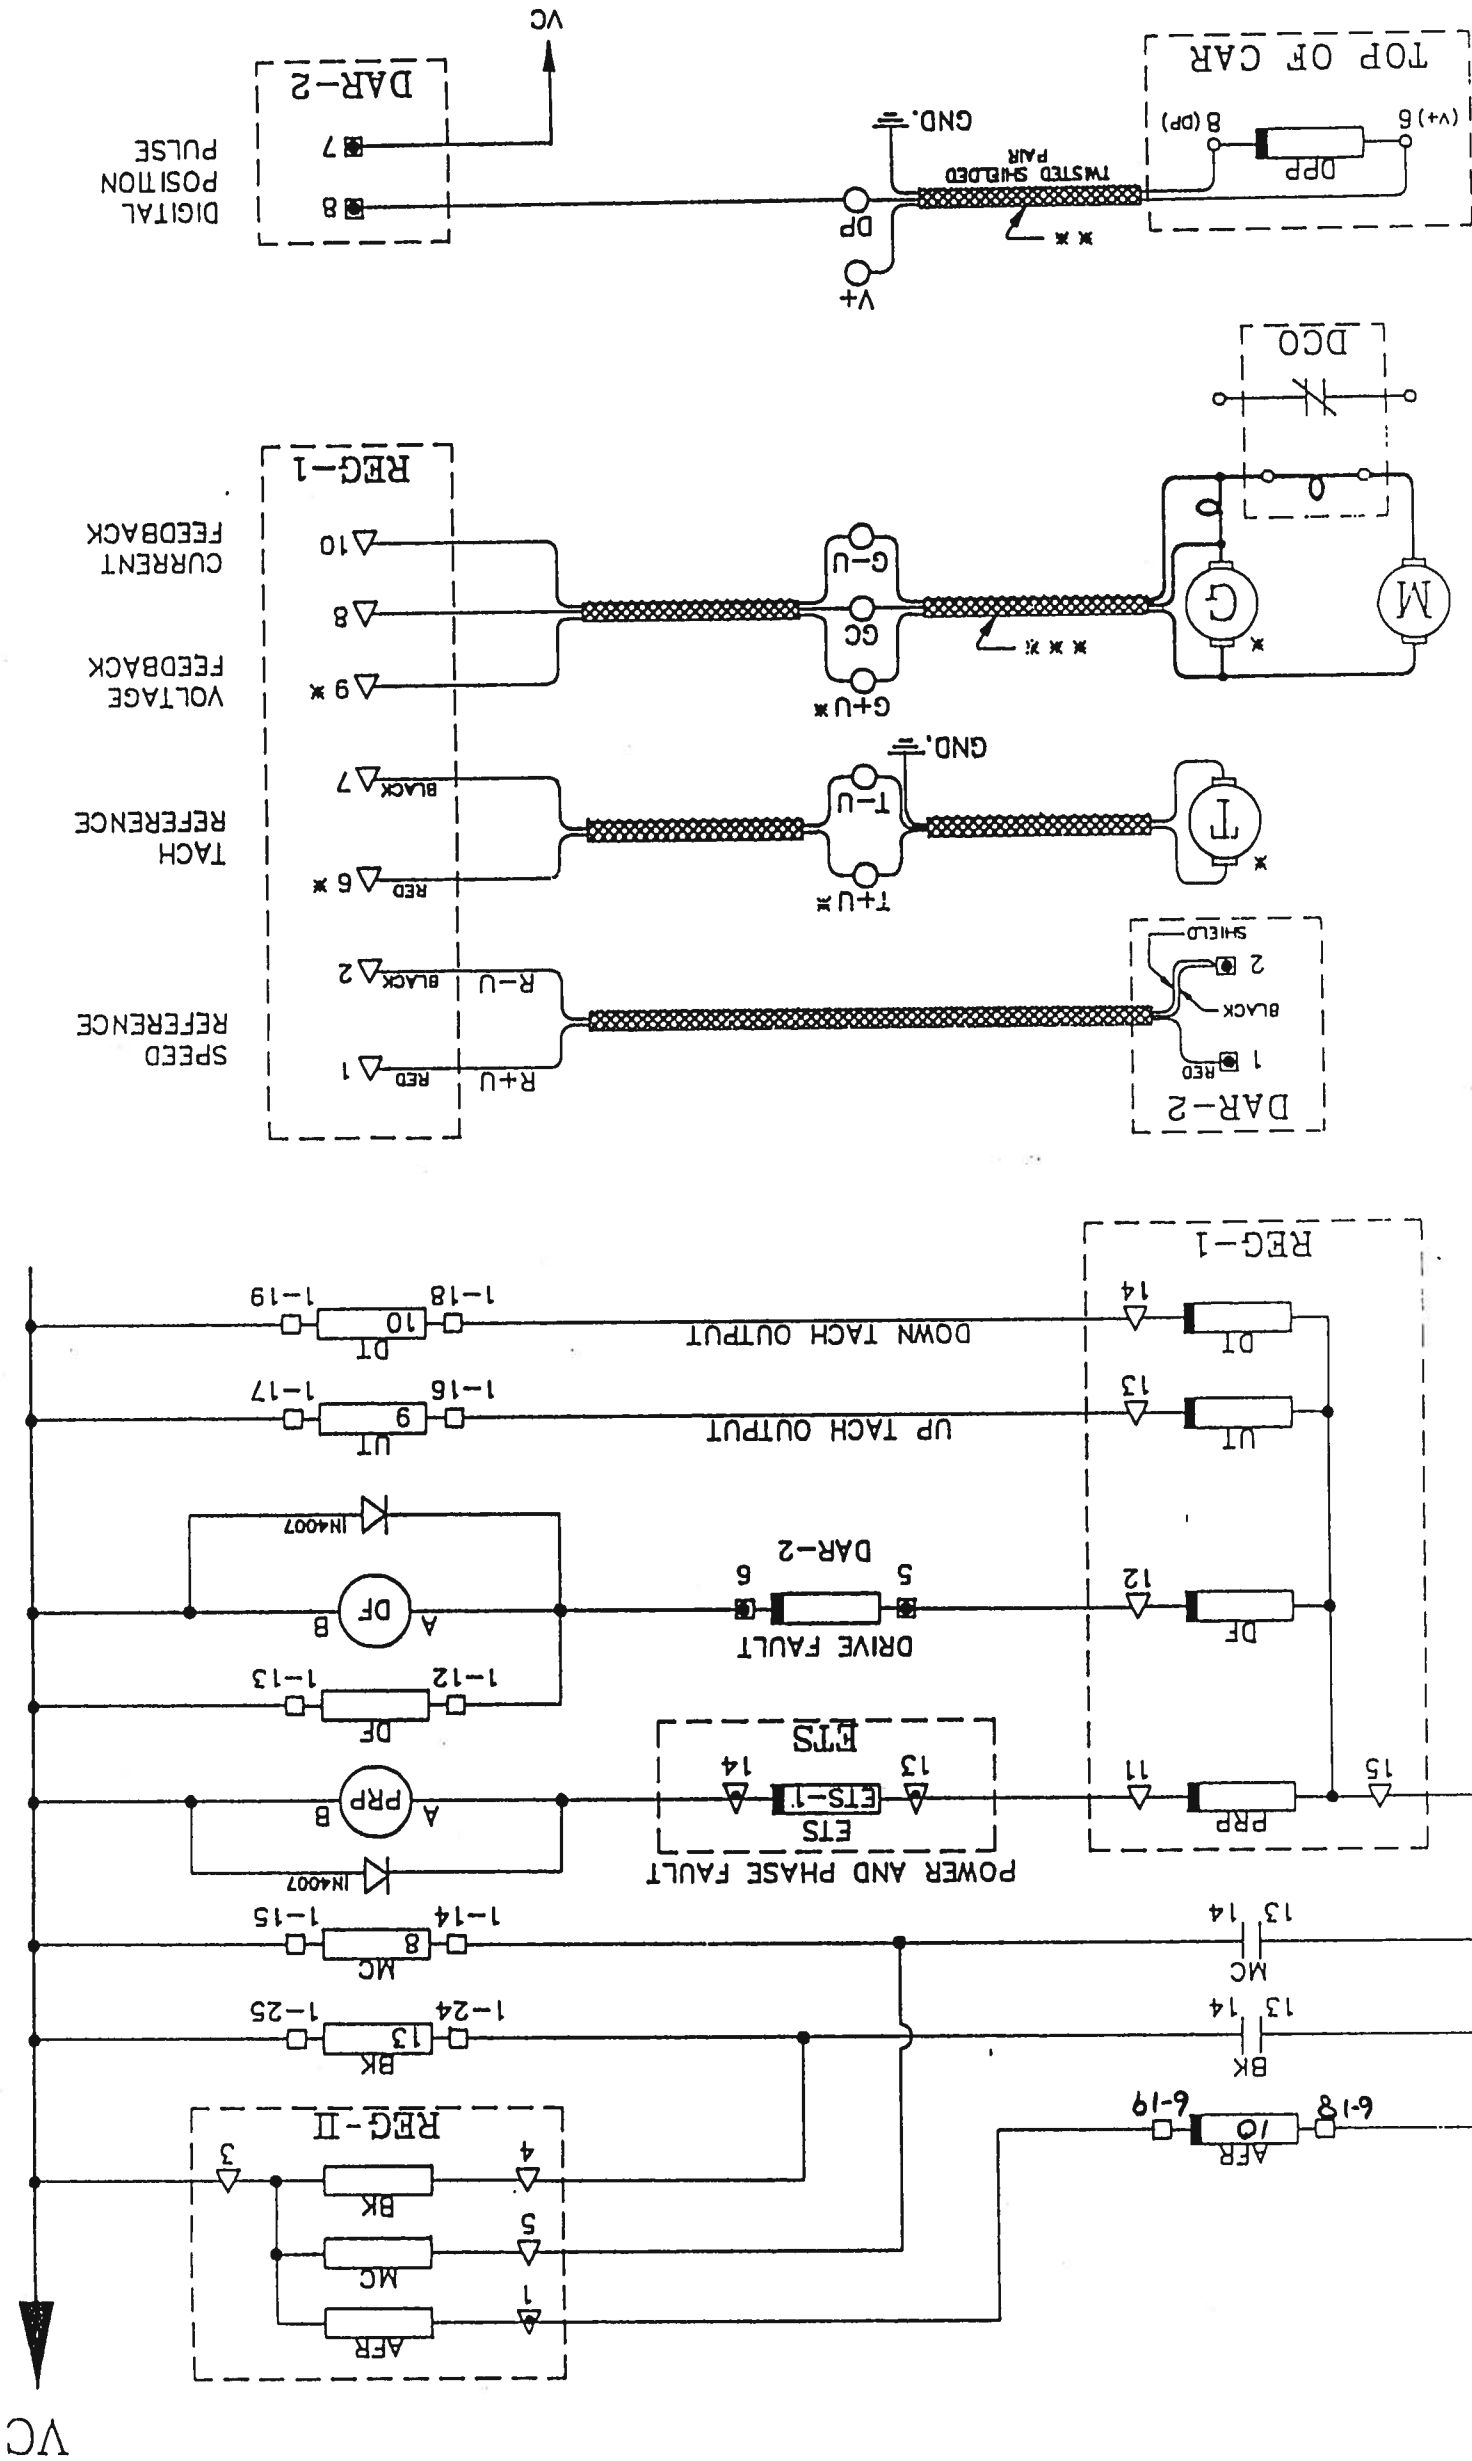


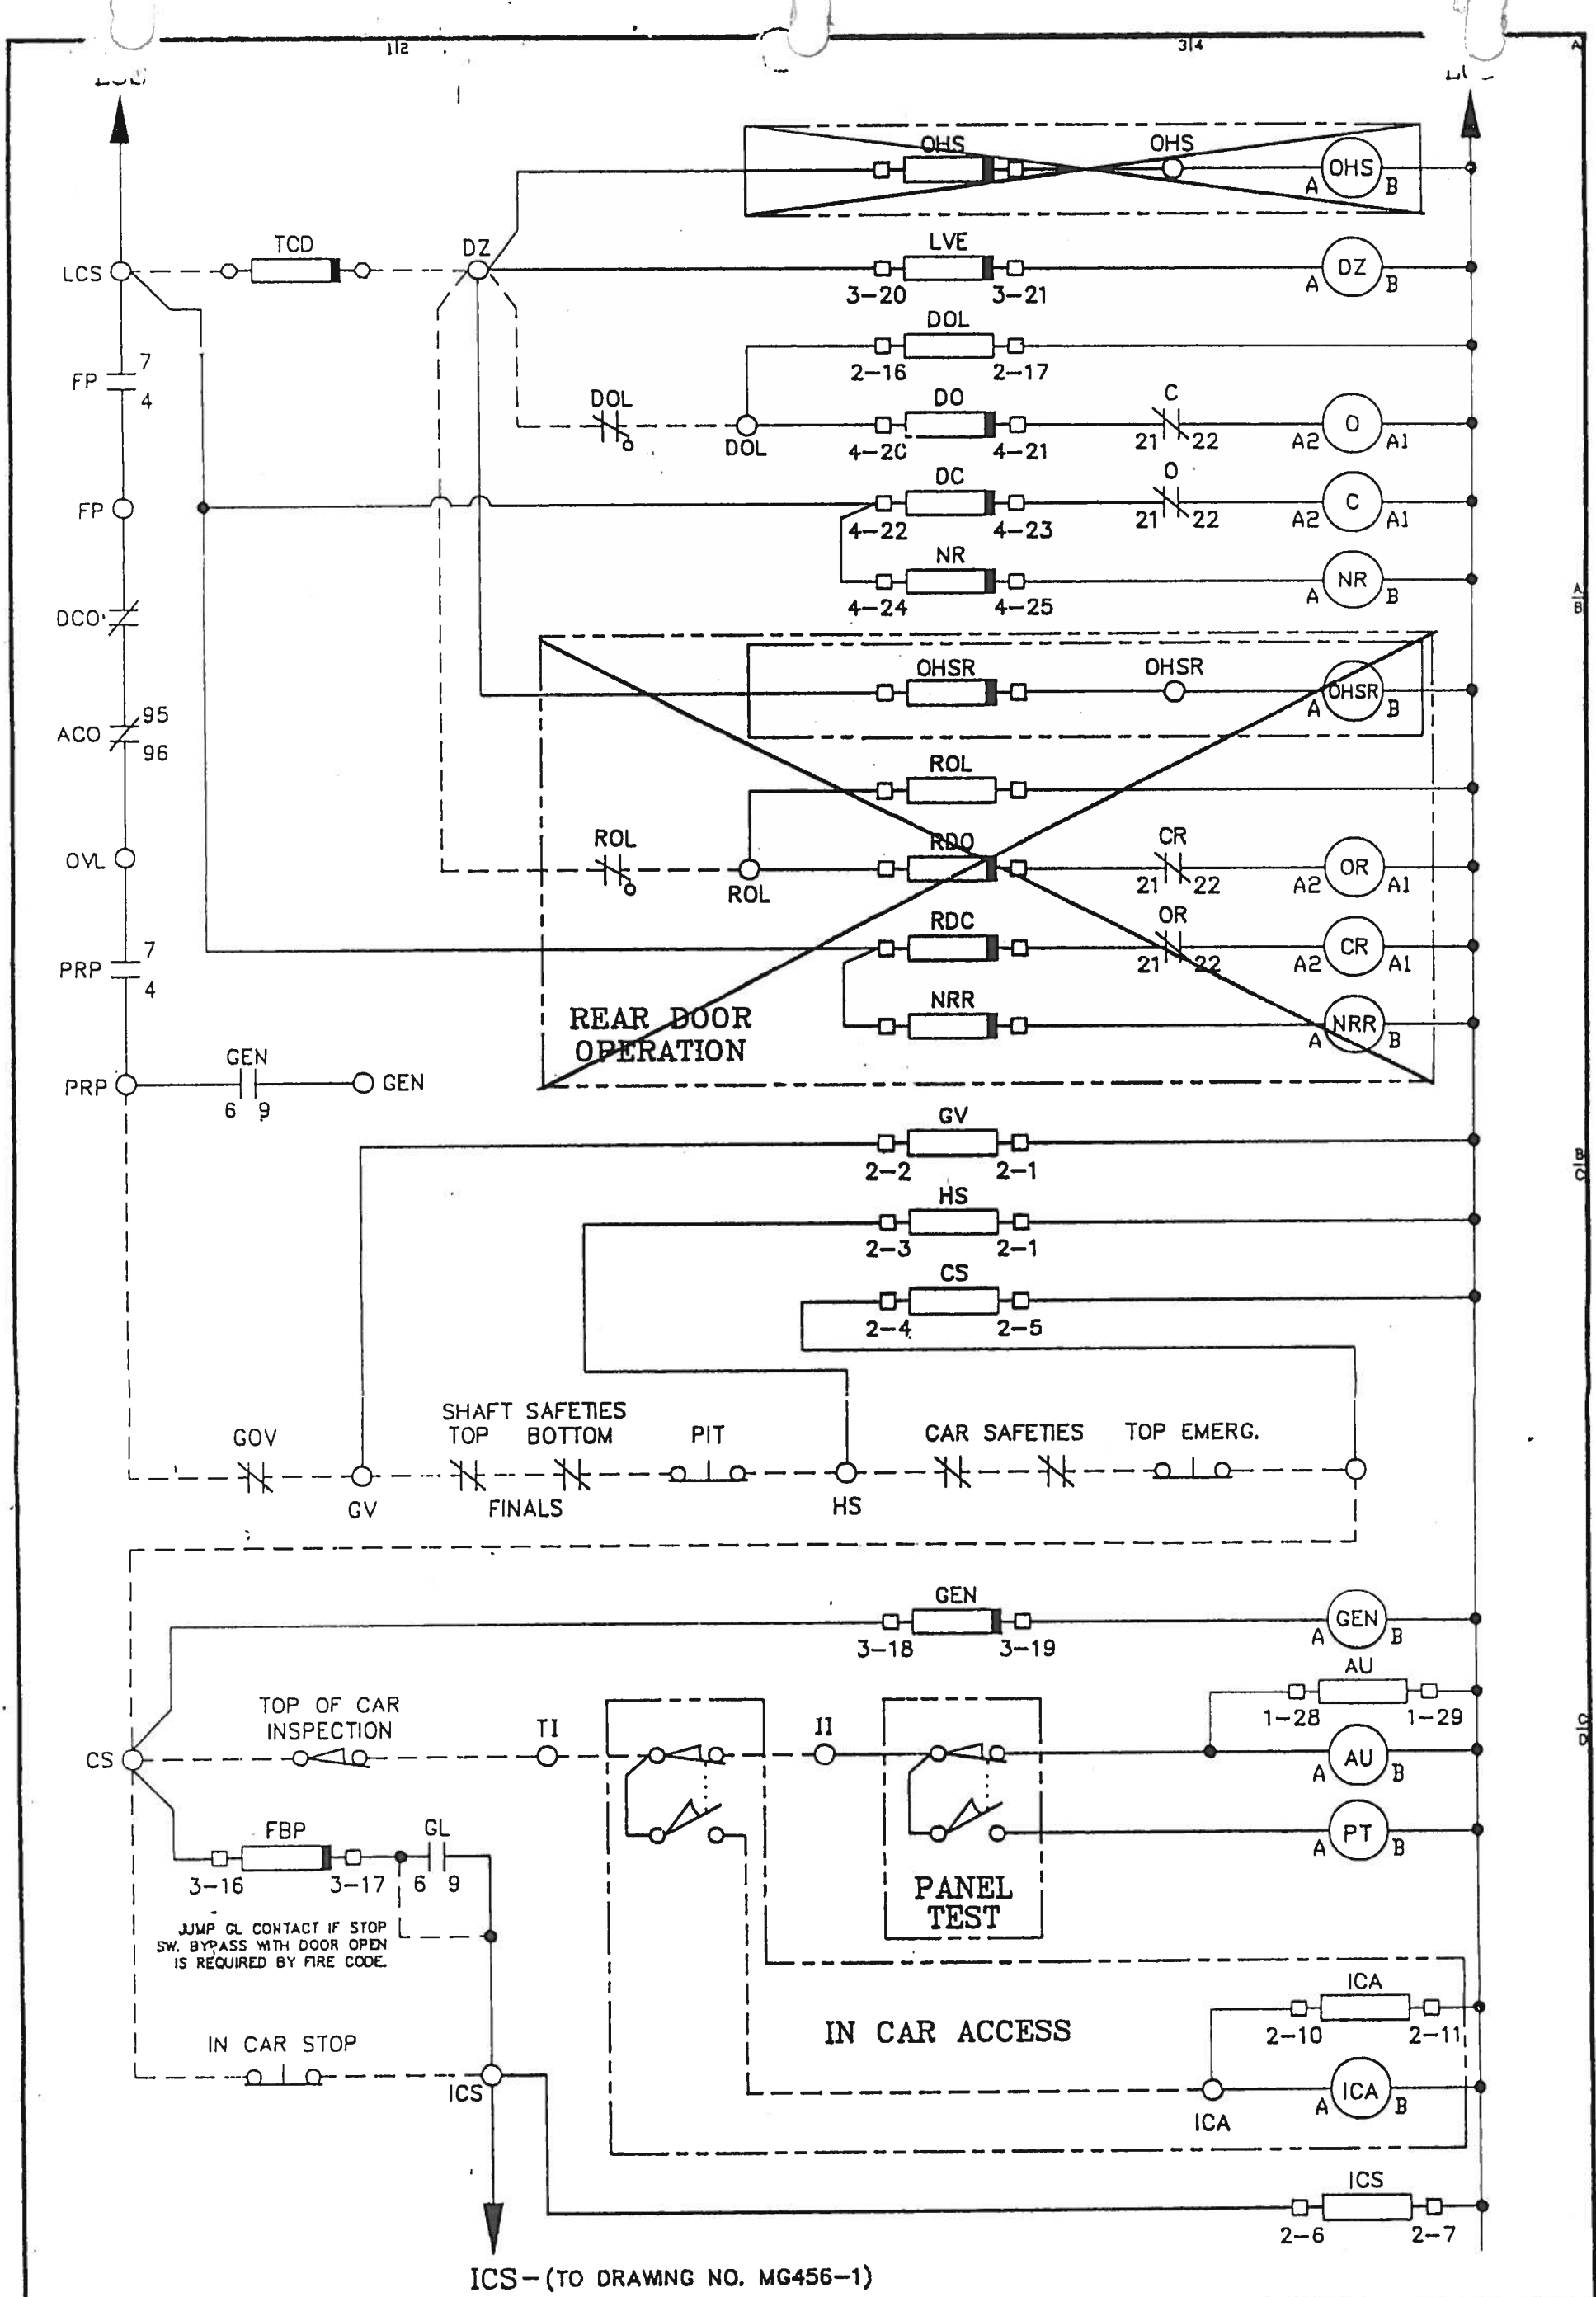

RELAY SECTION 2		
COMPUTERIZED ELEVATOR CONTROL CORP.	DATE	RECORD CHANGES
636 11TH AVENUE NEW YORK, NEW YORK 10036 TEL. (212) 397-0606	9-1-1987	REVISED
BUILDING: V.A.M.C.		
LOCATION: PERRY POINT MD.		
CONTRACTOR: ELEX ELEVATOR		
CAR NO. 122	DATE: 1-11-88	
DRAWING NO. MG455-1	JOB NO. 1406	


COMPUTERIZED ELEVATOR CONTROL CORP.	DATE	RECORD CHANGES
636 11TH AVENUE NEW YORK, NEW YORK 10036 TEL (212) 397-0606	11-24-1986	REVISED - ADDED INSP. SW.
BUILDING: V.A.M.C.	12-2-1986	REVISED - ADDED SUD CONTACT
LOCATION: PERRY POINT MD.		
CONTRACTOR: ELEX ELEVATOR		
CAR NO. 1#2	DATE: 1-11-88	
DRAWING NO. MC456-1	JOB NO. 1406	

RELAY SECTION 3

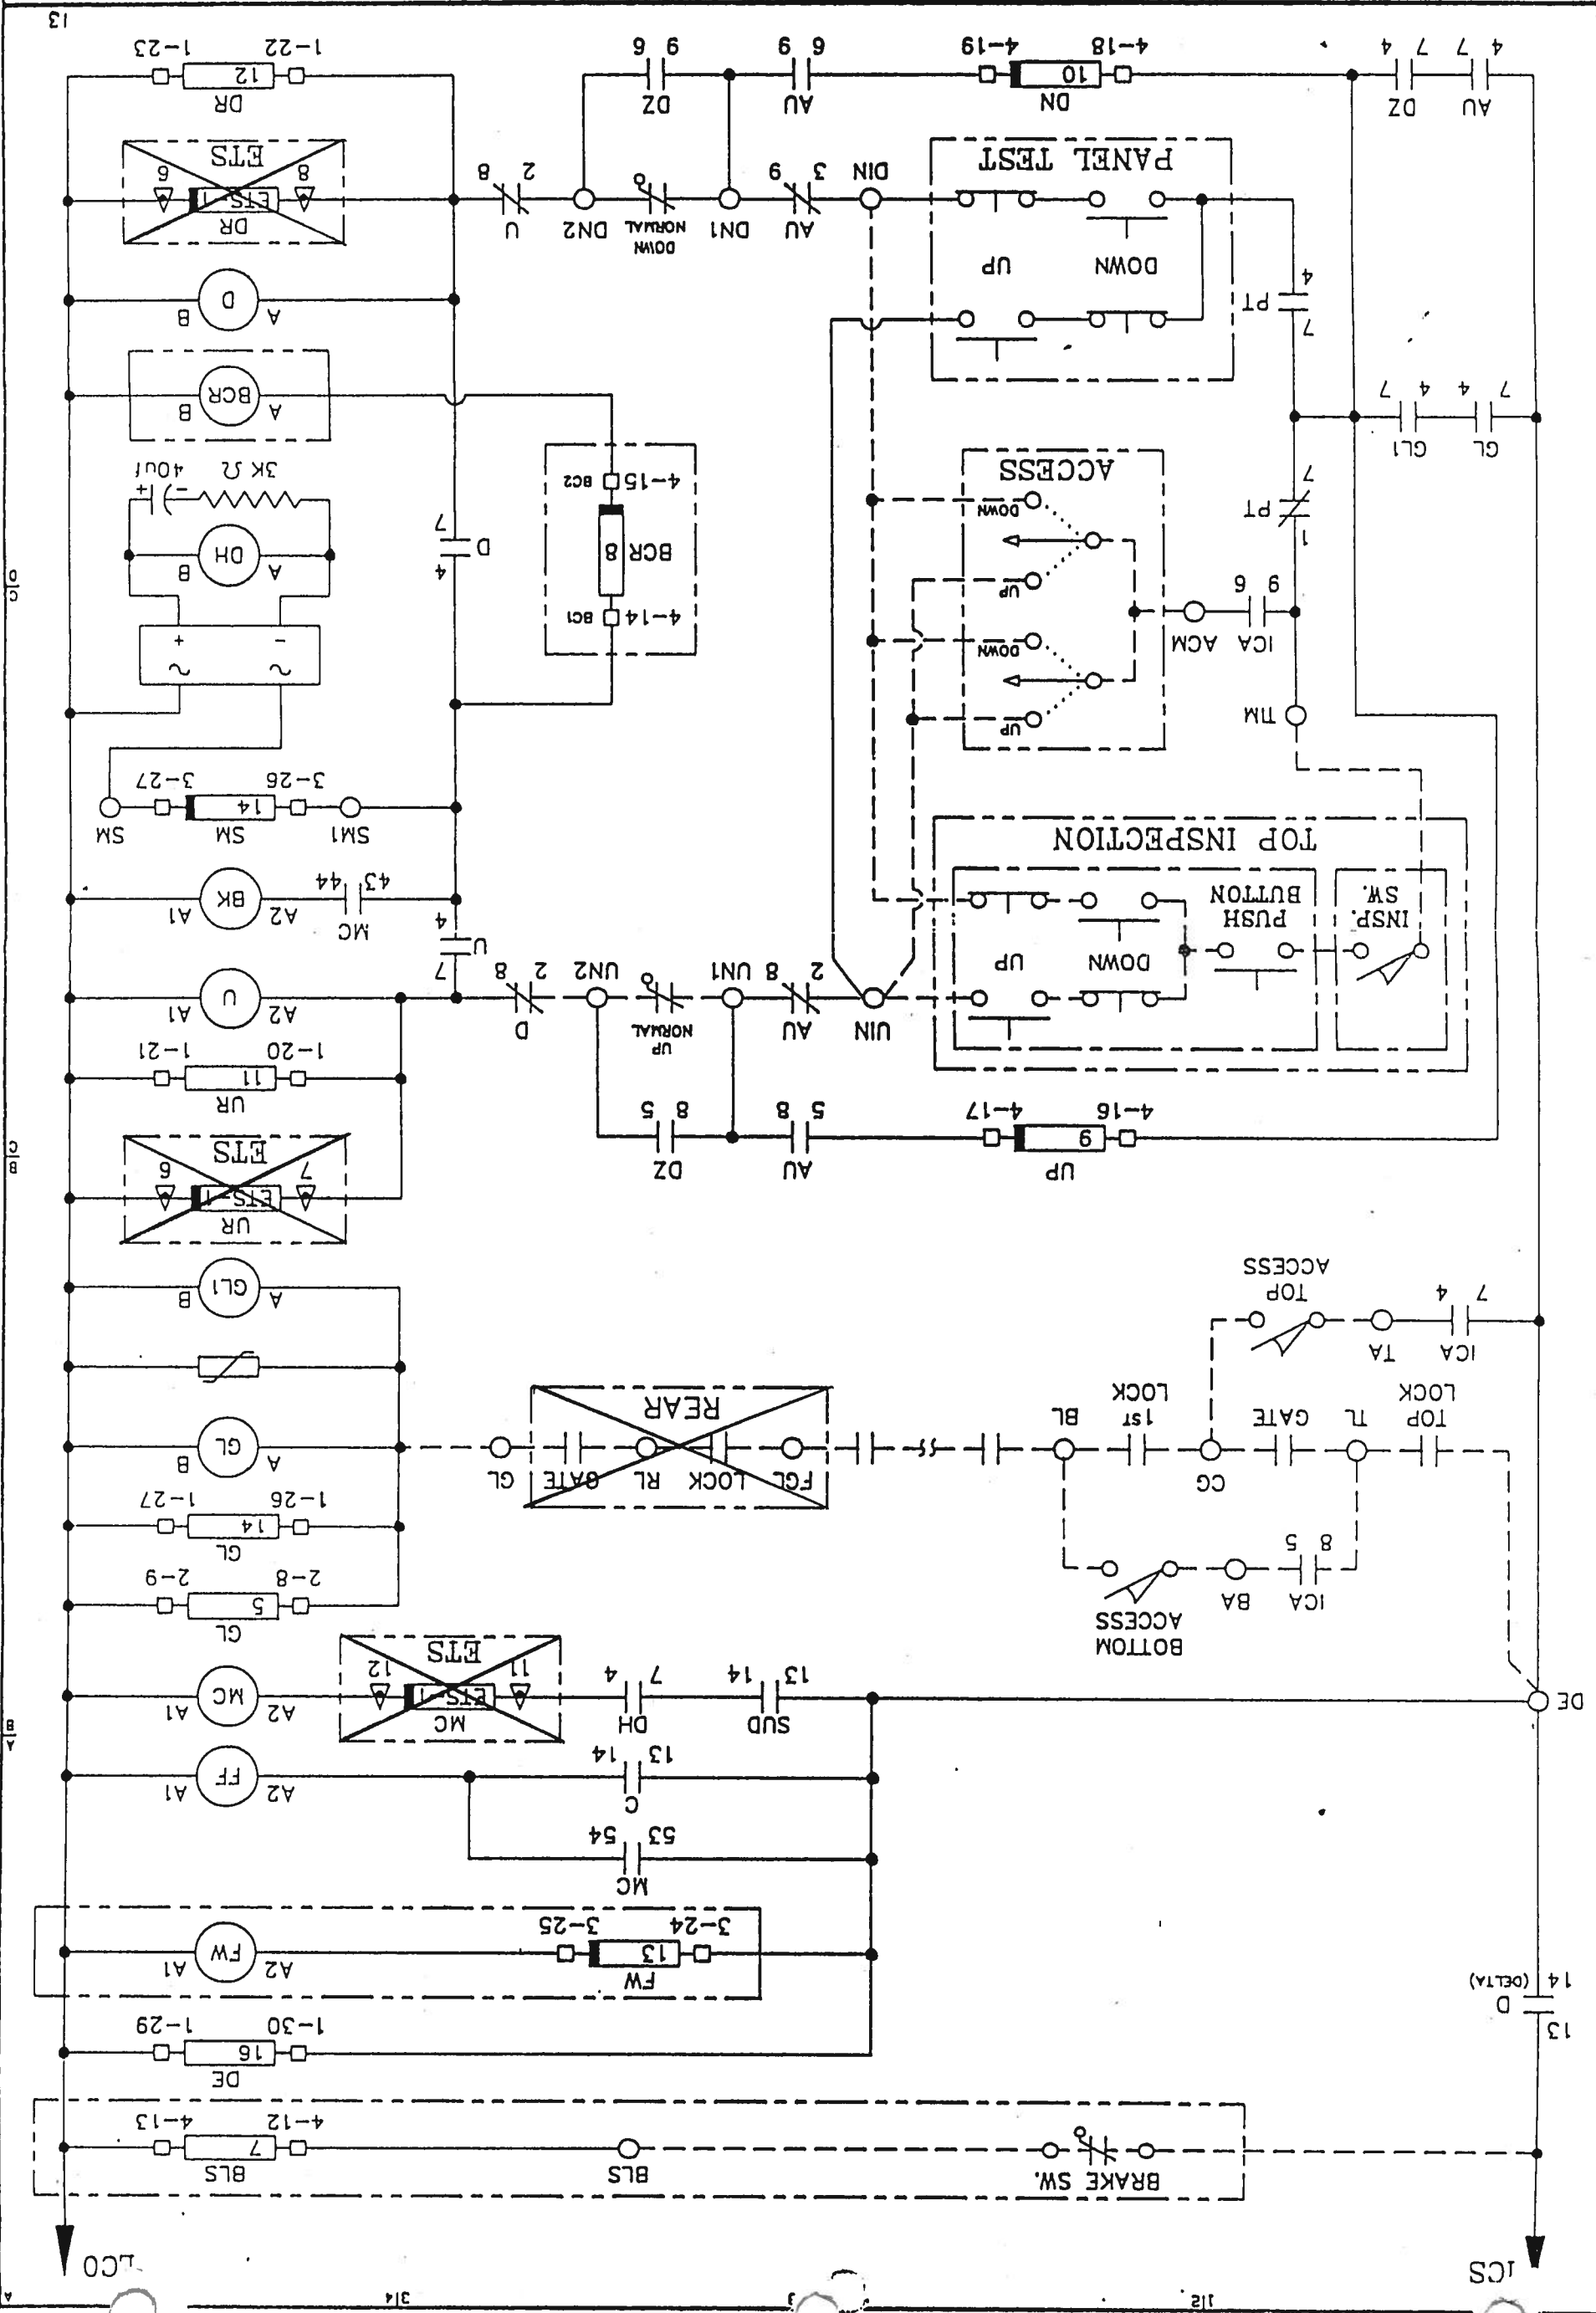


COMPUTERIZED ELEVATOR CONTROL CORP.		DATE	RECORD CHANGES
636 11TH AVENUE NEW YORK, NEW YORK 10036 TEL. (212) 397-0606			
CONTRACTOR: ELEX ELEVATOR			

RELAY SECTION 4

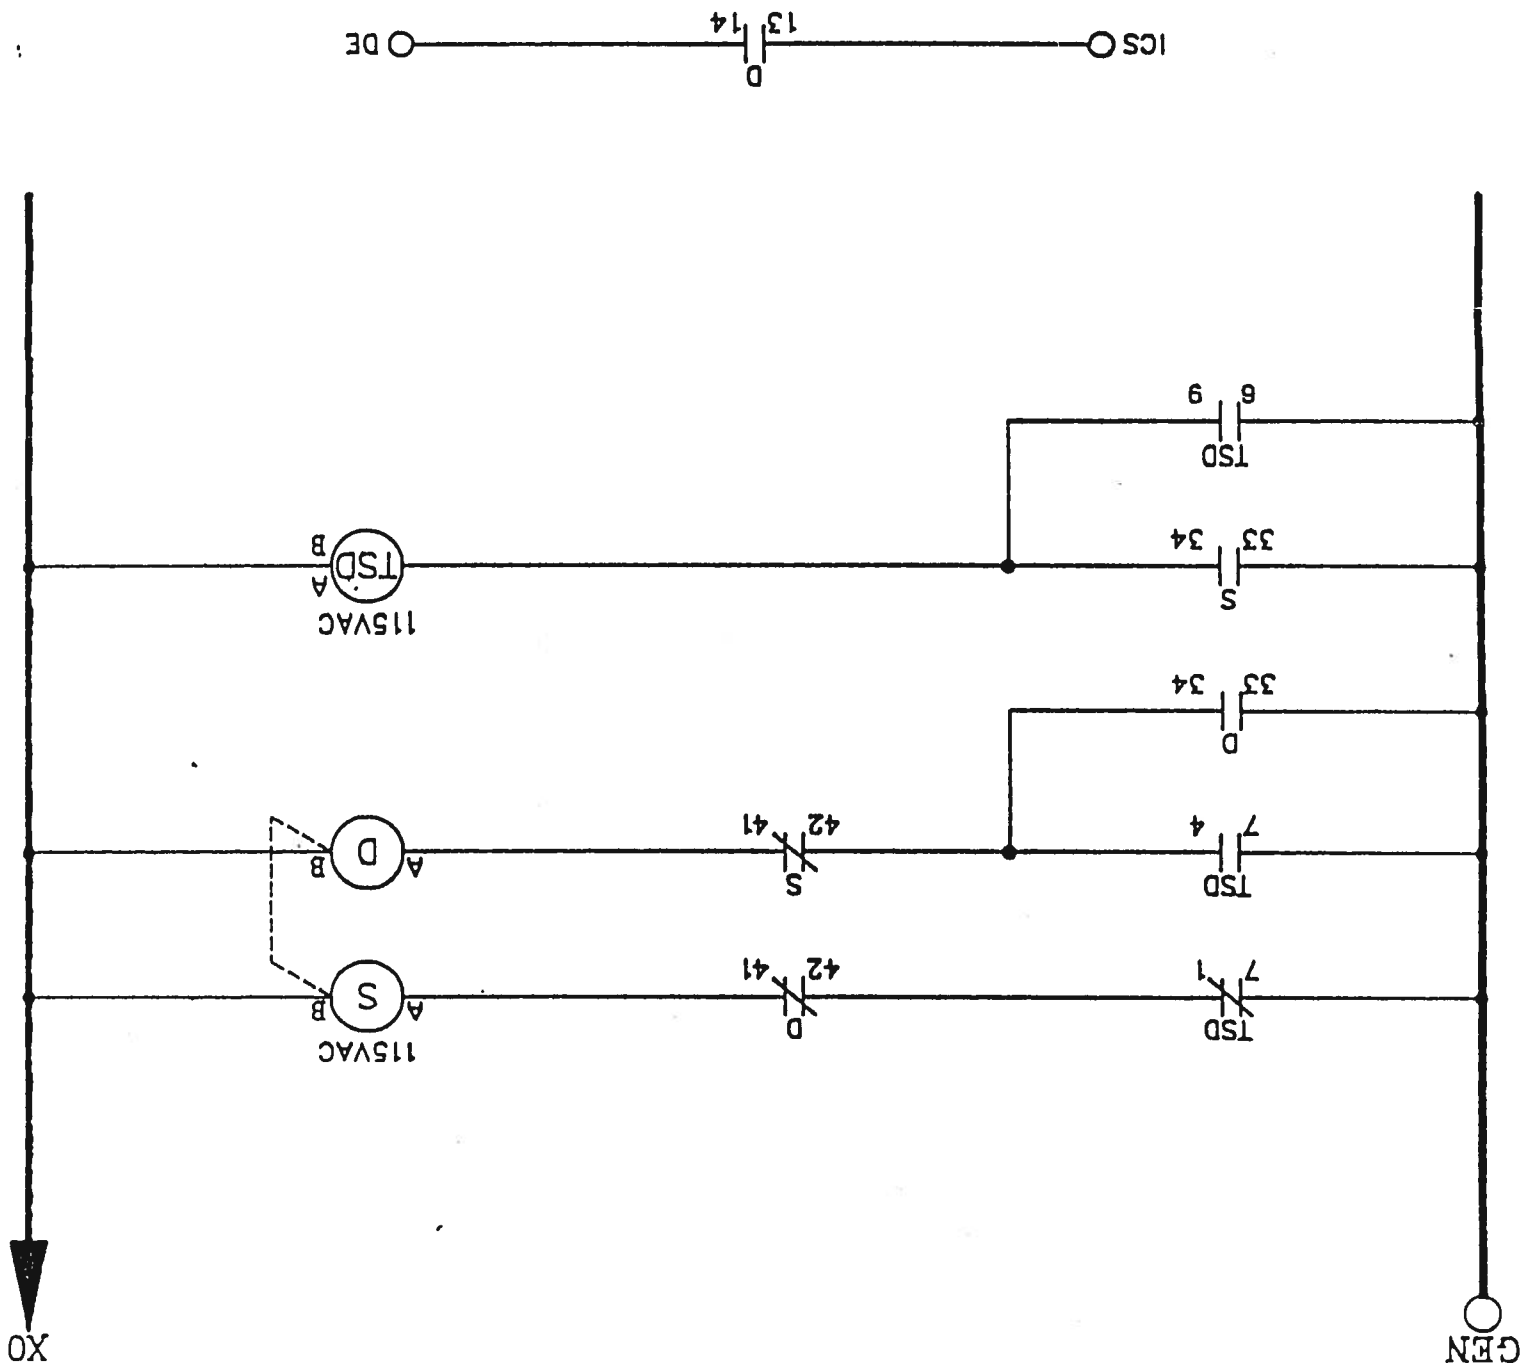


COMPUTERIZED ELEVATOR CONTROL CORP.	DATE	RECORD CHANGES
636 11TH AVENUE NEW YORK, NEW YORK 10036 TEL (212) 397-0606	11-24-1986	REMOVED - ADDED INSP. SW.
BUILDING: V.A.M.C.	12-2-1986	REMOVED - ADDED SUB CONTACT
LOCATION: PERRY POINT MD.		
CONTRACTOR: ELEX ELEVATOR		
CAR NO. 1#2	DATE: 1-11-88	
DRAWING NO. MG456-1	JOB NO. 1406	


RELAY SECTION 3

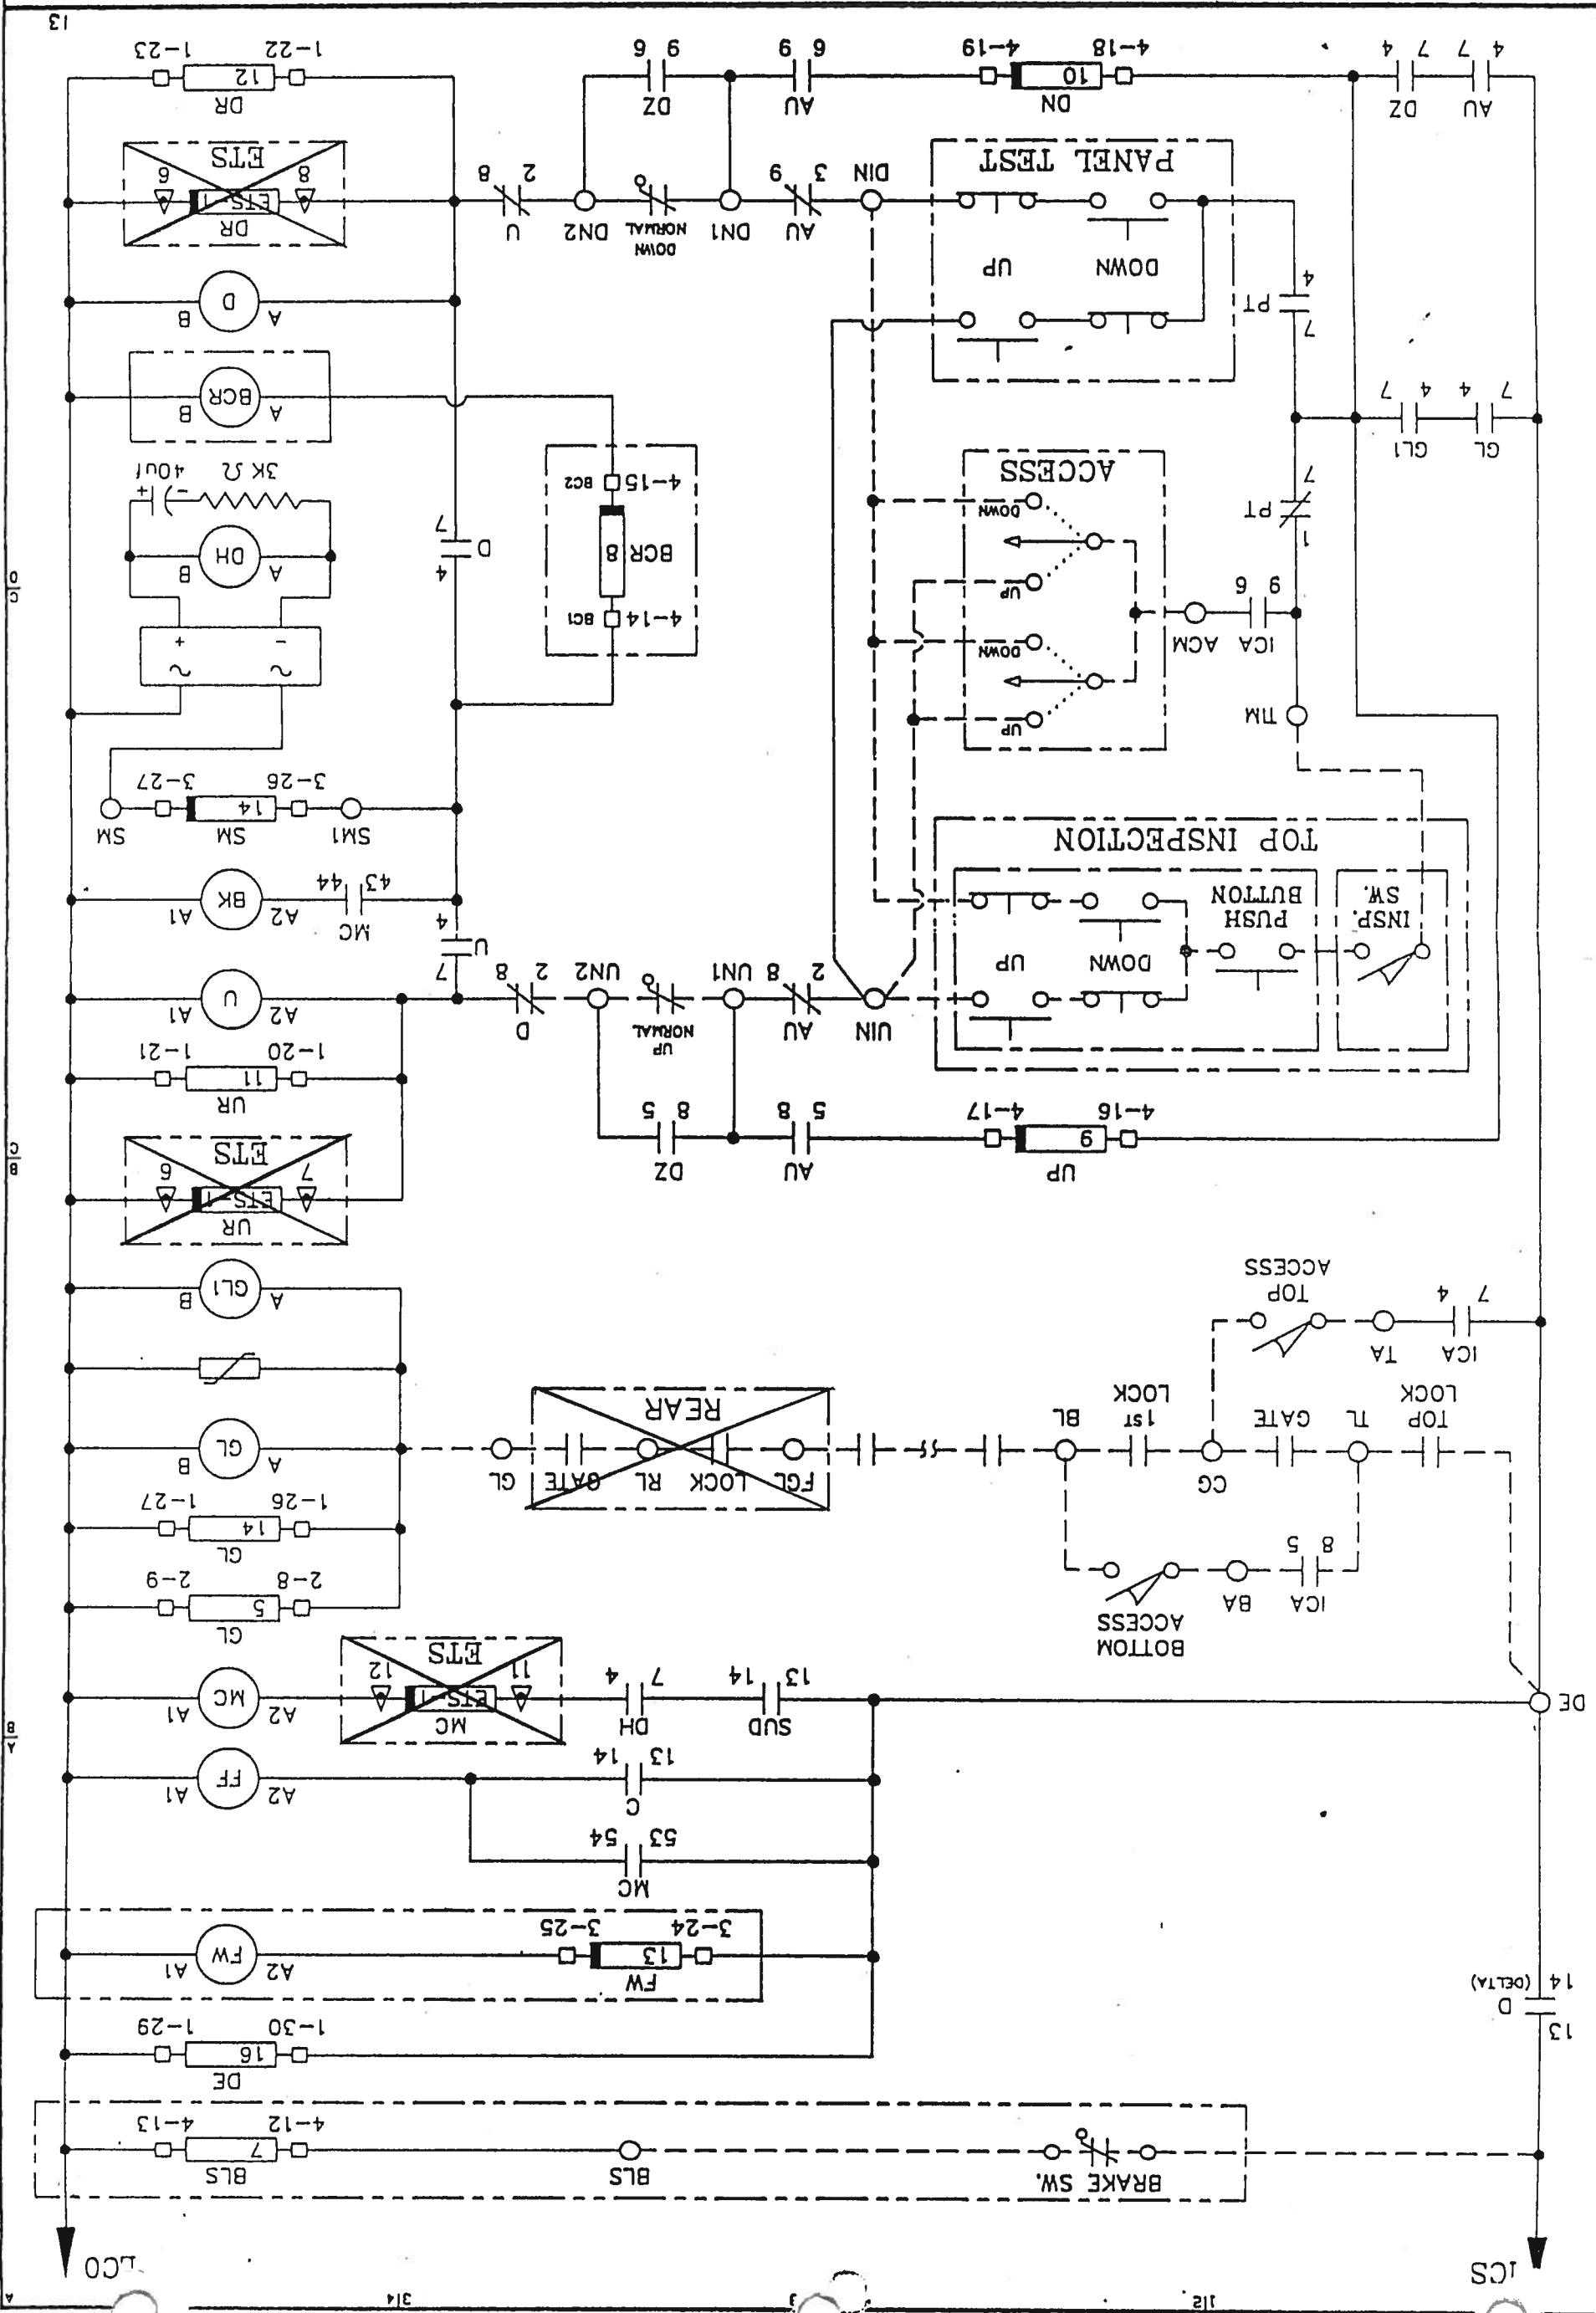



RELAY SECTION 1

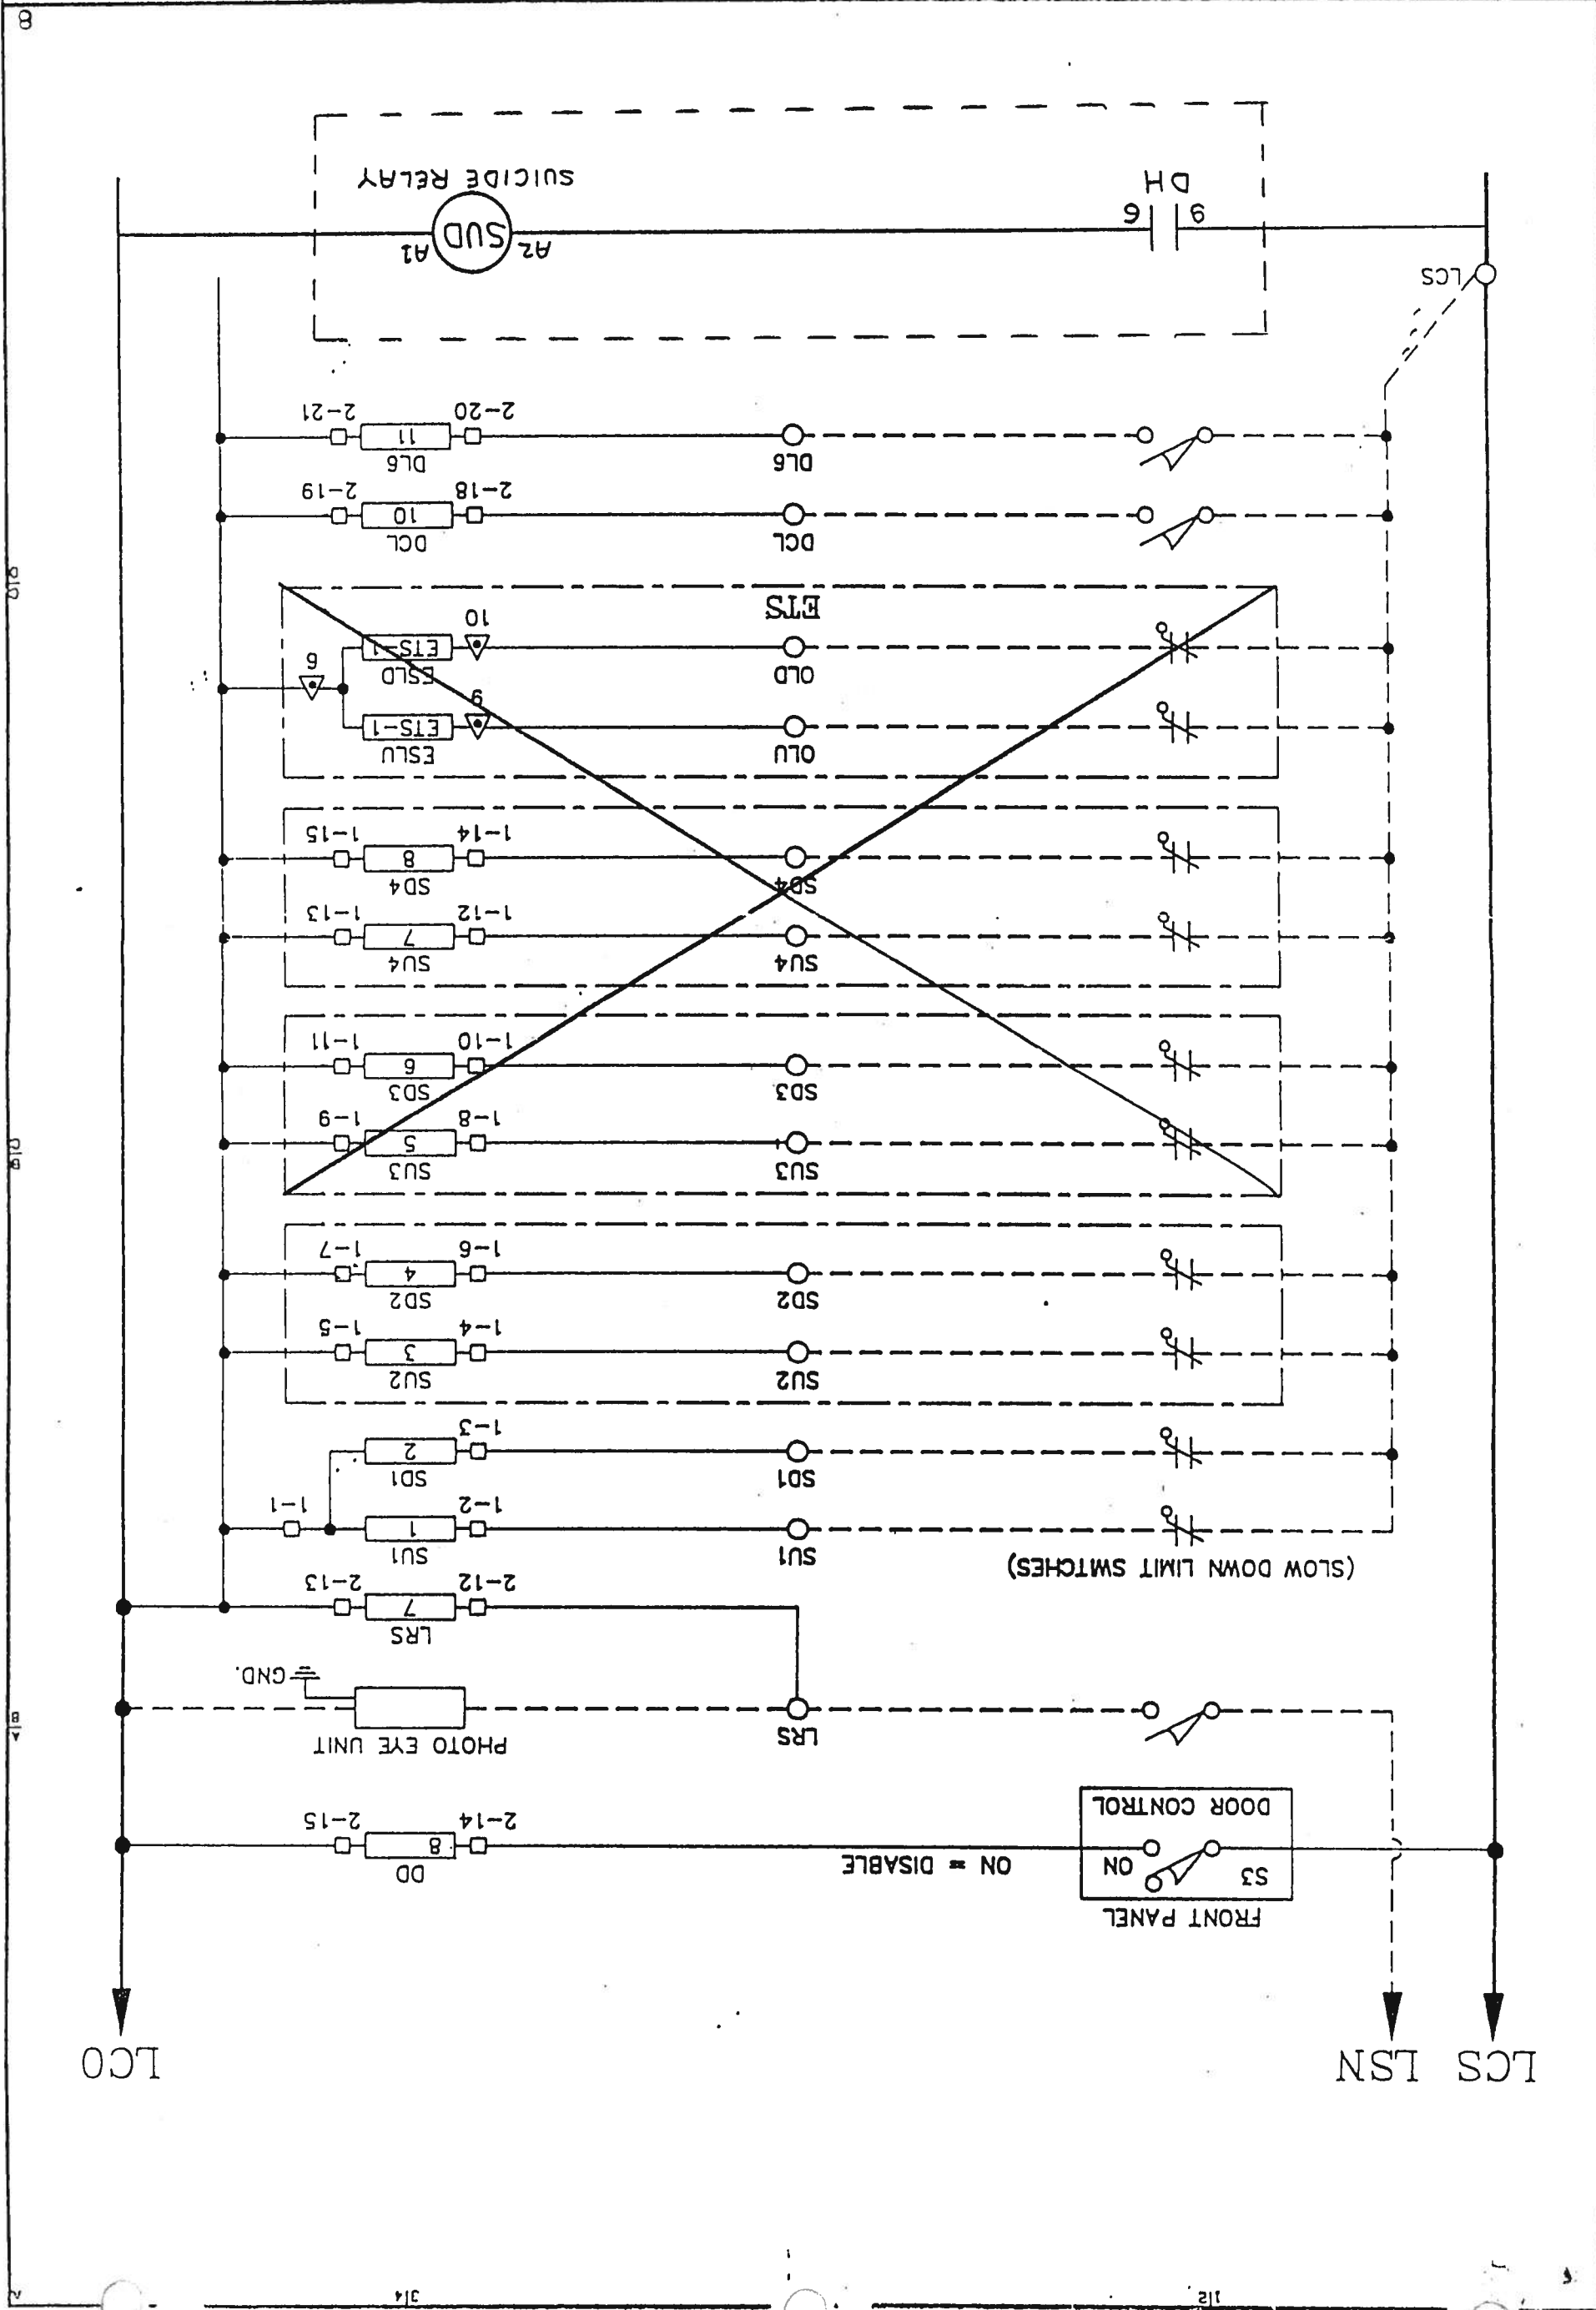

VOLTAGE: 115VAC


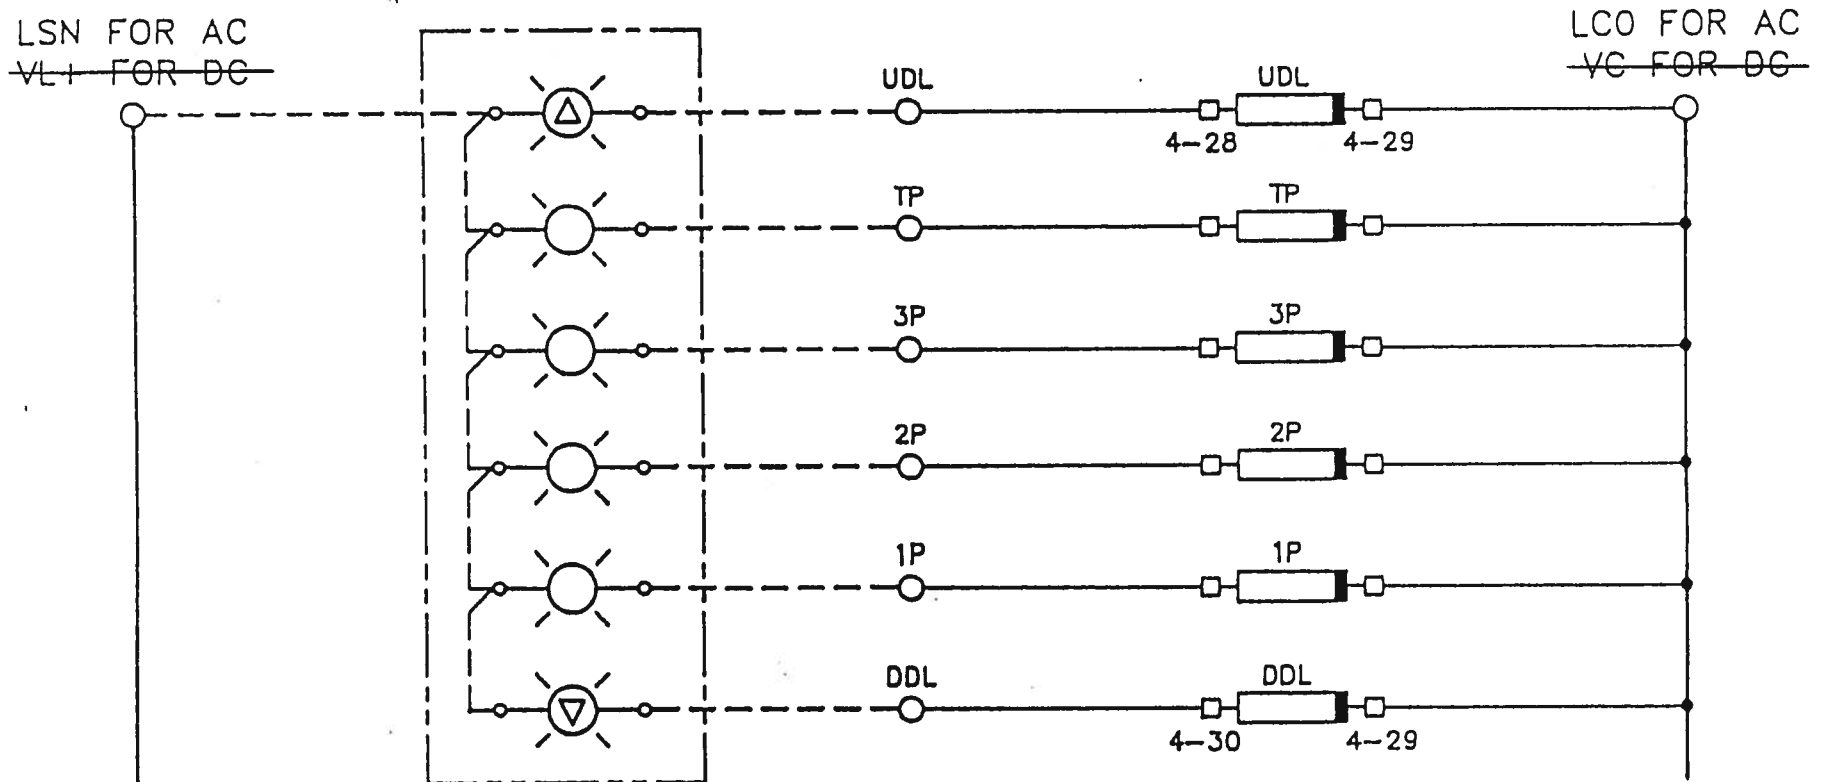


VOLTAGE: 115VAC

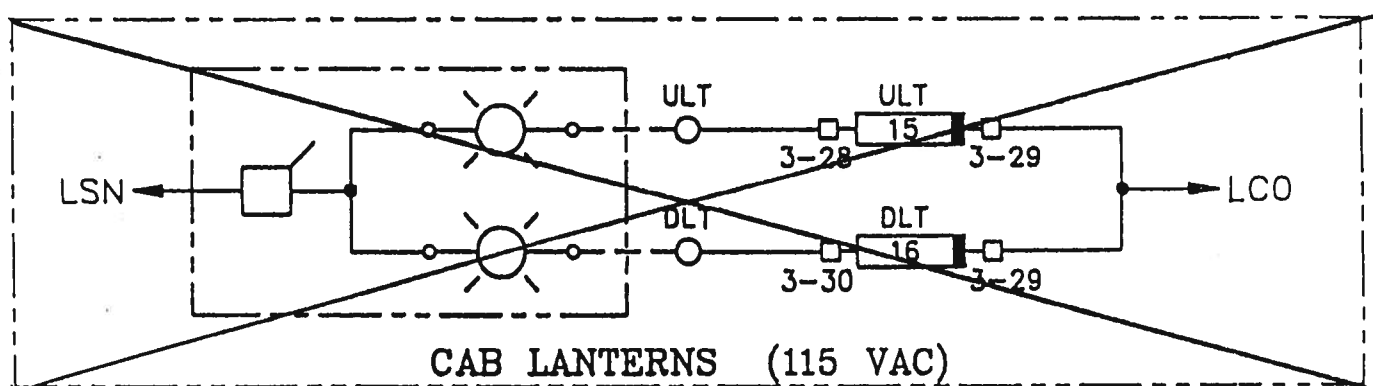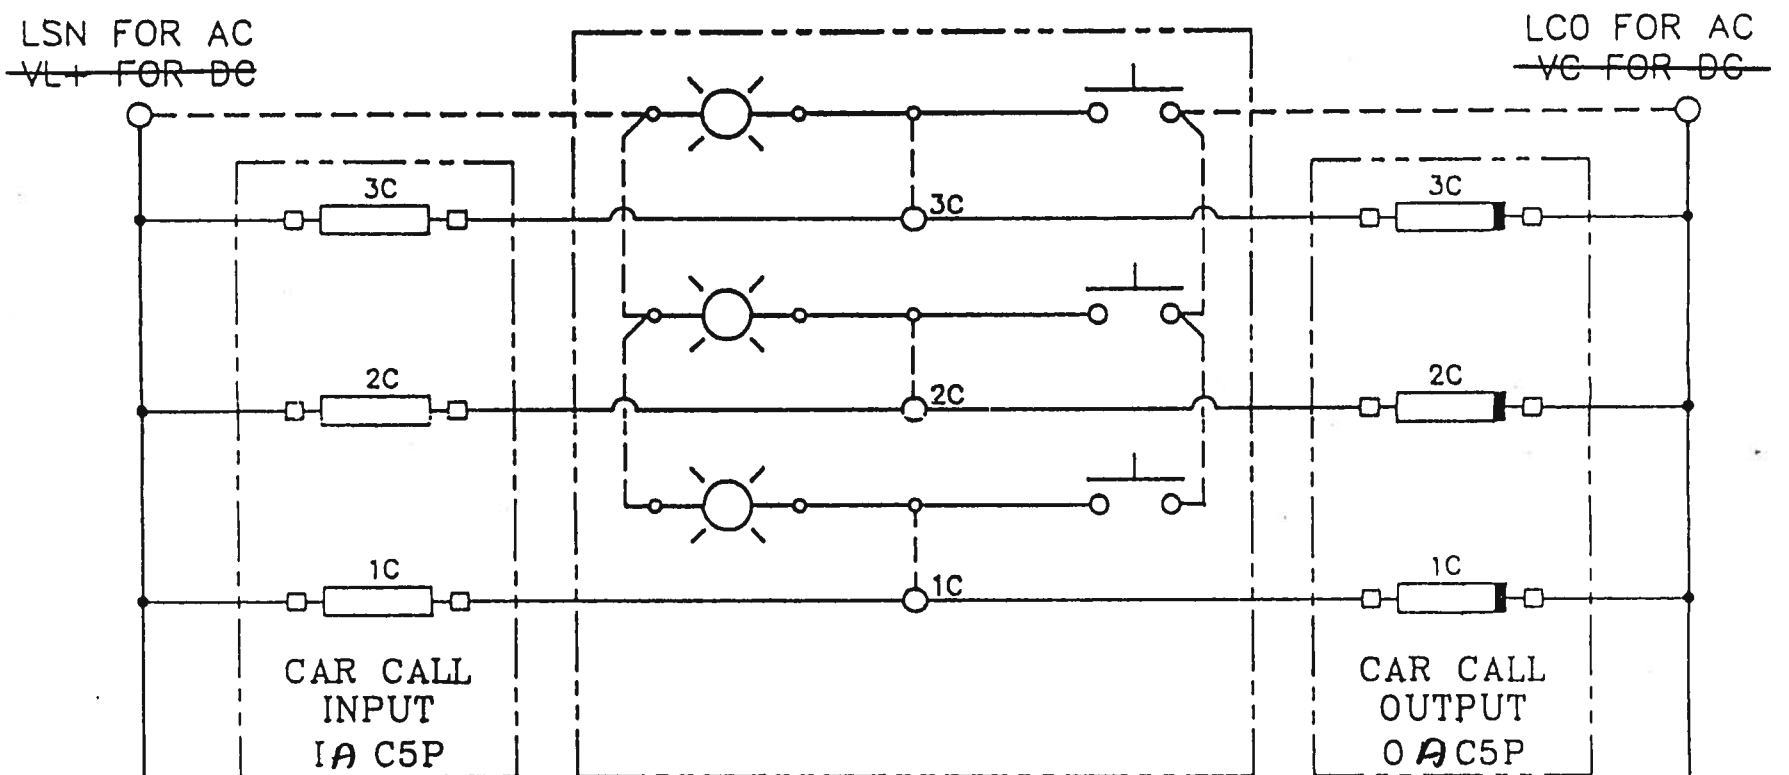


PMI INTERFACE SECTION 1

COMPUTERIZED ELEVATOR CONTROL CORP.	DATE	RECORD CHANGES
636 11TH AVENUE NEW YORK, NEW YORK 10036 TEL (212) 397-0606		
BUILDING: V.A.M.C.		
LOCATION: PERRY POINT MD.		
CONTRACTOR: FLEX ELEVATOR		
CAR NO. 12	DATE: 1-11-88	
DRAWING NO. MG504-1	JOB NO. 1406	

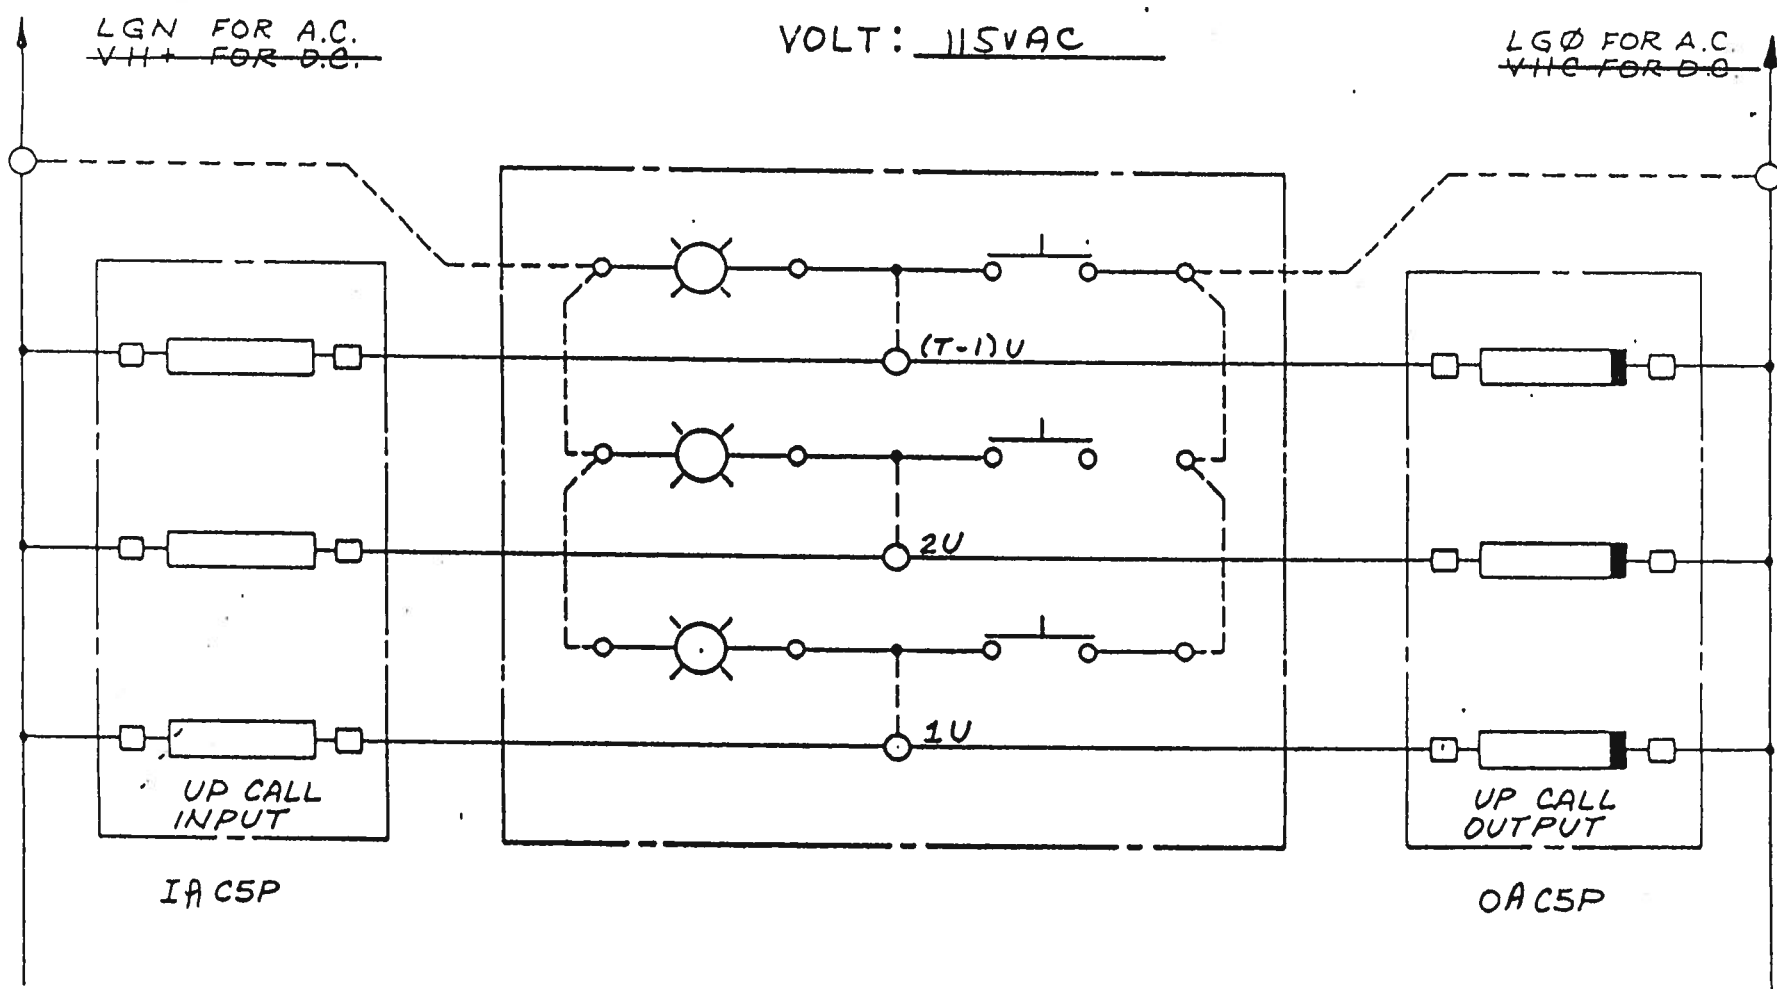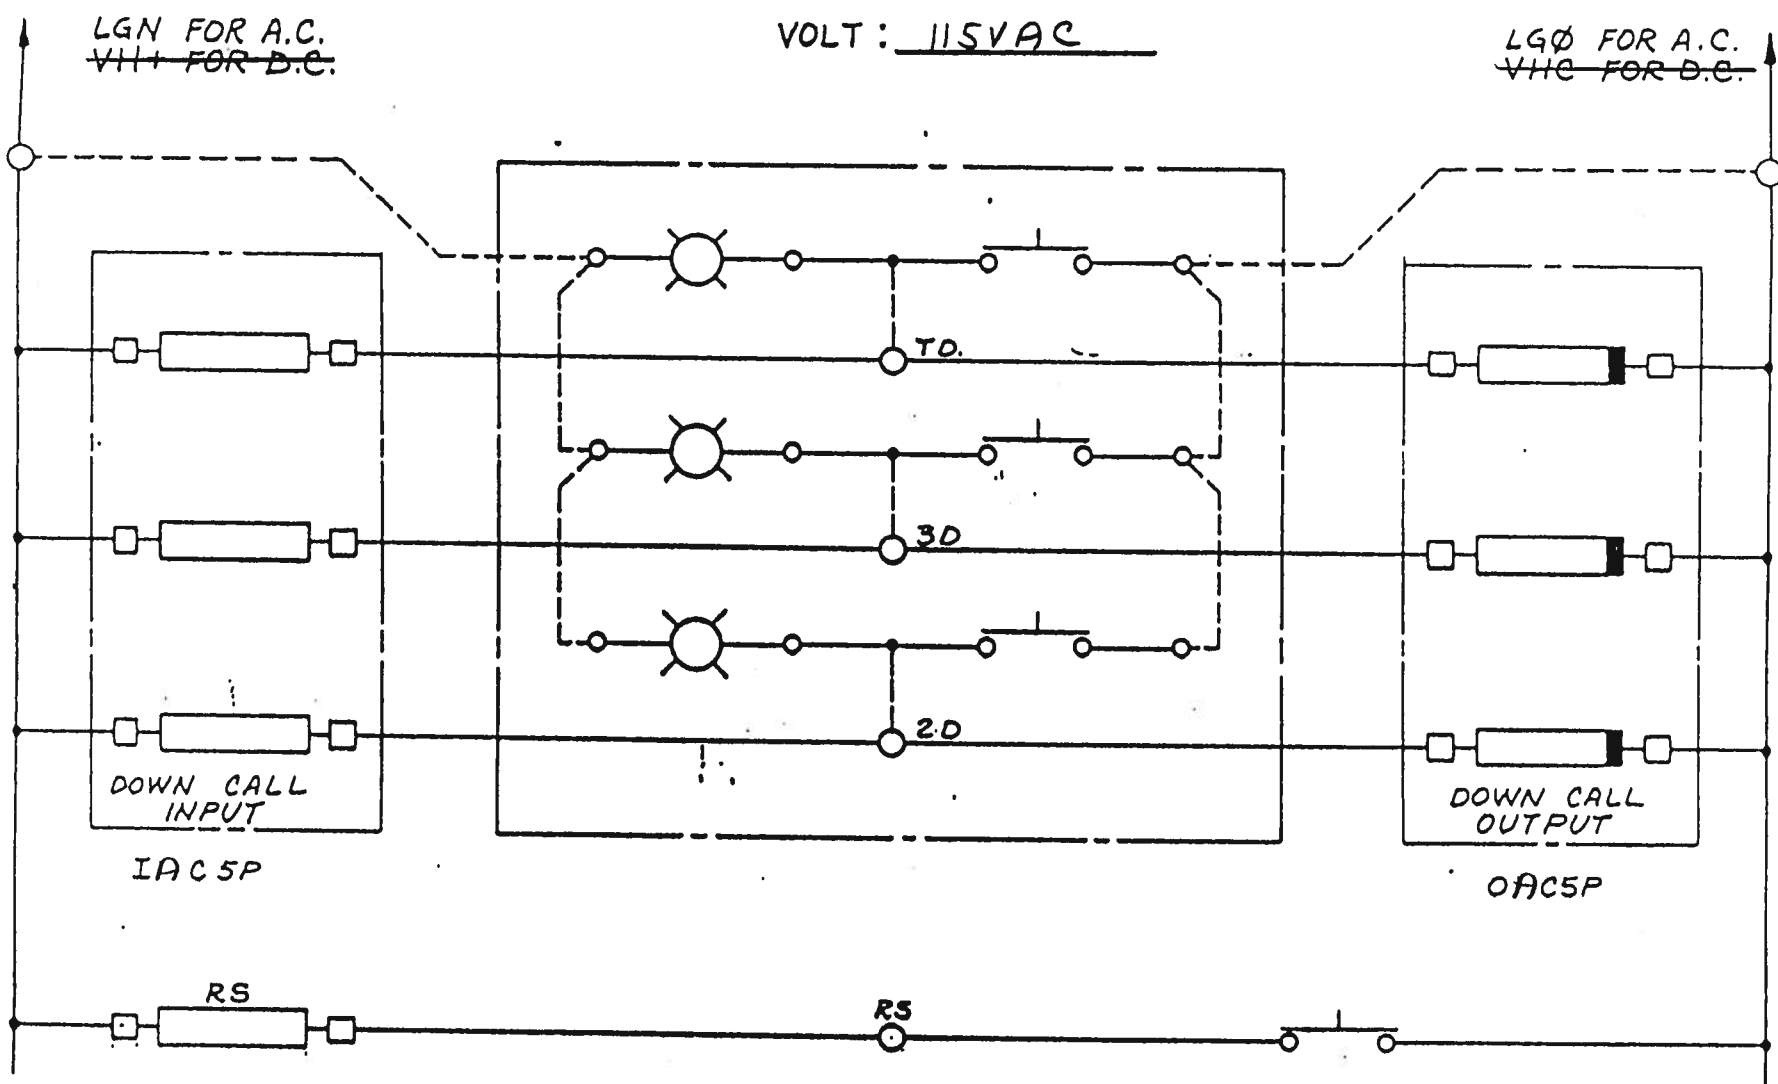



COMPUTERIZED ELEVATOR CONTROL CORP.	DATE	RECORD CHANGES
636 11TH AVENUE NEW YORK, NEW YORK 10036 TEL (212) 397-0606		
BUILDING: V.B.M.C.		
LOCATION: PERRY POINT, MD.		
CONTRACTOR: ELEX ELEVATOR		
CAR NO. 112	DATE: 1-11-88	
DRAWING NO. MG506-1	JOB NO. 1406	

FIRE CONTROL ANSI - 1985

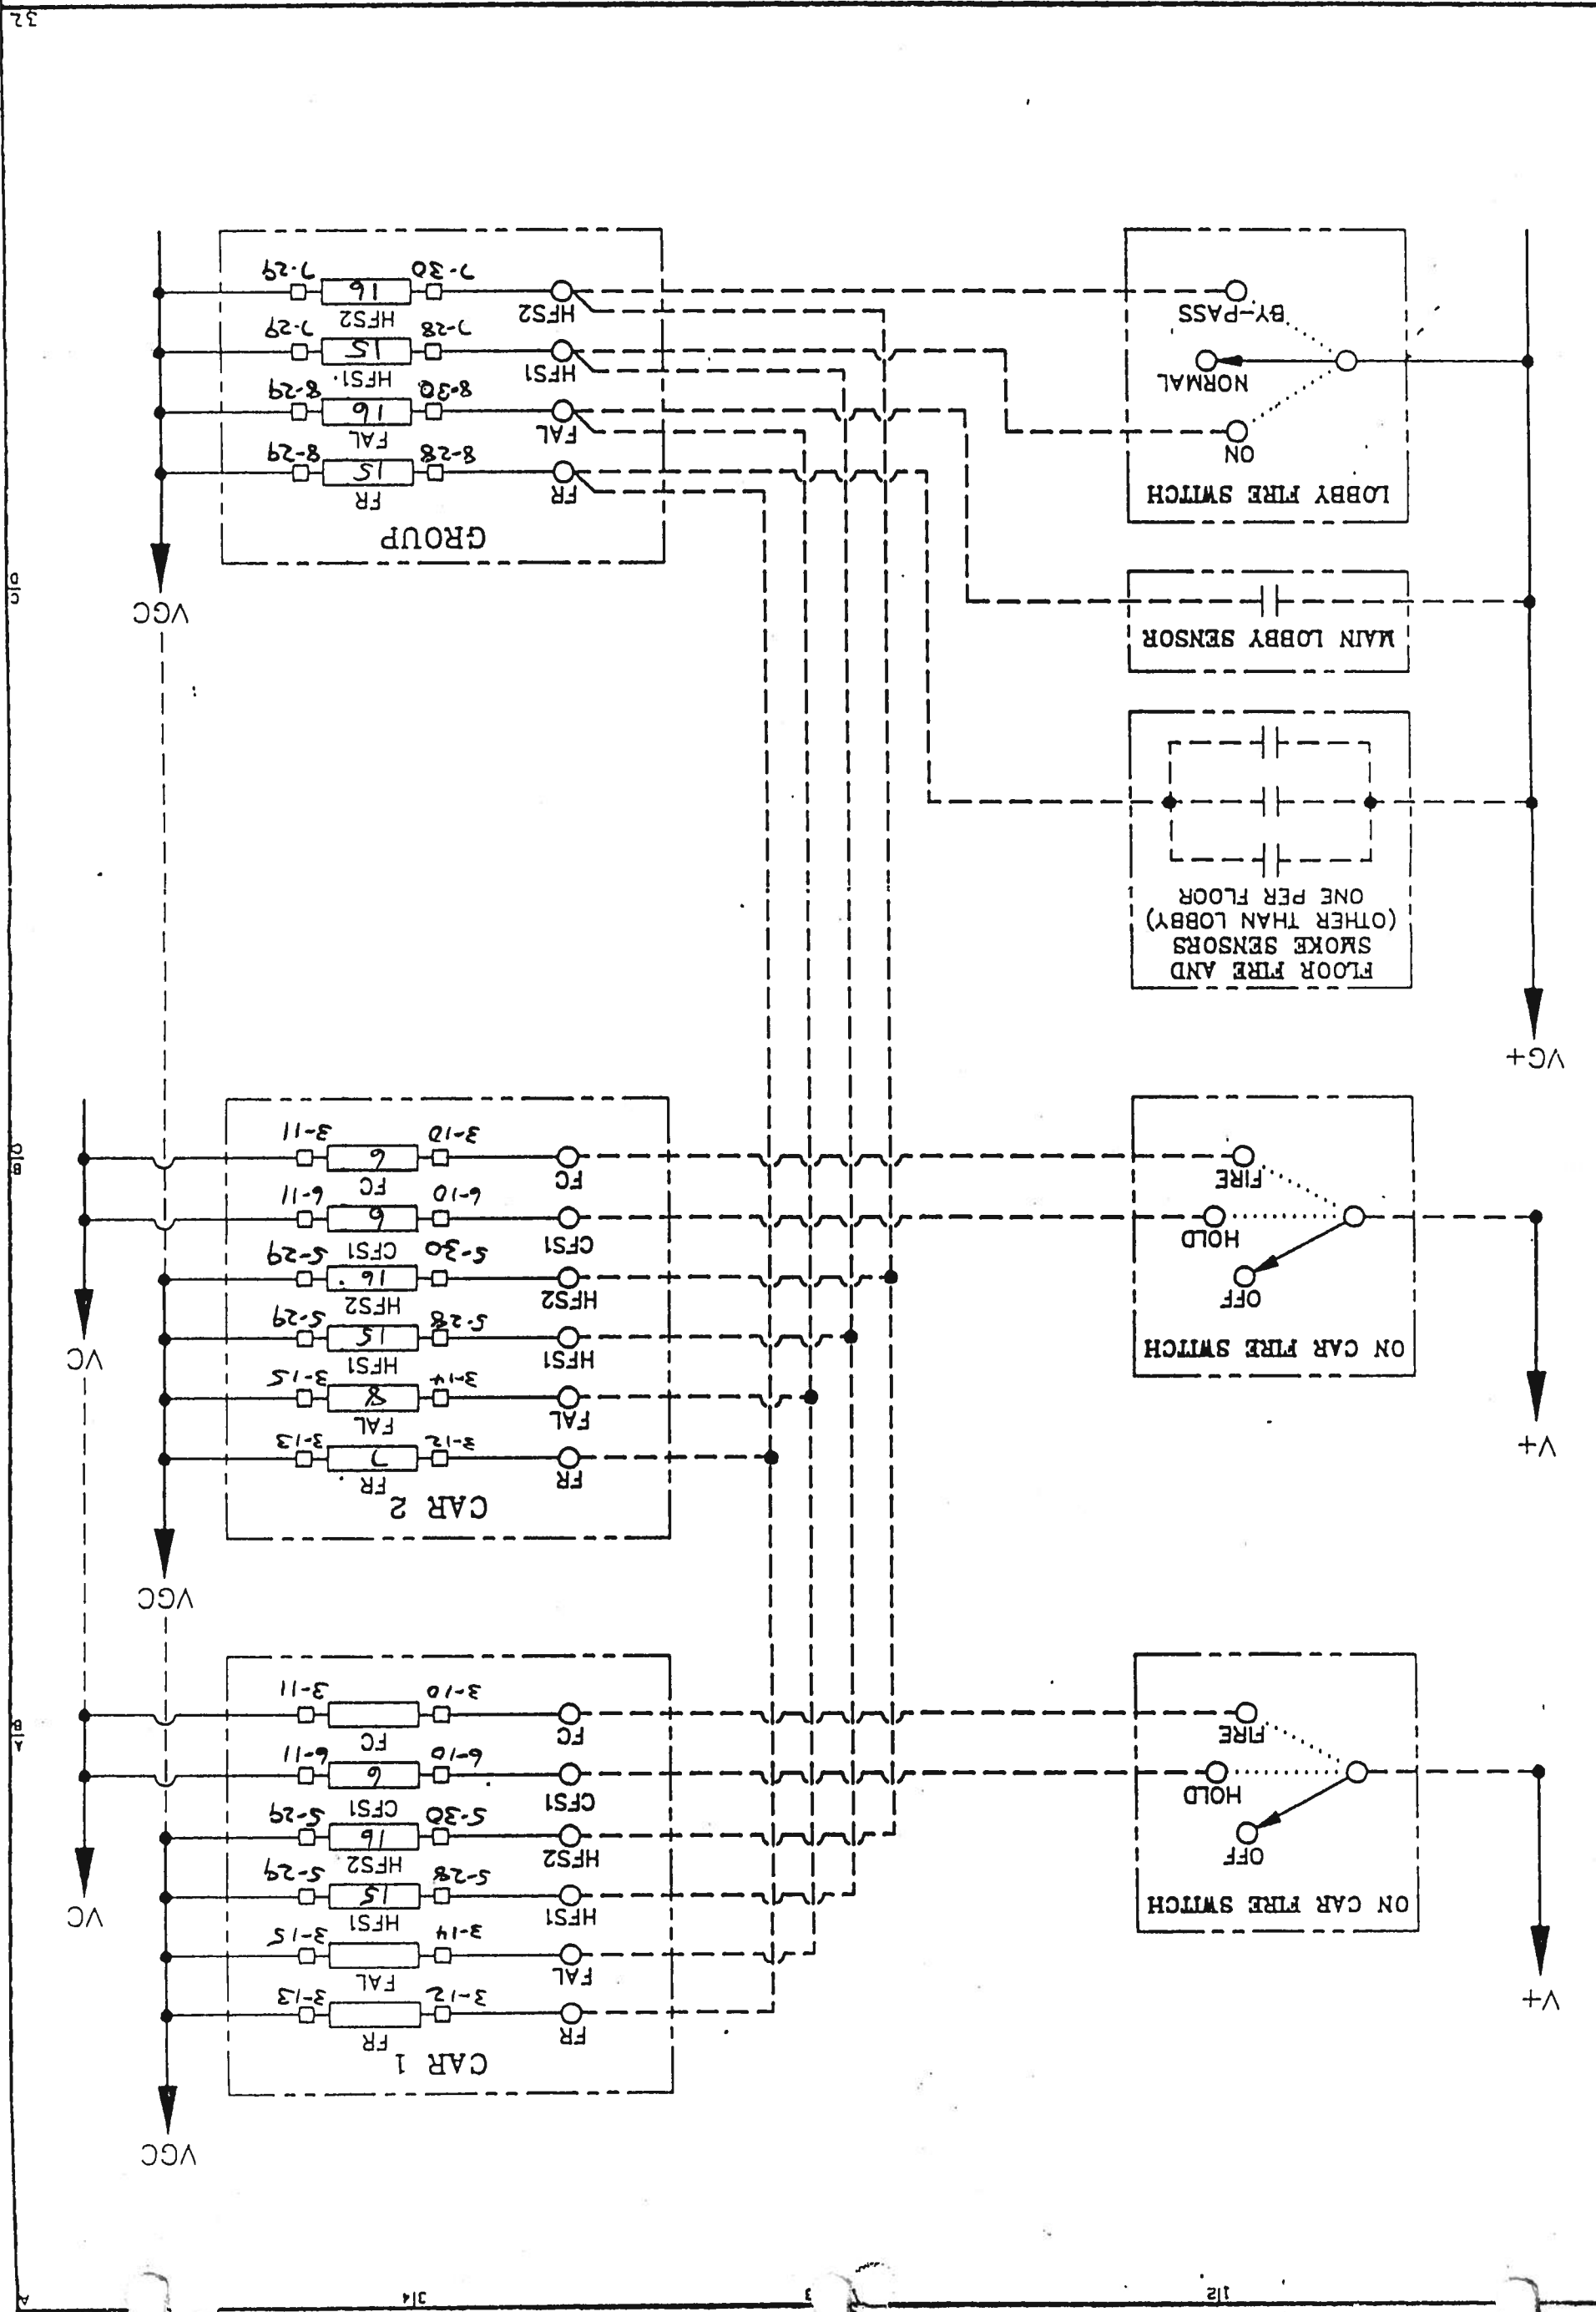

EMERGENCY POWER CIRCUITRY

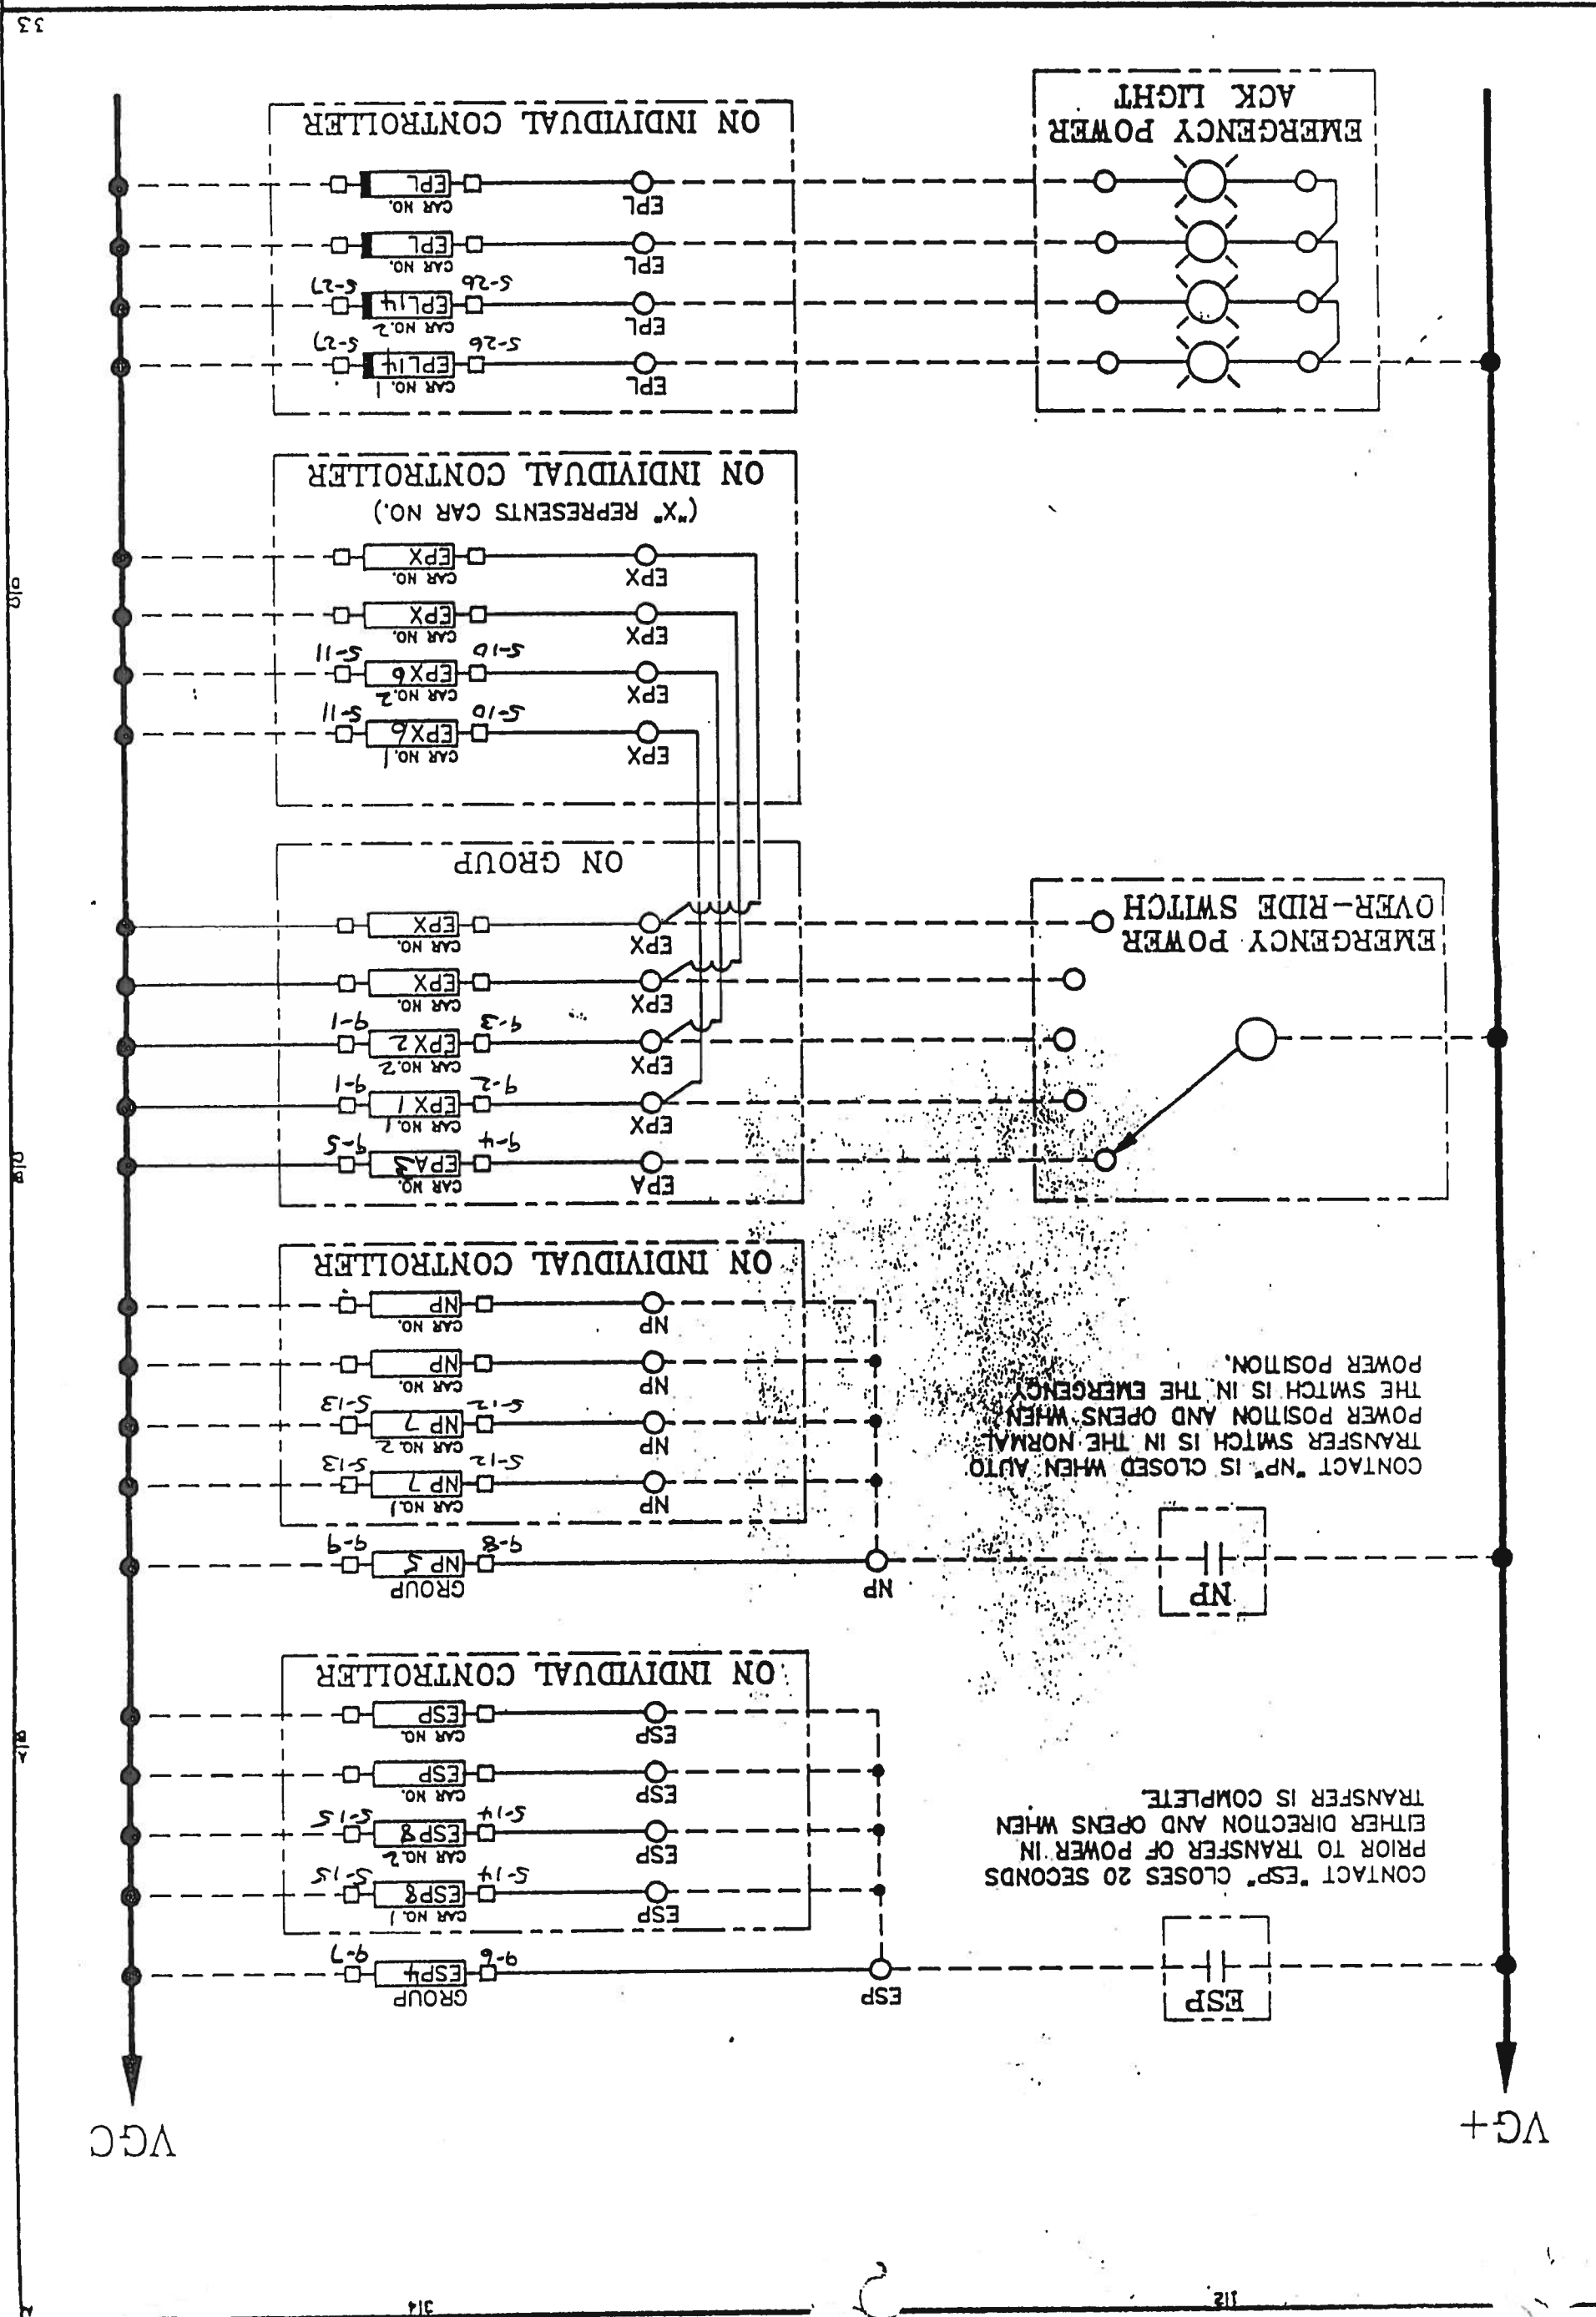

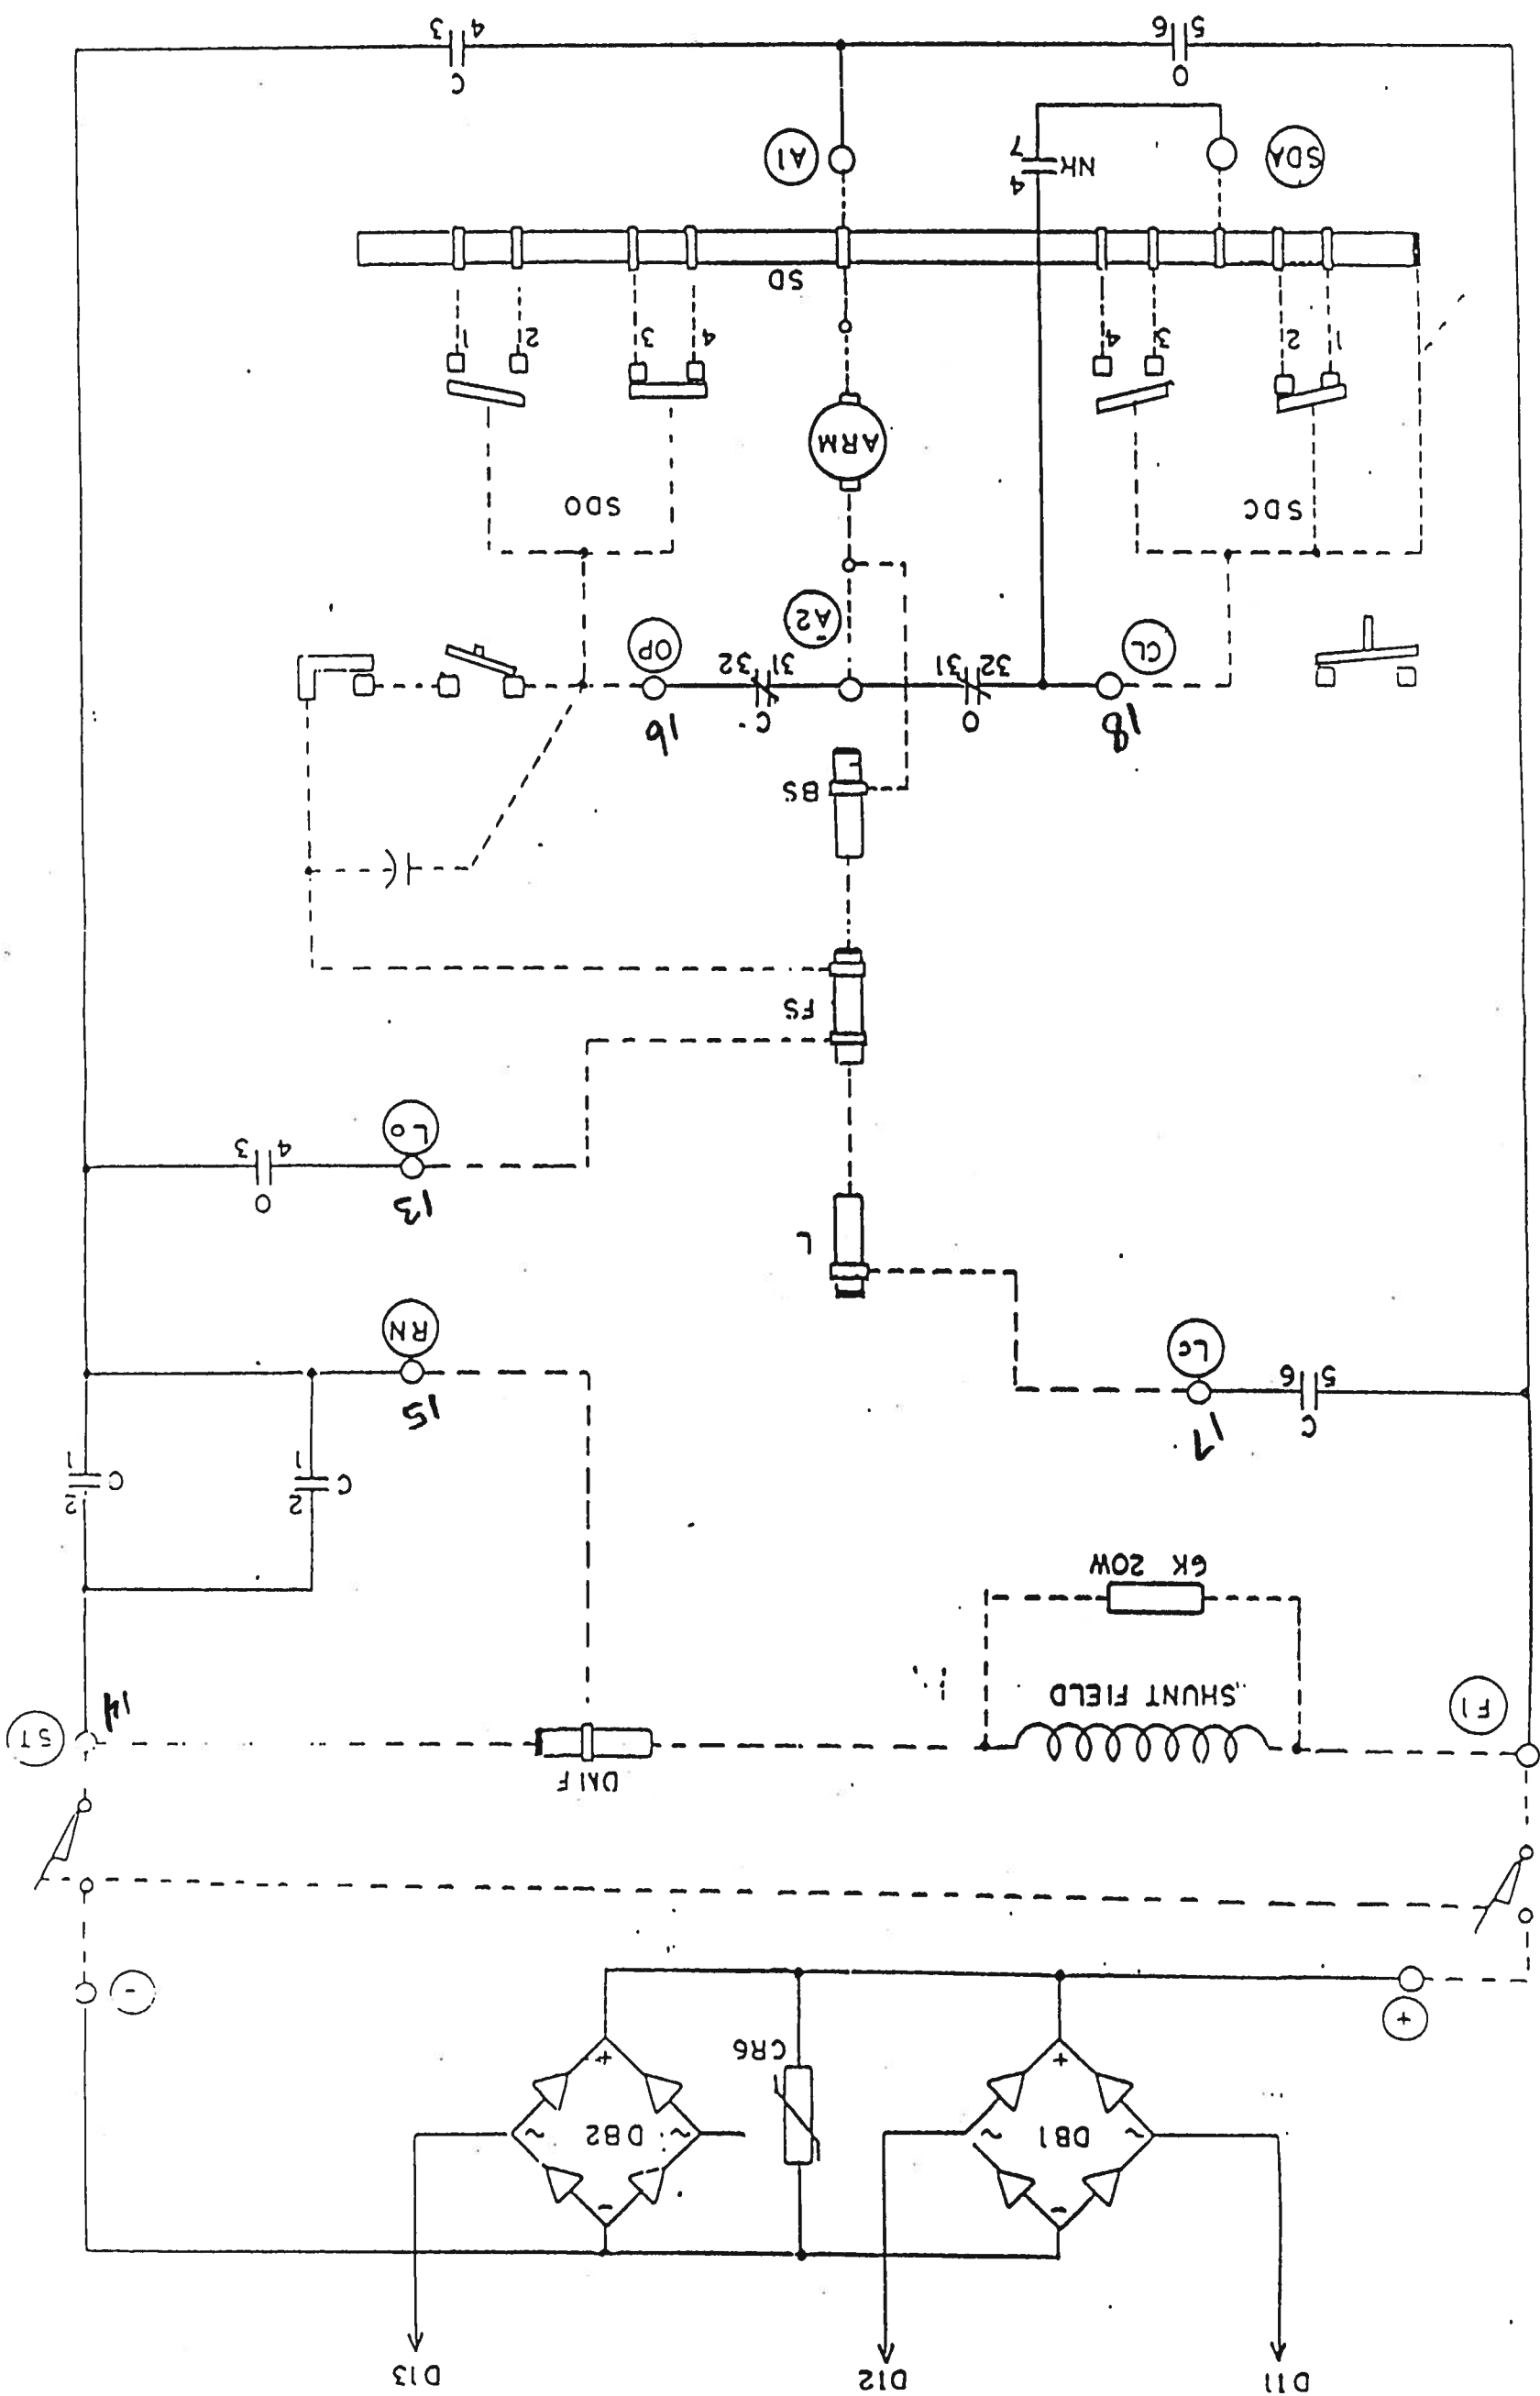

TO CAR
CONTROLLER

INTERNAL
WIRING

MAIN JUNCTION BOX

*
VL+

V+ (24VDC)

VC (DC
COMMON)

LCφ (AC
COMMON)

LSN (125VAC)

LLP (115VAC) LIGHT. (HOT)

LLN LIGHT.

GND

* USE "VL+" FOR LOW VOLTAGE LAMPS.
USE "LSN" FOR 115AC.

SC 2410-A

DRWG#: 241.1

CAR POWER DISTRIBUTION


JOB#: 1406

DATE:
1-11-88

PAGE OF

REF: V.A.M.C. PERRY POINT

27 CAN BE A COMP VP
24 CAN BE A COMP VP

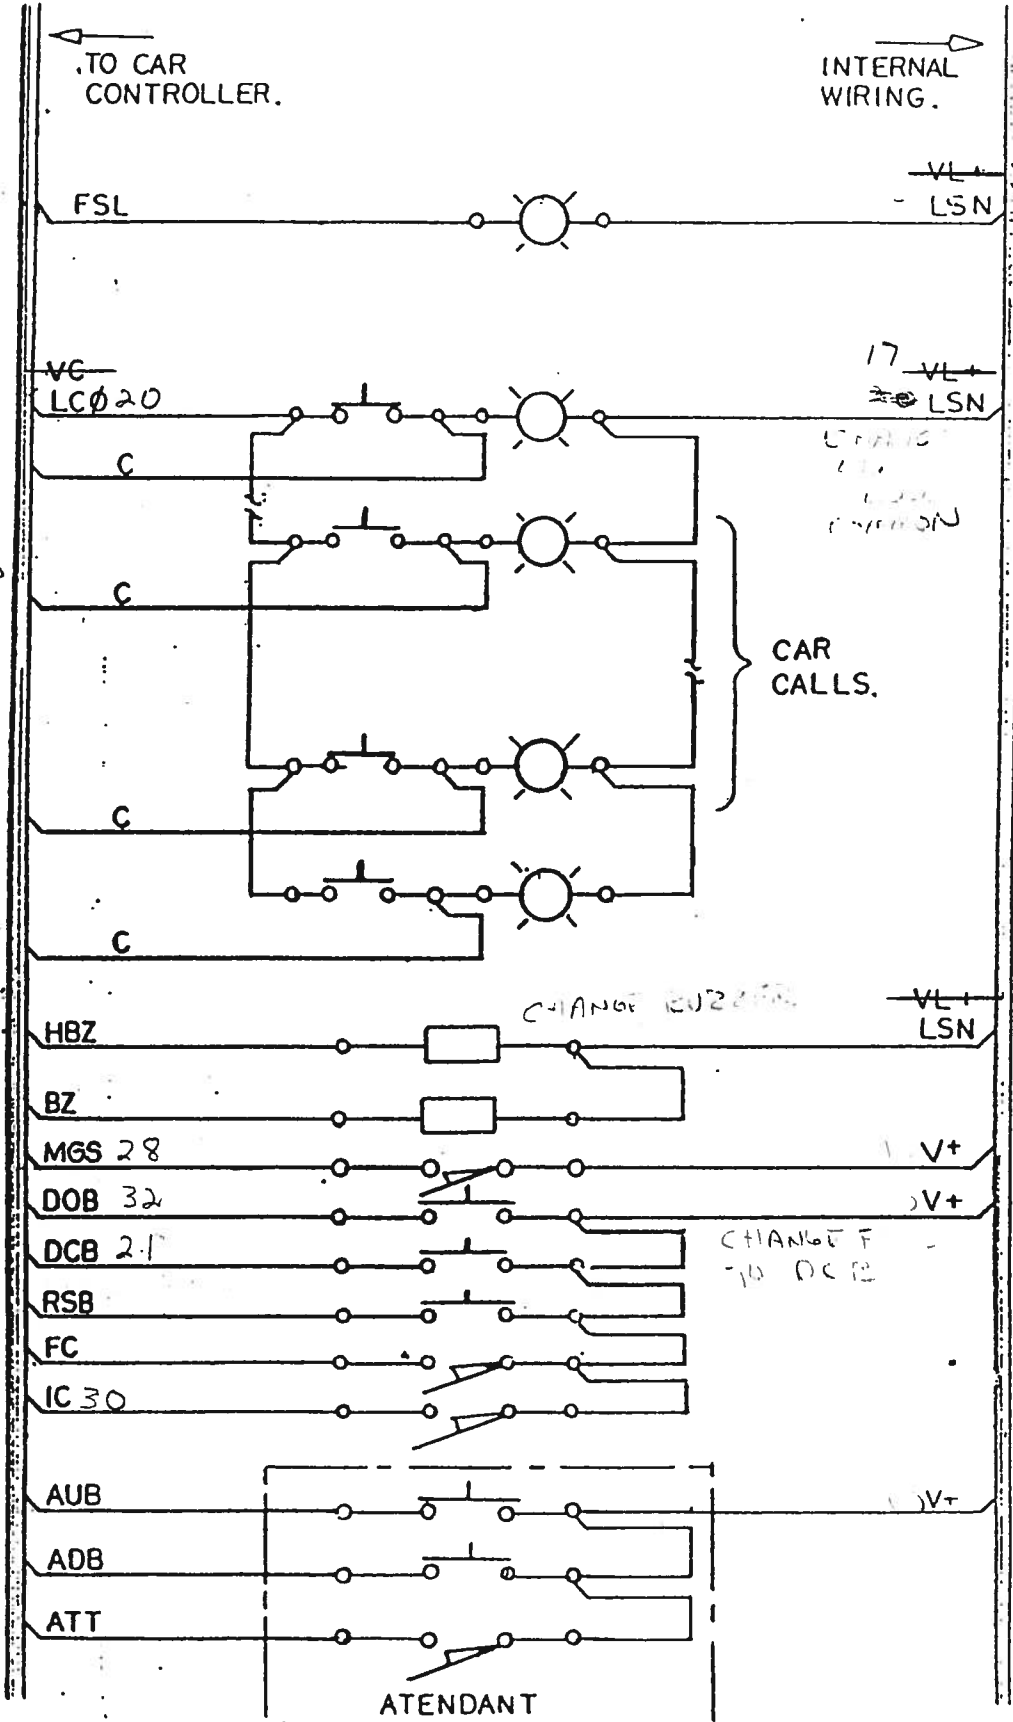


PUT 27
ON V+
+ 24 ALSO



19 18
22 15
12 25

20 17

SC 2420-A

DRWG#: 242.1	CAR STATION 1 OF 2	JOB#: 1406	DATE: 1-11-88
PAGE . OF		REF: V.A.M.C. PERRY POINT	

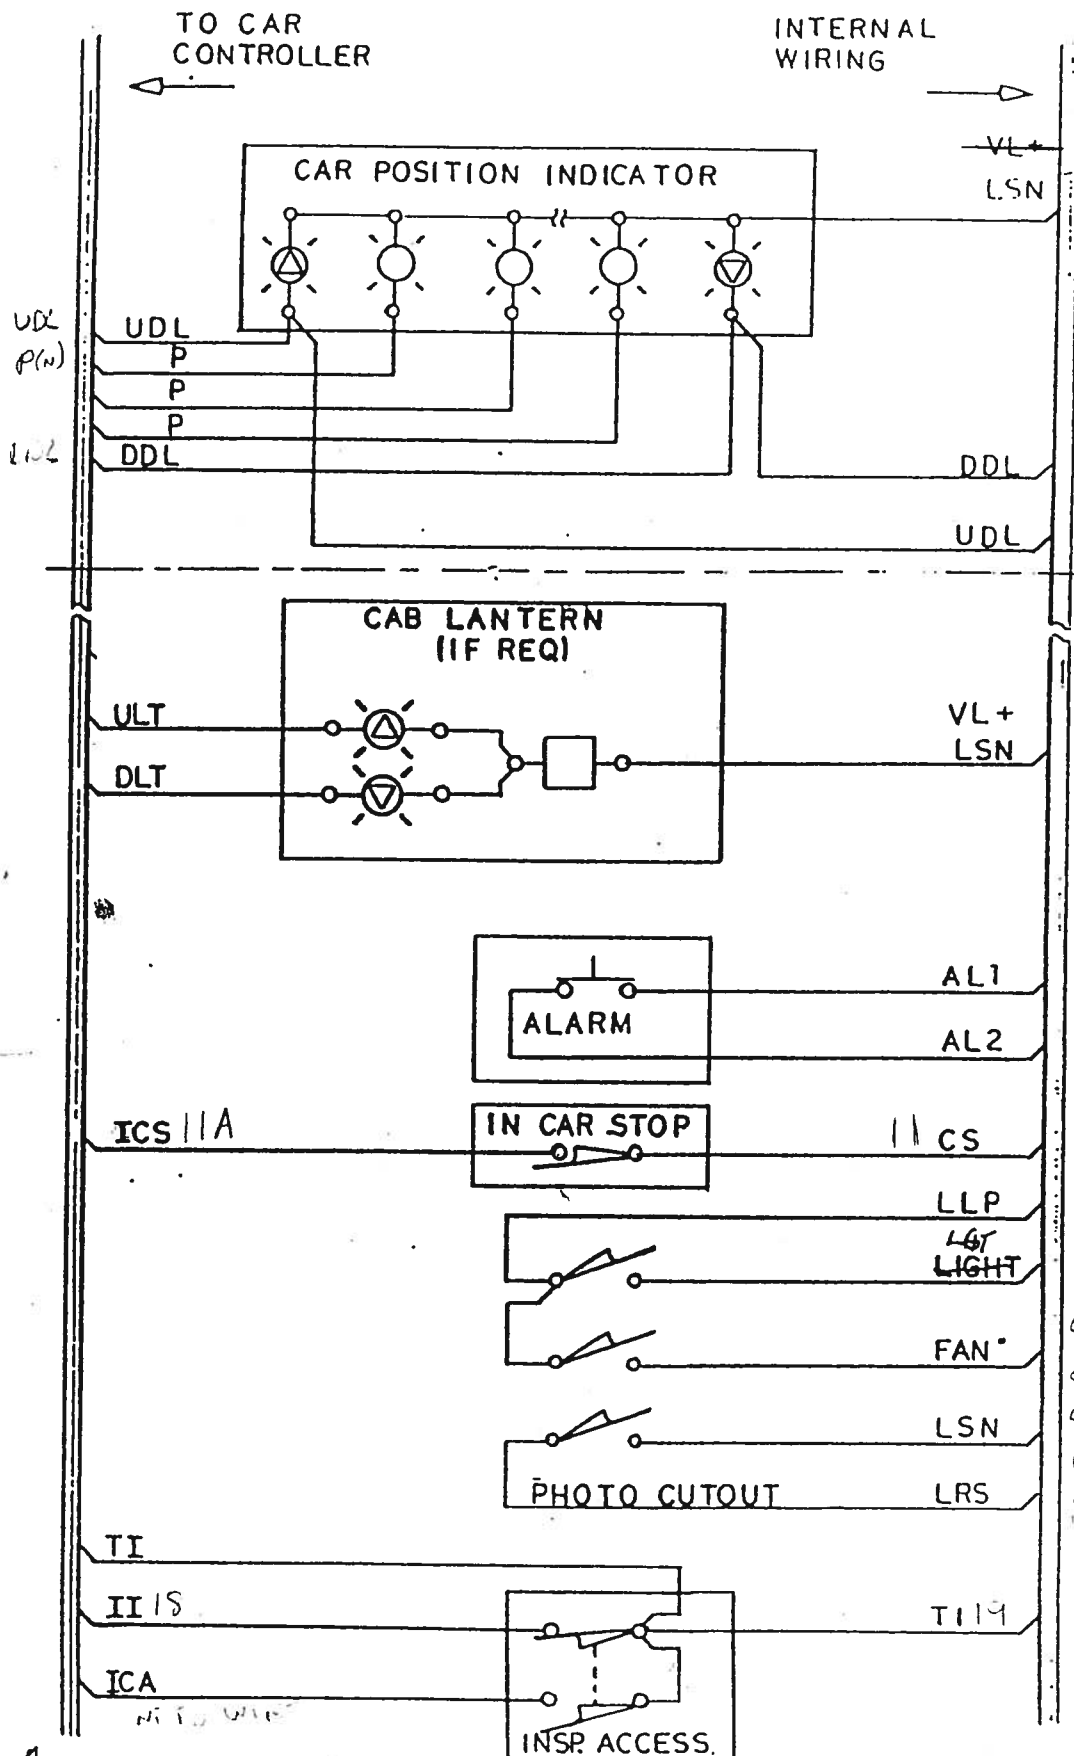

5C2421-A

DRWG#: 243.1


CAR STATION 2 OF 2

JOB#: 1406

DATE: 1-11-88

PAGE OF

REF: V.I.A.M.C. PERRY PRINT

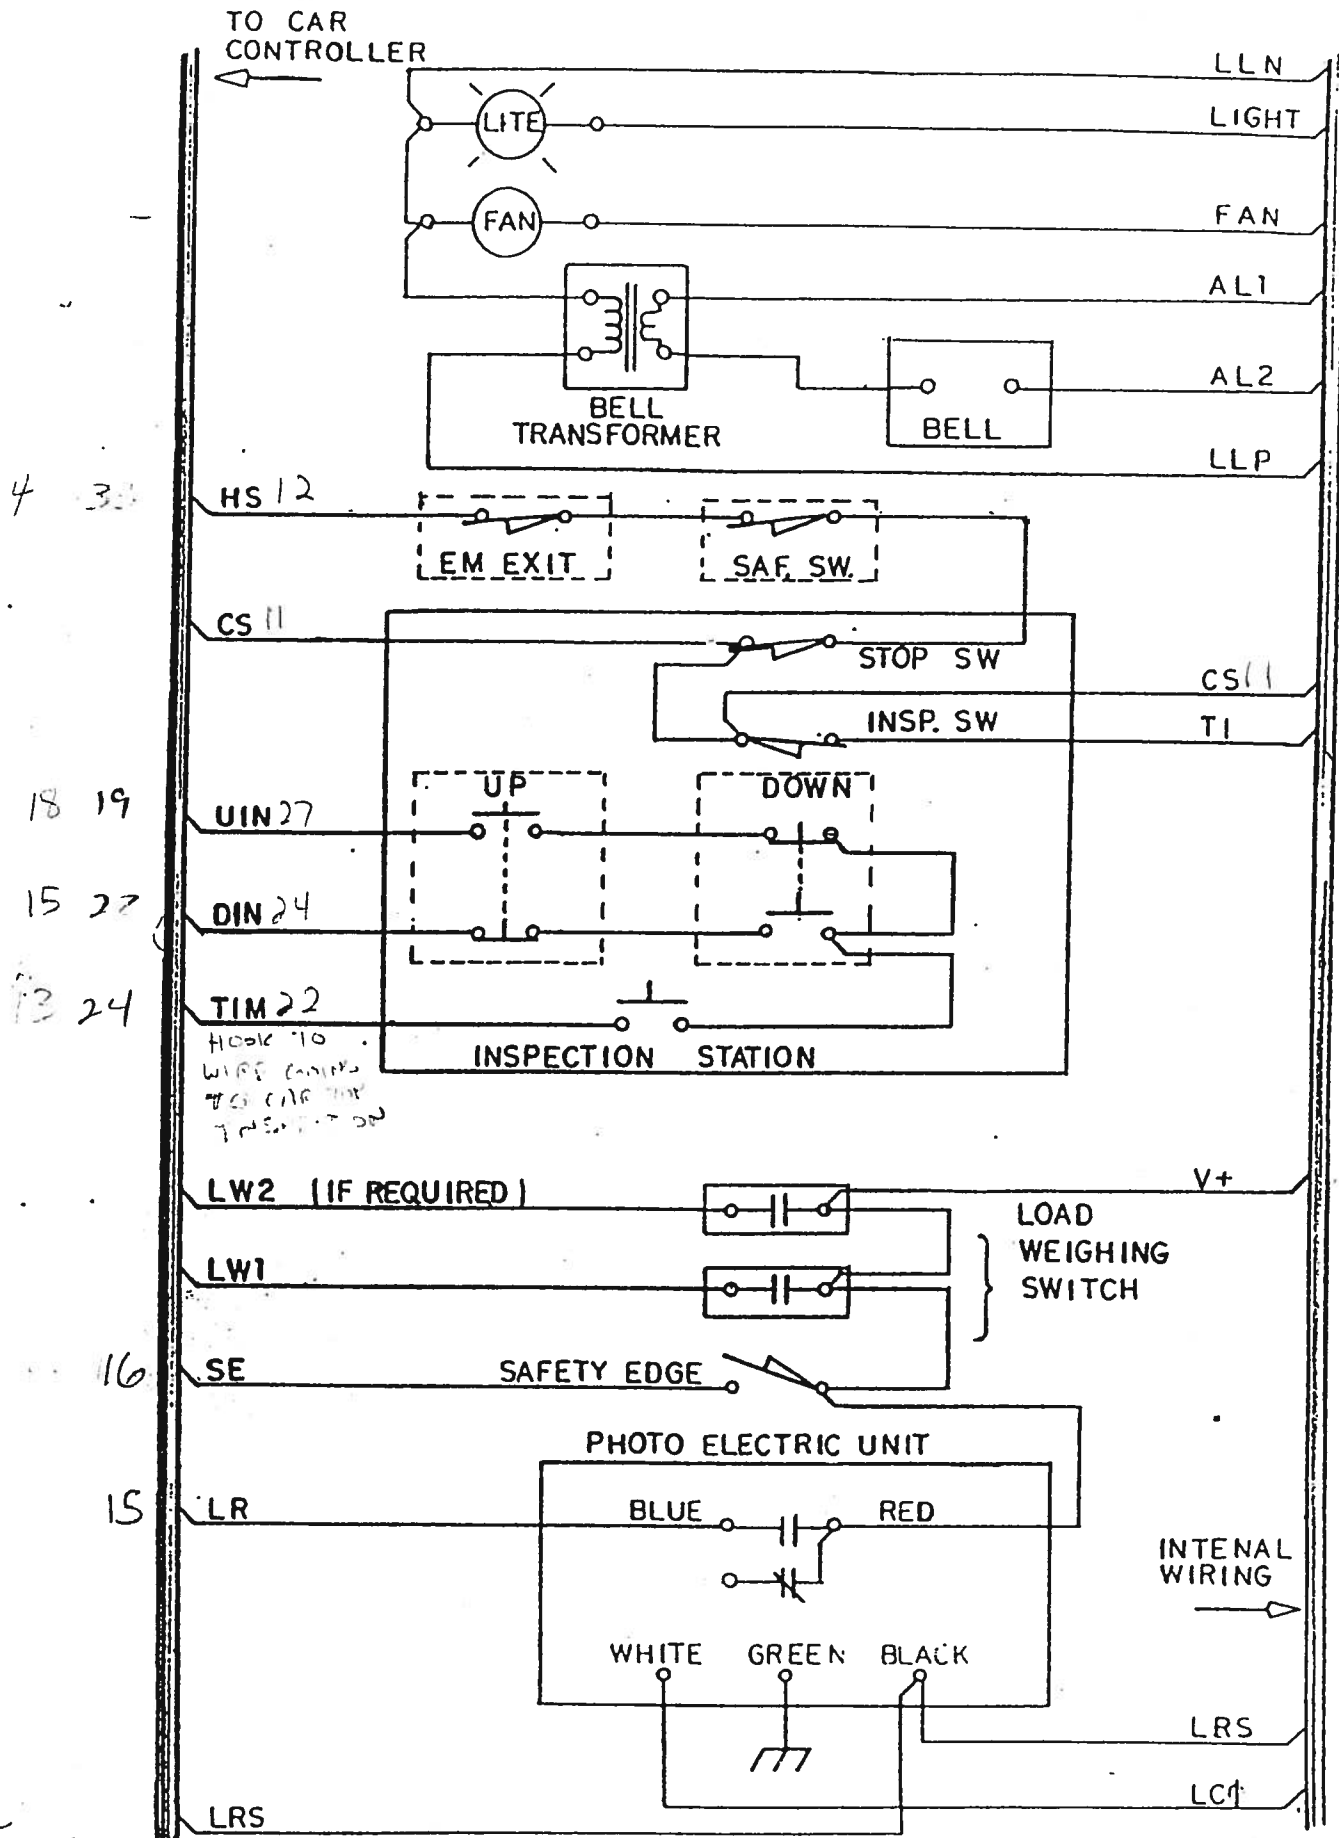

SC 2440-A

DRWG#: 244-1


TOP OF CAR WIRING

JOB#: 1406

DATE: 1-11-88

PAGE OF

REF: V.A.M.C. PERRY POINT

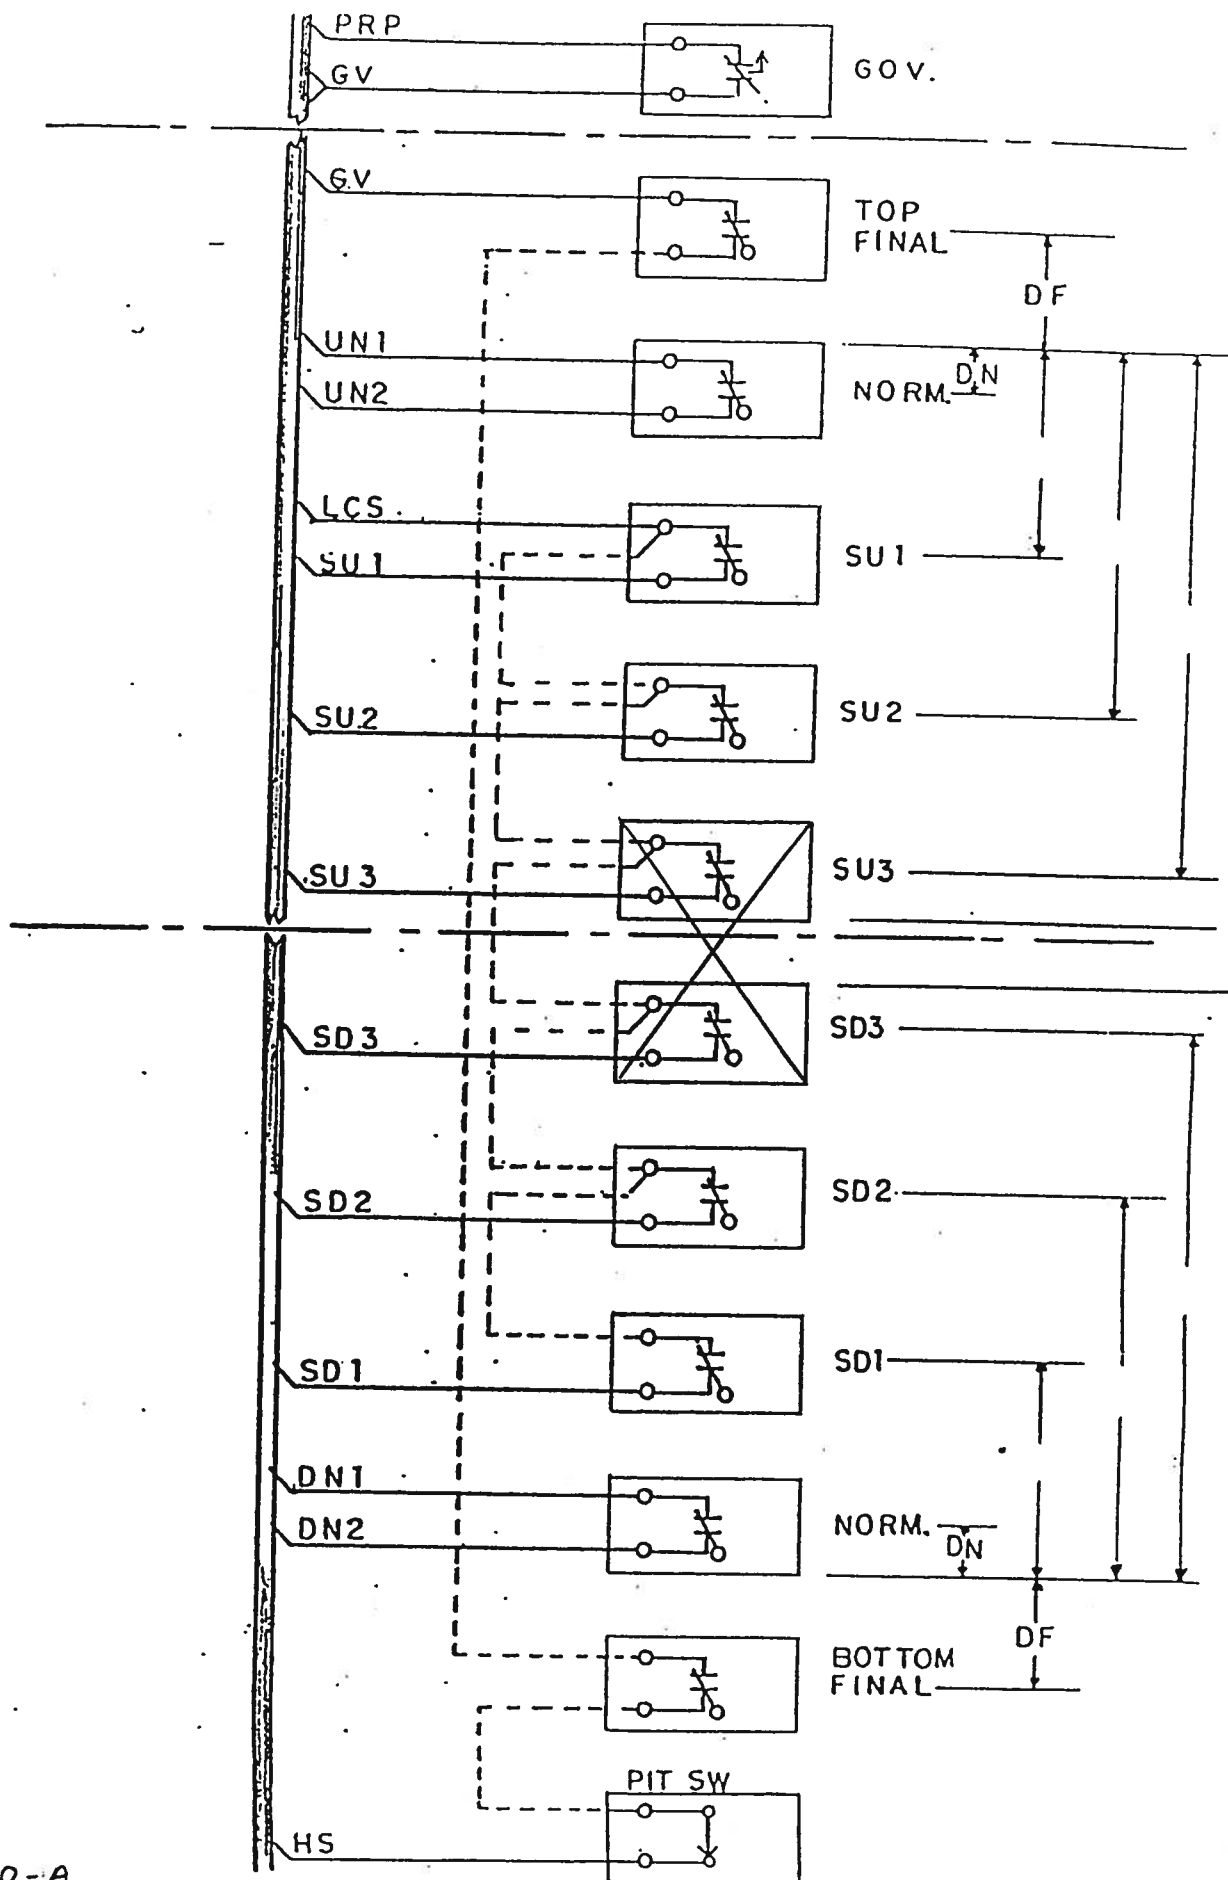

SC2510-A

DRWG#: 251.1


PAGE . OF

HOISTWAY LIMIT SWITCH.

JOB#: 1406

DATE:
1-11-88

REF: V.A.M.C. PERRY POINT

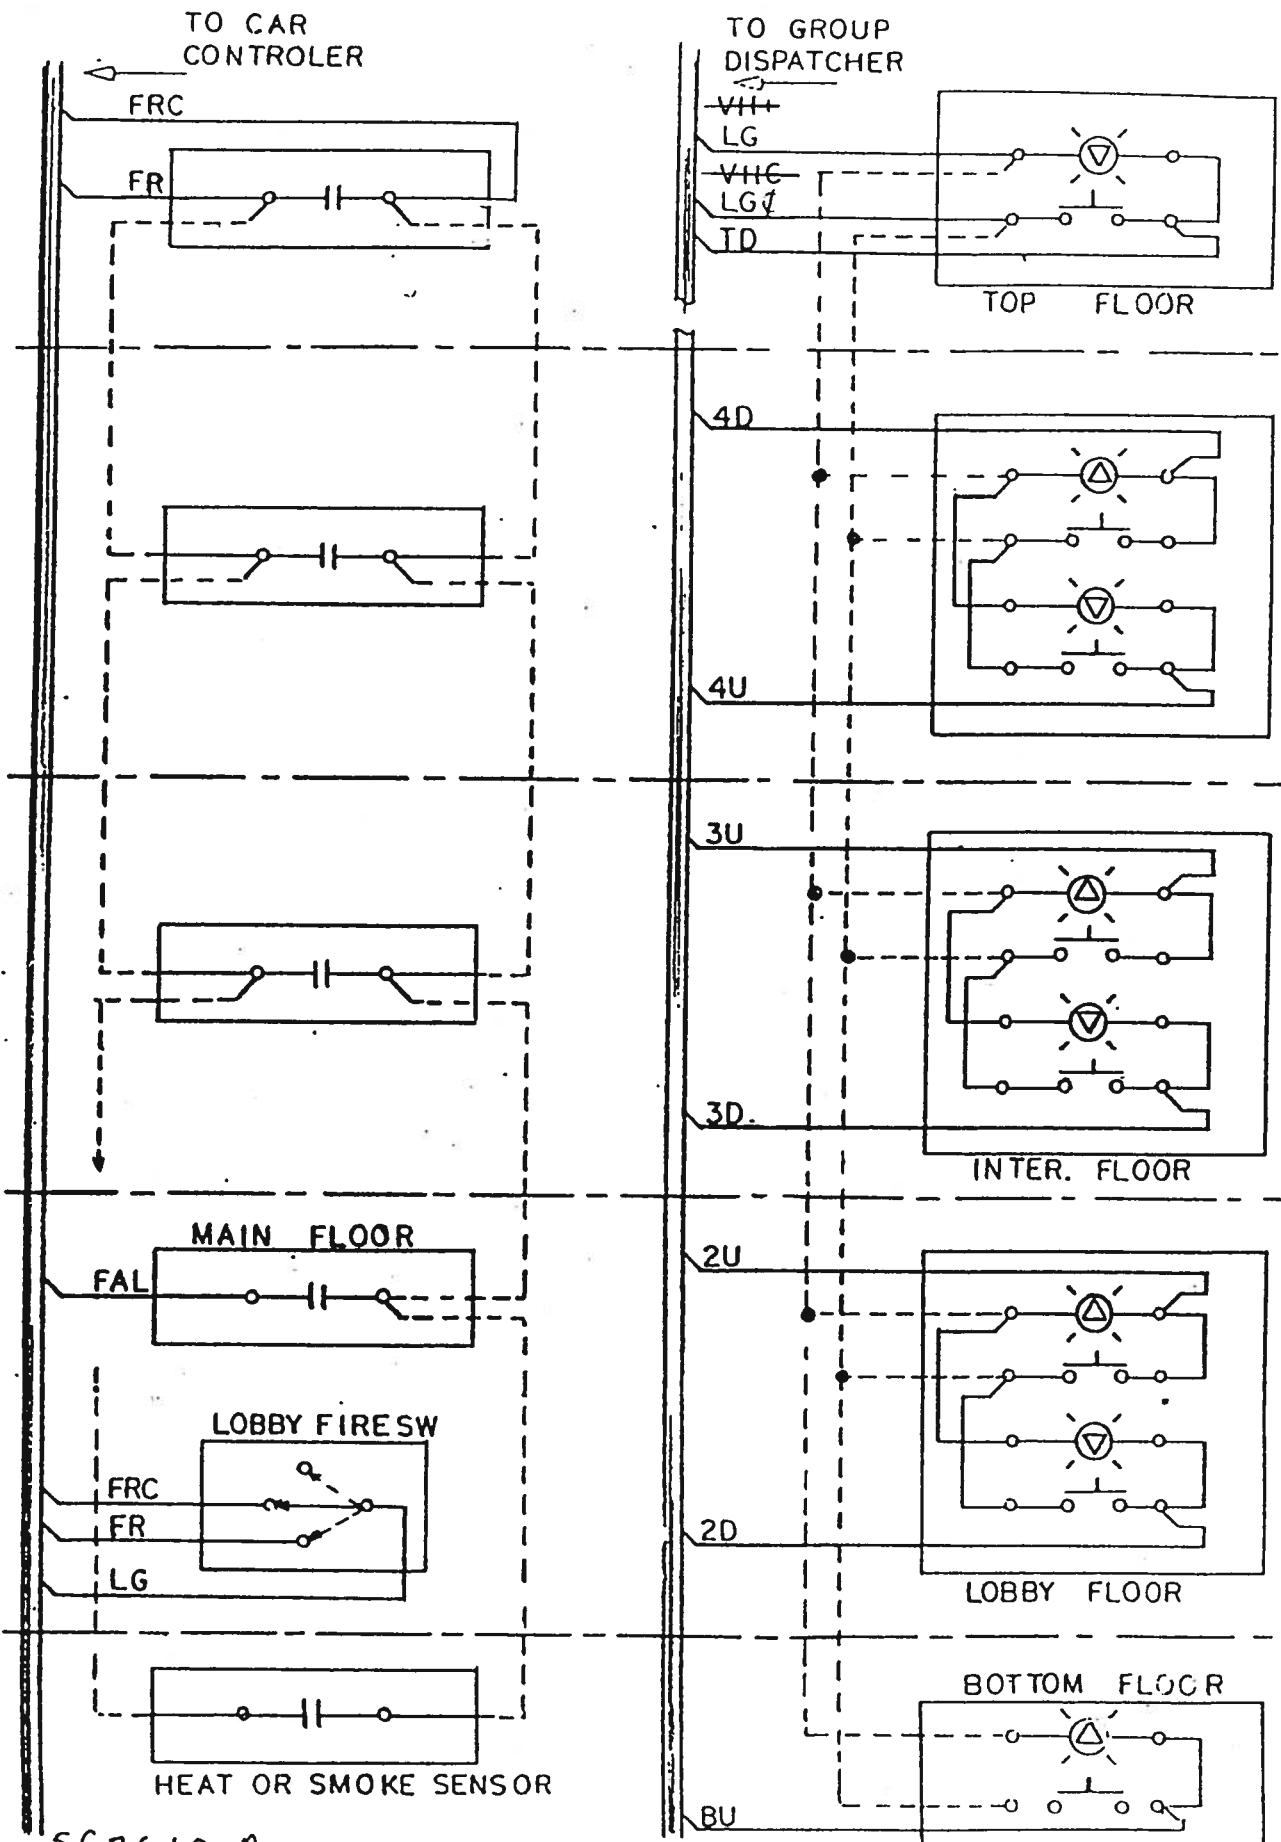

SC2610-A

DRWG#: 261-1

HALL PUSH-BUTTON RISER.


JOB#: 1406

DATE: 1-11-88

PAGE OF

REF: V.I.A.M.C. PERRY POINT

* NEGATIVE FOR UP LANTERN

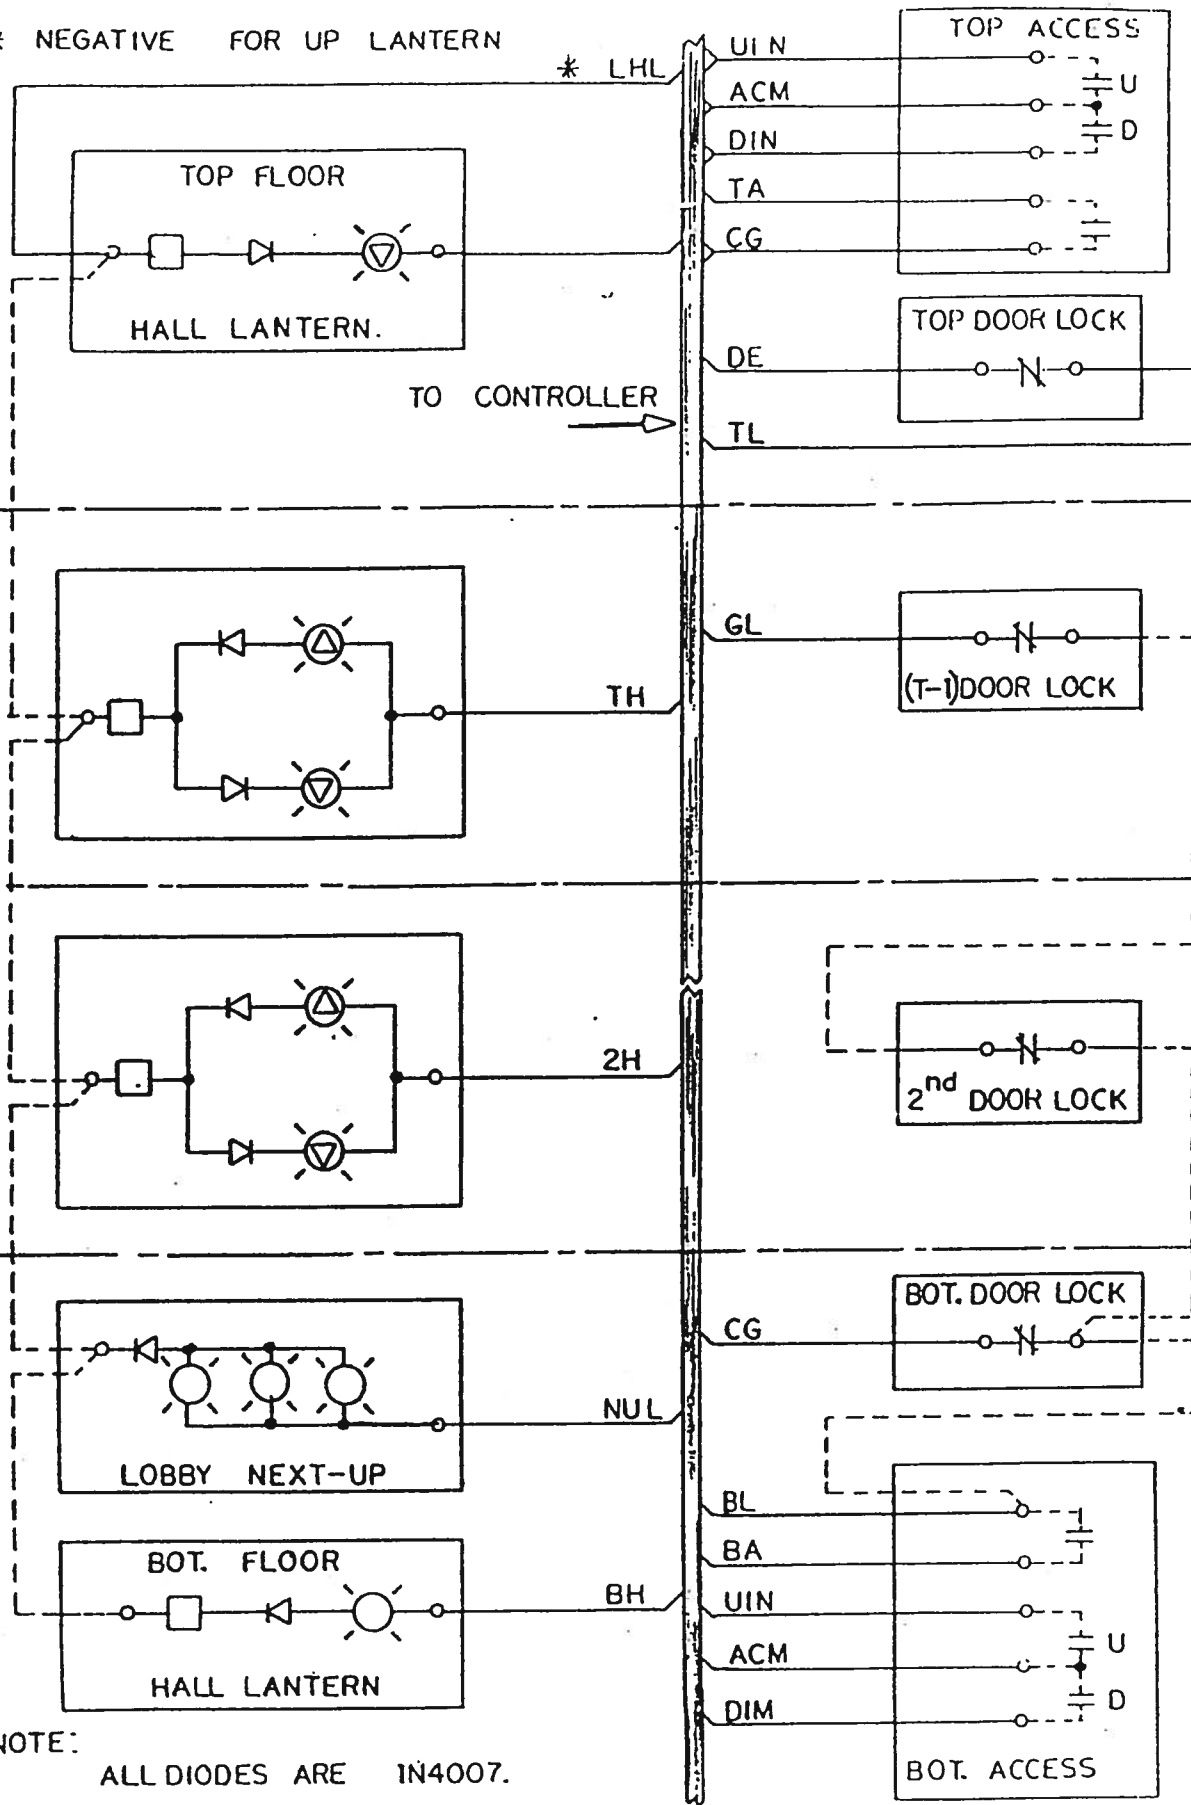

NOTE:

ALL DIODES ARE 1N4007.

SC 2520-A

DRWG#: 252.1

PAGE OF

LOCKS AND LANTERNS
WITH ACCESS.


JOB#: 1406

DATE:
1-11-88

REF: V.A.M.C. PERRY POINT

VP20 1CL⁵

TO CONTROLLER

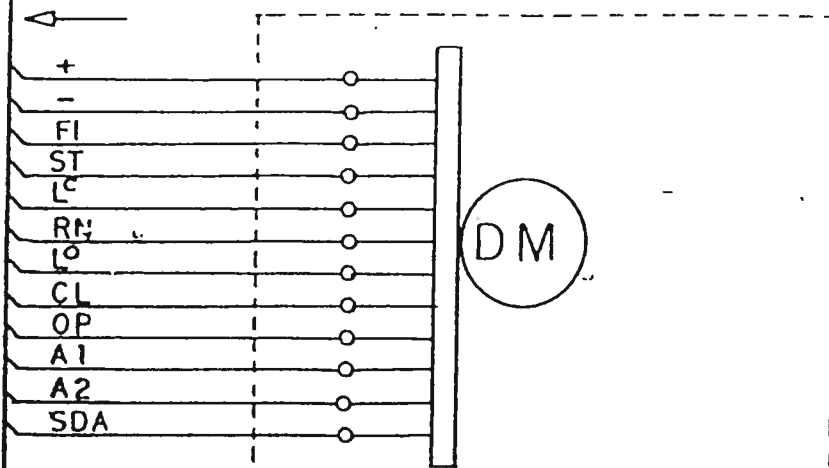


16 21




INTERNAL WIRING

17 20

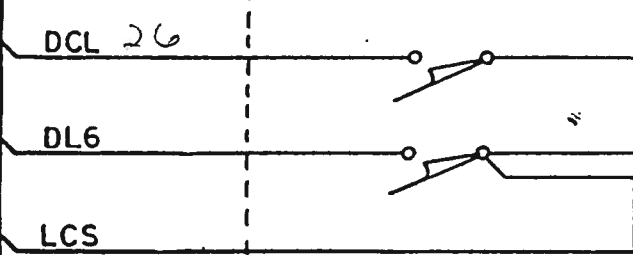

G.A.L. MOM/MOH

5 32

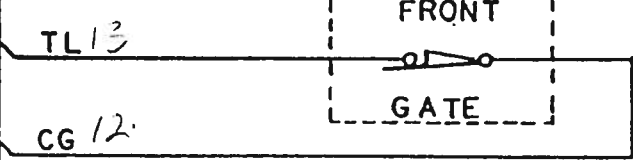


4 2CL



5C2462-A

DRWG#: 246.2	MOM FRONT DOOR OPERATOR	JOB#: 1406	DATE: 1-11-88
PAGE OF		REF: VAMP, PERRY POINT	

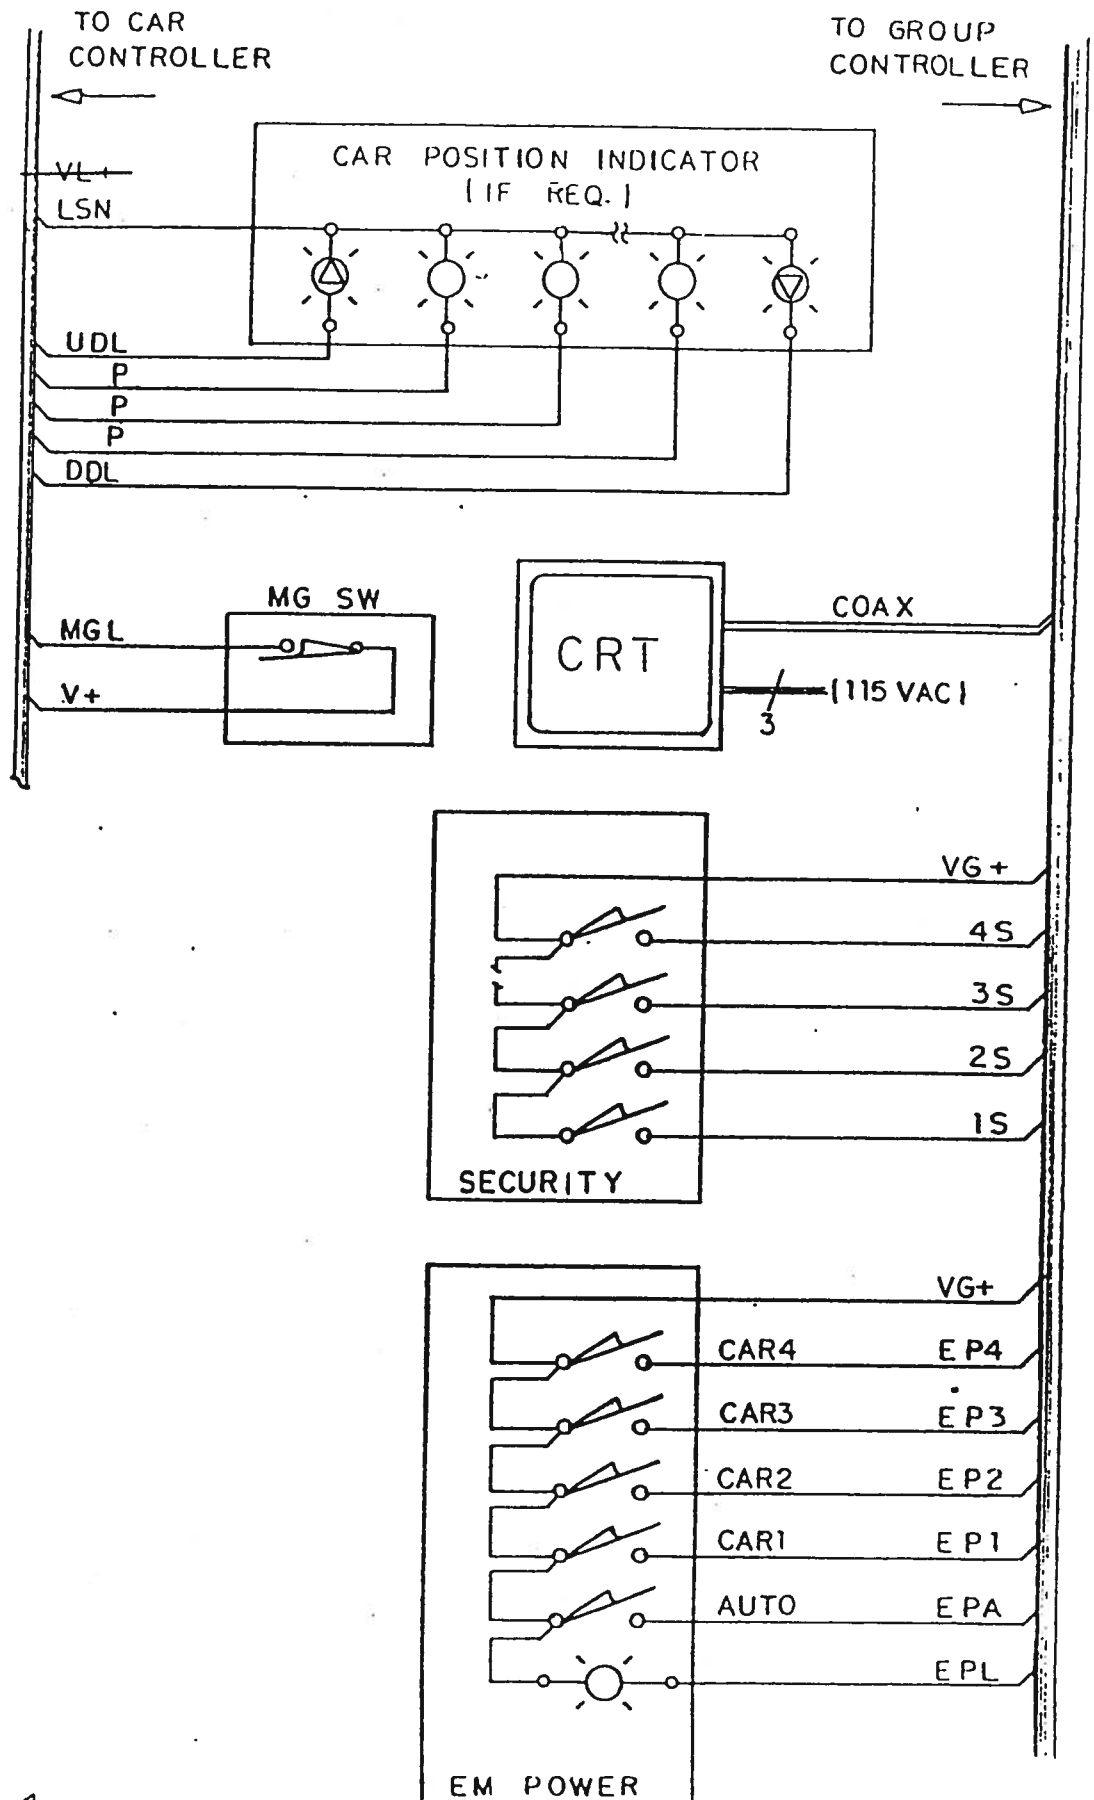

SC 2620-A

DRWG#: 262-2


LOBBY STATION.

JOB #: 14D6

DATE: 1-11-88

PAGE OF

REF: V.A.M.C. PERRY POINT

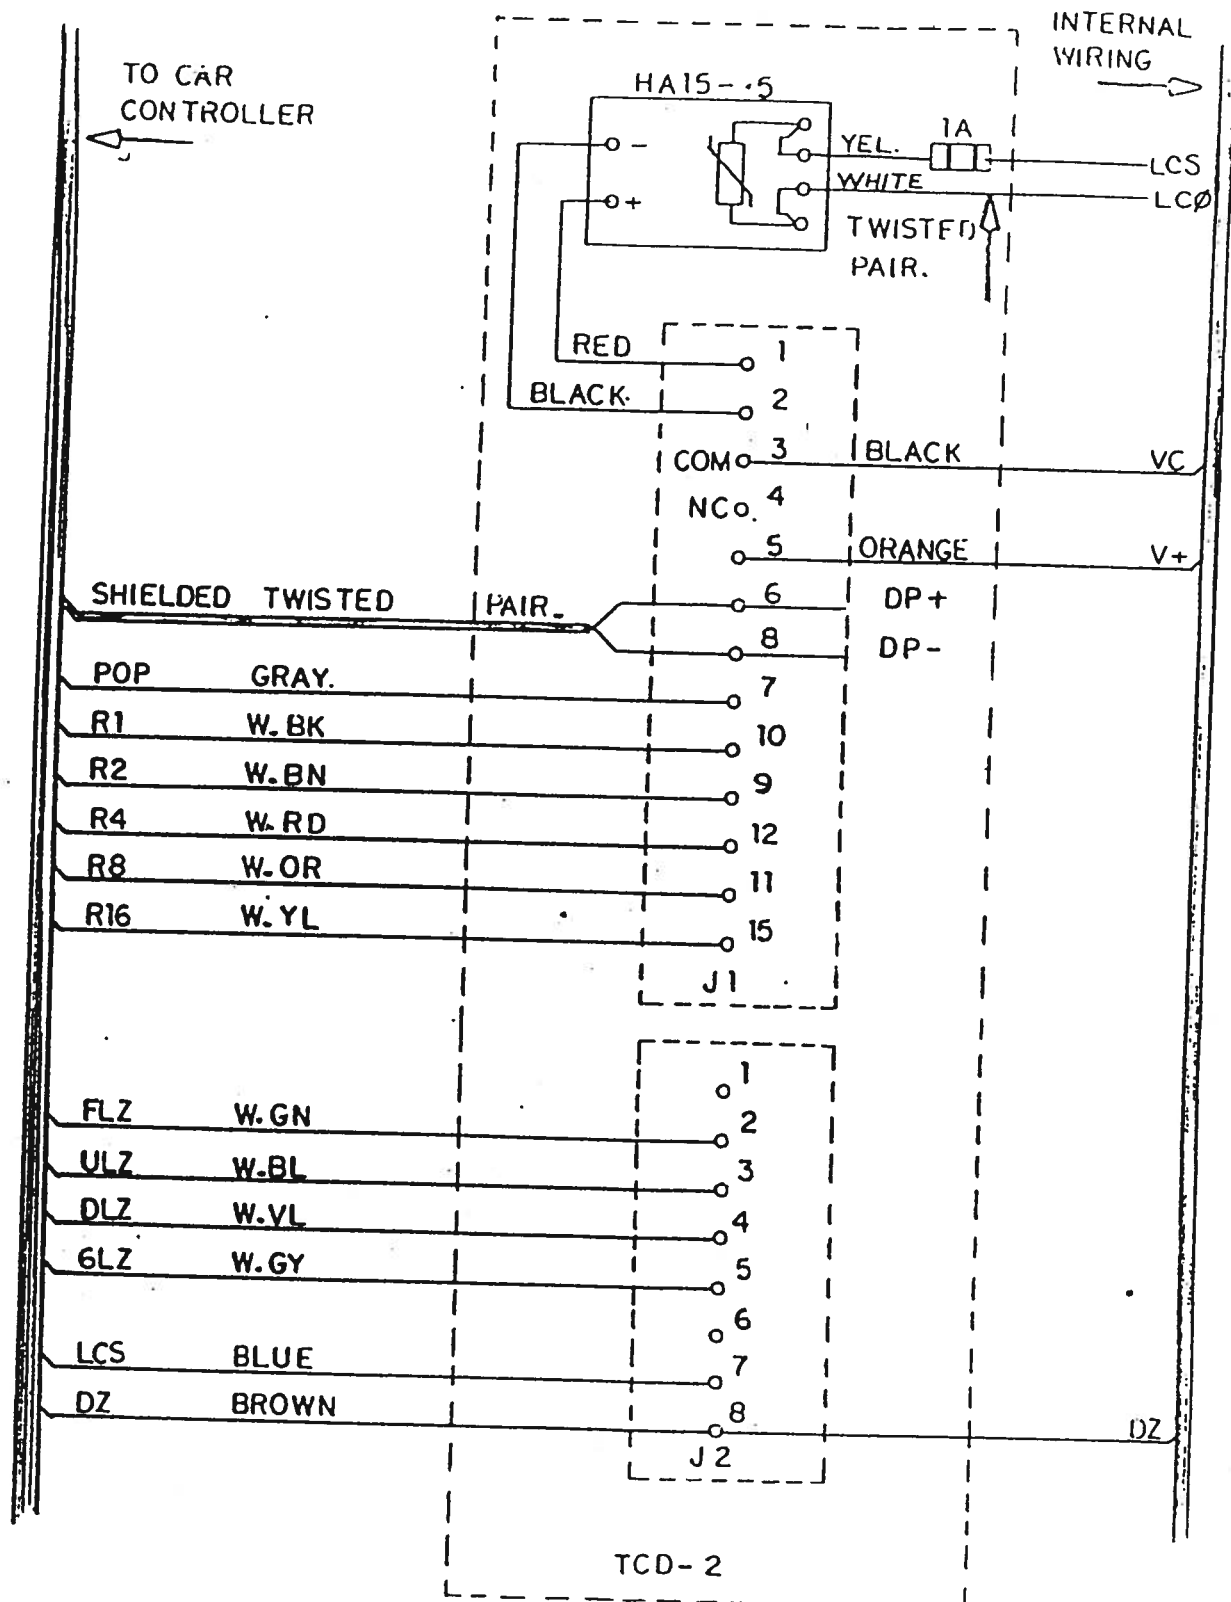

SC2450-A

DRWG#: 245.1

PAGE OF

LEVELING DIGITIZER.

JOB#: 1406

DATE: 1-11-88

REF: V.A.M.C. PERRY POINT