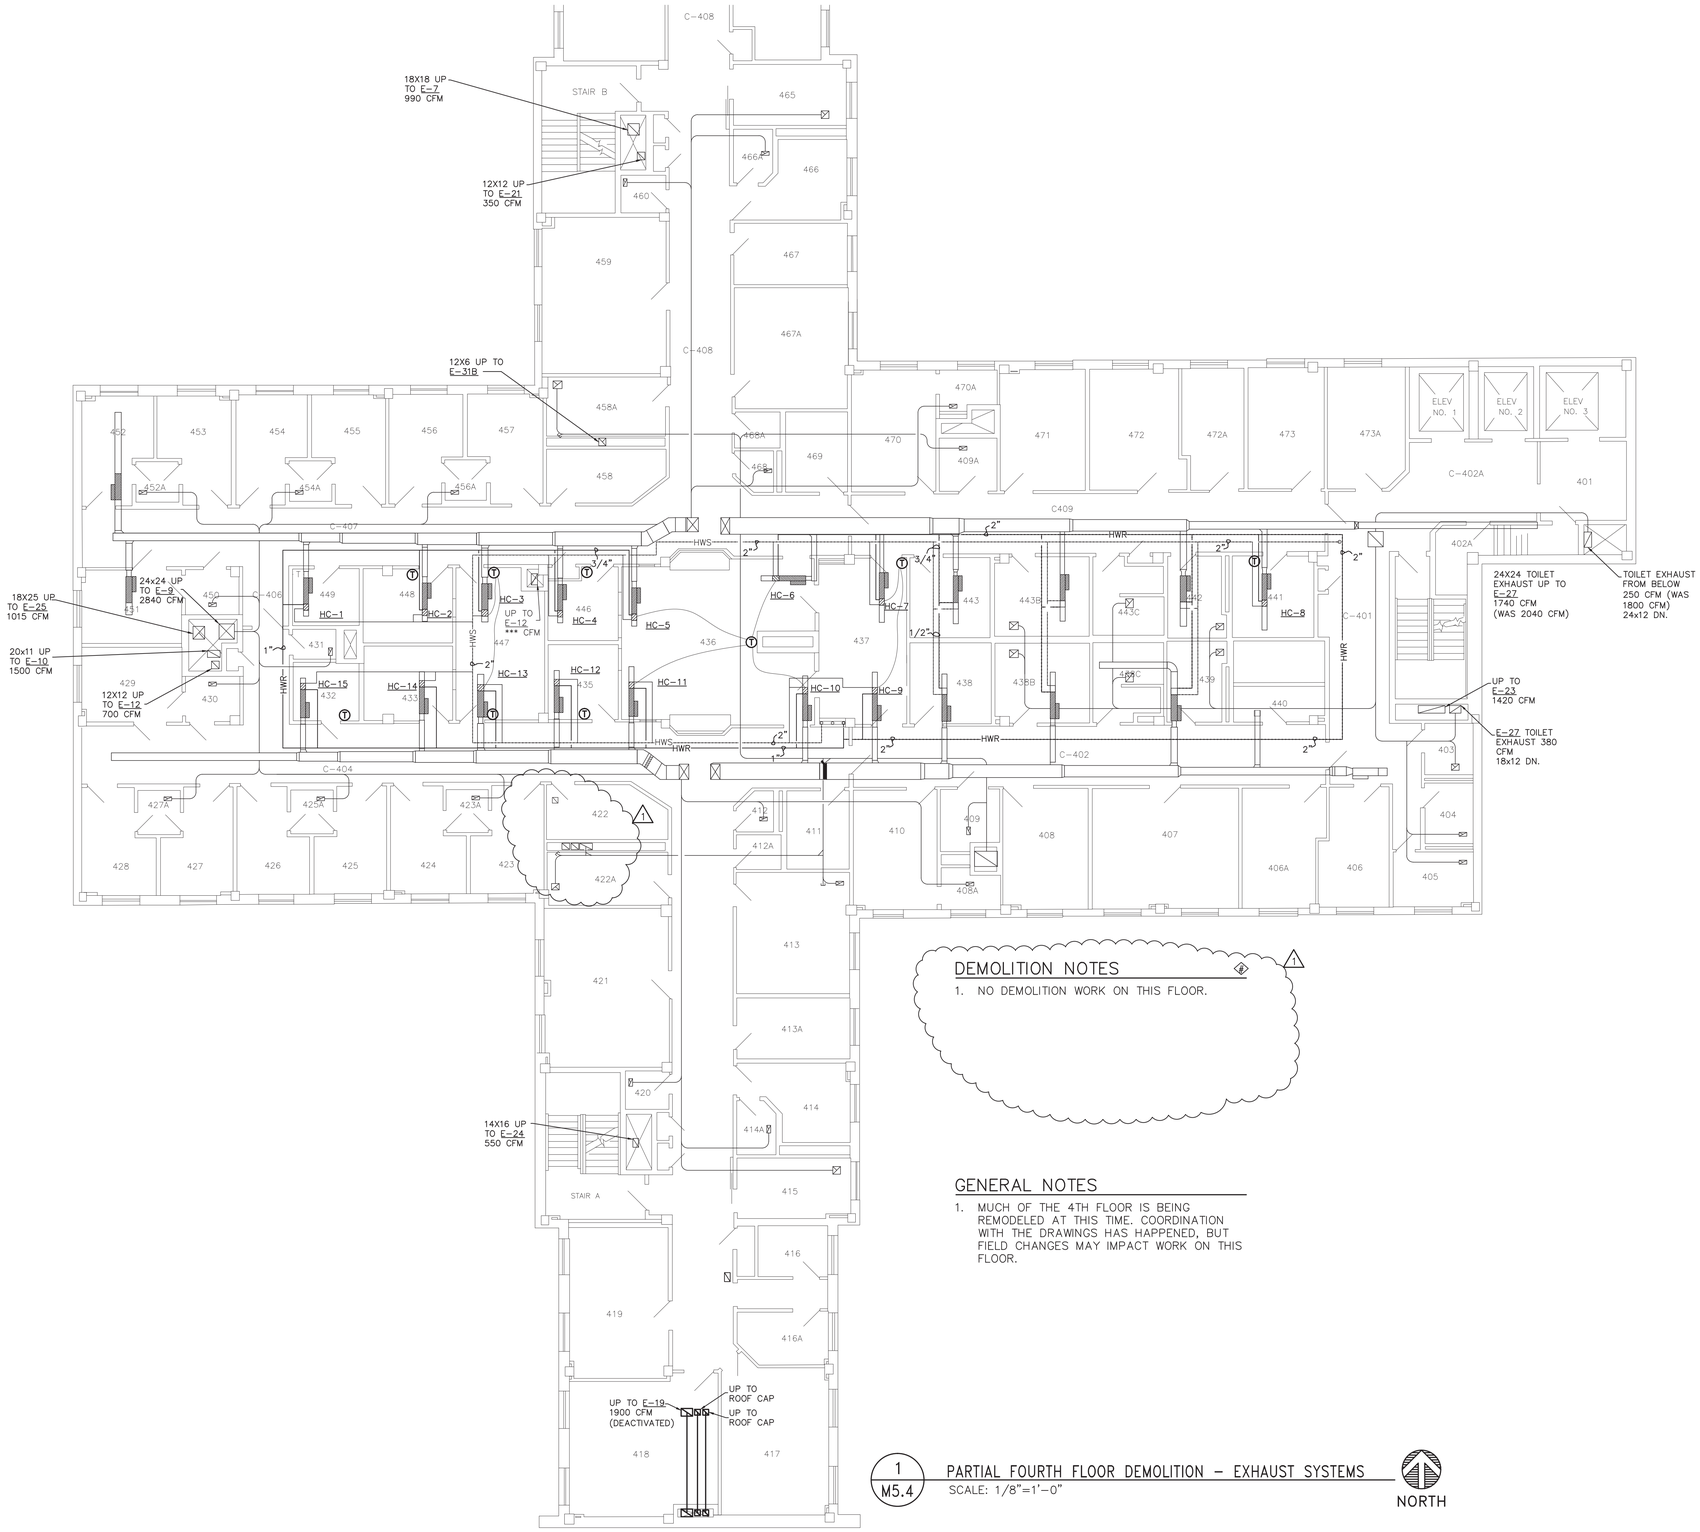

DEMOLITION NOTES

1. NO DEMOLITION WORK ON THIS FLOOR.

GENERAL NOTES

1. MUCH OF THE 4TH FLOOR IS BEING REMODELED AT THIS TIME. COORDINATION WITH THE DRAWINGS HAS HAPPENED, BUT FIELD CHANGES MAY IMPACT WORK ON THIS FLOOR.

1 / M5.4 PARTIAL FOURTH FLOOR DEMOLITION - EXHAUST SYSTEMS
SCALE: 1/8"=1'-0"

NORTH

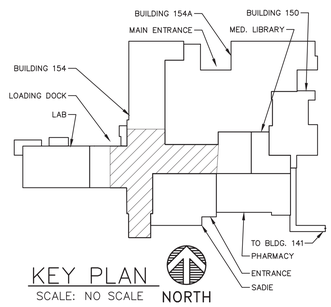

KEY PLAN
SCALE: NO SCALE NORTH

Scale: 1/8"=1'-0"

-	-
-	-
-	-
-	-
-	-
-	-
-	-
-	-
1: REVISE ROOM 422 AND ROOF ABOVE	6-8-15
Revisions:	Date

CONSULTANTS:

PCD ENGINEERING SERVICES
323 3RD AVENUE, #100 TEL: 303.678.1108
LONGMONT, CO 80501 FAX: 303.678.1142
JOB NO. 14004 PCDENGINEERING.COM

COLORADO REGISTERED PETER C. D'ANTONIO 33993 PROFESSIONAL ENGINEER 1/30/15

ARCHITECT/ENGINEERS:

CONSTRUCTION ENGINEERING SOLUTIONS, LLC.
715 Roundup Drive
Grand Junction, Colorado 81507
970.549.4504

Drawing Title: PARTIAL FOURTH FLOOR DEMOLITION PLAN

Approved Project Director: WAYNE DELZER, P.E.
Phone: 406.447.7290

Project Title: COMM. AUDIT CORRECTIONS ELEMENT 4 - EXHAUST SYSTEMS RENOVATIONS

Location: VAMC Fort Harrison, MT

Date: January, 2015 | Checked: PD | Drawn: JLE

Project Number: 436-14-001

Building Number: 154

Drawing Number: M5.4

Dwg. 36 of 61

Office of Construction and Facilities Management

Department of Veterans Affairs

VA FORM 08-6231