



three inches = one foot  
 one and one half inches = one foot  
 one inch = one foot  
 three quarters inch = one foot  
 one half inch = one foot  
 three eighths inch = one foot  
 one quarter inch = one foot  
 one eighth inch = one foot  
 one eighth inch = one foot

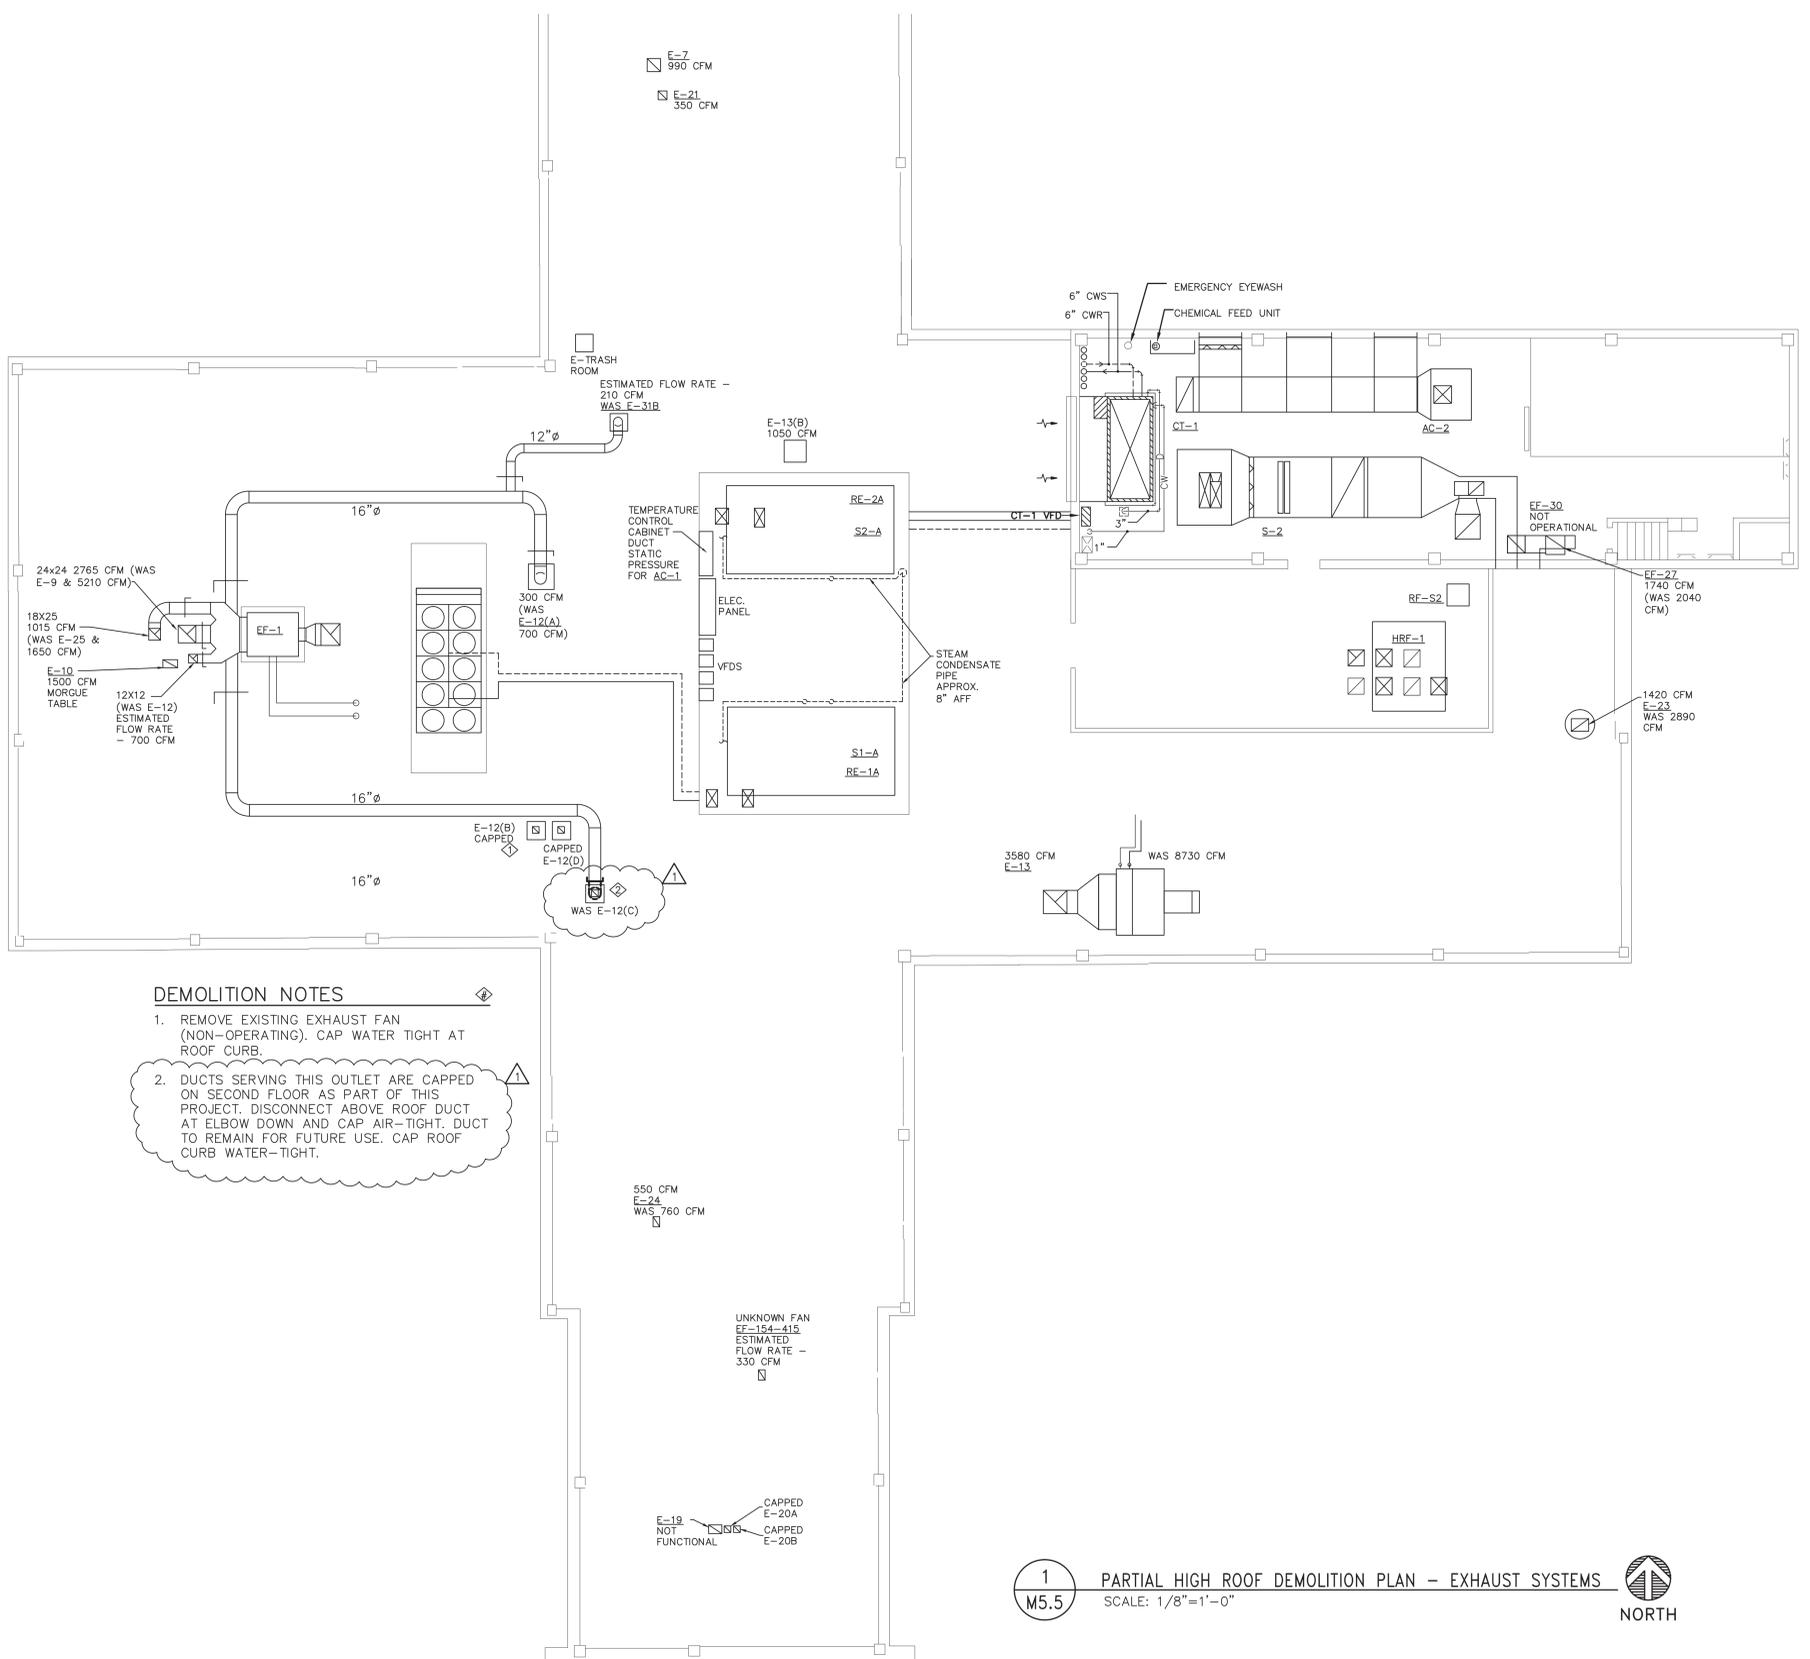

**DEMOLITION NOTES**

1. REMOVE EXISTING EXHAUST FAN (NON-OPERATING). CAP WATER TIGHT AT ROOF CURB.
2. DUCTS SERVING THIS OUTLET ARE CAPPED ON SECOND FLOOR AS PART OF THIS PROJECT. DISCONNECT ABOVE ROOF DUCT AT ELBOW DOWN AND CAP AIR-TIGHT. DUCT TO REMAIN FOR FUTURE USE. CAP ROOF CURB WATER-TIGHT.

**1** PARTIAL HIGH ROOF DEMOLITION PLAN - EXHAUST SYSTEMS  
 M5.5 SCALE: 1/8"=1'-0" NORTH

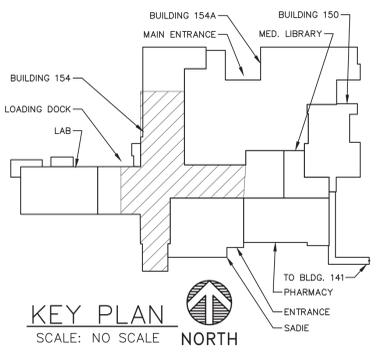

Revisions	Date
1 REVISE ROOM 422 AND ROOF ABOVE	6-8-15

**CONSULTANTS:**

**PCD ENGINEERING SERVICES**  
 323 3RD AVENUE, #100 TEL: 303.678.1108  
 LONGMONT, CO 80501 FAX: 303.678.1142  
 JOB NO. 14004 PCDENGINEERING.COM

**ARCHITECT/ENGINEERS:**

**CES CONSTRUCTION ENGINEERING SOLUTIONS, LLC.**  
 715 Roundup Drive  
 Grand Junction, Colorado 81507  
 970.549.4504

**Drawing Title:**  
 HIGH ROOF SECOND FLOOR DEMOLITION PLAN

**Approved Project Director:**  
 WAYNE DELZER, P.E.  
 Phone: 406.447.7290

**Project Title:**  
 COMM. AUDIT CORRECTIONS ELEMENT 4 - EXHAUST SYSTEMS RENOVATIONS

**Location:**  
 VAMC Fort Harrison, MT

**Date:** January, 2015  
**Checked:** PD  
**Drawn:** JLE

**Project Number:** 436-14-001  
**Building Number:** 154  
**Drawing Number:** M5.5  
 Dwg. 37 of 61

**Office of Construction and Facilities Management**  
 Department of Veterans Affairs