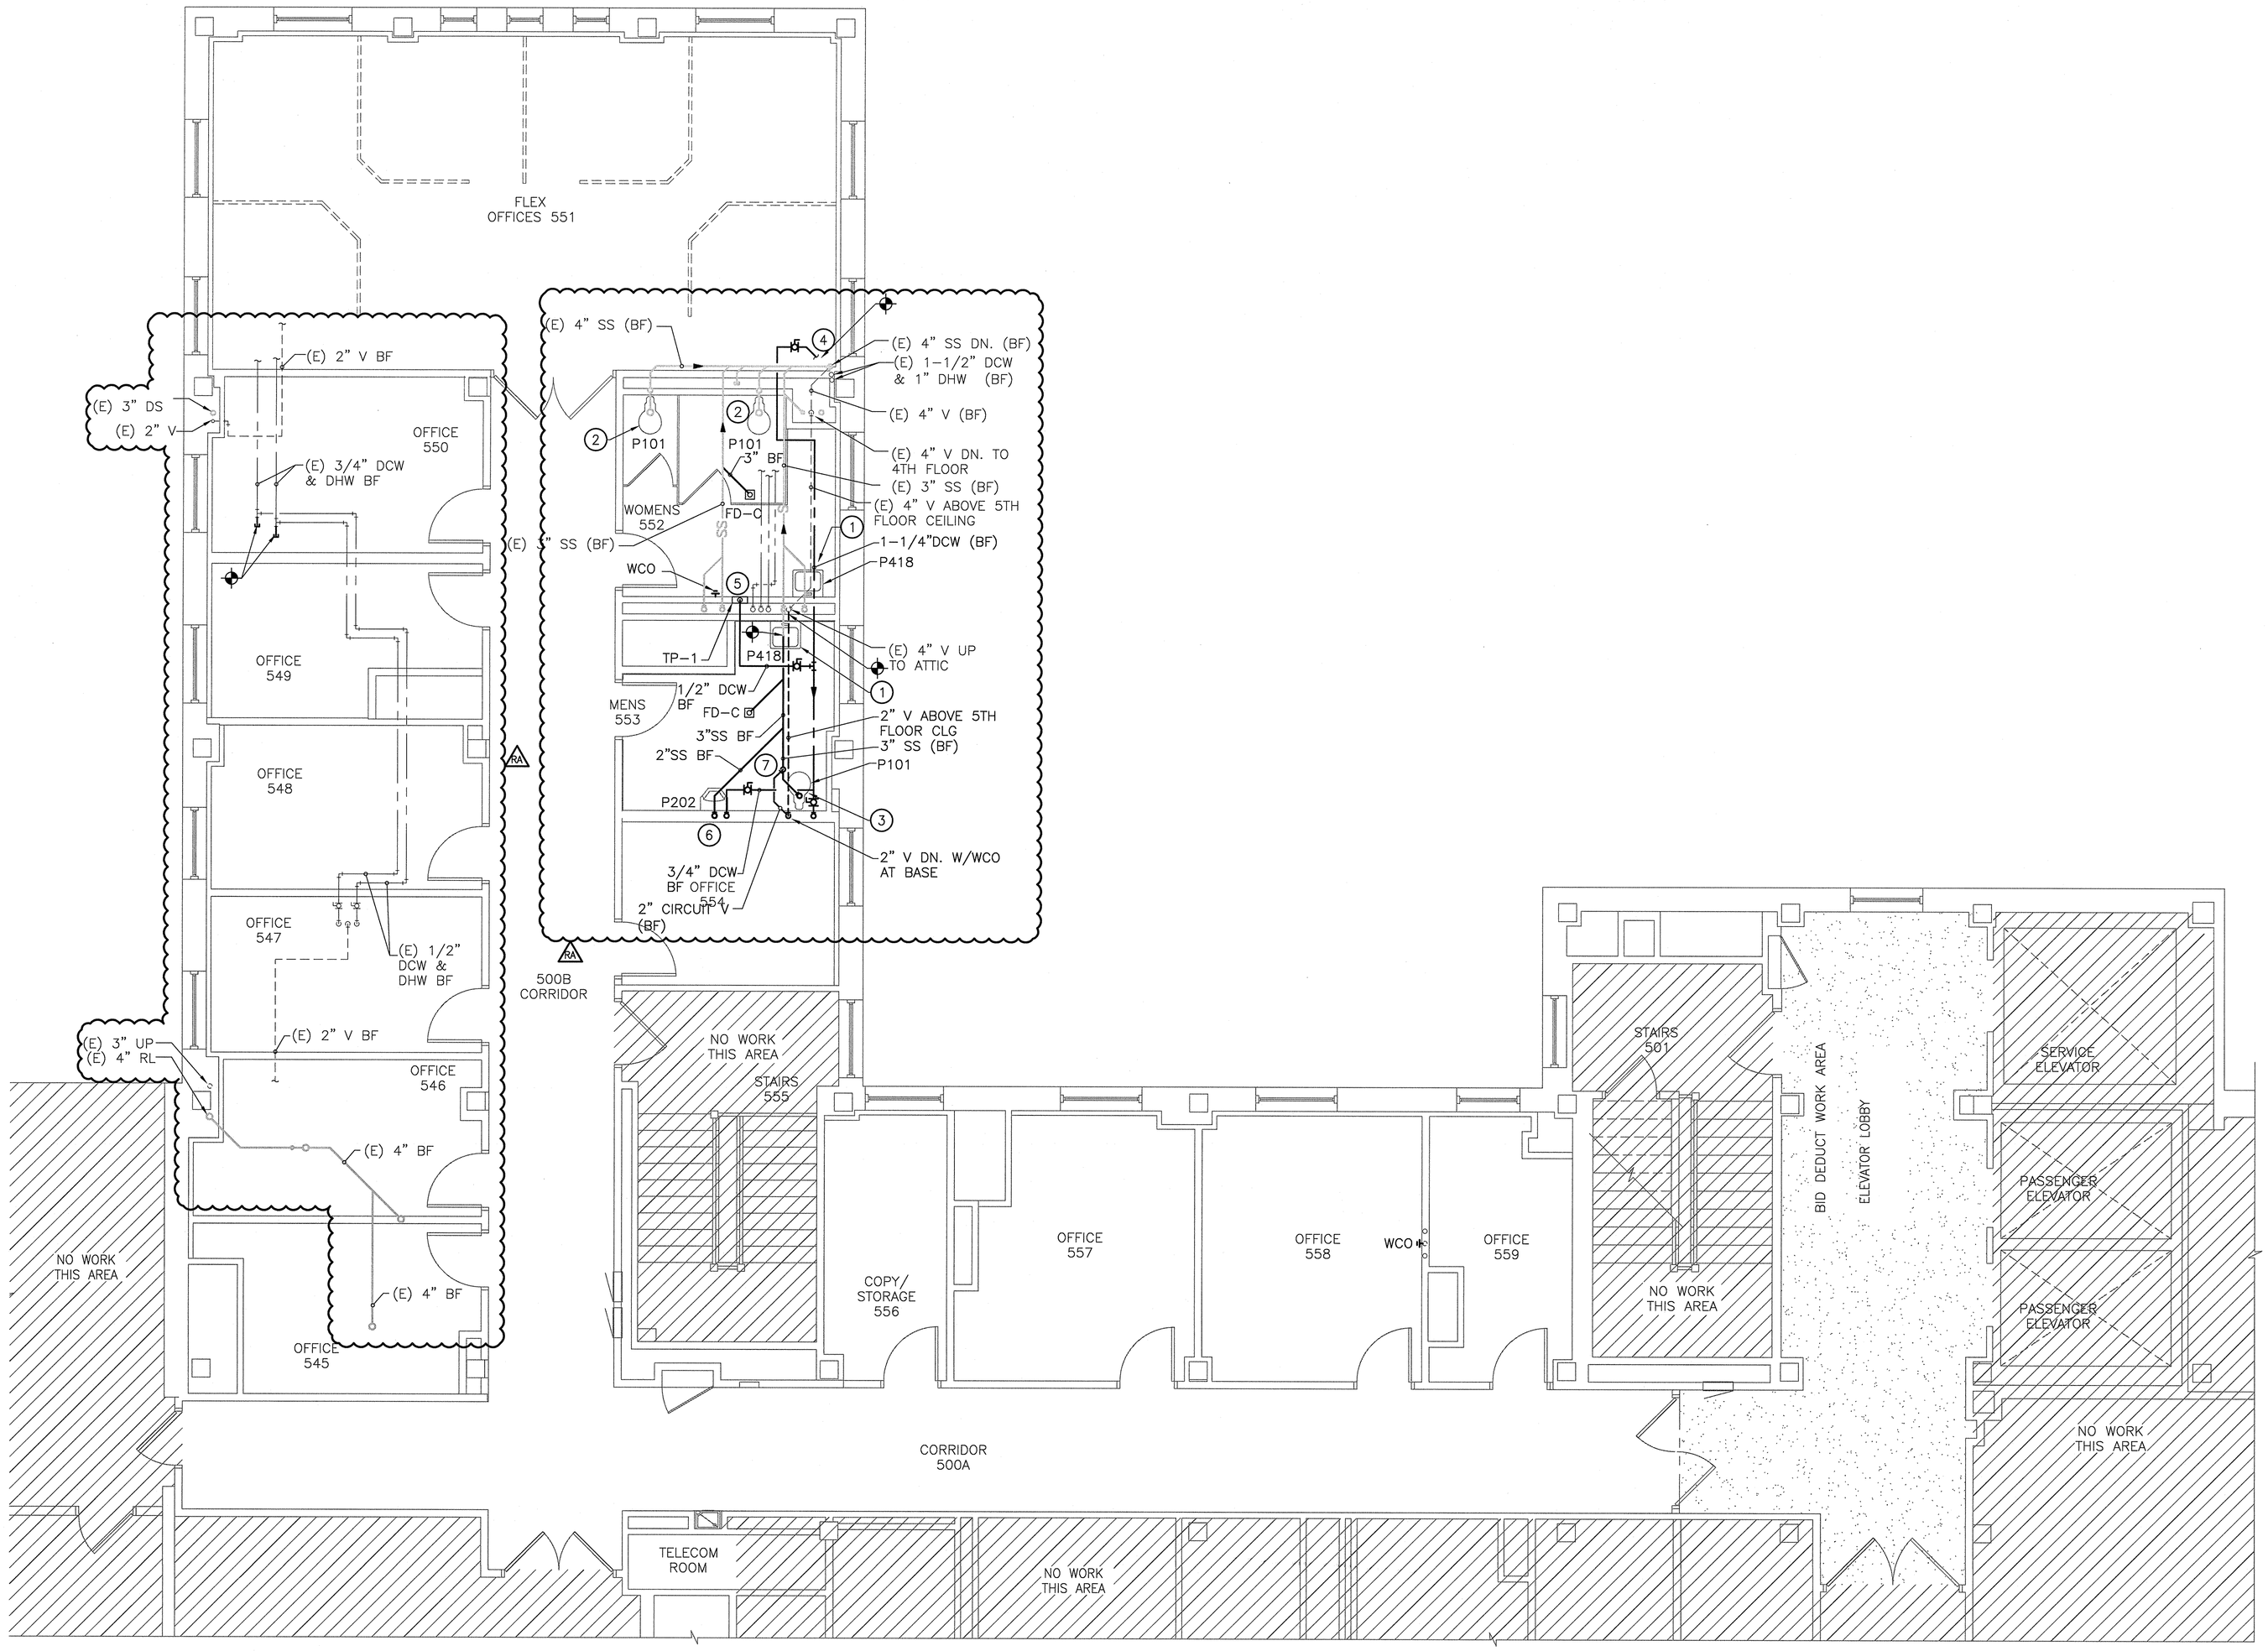

1 FIFTH FLOOR PLAN

SCALE: 1/4" = 1'-0"

PLAN TRUE

GENERAL NOTES

1. THESE DRAWINGS ARE BASED ON FIELD OBSERVATION AND EXISTING RECORD DOCUMENTS. REPORT DISCREPANCIES TO THE ARCHITECT/ENGINEER BEFORE DISTURBING EXISTING INSTALLATION.
2. THE CONTRACTOR SHALL COORDINATE HIS WORK WITH THE WORK OF OTHER TRADES TO MINIMIZE CONFLICT AND INTERFERENCE THROUGHOUT THE PROJECT.
3. THE CONTRACTOR SHALL NOT PLACE ANY SHUTOFF VALVES ABOVE ANY HARD CEILINGS. ALL VALVES SHALL BE IDENTIFIED AND TAGGED AND SHALL BE EQUIPPED WITH APPROPRIATE MEANS TO LOCK/SECURE THE VALVE IN THE CLOSED POSITION TO ALLOW FOR COMPLIANCE WITH OSHA LOCK OUT-TAG OUT REQUIREMENTS.
4. THE CONTRACTOR SHALL COORDINATE ANY REQUIRED SHUTDOWNS WITH THE OWNER.
5. THE CONTRACTOR SHALL COORDINATE ANY CORE DRILLS WITH THE ARCHITECT/ENGINEER BEFORE DRILLING.
6. NO PIPING OR EQUIPMENT SHALL BE ABANDONED IN PLACE.
7. THE CONTRACTOR SHALL ROD OUT ALL EXISTING SANITARY PIPING FROM POINT OF NEW CONNECTION BACK TO EXISTING MAIN.
8. UNLESS OTHERWISE NOTED ALL HORIZONTAL PIPING SHOWN ON THIS PLAN IS LOCATED ABOVE THE FOURTH FLOOR CEILING.
9. THE CONTRACTOR SHALL VERIFY EXACT LOCATION AND INVERT ELEVATION OF EXISTING SANITARY PIPING PRIOR TO CONSTRUCTION AND INSURE THAT SANITARY PIPING CAN BE PROPERLY CONNECTED AND INSTALLED WITH MINIMUM SLOPE AS REQUIRED BY NC PLUMBING CODE.
10. WHERE AFFECTED BY THE NEW OR DEMOLITION WORK CONTRACTOR SHALL RELOCATE ANY EXISTING PIPING, COMPONENTS OR SYSTEMS THAT ARE REQUIRED TO REMAIN IN ORDER TO KEEP EXISTING SYSTEMS OPERATIVE.
11. THE CONTRACTOR SHALL RECONNECT ANY EXISTING FIXTURES TO REMAIN WHERE THE EXISTING PIPING IS AFFECTED BY THE NEW OR DEMOLITION WORK.
12. CONTRACTOR SHALL INSTALL TEMPORARY CAPS AT TERMINATION POINTS OF EXISTING PIPING TO REMAIN DURING DEMOLITION PHASE.

NEW WORK NOTES INDICATED BY (#)

1. NEW LAVATORY P418. CONNECT TO EXISTING ROUGH-IN.
2. NEW WATER CLOSET P101, CONNECT TO EXISTING ROUGH-IN.
3. NEW WATER CLOSET P101. RUN 1" DCW UP IN WALL TO 5TH FLOOR AND CONNECT TO WATER CLOSET. 3" SANITARY SEWER UP TO FLOOR MOUNTED WATER CLOSET.
4. CONNECT NEW 1-1/4" DCW TO (E) 1-1/2" DCW .
5. INSTALL TYPE "C" ELECTRONIC TRAP PRIMER WITH BOX TP-1. RUN 1/2" DCW UP IN WALL TO 5TH FLOOR AND CONNECT TO BOX, AS SHOWN. EXTEND (2) 1/2" PRIMER PIPE BELOW FLOOR TO FLOOR DRAIN P-TRAP PRIMER CONNECTION.
6. NEW URINAL P202. RUN 3/4" DCW AND 2" SANITARY SEWER UP IN WALL UP TO 5TH FLOOR AND CONNECT TO URINAL.
7. 2" CIRCUIT VENT. THE VENT MUST RISE MIN 6" VERTICALLY BEFORE TURNING HORIZONTALLY AND CONTINUE TO THE WALL. RUN VENT UP TO 5TH FLOOR CEILING AND CONNECT TO (E) 4" VENT.

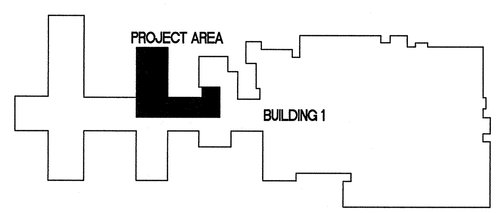

KEY PLAN - NTS

REVISION RA - OFFICE 449 / MENS 553	06/05/15
Revisions:	Date

100% FINAL CONSTRUCTION DOCUMENTS

Project Number	Scale
50062523	As indicated

NORTH CAROLINA PROFESSIONAL SEAL 16624 ENGINEER JOHN W. ROBERTS 05/16

ARCHITECT/ENGINEERS:

Atriax GROUP
www.atriaxgroup.com

Atriax, pllc
102 3rd Avenue, NE
PO Box 1629, Hickory, NC 28603
T: 828.315.9962
F: 828.315.9964

NC Engineering License No.: P-0214
NC Architectural License No.: 51254

Dewberry®
Dewberry Engineers Inc.
605 EASTOWNE DRIVE
CHAPEL HILL, NC 27514
PHONE: 919.433.0075
FAX: 919.433.0079
NCBELS # F-0929

Drawing Title: FIFTH FLOOR PLUMBING

Approved Project Director: - - -

Project Title: RENOVATE B-WING 5TH FLR FOR MENTAL HEALTH

Location: VAMC FAYETTEVILLE NC

Date: 9 JUN 2014 | Checked: ATH | Drawn: ALB

Project Number	Building Number	Drawing Number
565-13-209	1	PL101

Dwg.16 of 36

Office of Construction and Facilities Management

Department of Veterans Affairs

P:\50062523 DewCH - Atriax Fayetteville\CAD\Plumbing-Fire\50062523 - PL101.dwg 6-08-15 08:33:16 AM ocomonicliu

VA FORM 08-6231