




1 TYPICAL LAVATORY DETAIL
SCALE: NTS

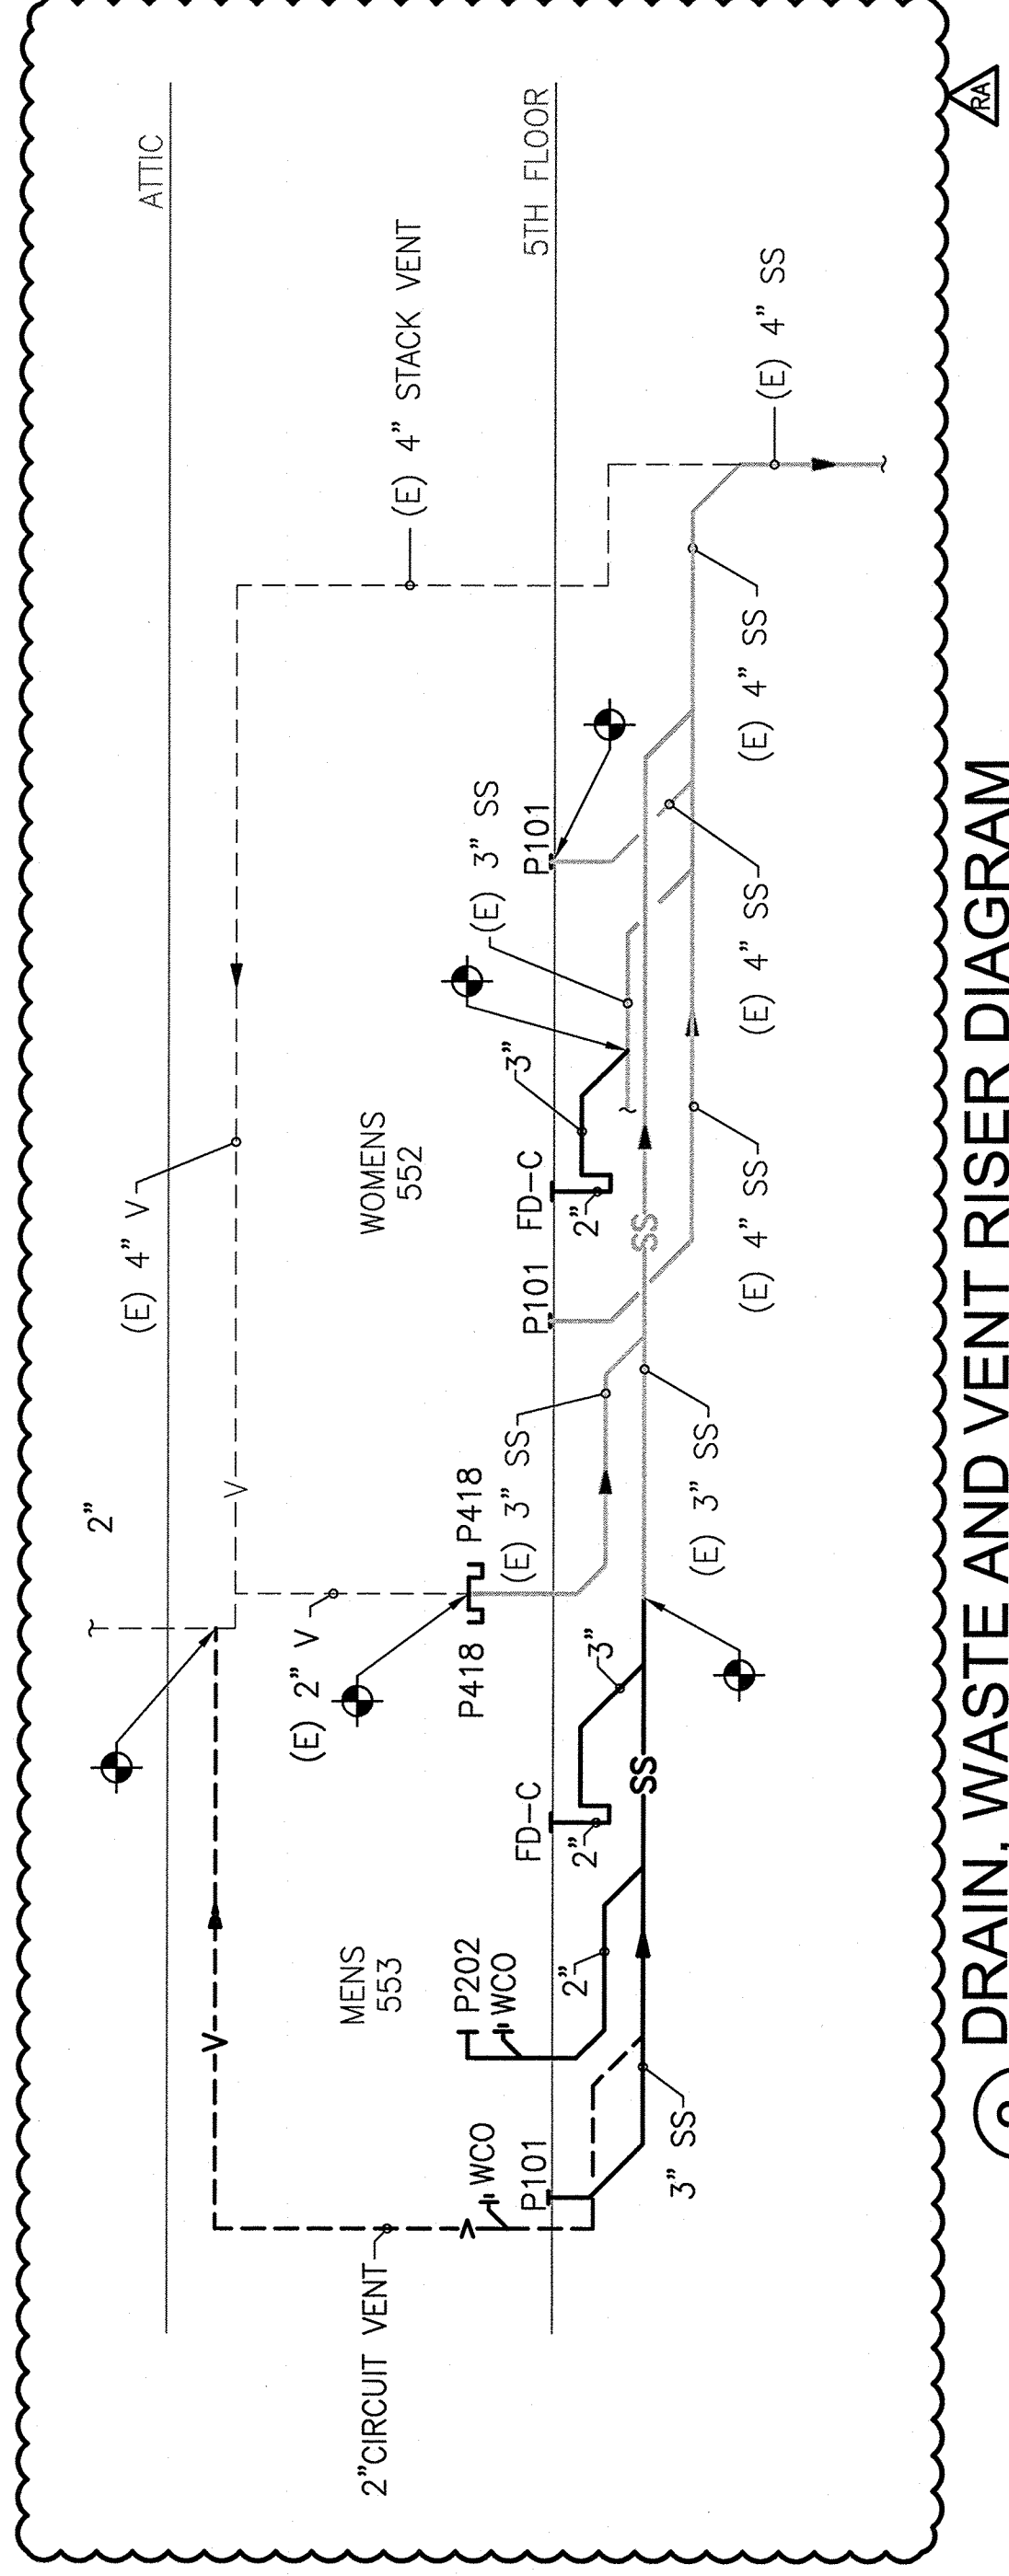

3 DRAIN, WASTE AND VENT RISER DIAGRAM
SCALE: NTS

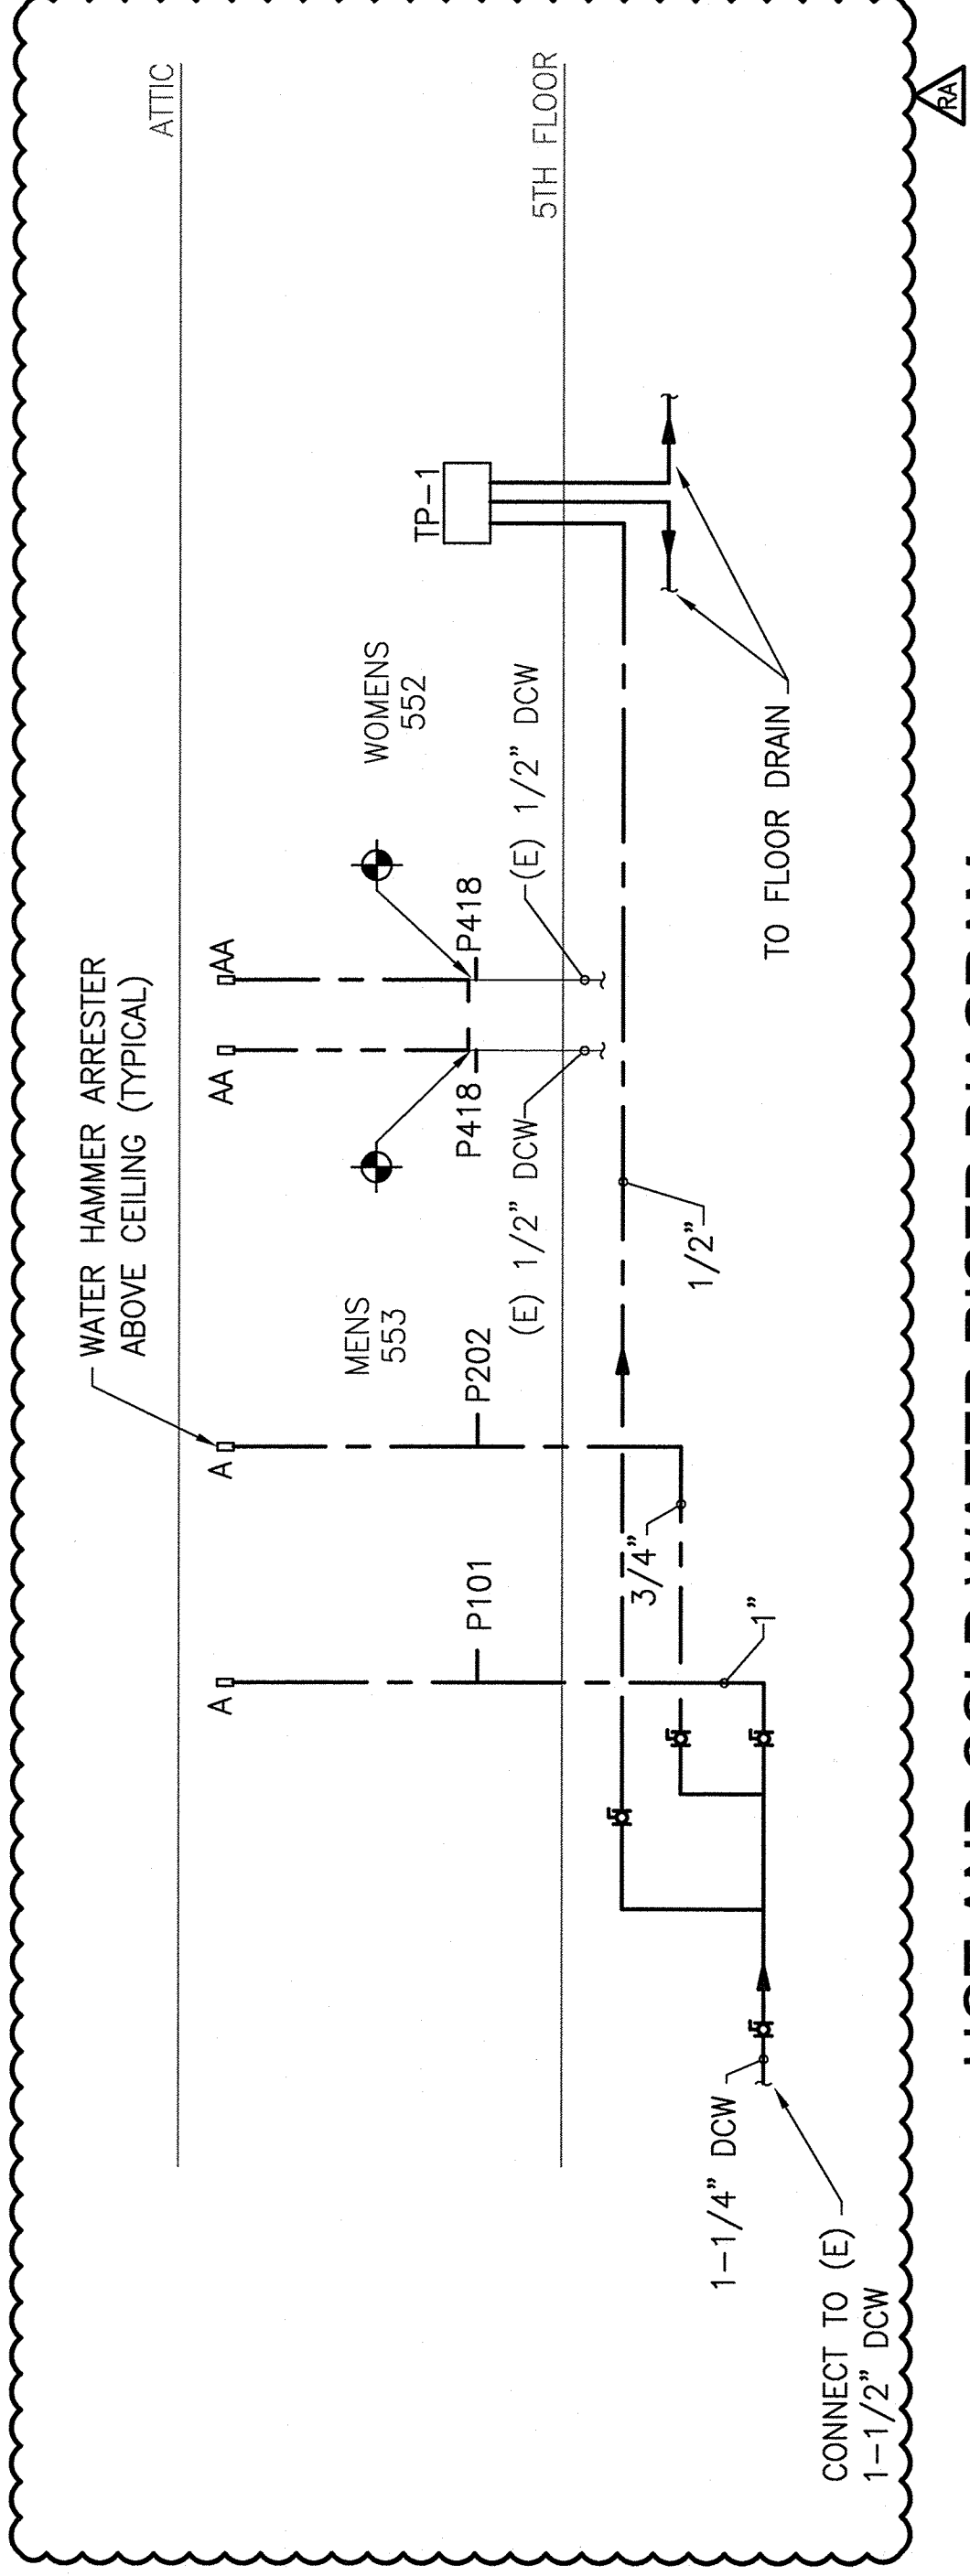

4 HOT AND COLD WATER RISER DIAGRAM
SCALE: NTS

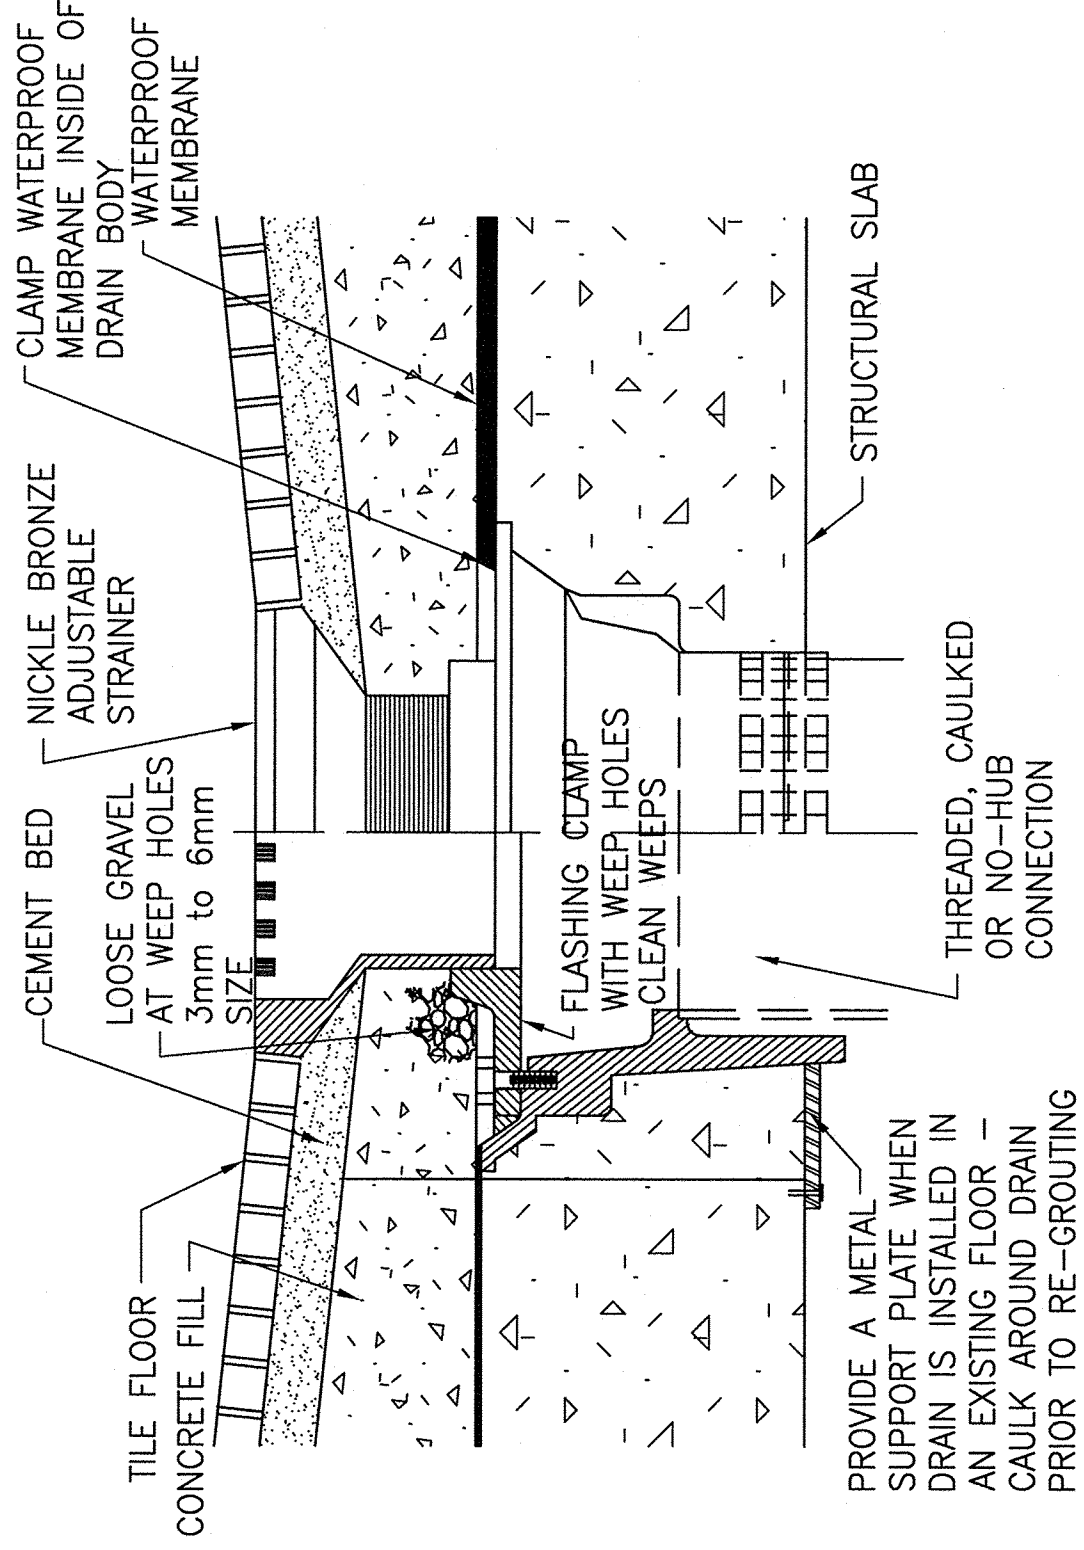


2 TYPE "C" FLOOR DRAIN DETAIL
SCALE: NTS

[illegible]

100% FINAL CONSTRUCTION
DOCUMENTS

Project Number 50062523	Scale As Indicated

Drawing Title	PLUMBING DETAILS AND SCHEDULES	Project Title RENOVATE B-WING 5TH FLR FOR MENTAL HEALTH				Project Number 565-13-209		Office of Construction and Facilities Management
						Building Number 1		
		Location VAMC FAYETTEVILLE				Drawing Number PI002		
		Date 9 JUN 2014		Checked ALB		Drawn MAN		
Approved Project Director								 Department of Veterans Affairs
-								
-								
-								