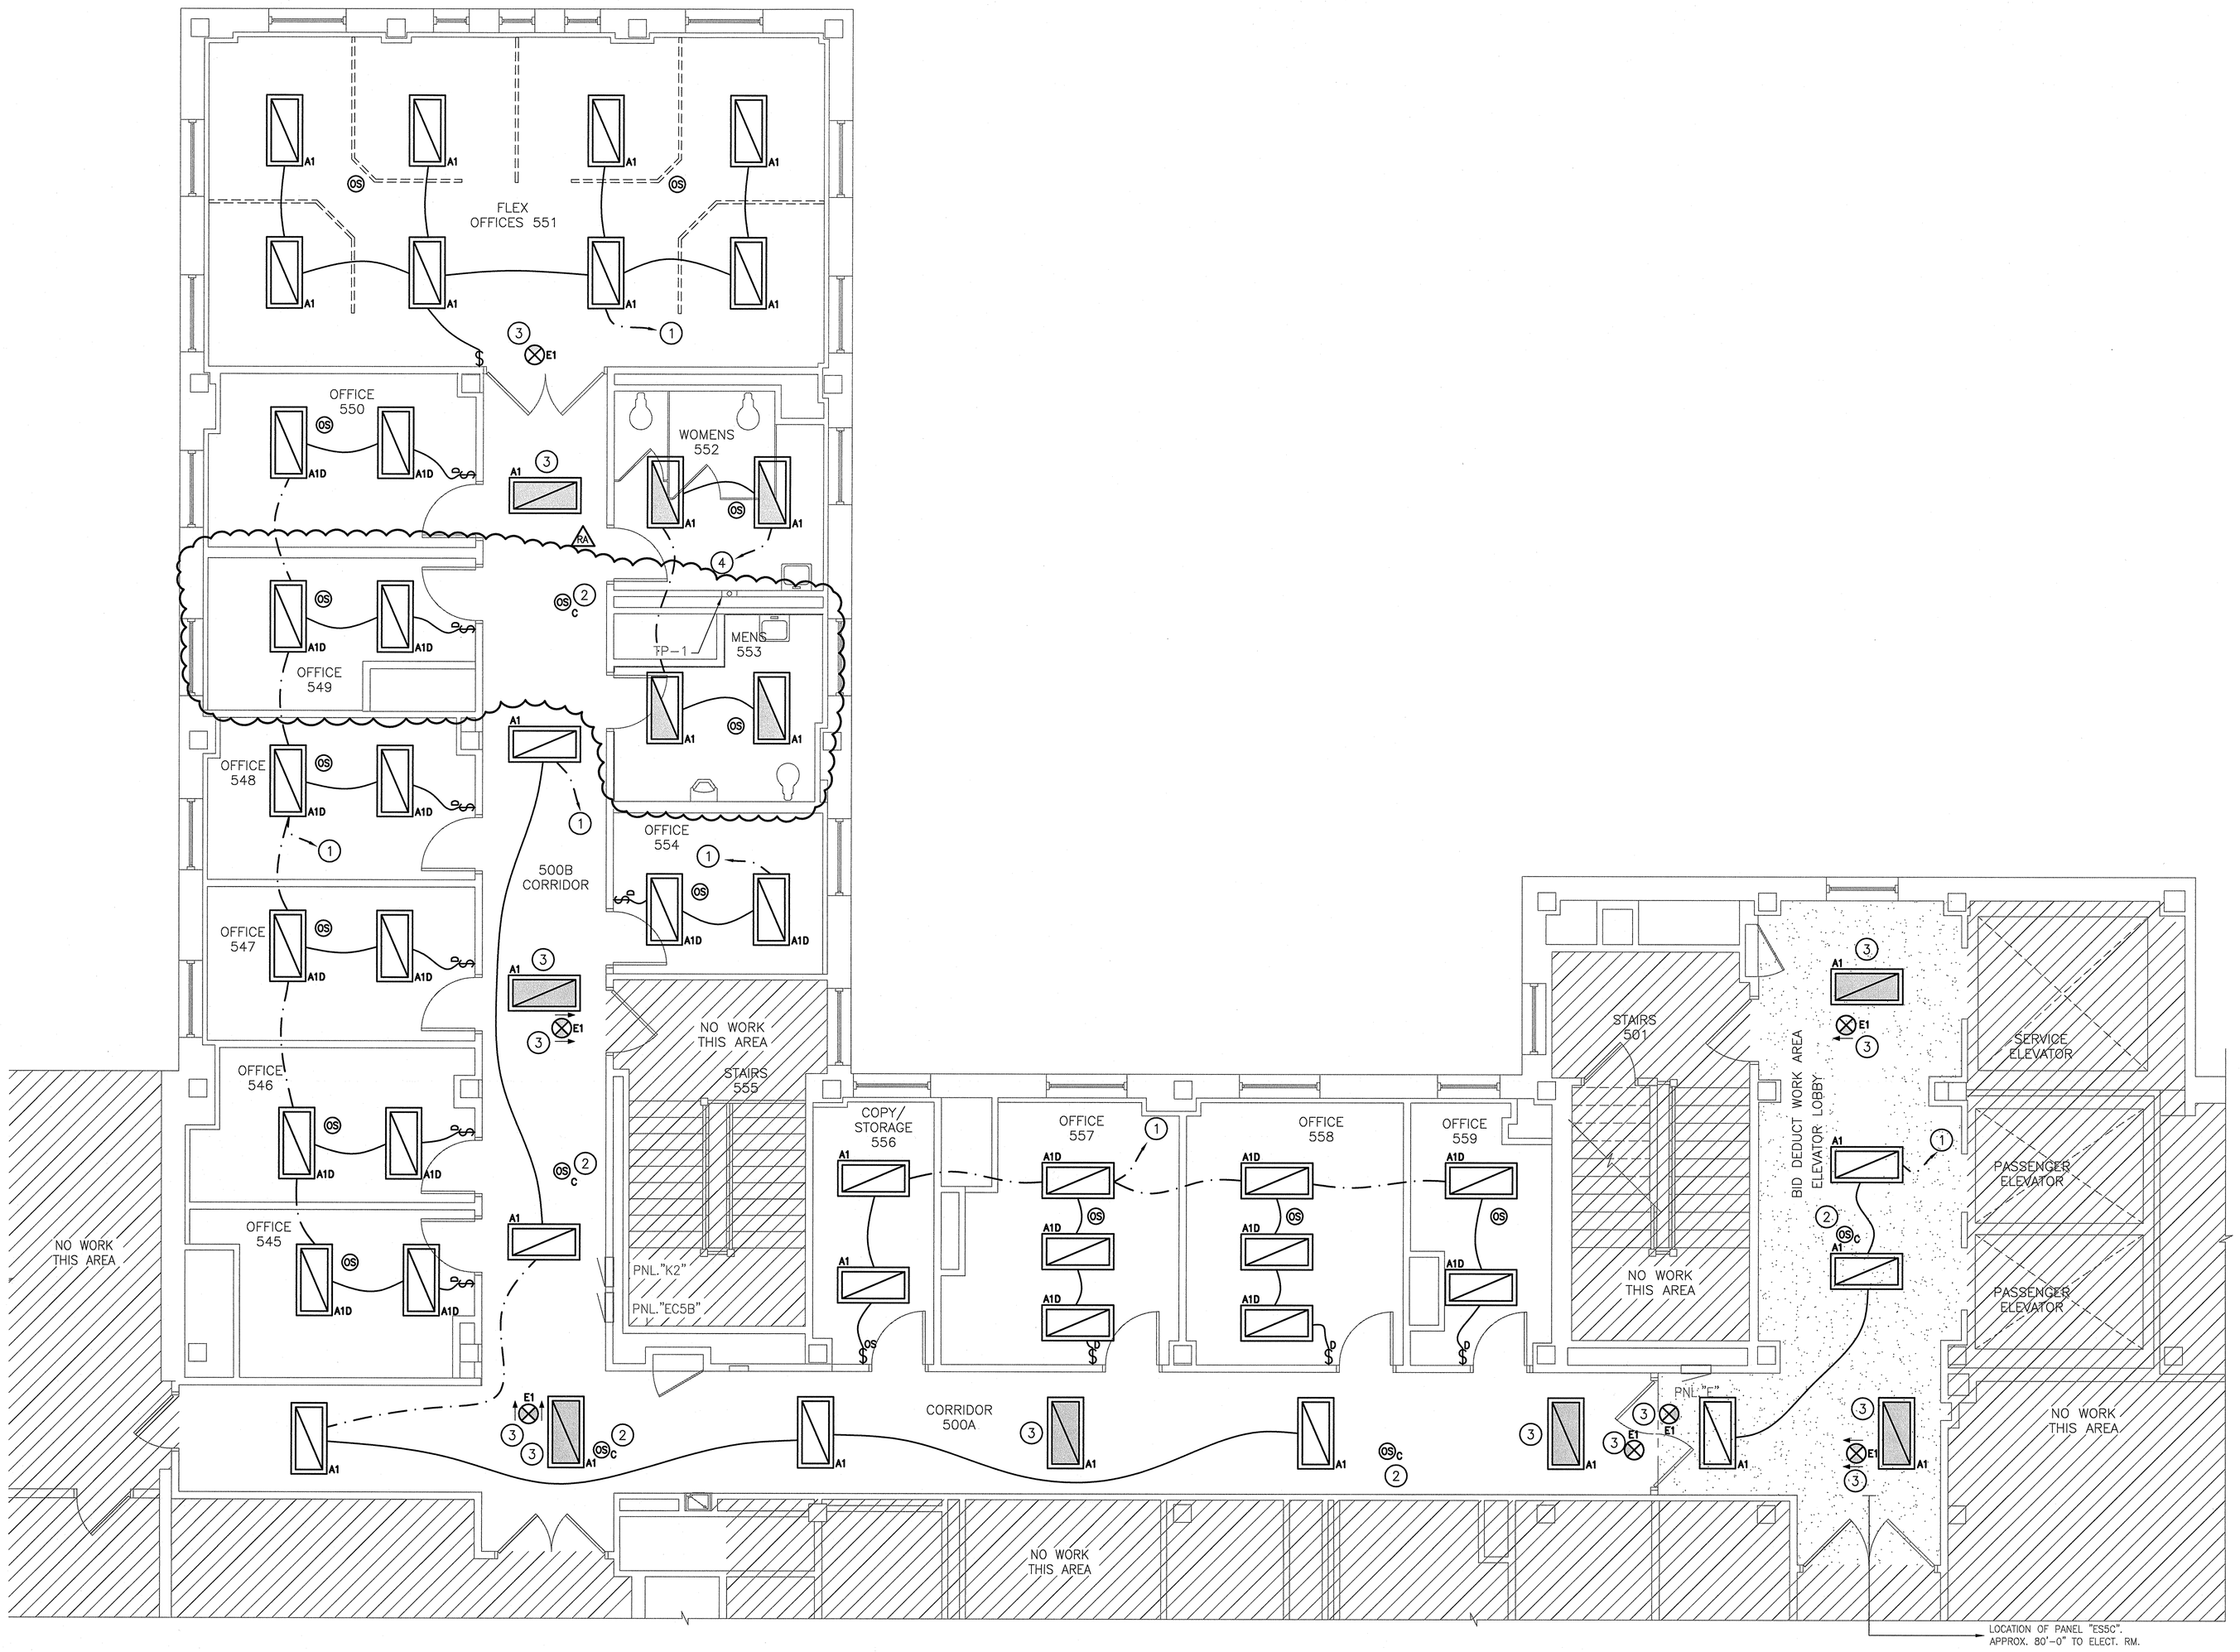

1 FIFTH FLOOR PLAN
SCALE: 1/4" = 1'-0"

PLAN TRUE

GENERAL NOTES

NEW WORK NOTES INDICATED BY (#)

1. WIRE TO EXISTING AREA NORMAL BRANCH LIGHTING CIRCUIT WITH #12 CU WIRE IN 3/4" CONDUIT. NO LOAD INCREASE.
2. OCCUPANCY SENSOR SHALL CONTROL NORMAL BRANCH LIGHT FIXTURES IN THIS CORRIDOR ONLY.
3. WIRE TO EXISTING LIFE SAFETY PANEL "ES5C" POLE #5.
4. WIRE TO EXISTING CRITICAL BRANCH PANEL "EC5B". PROVIDE A 20A–1P CIRCUIT BREAKER IN EXISTING SPACE POLE #1.

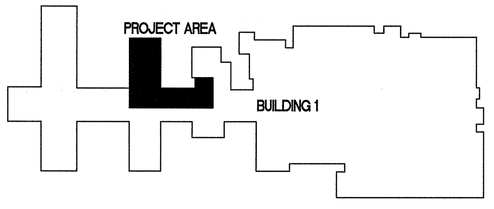

KEY PLAN - NTS

REVISION RA - OFFICE 449 / MENS 553	06/05/15
Revisions	Date

100% FINAL CONSTRUCTION DOCUMENTS

Project Number: 50062523
Scale: As indicated

NORTH CAROLINA PROFESSIONAL ENGINEER SEAL 024507 WAYNE B. MITCHELL 6-8-15

ARCHITECT/ENGINEERS:

Atriax GROUP
www.atriaxgroup.com

Atriax, pllc
102 3rd Avenue, NE
PO Box 1629, Hickory, NC 28603
T: 828.315.9962
F: 828.315.9964

NC Engineering License No.: P-0214
NC Architectural License No.: 51254

Dewberry
Dewberry Engineers Inc.
605 EASTOWNE DRIVE
CHAPEL HILL, NC 27514
PHONE: 919.433.0075
FAX: 919.433.0079
NCBELS # F-0929

Drawing Title: FIFTH FLOOR ELECTRICAL LIGHTING

Approved Project Director: – – –

Project Title: RENOVATE B-WING 5TH FLR FOR MENTAL HEALTH

Location: VAMC FAYETTEVILLE NC

Date: 9 JUN 2014 | Checked: SBM | Drawn: TGP

Project Number: 565-13-209
Building Number: 1
Drawing Number: EL101
Dwg. 30 of 36

Office of Construction and Facilities Management
Department of Veterans Affairs

VA FORM 08-6231

P:\50062523 DewCH - Atriax Fayetteville\CAD\Elec\50062523 - EL101.dwg 6-05-15 04:16:52 PM tpalmer