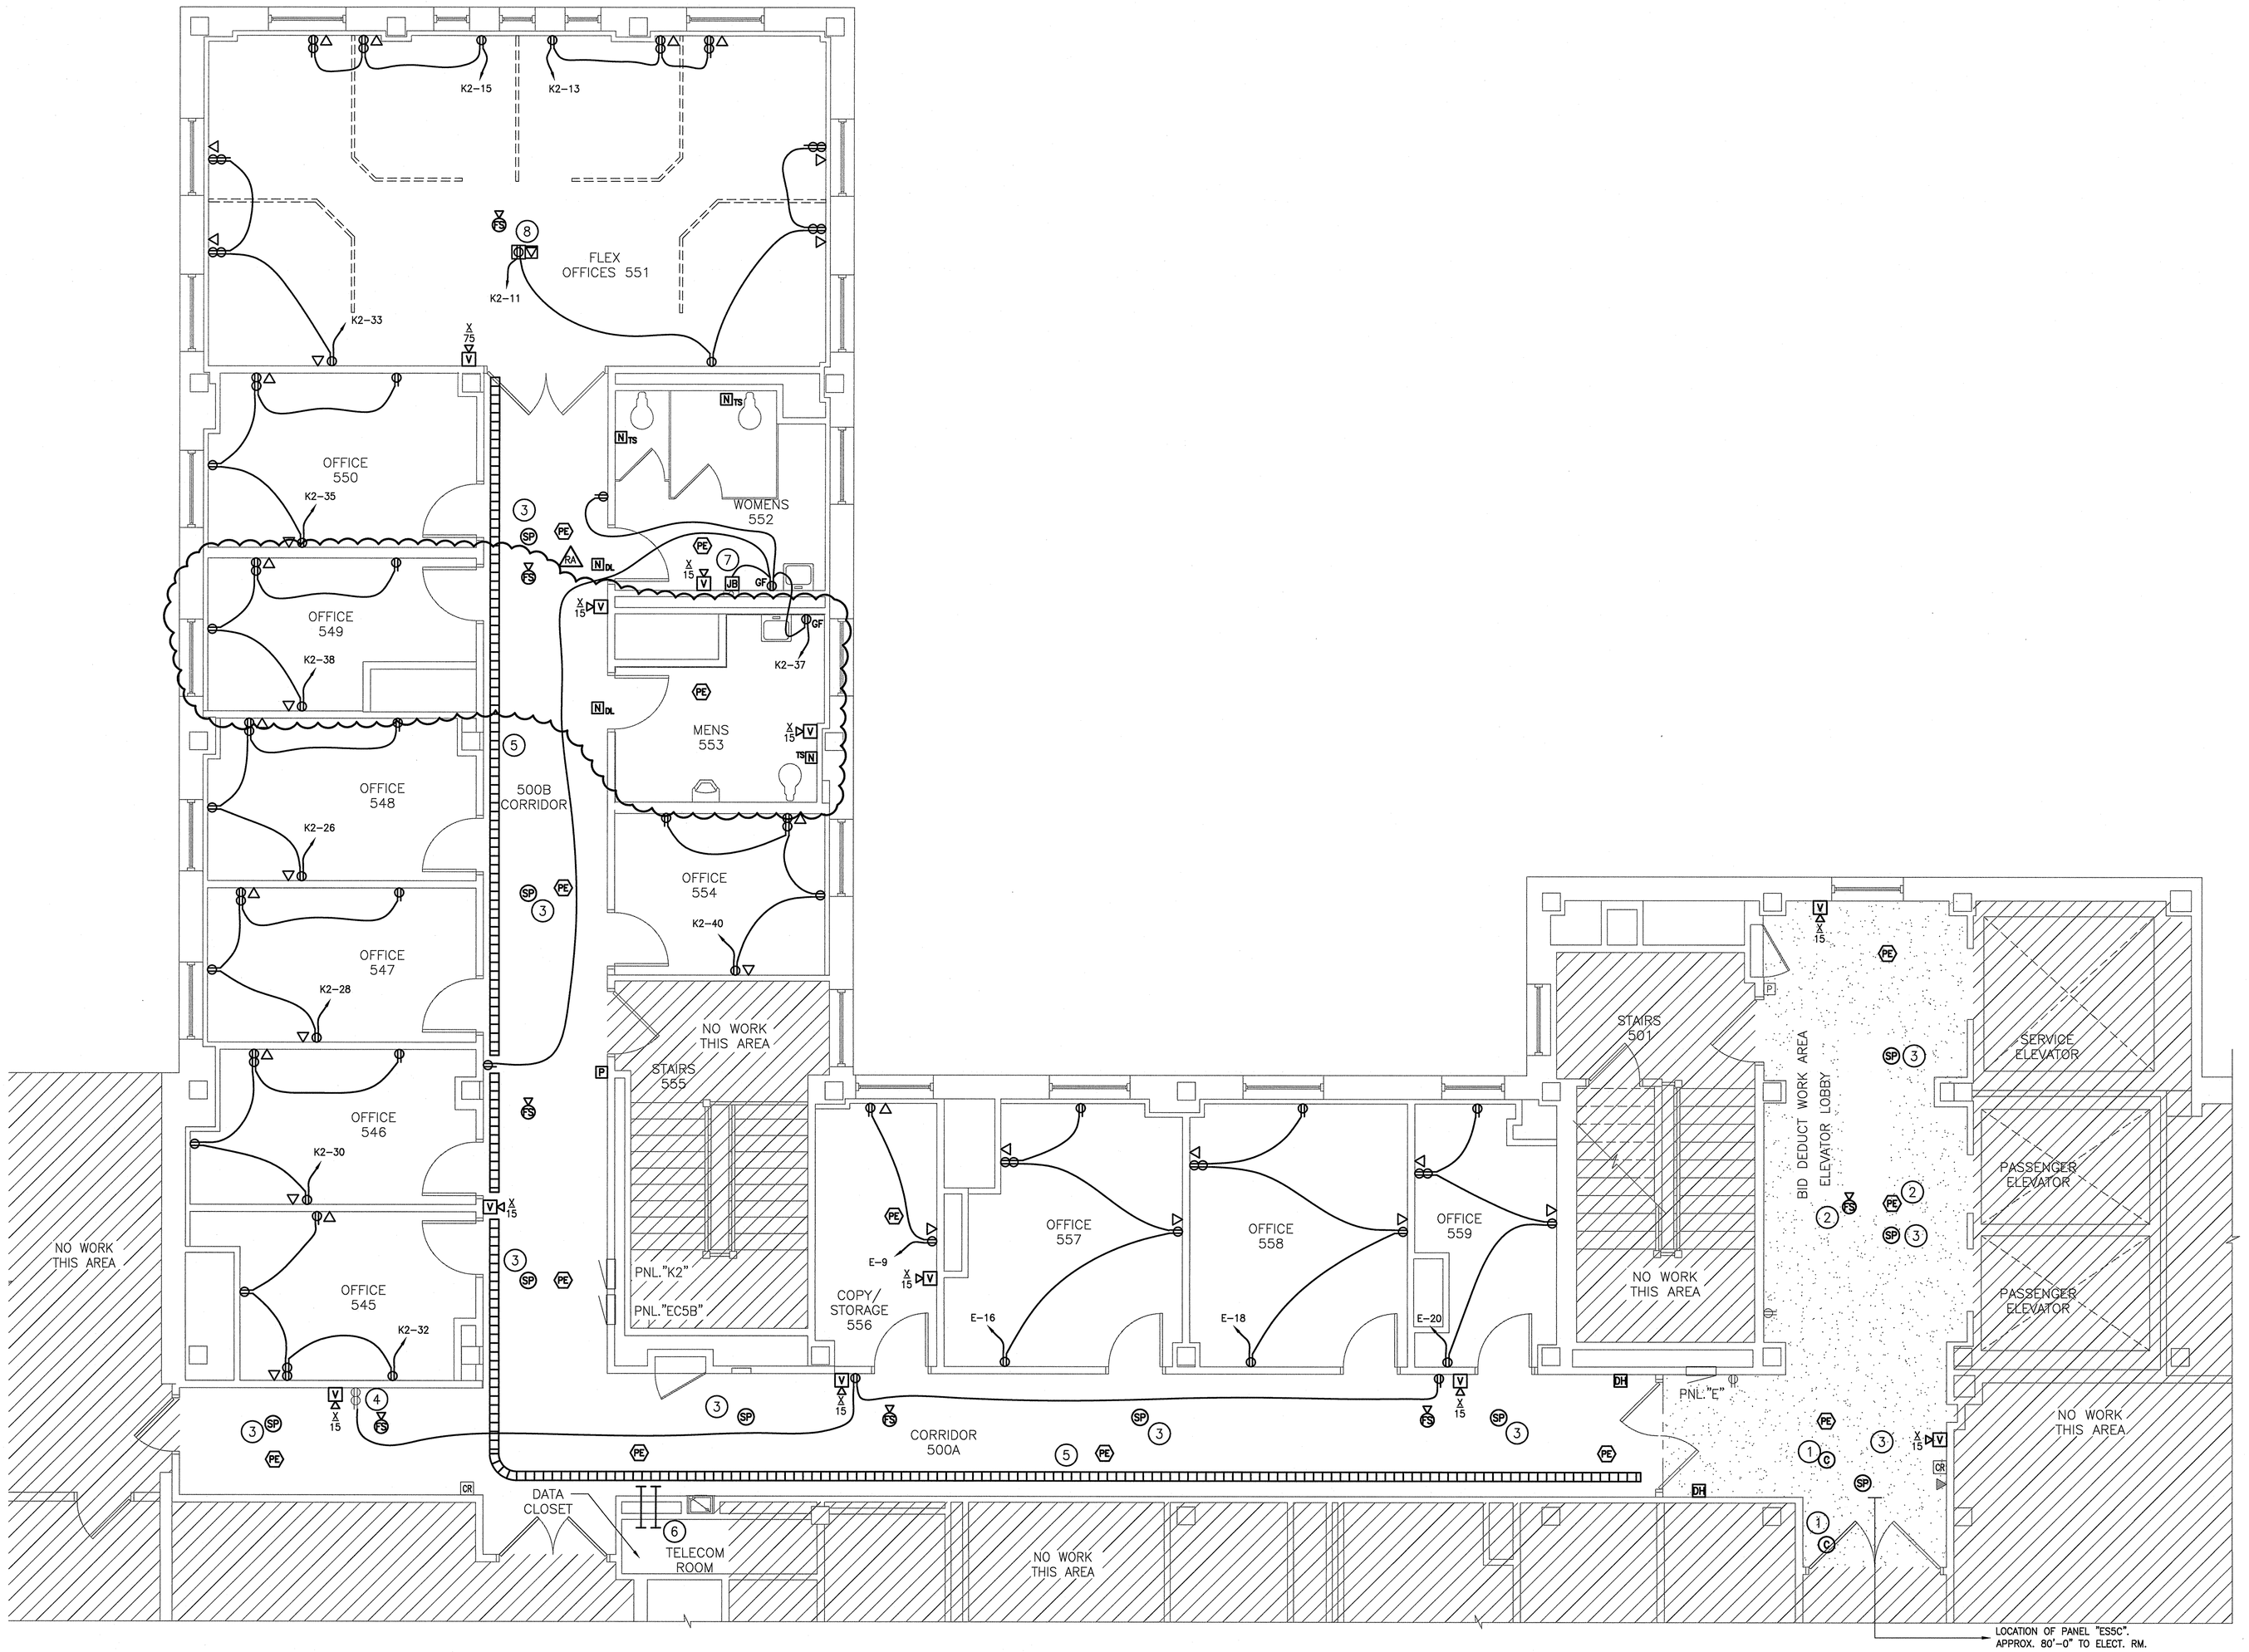

1 FIFTH FLOOR PLAN

SCALE: 1/4" = 1'-0"

PLAN TRUE NORTH

GENERAL NOTES

1. ELECTRICAL CONTRACTOR SHALL VERIFY ALL EXISTING SPARES AND SPACES IN PANELS.
2. EXISTING NURSE CALL SYSTEM IS SIMPLEX GRINNELL EZ-CARE. PROVIDE DEVICES TO MATCH HOSPITAL STANDARD. COORDINATE BACK BOX SIZE/TYPE AND WIRE TYPE TIE-IN POINT TO EXISTING NETWORK SYSTEM WITH MANUFACTURER VENDOR.

NEW WORK NOTES INDICATED BY (#)

1. REINSTALL EXISTING CAMERA IN NEW CEILING IN EXISTING SPOT.
2. REINSTALL EXISTING FIRE ALARM DEVICE IN NEW CEILING. EXTEND EXISTING CONDUIT AND WIRE AS REQUIRED TO NEW LOCATION SHOWN.
3. REINSTALL EXISTING SPEAKER IN NEW CEILING. EXTEND EXISTING CONDUIT AND WIRE AS REQUIRED TO NEW LOCATION SHOWN.
4. WIRE NEW RECEPTACLES TO EXISTING RECEPTACLE WITH #12 CU WIRE IN 3/4" CONDUIT.
5. 12"W x 4"D CABLE TRAY.
6. PROVIDE (2) 4" CONDUIT SLEEVES FOR TELECOM. COORDINATE EXACT LOCATION IN ROOM WITH EXISTING SURROUNDING UTILITIES AND EQUIPMENT.
7. POWER FOR TRAP PRIMER.
8. NEW FLOOR BOX FOR POWER AND DATA TO SERVE CONFERENCE TABLE. COORDINATE CORE DRILLING WITH FACILITIES STAFF. FLOOR FIRE RATING MUST REMAIN AT 2HR PROTECTION. PROVIDE WIREMOLD EVOLUTION 8AT POKE-THRU TYPE FLOOR BOX WITH RECESSED ACTIVATION OR APPROVED EQUAL BY HUBBELL. PROVIDE (2) INTEGRAL DUPLEX RECEPTACLES AND (3) RJ-45 TELECOM JACKS.

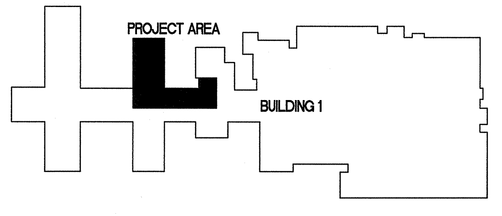

KEY PLAN - NTS

Revisions	Date
REVISION RA - OFFICE 449 / MENS 553	06/05/15

100% FINAL CONSTRUCTION DOCUMENTS

Project Number: 50062523 | Scale: As indicated

NORTH CAROLINA REGISTERED PROFESSIONAL ENGINEER SEAL 024507 JAMES B. MITCHELL 6-8-15

ARCHITECT/ENGINEERS:

Atriax GROUP
www.atriaxgroup.com
Atriax, pllc
102 3rd Avenue, NE
PO Box 1629, Hickory, NC 28603
T: 828.315.9962
F: 828.315.9964
NC Engineering License No.: P-0214
NC Architectural License No.: 51254

Dewberry®
Dewberry Engineers Inc.
605 EASTOWNE DRIVE
CHAPEL HILL, NC 27514
PHONE: 919.433.0075
FAX: 919.433.0079
NCBELS # F-0929

Drawing Title	FIFTH FLOOR ELECTRICAL POWER AND LOW VOLTAGE
Approved Project Director	- - -
Project Title	RENOVATE B-WING 5TH FLR FOR MENTAL HEALTH
Location	VAMC FAYETTEVILLE NC
Date	9 JUN 2014
Checked	SBM
Drawn	TGP
Project Number	565-13-209
Building Number	1
Drawing Number	EPLV101
Dwg.	32 of 36

Office of Construction and Facilities Management

Department of Veterans Affairs

P:\50062523 DewCH - Atriax Fayetteville\CAD\Elec\50062523 - EPLV101.dwg 6-05-15 04:17:10 PM tpolmer

VA FORM 08-6231